


REVISIONS			
REV.	DESCRIPTION	DATE	APPROVED
A	Initial Release/As Built	20081208	HRadkins

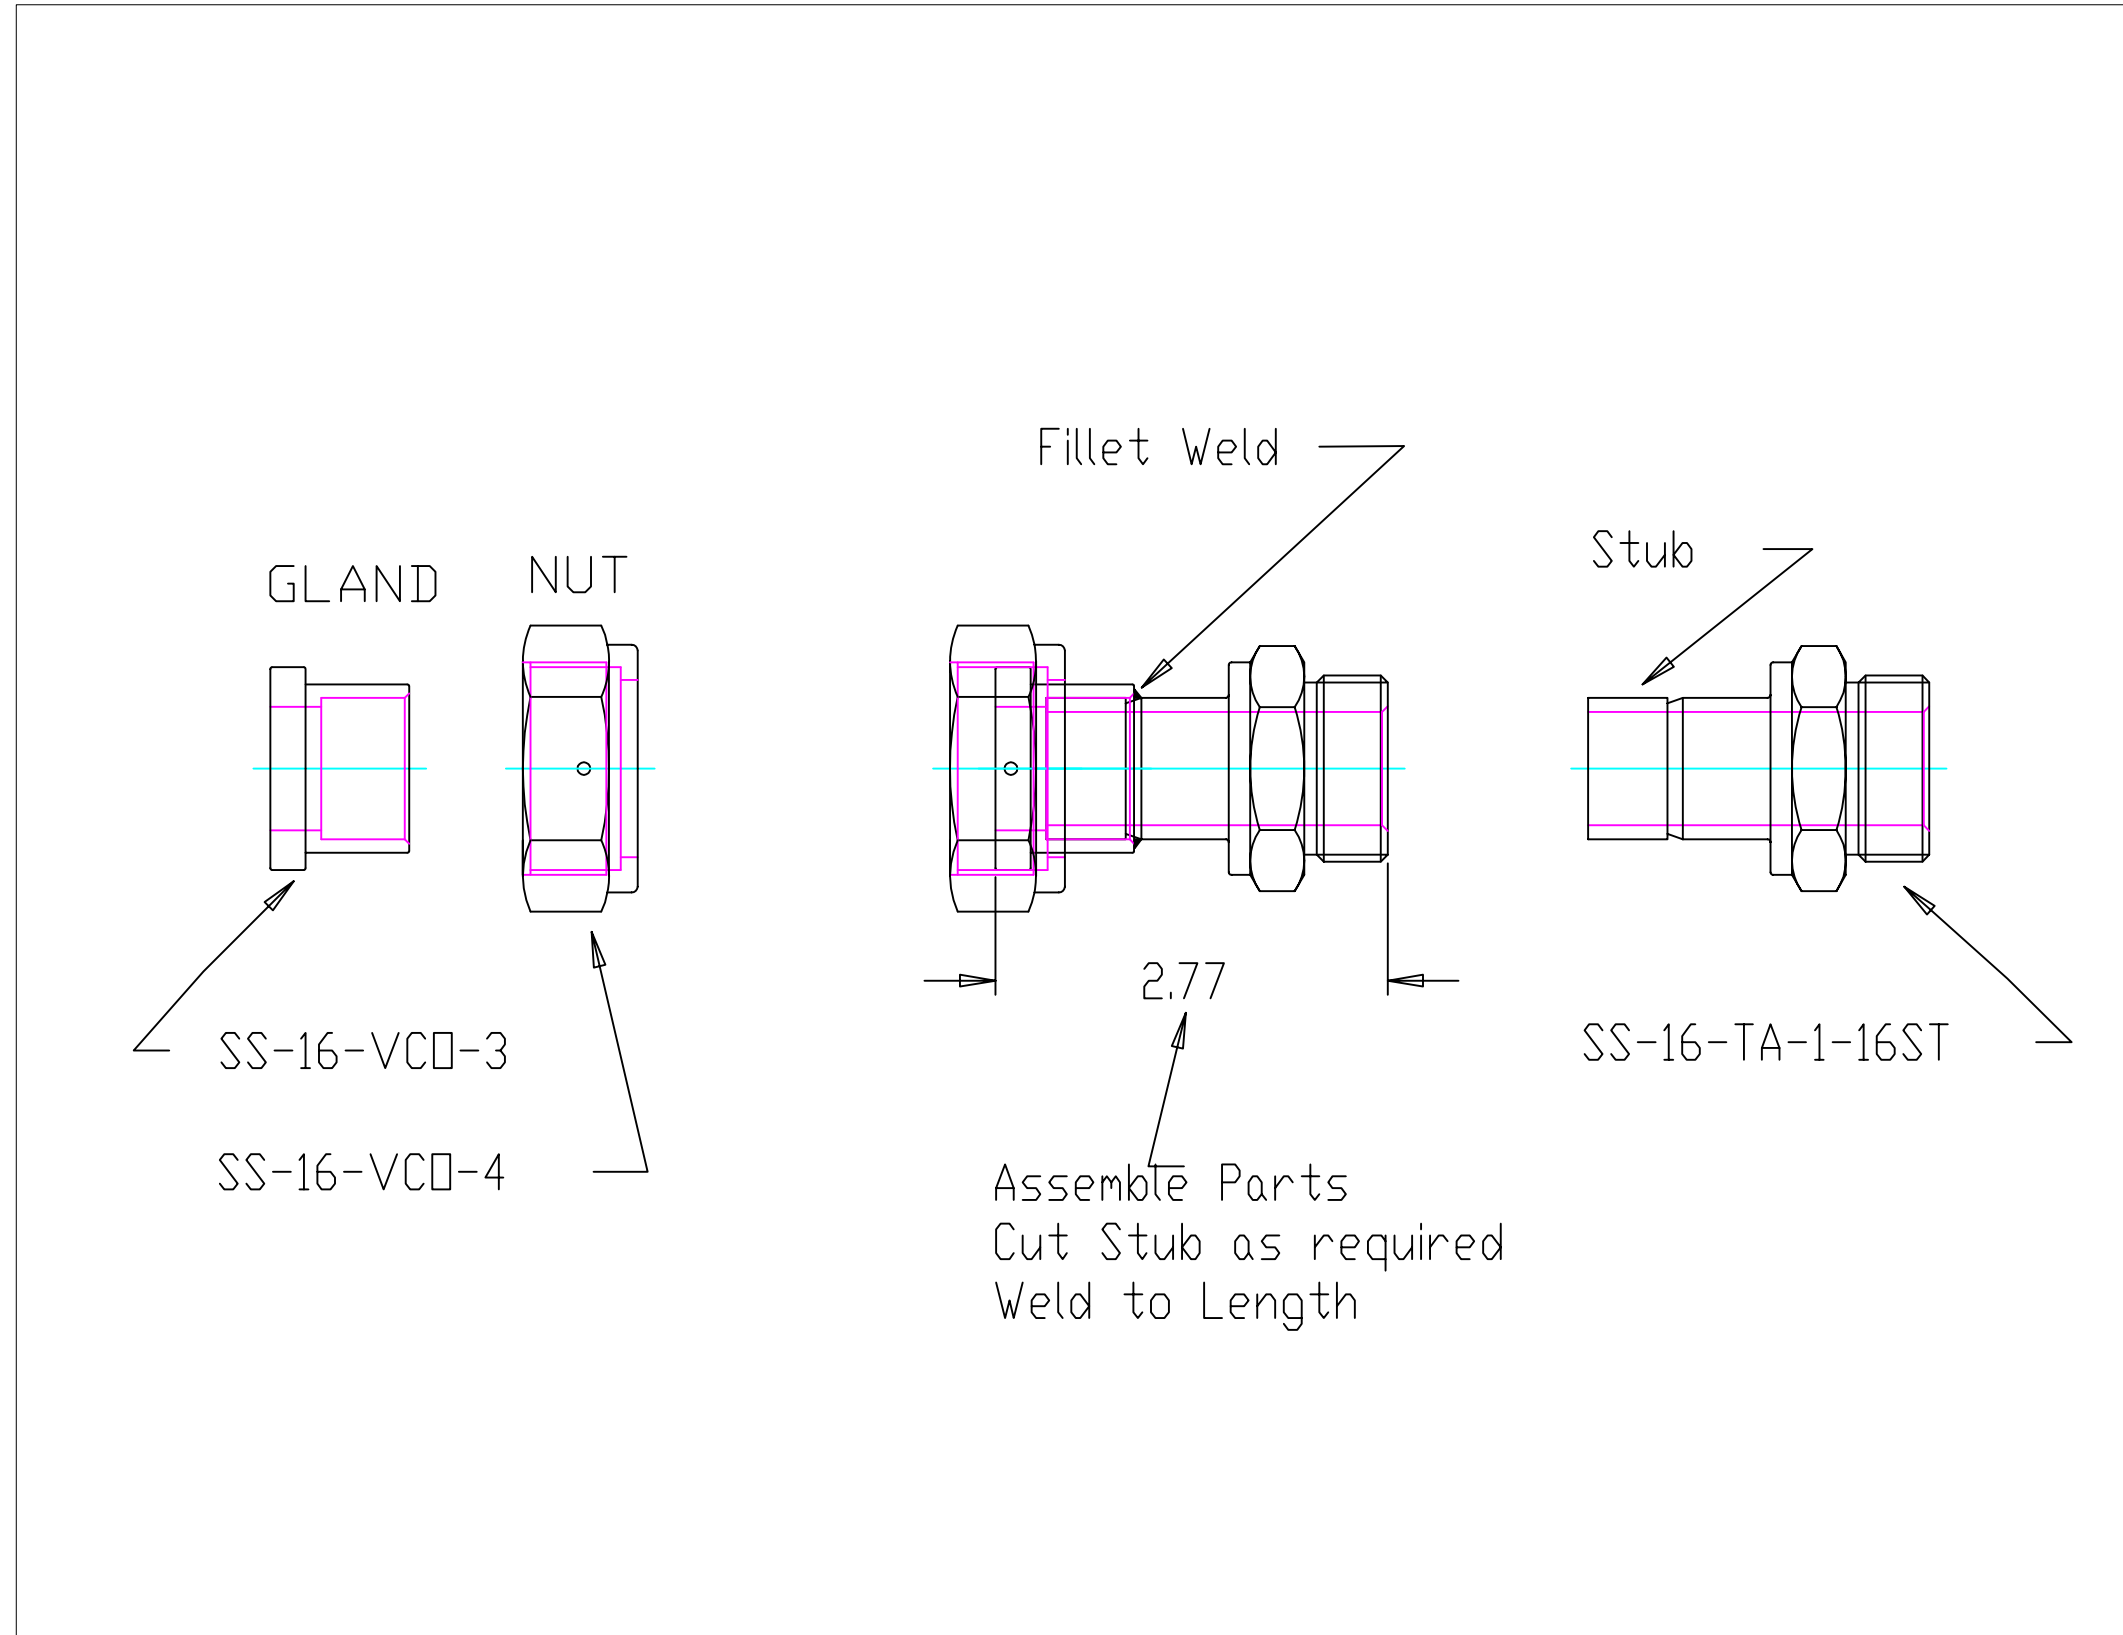

UNLESS OTHERWISE SPECIFIED:		NAME	DATE	CALIFORNIA INSTITUTE OF TECHNOLOGY MASSACHUSETTS INSTITUTE OF TECHNOLOGY
Dimension in Inches	DRAWN	HRadkins	080827	
TOLERANCES:	CHECKED			SYSTEM: LHO
TWO PLACE DECIMAL: ± 0.03				SUB-SYSTEM: HEPI
				NEXT ASSM: D040299
				TITLE: Valve to Filter Assembly
MATERIAL	COMMENTS:			SIZE DWG. NO.
	Part numbers are Swagelok			D D080498-A-D
FINISH				REV. A
				SCALE: DO NOT SCALE DRAWING