

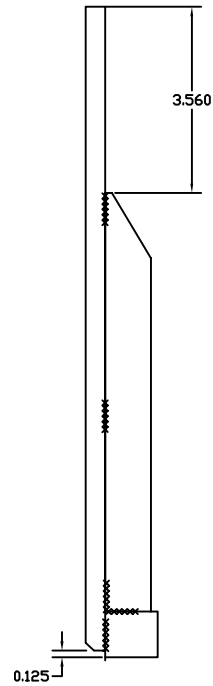



NOTES: (UNLESS OTHERWISE SPECIFIED)

REV.	DATE		
√1	20081208	Initial Release/AS Built	

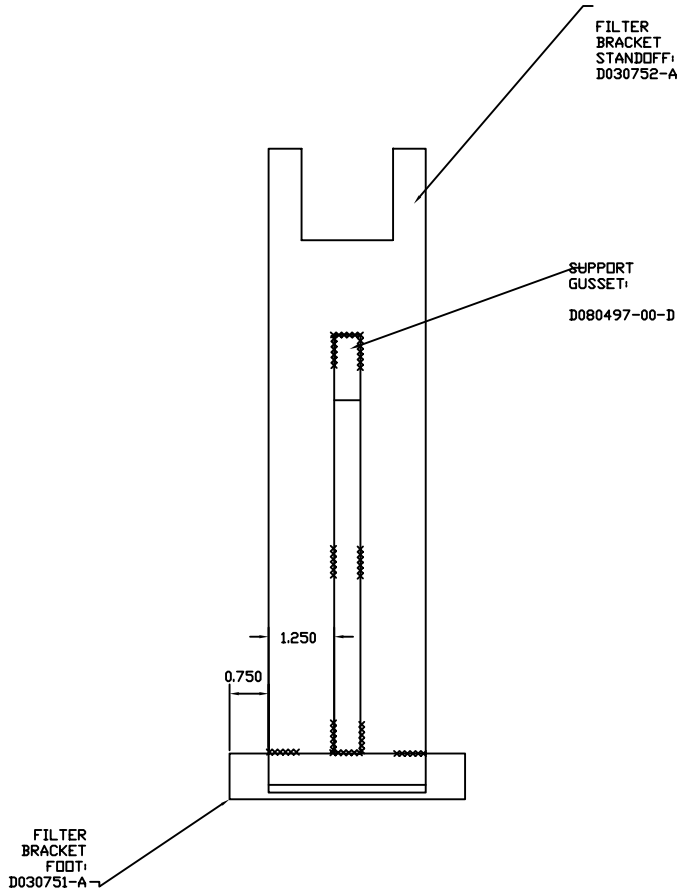

Fillet Weld 3/4" at 17 Places as Indicated

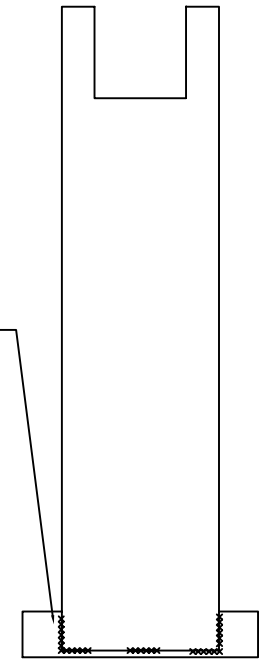

DIMENSIONS ARE IN INCHES		NAME	DATE	 CALIFORNIA INSTITUTE OF TECHNOLOGY MASSACHUSETTS INSTITUTE OF TECHNOLOGY
DRAWN	E. Douglas	08 / 27 / 08	SYSTEM	
CHECKED	H. Radkins	20080908	SUB-SYSTEM	HEPI
MATERIAL			NEXT ASSY	D040299
FINISH			PART NAME	FILTER BRACKET ASSEMBLY
TOLERANCES: .XX +/- 0.03 .XXX +/- 0.005 ANGULAR +/- 3 DEG			COMMENTS:	SCALE: DWG. NO. D080519-V1-D REV. V1
			SCALE:	SHEET 1 OF 1

FILE NAME/LOCATION: