


REV.	DATE	DCN #	DRAWING TREE #
v1	25JUN2010	NA	NA

NOTES:
 1) ALL DIMENSIONS ARE INCHES [MM]
 2) THE HOOK HEIGHT IS AS-BUILT FOR LHO
 3) HOOK HEIGHT FOR LLO IS TBD
 4) CLEAN ROOM IS SHOWN IN LOWEST HEIGHT ACCORDING TO PSI DRAWING V049-4-133, REV. 5

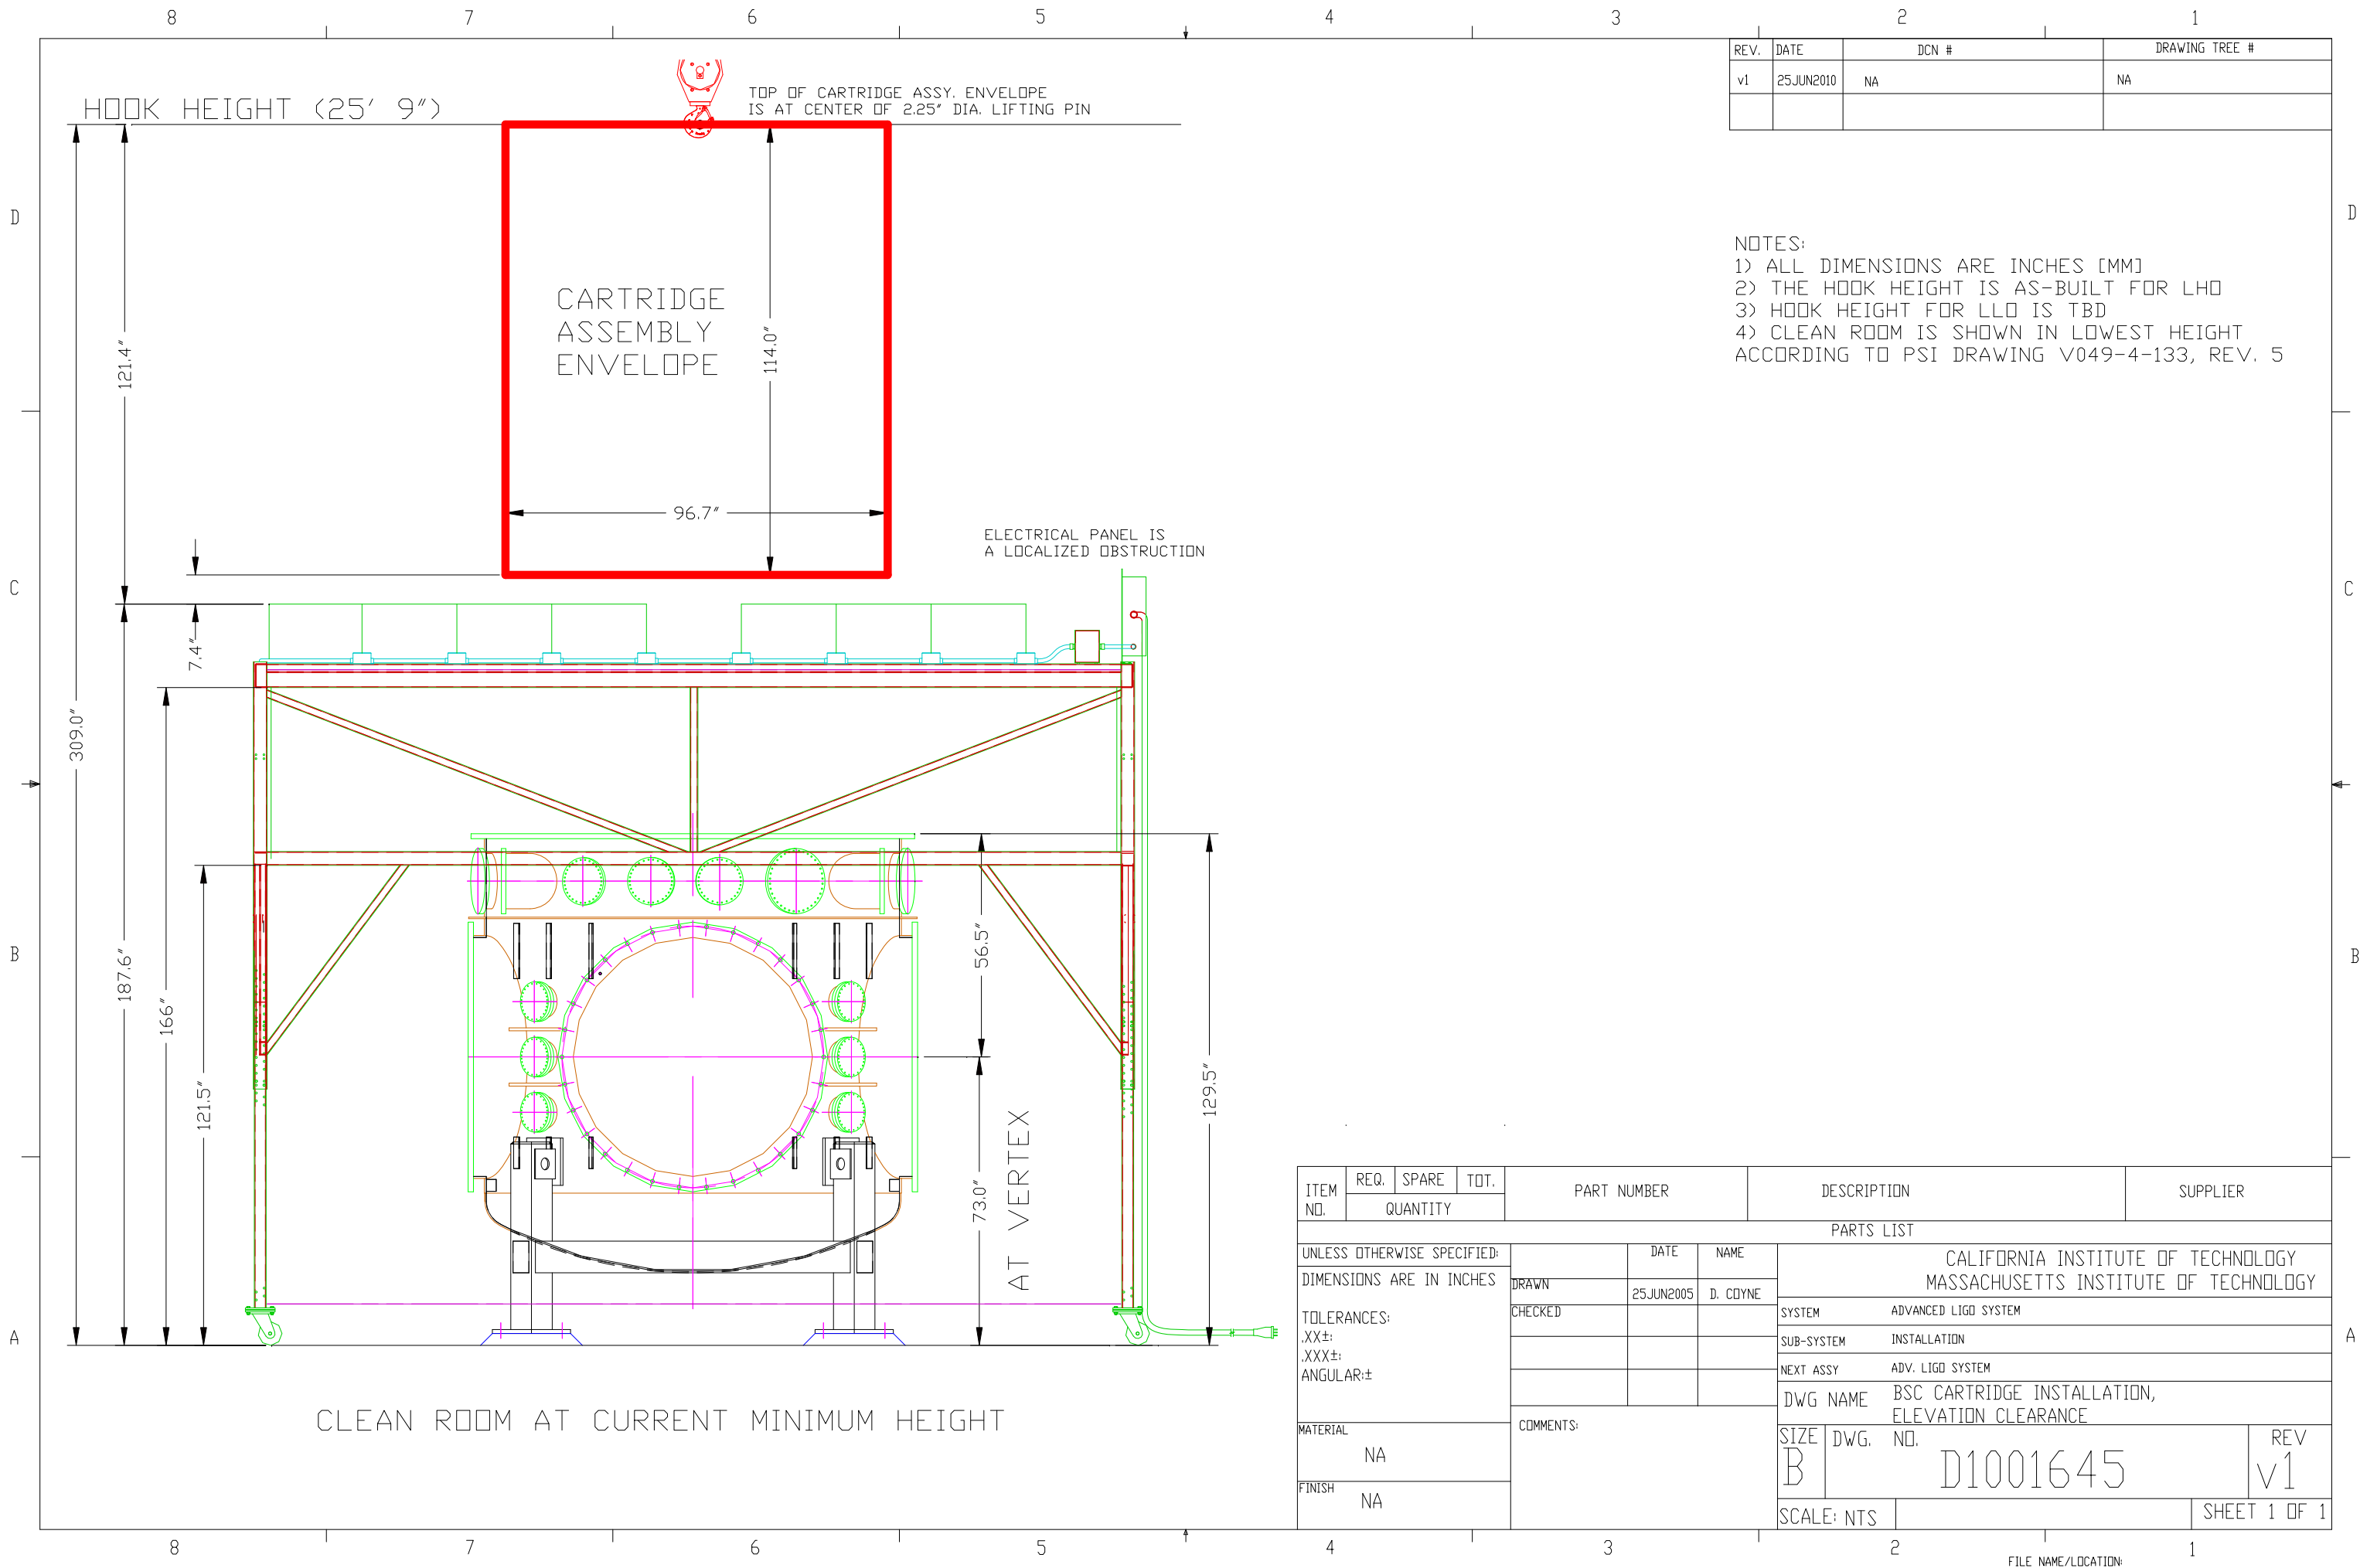

ITEM NO.	REQ. QUANTITY	SPARE	TOT.	PART NUMBER	DESCRIPTION	SUPPLIER
UNLESS OTHERWISE SPECIFIED: DIMENSIONS ARE IN INCHES						
TOLERANCES:		DRAWN		DATE	NAME	CALIFORNIA INSTITUTE OF TECHNOLOGY MASSACHUSETTS INSTITUTE OF TECHNOLOGY SYSTEM ADVANCED LIGO SYSTEM SUB-SYSTEM INSTALLATION NEXT ASSY ADV. LIGO SYSTEM DWG NAME BSC CARTRIDGE INSTALLATION, ELEVATION CLEARANCE SIZE DWG. NO. D1001645 REV v1
.XX±:	CHECKED		25JUN2005	D. COYNE		
.XXX±:						
ANGULAR±:						
MATERIAL	NA			COMMENTS:		
FINISH	NA					
SCALE: NTS						SHEET 1 OF 1