


Put (1) E parts here.

L160-D950136-SH-V  
OCT 18/95  
John Woden  
PRELIMINARY

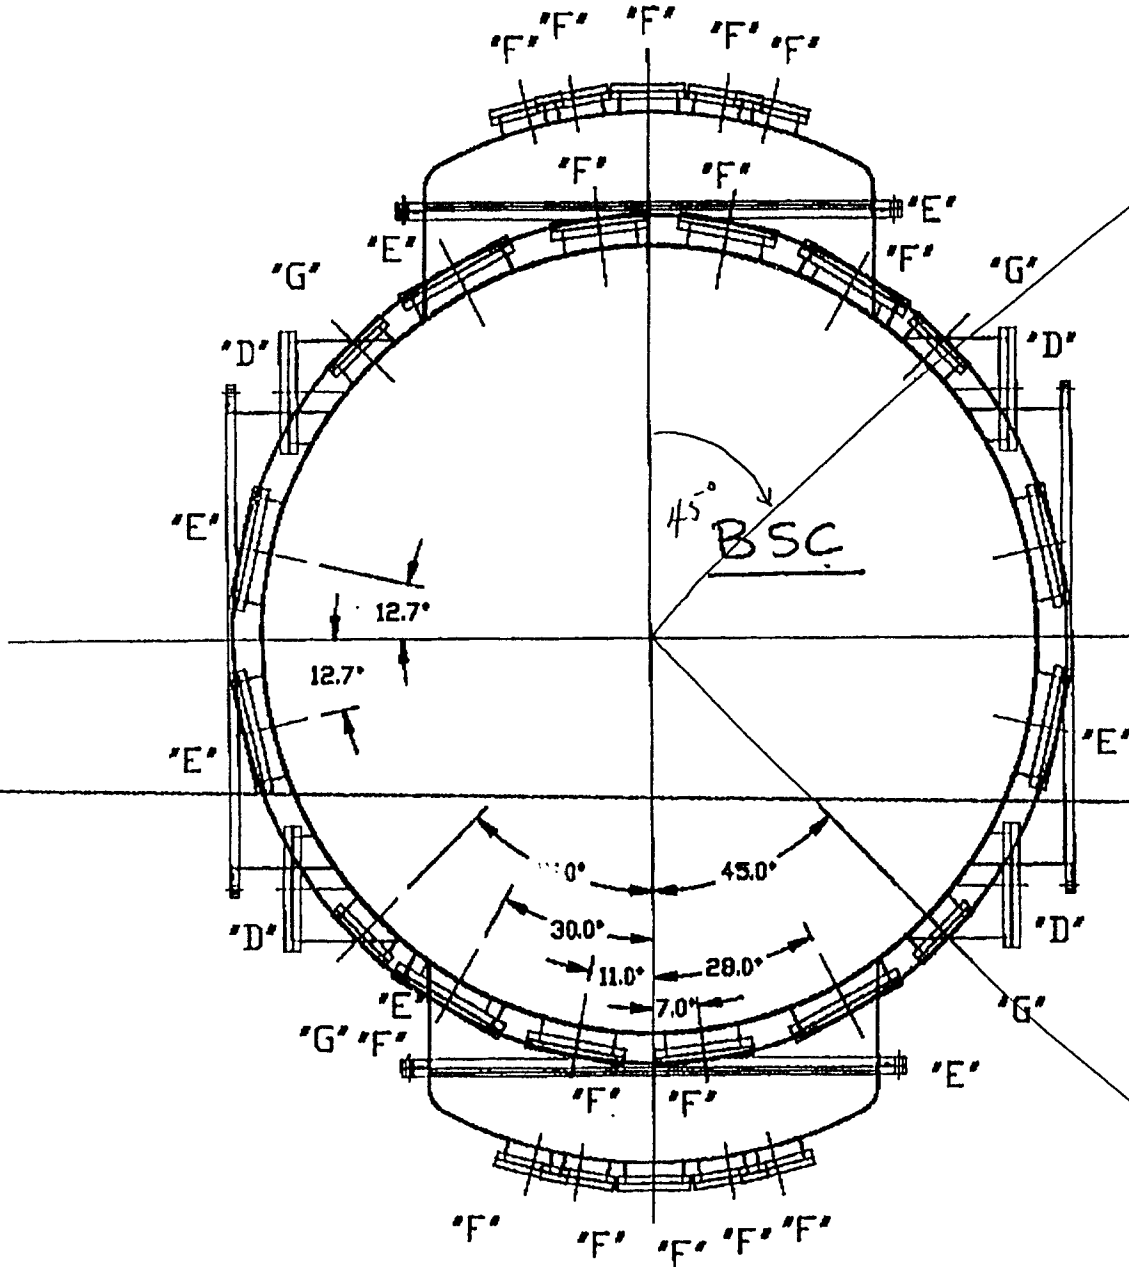

PLAN -A-A

Put (1) E part here