


LASER INTERFEROMETER GRAVITATIONAL-WAVE OBSERVATORY

BEAM TUBE ENCLOSURE SITEWORK AND PRECAST FABRICATION ISSUED FOR AS BUILT

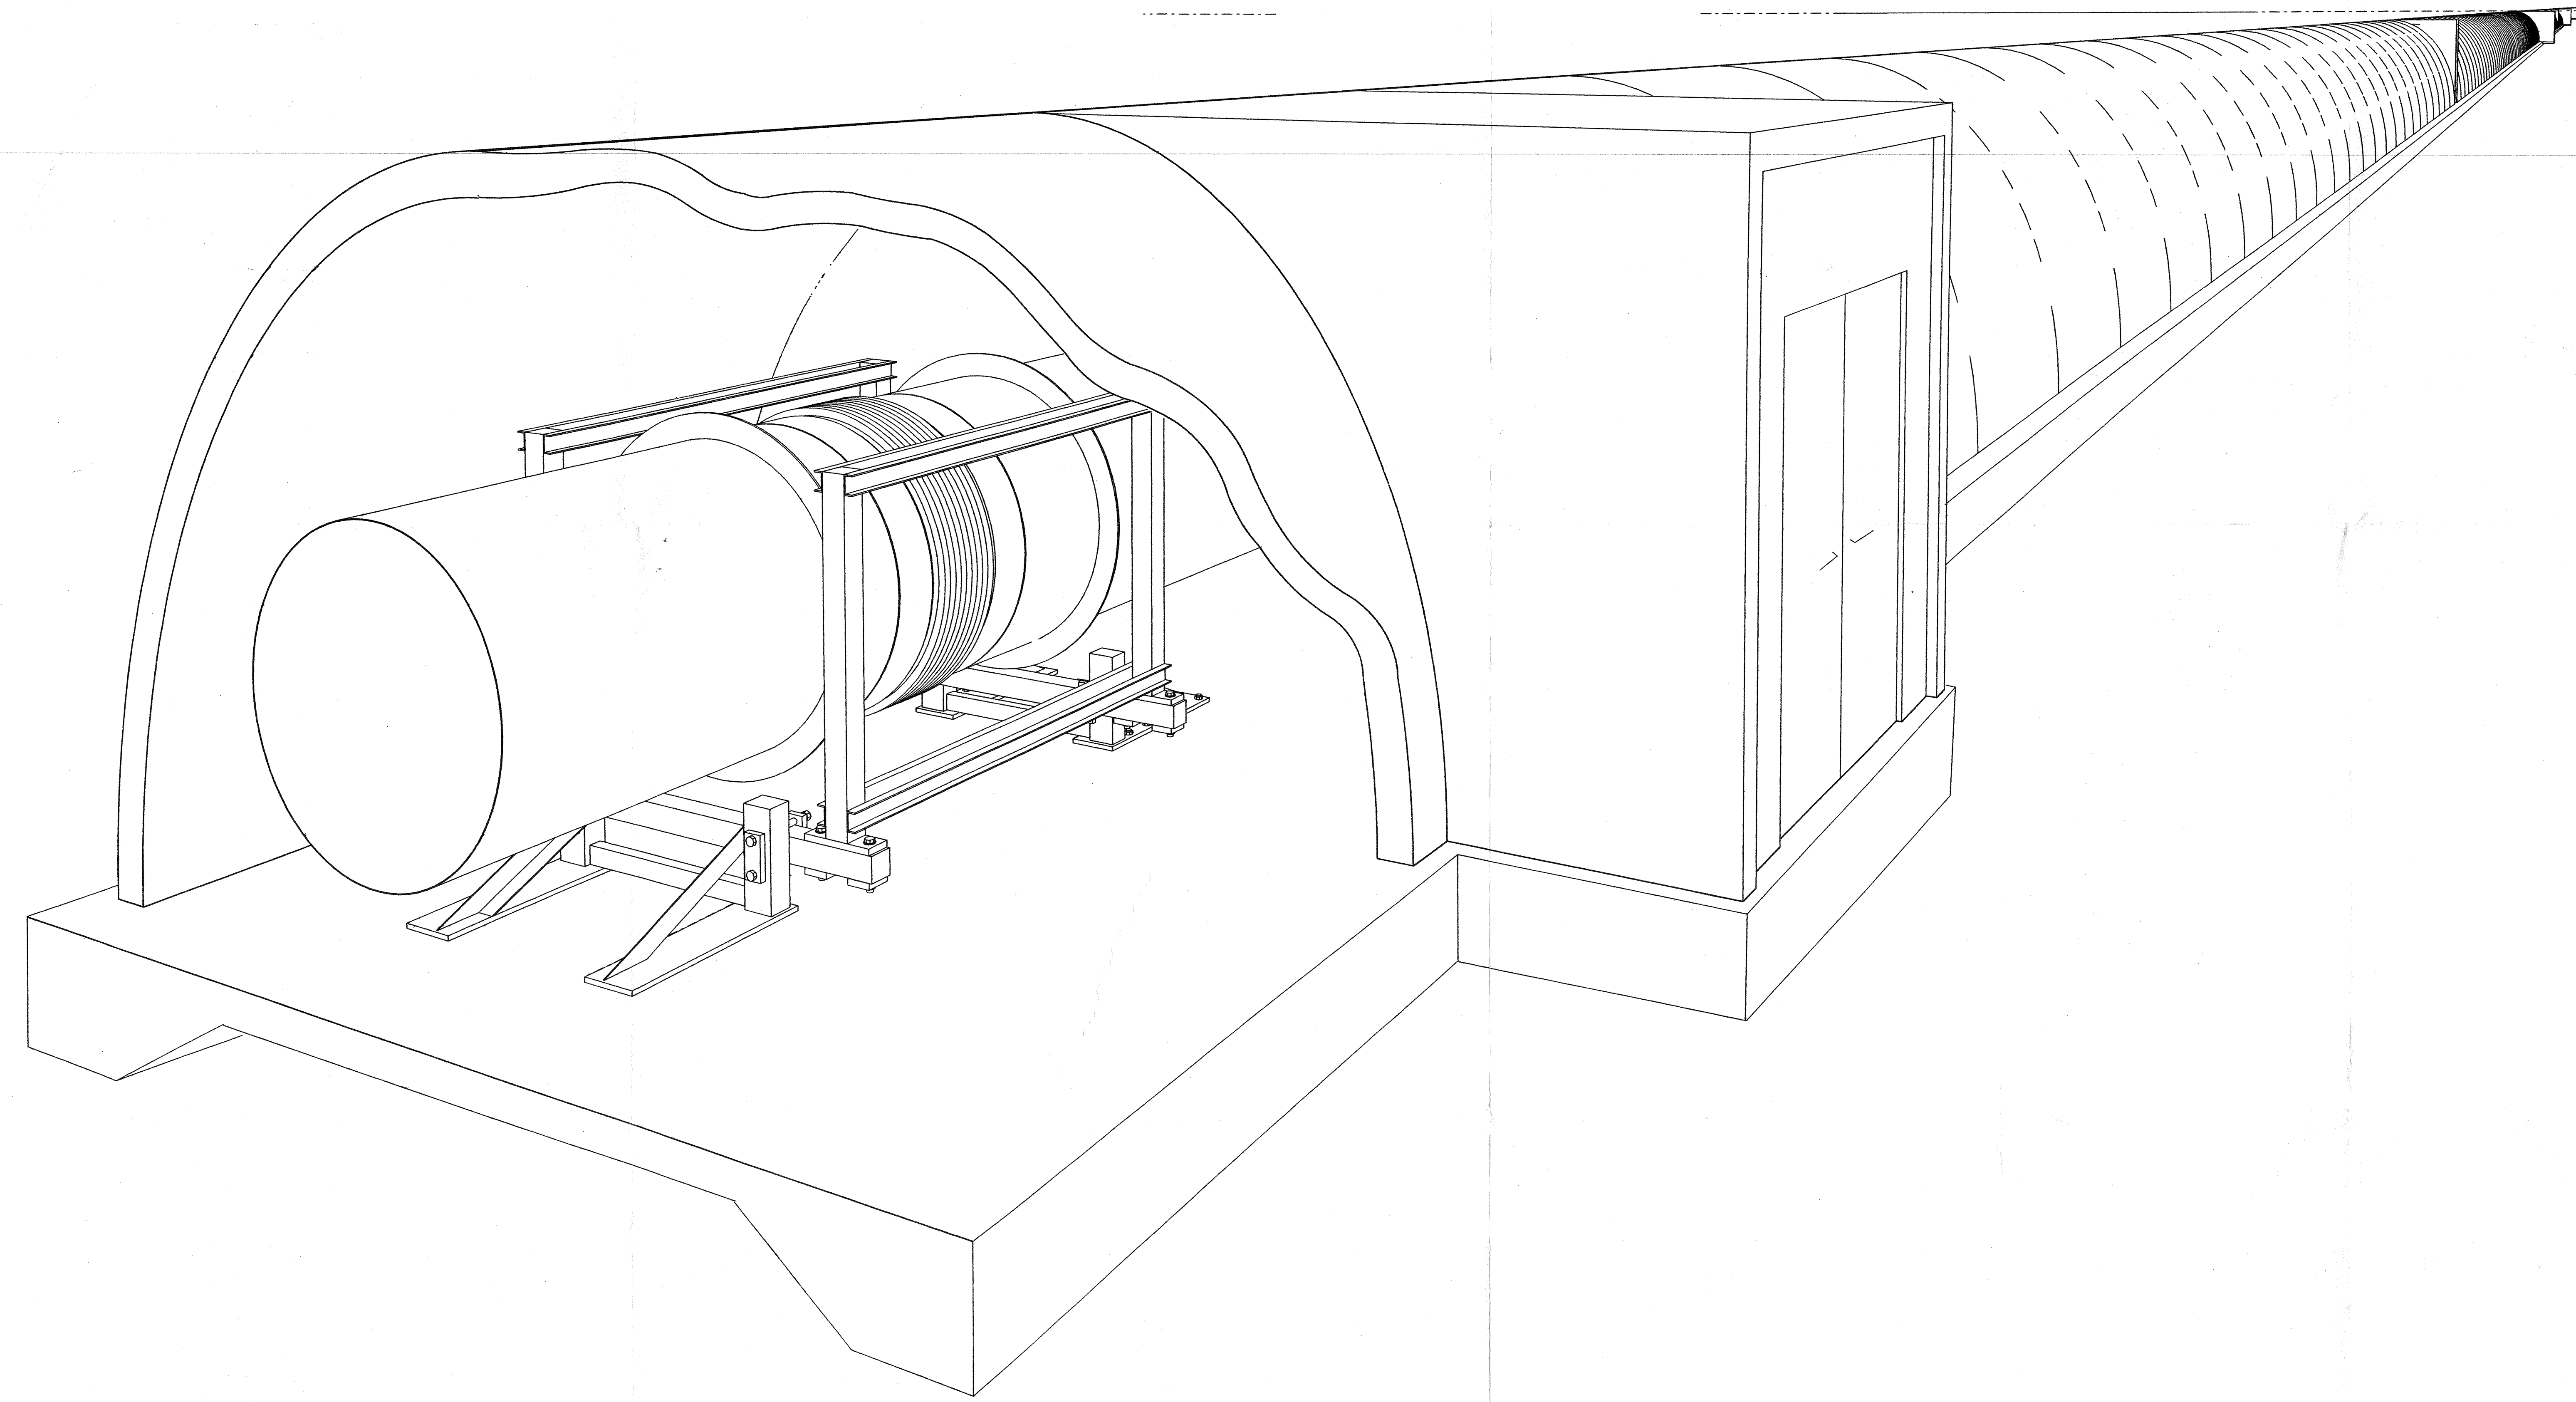

This document and the design it covers are the property of PARSONS. They are loaned only with the borrower's expressed written agreement that they will not be reproduced, copied, loaned, exhibited, or used in any other way, except by written consent from PARSONS to the borrower.

LIGO-D960160-01-O

NO.	DATE	BY	CHKD	ENGR	PROJ	DESCRIPTION
1	1-22-99	MEI	--	--	MDW	ISSUED FOR AS BUILT

ISSUED FOR CONSTRUCTION		
DRAWN	RGC	1-19-96
CHECKED		
ENGINEER		
PROJ	MDW	1-19-96
AS-BUILT DRAWINGS		


PARSONS
 100 WEST WALNUT STREET
 PASADENA, CALIFORNIA


LIGO
 CALIFORNIA INSTITUTE OF TECHNOLOGY
 MASSACHUSETTS INSTITUTE OF TECHNOLOGY

LASER INTERFEROMETER
 GRAVITATIONAL-WAVE OBSERVATORY
 BTE SITEWORK & FABRICATION - HANFORD, WA

SCALE	CONTRACT NUMBER	PROJECT NUMBER
NONE	PP150969	8094
GENERAL COVER SHEET		REVISIONS BT-G-001

Thu Jan 21 17:42:42 1999 G:\PLOT\QUE\S3-V3682.DCF 52085 KAV3682.gp001.epr.f