



This document and the design it covers are the property of PARSONS. They are loaned only with the borrower's expressed written agreement that they will not be reproduced, copied, loaned, exhibited, or used in any other way, except by written consent from PARSONS to the borrower.

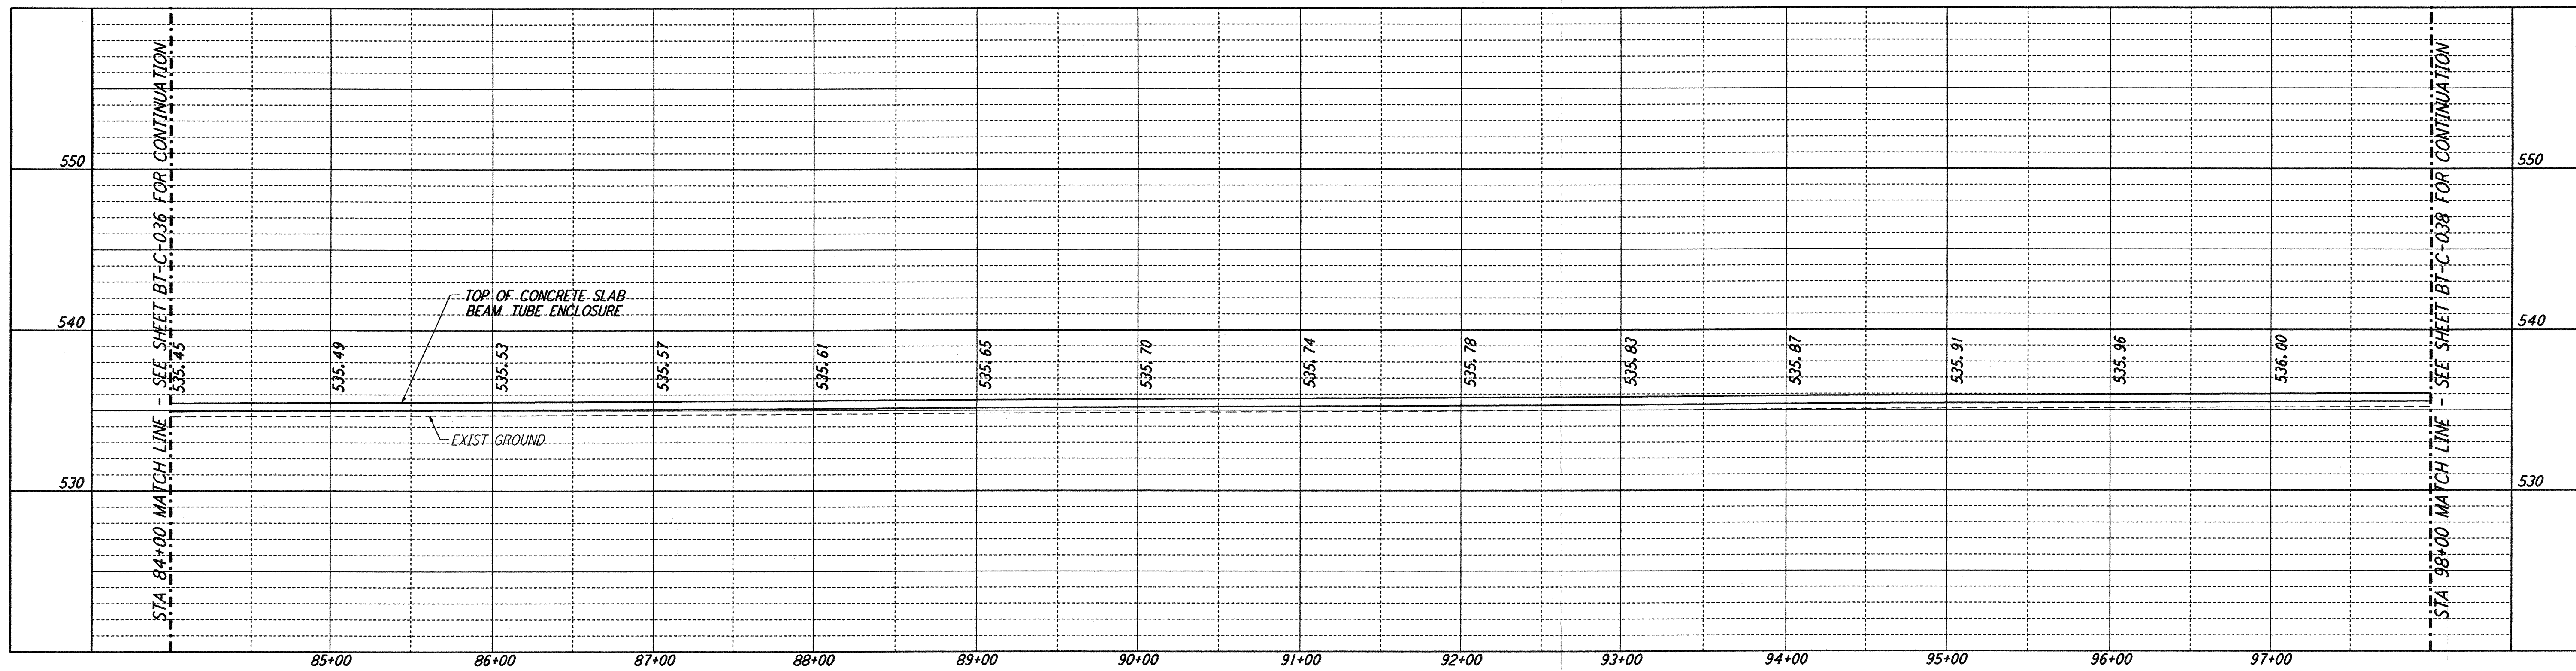


PROFILE
SCALE: HORIZ: 1" = 50'
VERT: 1" = 5'

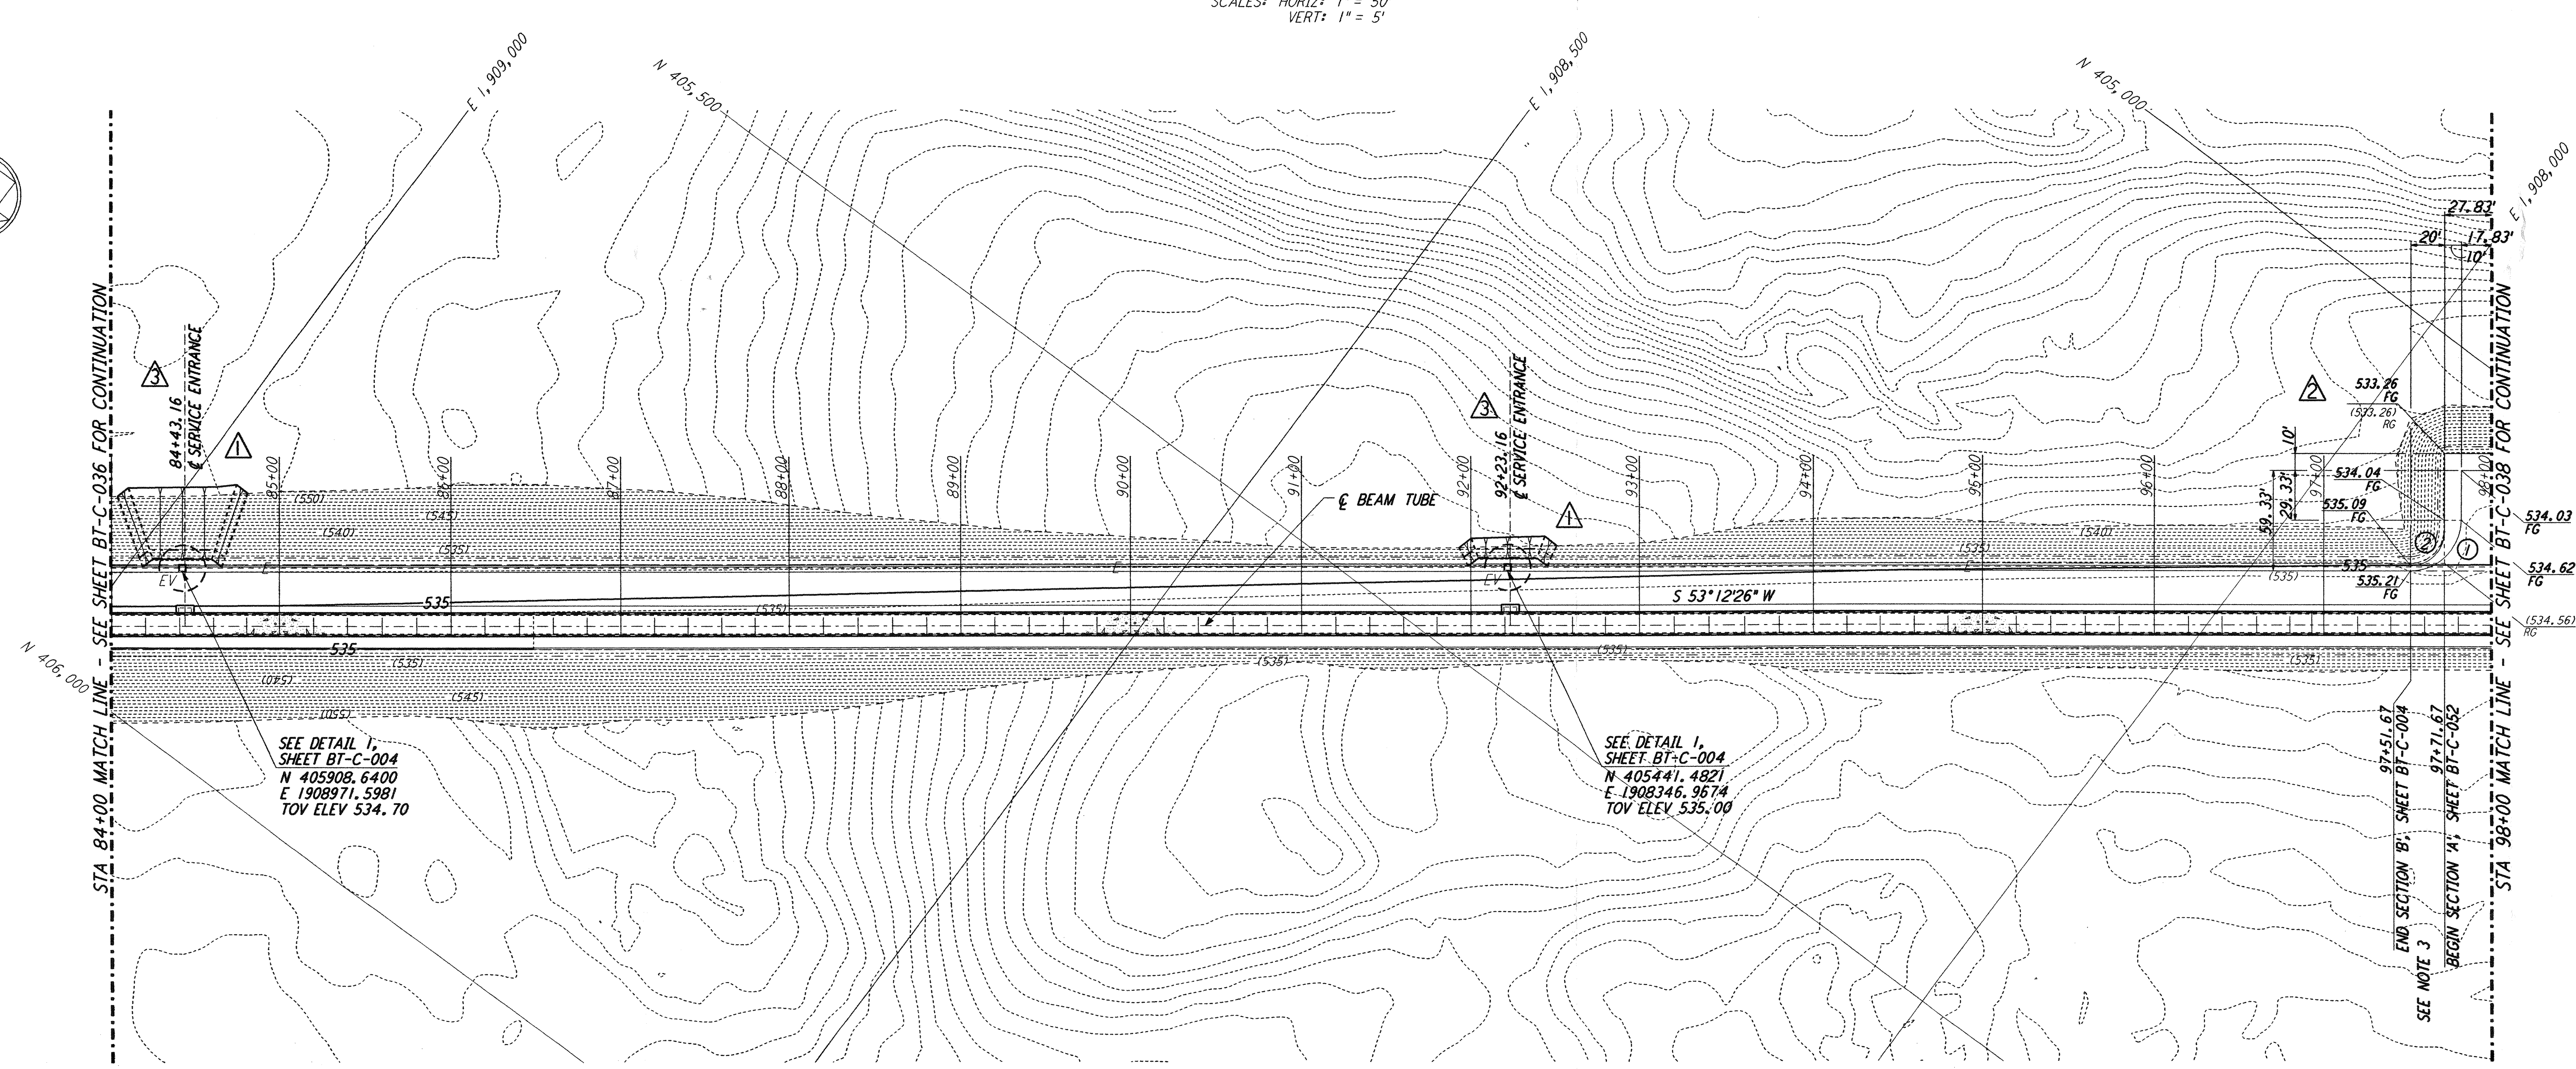


PLAN
SCALE: 1" = 50'

- NOTES:
- SEE SHEET BT-C-002 FOR GENERAL NOTES, LEGEND AND ABBREVIATIONS.
 - SEE SHEET BT-C-004 FOR TYPICAL SECTIONS AND DETAILS.
 - TRANSITION BETWEEN SECTIONS, AS SHOWN ON PLAN.

CURVE DATA				
Δ	RADIUS	LENGTH	TANGENT	
1	90°00'00"	30'	47.12'	30.00'
2	90°00'00"	20'	31.42'	20.00'

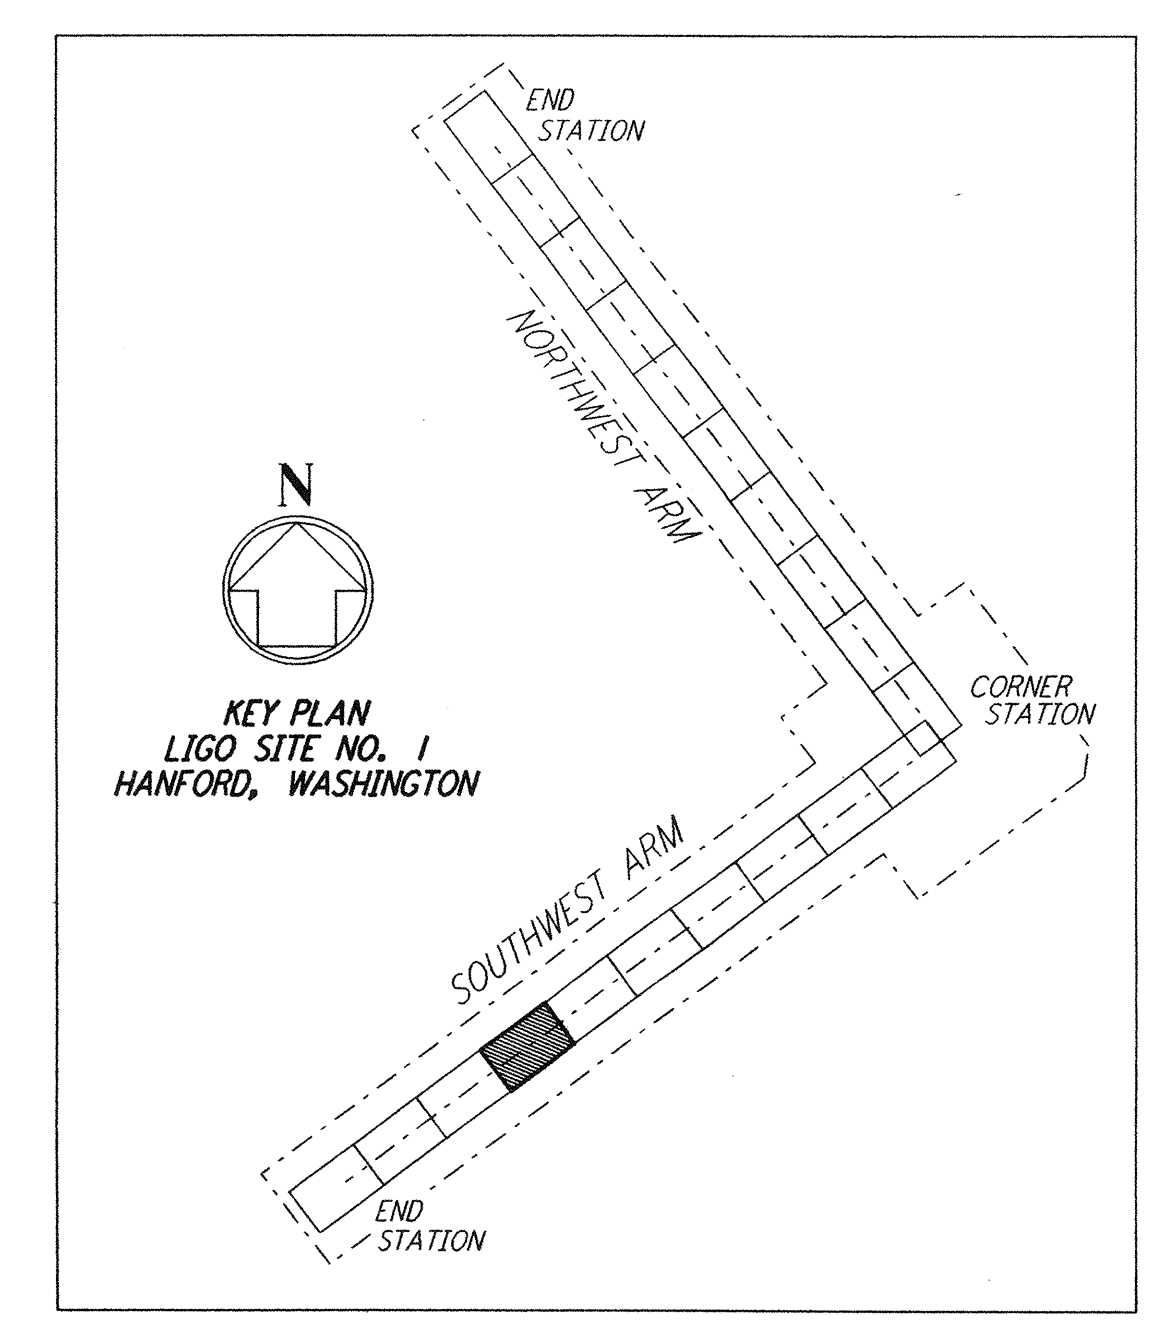

LIGO-D960182-04-O

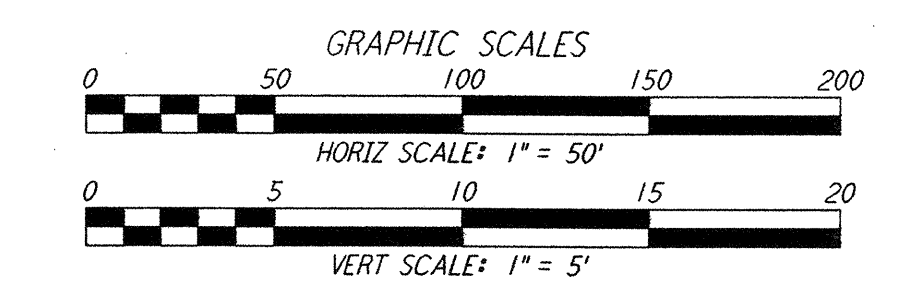

NO.	DATE	BY	CHKD	ENGR	PROJ	DESCRIPTION
4	1-22-99	MEI	--	--	MDW	ISSUED FOR AS BUILT
3	5-10-96	WRB	TDM	JB	MDW	REVISED BEAM TUBE SERVICE ENTRANCES
2	4-19-96	WRB	TDM	JB	MDW	CHANGE ORDER NO. 4
1	2-29-96	WRB	TDM	JB	MDW	CHANGE ORDER NO. 2

ISSUED FOR CONSTRUCTION		
DRAWN	WRB	1-19-96
CHECKED	MP	1-19-96
ENGINEER	JB	1-19-96
PROJ	MDW	1-19-96

AS-BUILT DRAWINGS



100 WEST WALNUT STREET
PASADENA, CALIFORNIA



CALIFORNIA INSTITUTE OF TECHNOLOGY
MASSACHUSETTS INSTITUTE OF TECHNOLOGY

LASER INTERFEROMETER
GRAVITATIONAL-WAVE OBSERVATORY
BTE SITework & FABRICATION - HANFORD, WA

TITLE	CIVIL SOUTHWEST ARM PLAN AND PROFILE STA 84+00 TO STA 98+00	SCALE	AS NOTED	CONTRACT NUMBER	PP150969	PROJECT NUMBER	8094
SHEET NUMBER	BT - C - 037	REVISIONS	4				