


NOTE:

- FOR GENERAL NOTES, ABBREVIATIONS AND LEGEND SEE DRAWING BT-S-001.
- SPACERS SHALL BE ELIMINATED WHEN EXPANSION JOINT BETWEEN PRECAST SEGMENTS IS WITHIN 4 FEET FROM THE EXPANSION JOINT IN THE FOUNDATION SLAB.
- REINFORCEMENT FOR ALL ELEMENTS OF PRECAST CONCRETE ENCLOSURES SHALL BE DESIGNED BY THE CONTRACTOR AND SHALL BE APPROVED BY THE CONSTRUCTION MANAGER. REINFORCEMENT SHOWN IS FOR BID PURPOSE ONLY.
- DIMENSIONS ARE FOR A SEMI-ELLIPTICAL CROSS SECTION. CONTRACTOR MAY SLIGHTLY DEVIATE FROM THIS SHAPE PROVIDED ALL SHOWN DIMENSIONS AND CLEARANCES ARE SATISFIED.

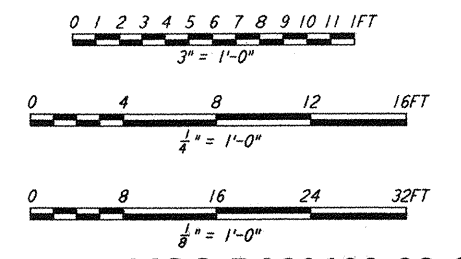

LIGO-D960189-02-O

NO.	DATE	BY	CHKD	ENGR	PROJ	DESCRIPTION
2	1-22-99	MEI			MOW	ISSUED FOR AS BUILT
1	3-25-96	TM	BP	TM		CHANGE ORDER #3

ISSUED FOR CONSTRUCTION	DRAWN	SY	1-19-96
CHECKED	RM	1-19-96	
ENGINEER	FD	1-19-96	
PROJ	MW	1-19-96	

AS-BUILT DRAWINGS

PARSONS

100 WEST WALNUT STREET
PASADENA, CALIFORNIA

LIGO

CALIFORNIA INSTITUTE OF TECHNOLOGY
MASSACHUSETTS INSTITUTE OF TECHNOLOGY

LASER INTERFEROMETER
GRAVITATIONAL-WAVE OBSERVATORY
BTE SITWORK & FABRICATION - HANFORD, WA

TITLE: **STRUCTURAL BEAM TUBE ENCLOSURE PLANS, SECTIONS & DETAILS**

SHEET NUMBER: **BT-S-003**

PROJECT NUMBER: **PP150969**

REVISION: **8094**

not be reproduced, copied, loaned, exhibited, or used in any other way, except by written consent from PARSONS to the borrower.

This document and the design it covers are the property of PARSONS. They are loaned only with the borrower's expressed written agreement that they will

Plot Jan 21 13:26:19 1999 C:\PLOT\QUE\S\SP-19862.DWG 52085 K:\V5682\418036.dwg