



This document and the design it covers are the property of PARSONS. They are loaned only with the borrower's expressed written agreement that they will not be reproduced, copied, loaned, exhibited, or used in any other way, except by written consent from PARSONS.

This document and the design it covers are the property of PARSONS. They are loaned only with the borrower's expressed written agreement that they will not be reproduced, copied, loaned, exhibited, or used in any other way, except by written consent from PARSONS.

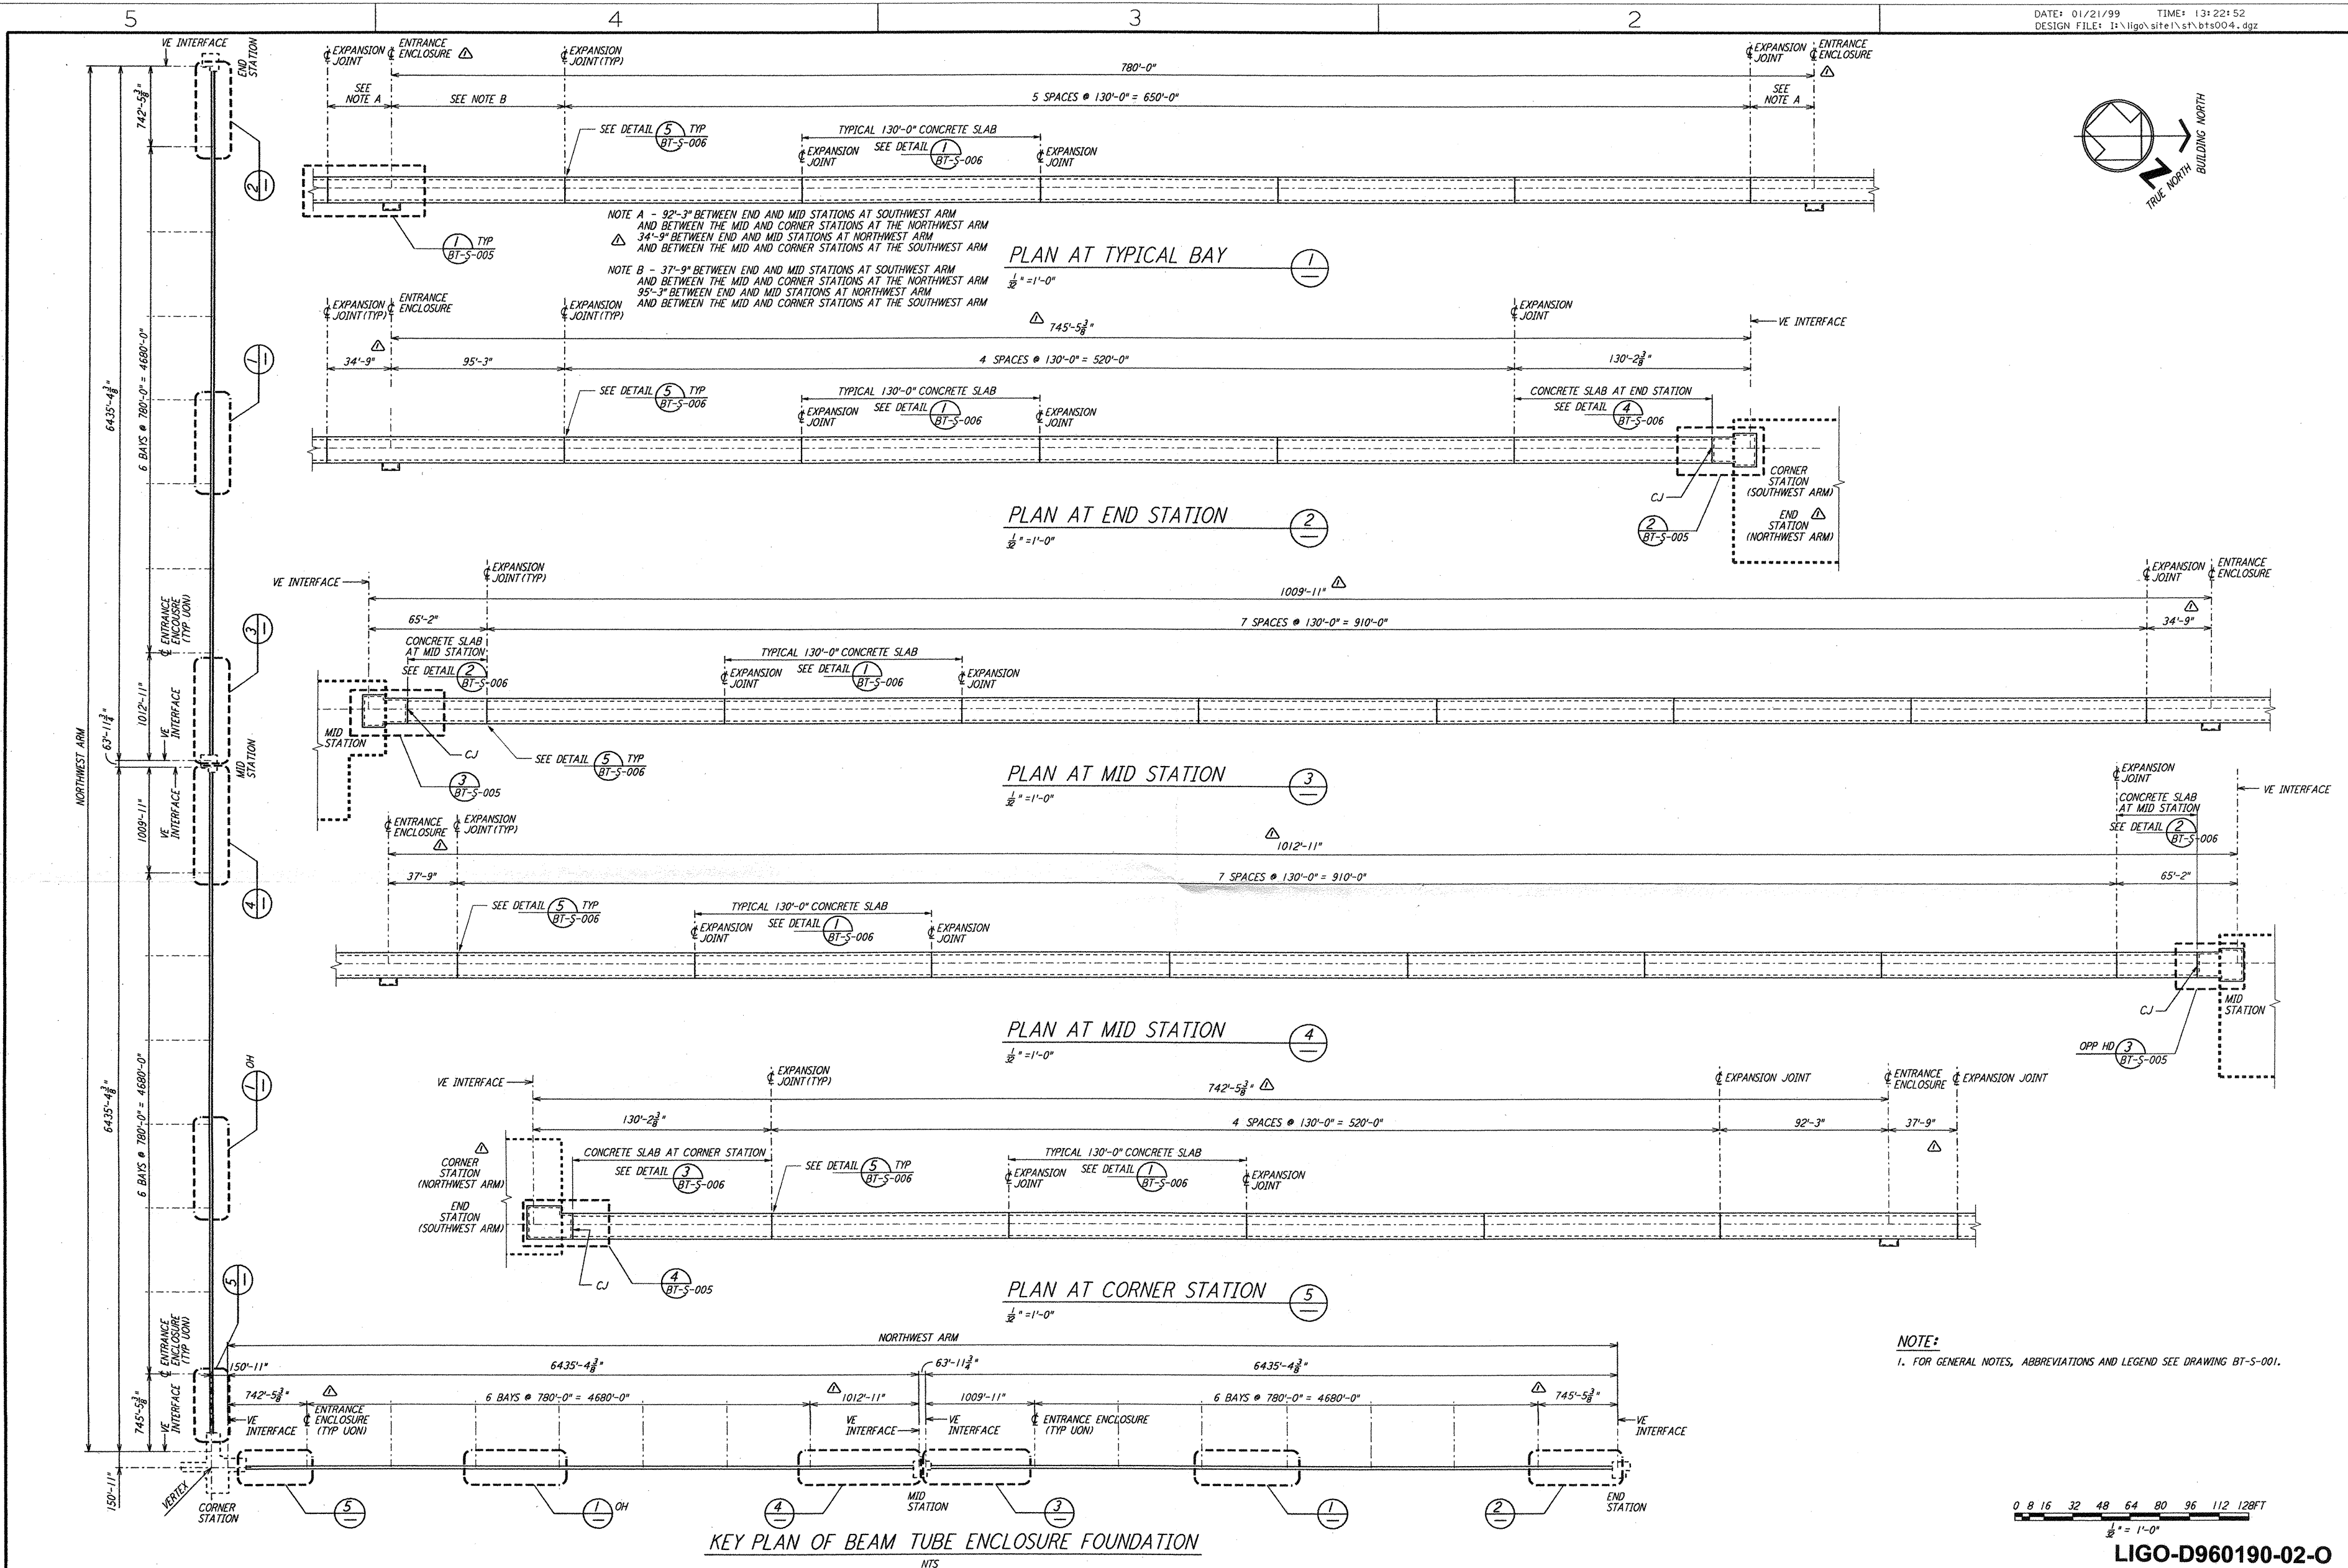

**NOTE:**  
 1. FOR GENERAL NOTES, ABBREVIATIONS AND LEGEND SEE DRAWING BT-S-001.

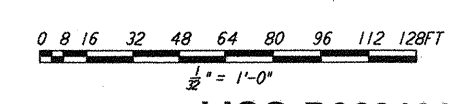

**LIGO-D960190-02-0**

NO.	DATE	CHKD	ENGR	PROJ	DESCRIPTION
2	1-22-99	MET		MDW	ISSUED FOR AS BUILT
1	3-25-96	TM	BP	TM	CHANGE ORDER #3

NO.	DATE	CHKD	ENGR	PROJ	DESCRIPTION
1	1-19-96	SH			ISSUED FOR CONSTRUCTION
2	1-19-96	RM			CHECKED
3	1-19-96	FD			ENGINEER
4	1-19-96	MW			PROJ

**AS-BUILT DRAWINGS**

**PARSONS**  
 100 WEST WALNUT STREET  
 PASADENA, CALIFORNIA

**LIGO**  
 CALIFORNIA INSTITUTE OF TECHNOLOGY  
 MASSACHUSETTS INSTITUTE OF TECHNOLOGY

LASER INTERFEROMETER  
 GRAVITATIONAL-WAVE OBSERVATORY  
 BTE SITWORK & FABRICATION - HANFORD, WA

TITLE: STRUCTURAL KEY PLAN OF BEAM TUBE ENCLOSURE FDN & PARTIAL ENLARGED PLANS  
 AS NOTED PPI50969 8094  
**BT-S-004**

No. Jan 21 13:22:52 1999 C:\PLOT\JOB\33-1662\25F 52885 K:\V382\18046.prf LIG00TF.BDR