

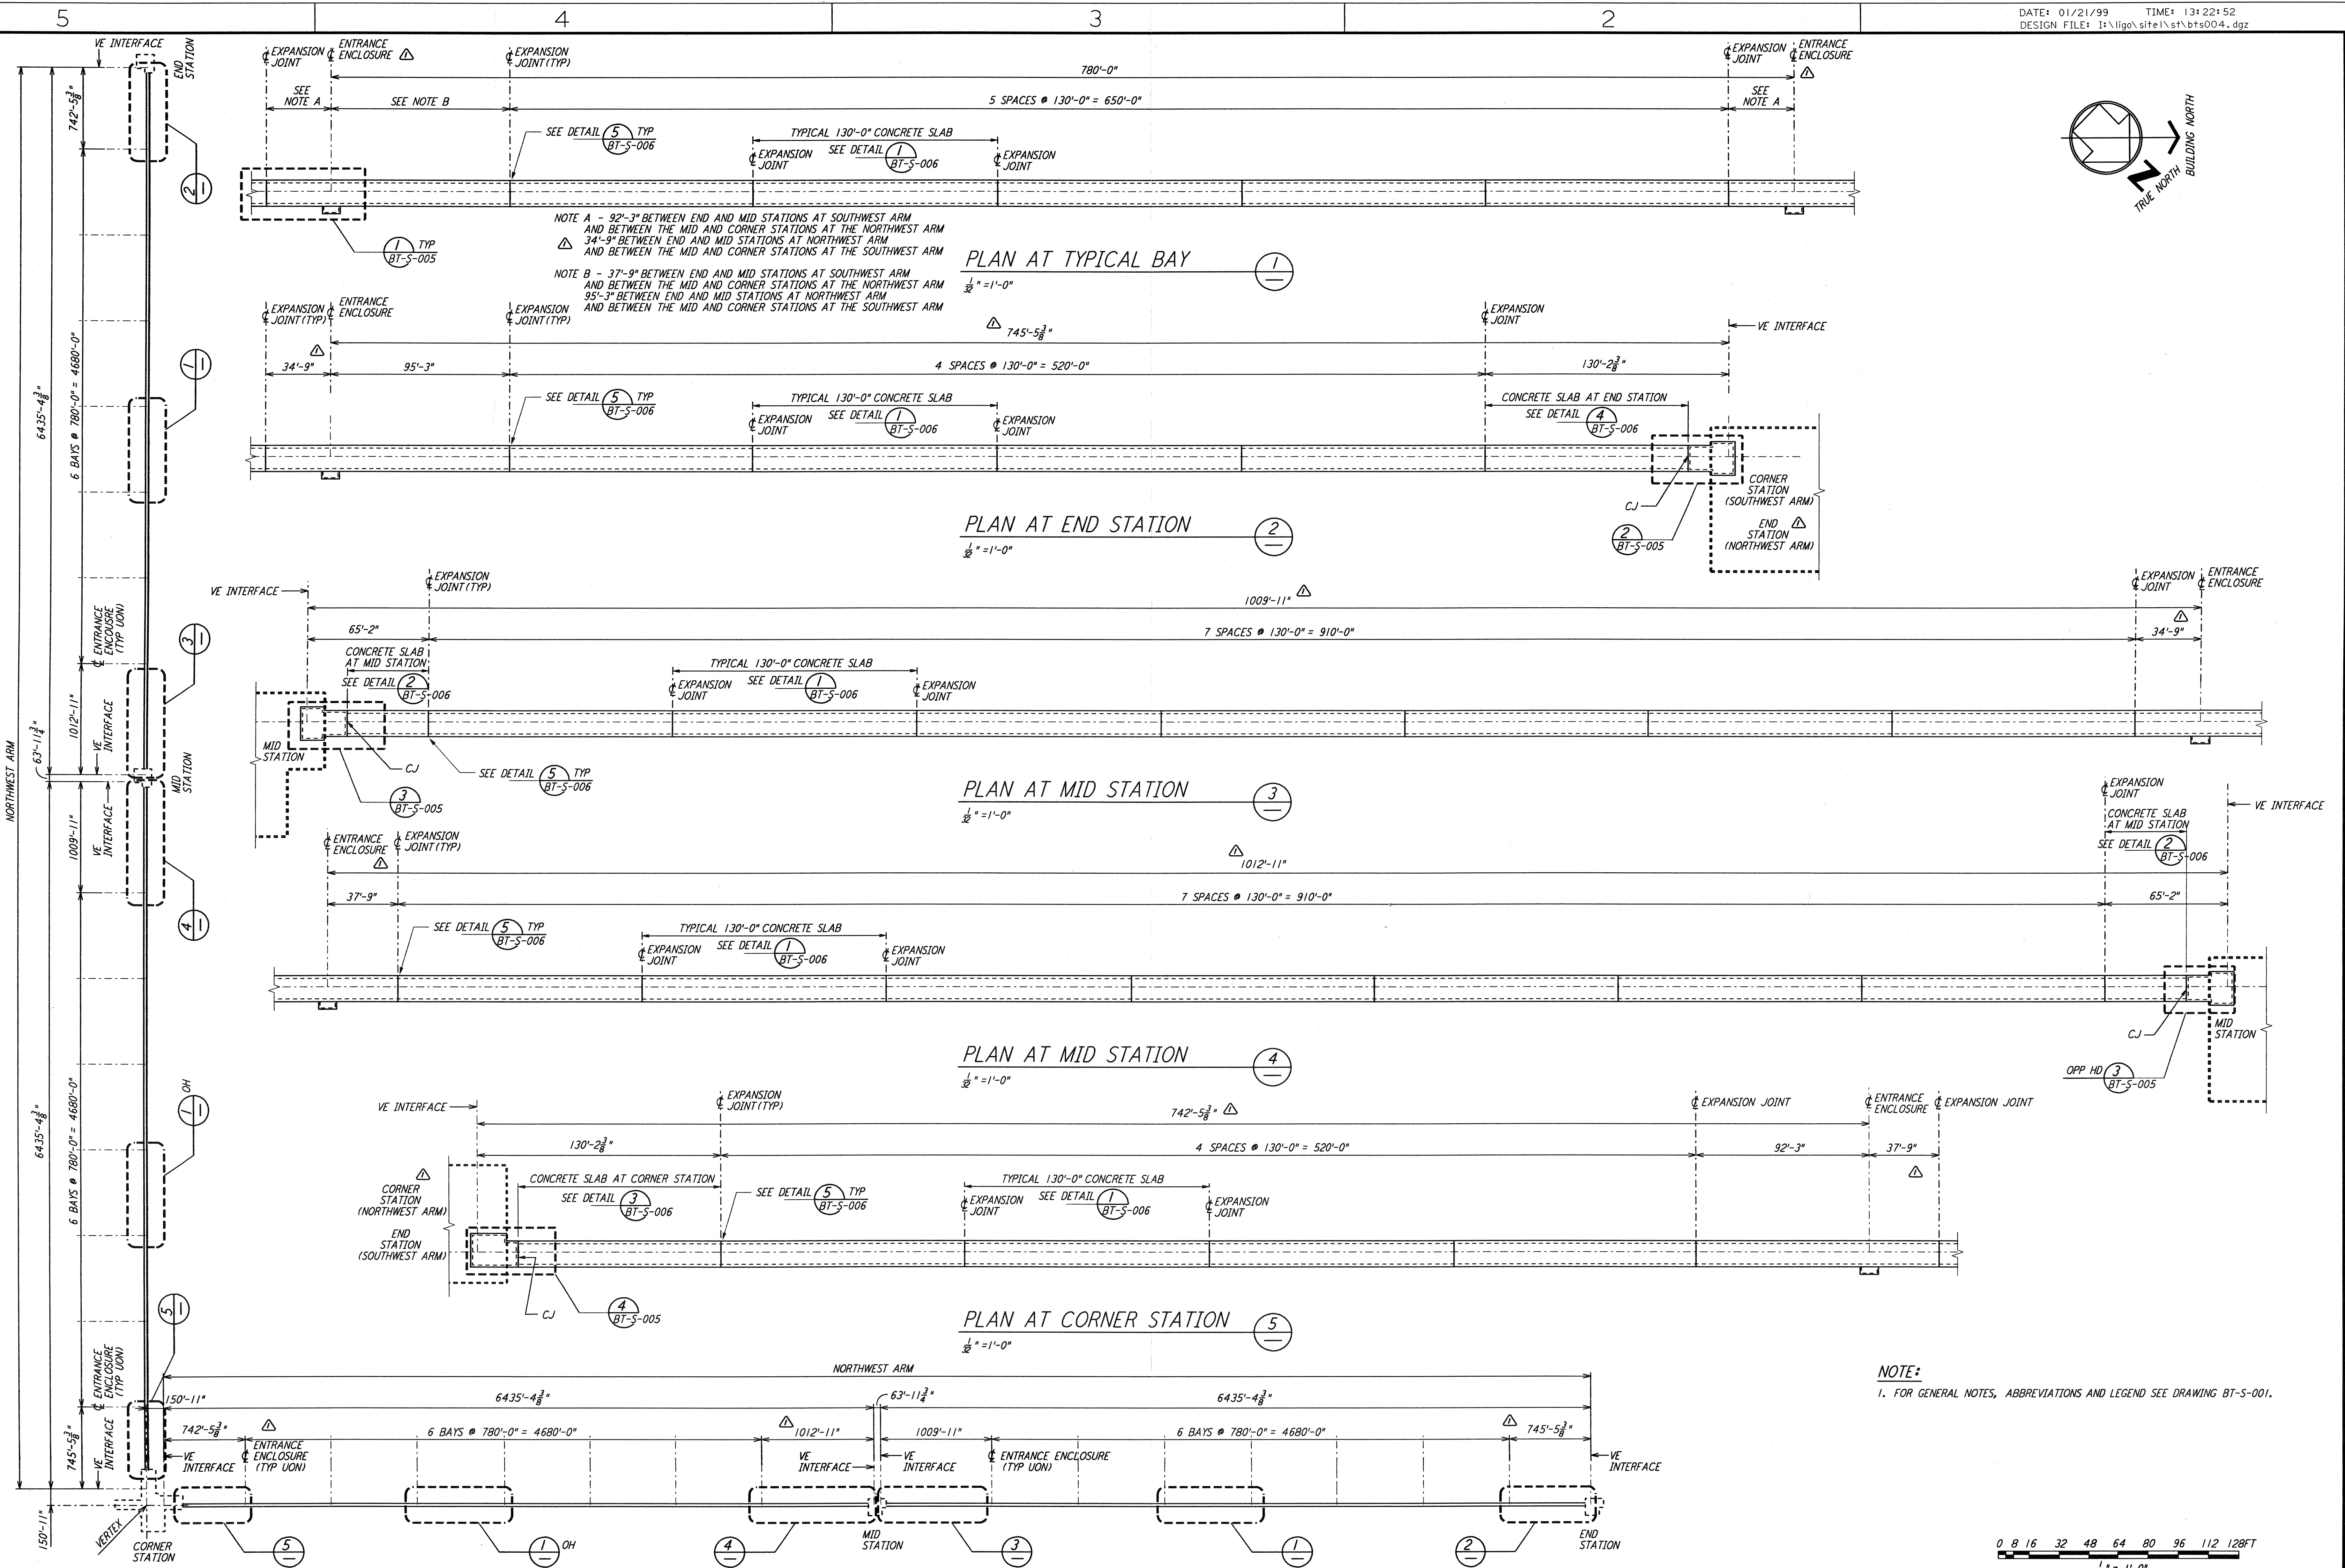


This document and the design it covers are the property of PARSONS. They are loaned only with the borrower's expressed written agreement that they will not be reproduced, copied, loaned, exhibited, or used in any other way, except by written consent from PARSONS to the borrower.

This document and the design it covers are the property of PARSONS. They are loaned only with the borrower's expressed written agreement that they will not be reproduced, copied, loaned, exhibited, or used in any other way, except by written consent from PARSONS to the borrower.

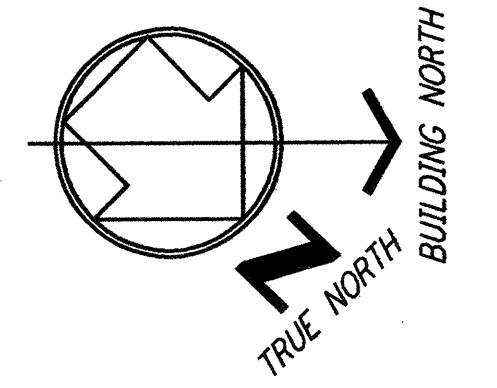

**NOTE:**  
 1. FOR GENERAL NOTES, ABBREVIATIONS AND LEGEND SEE DRAWING BT-S-001.

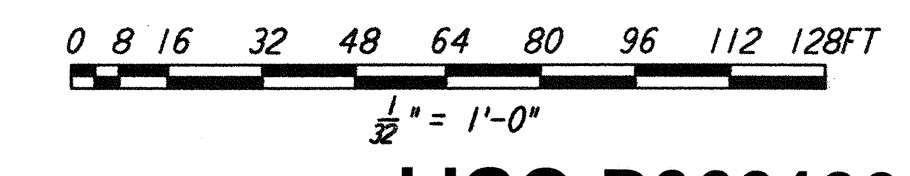

**LIGO-D960190-02-O**

NO.	DATE	BY	CHKD	ENGR	PROJ	DESCRIPTION
2	1-22-99	MET			MDW	ISSUED FOR AS BUILT
1	3-25-96	TM	BP	TM		CHANGE ORDER #3

ISSUED FOR CONSTRUCTION  
 DRAWN SH 1-19-96  
 CHECKED RM 1-19-96  
 ENGINEER FD 1-19-96  
 PROJ MW 1-19-96

**AS-BUILT DRAWINGS**

**PARSONS**  
 100 WEST WALNUT STREET  
 PASADENA, CALIFORNIA

**LIGO**  
 CALIFORNIA INSTITUTE OF TECHNOLOGY  
 MASSACHUSETTS INSTITUTE OF TECHNOLOGY

LASER INTERFEROMETER  
 GRAVITATIONAL-WAVE OBSERVATORY  
 BTE SITWORK & FABRICATION - HANFORD, WA

TITLE: **STRUCTURAL KEY PLAN OF BEAM TUBE ENCLOSURE FDN & PARTIAL ENLARGED PLANS**

AS NOTED PPI 50969 8094  
**BT-S-004**