




This document and the design it covers are the property of PARSONS. They are loaned only with the borrower's expressed written agreement that they will not be reproduced, copied, loaned, exhibited, or used in any other way, except by written consent from PARSONS to the borrower.

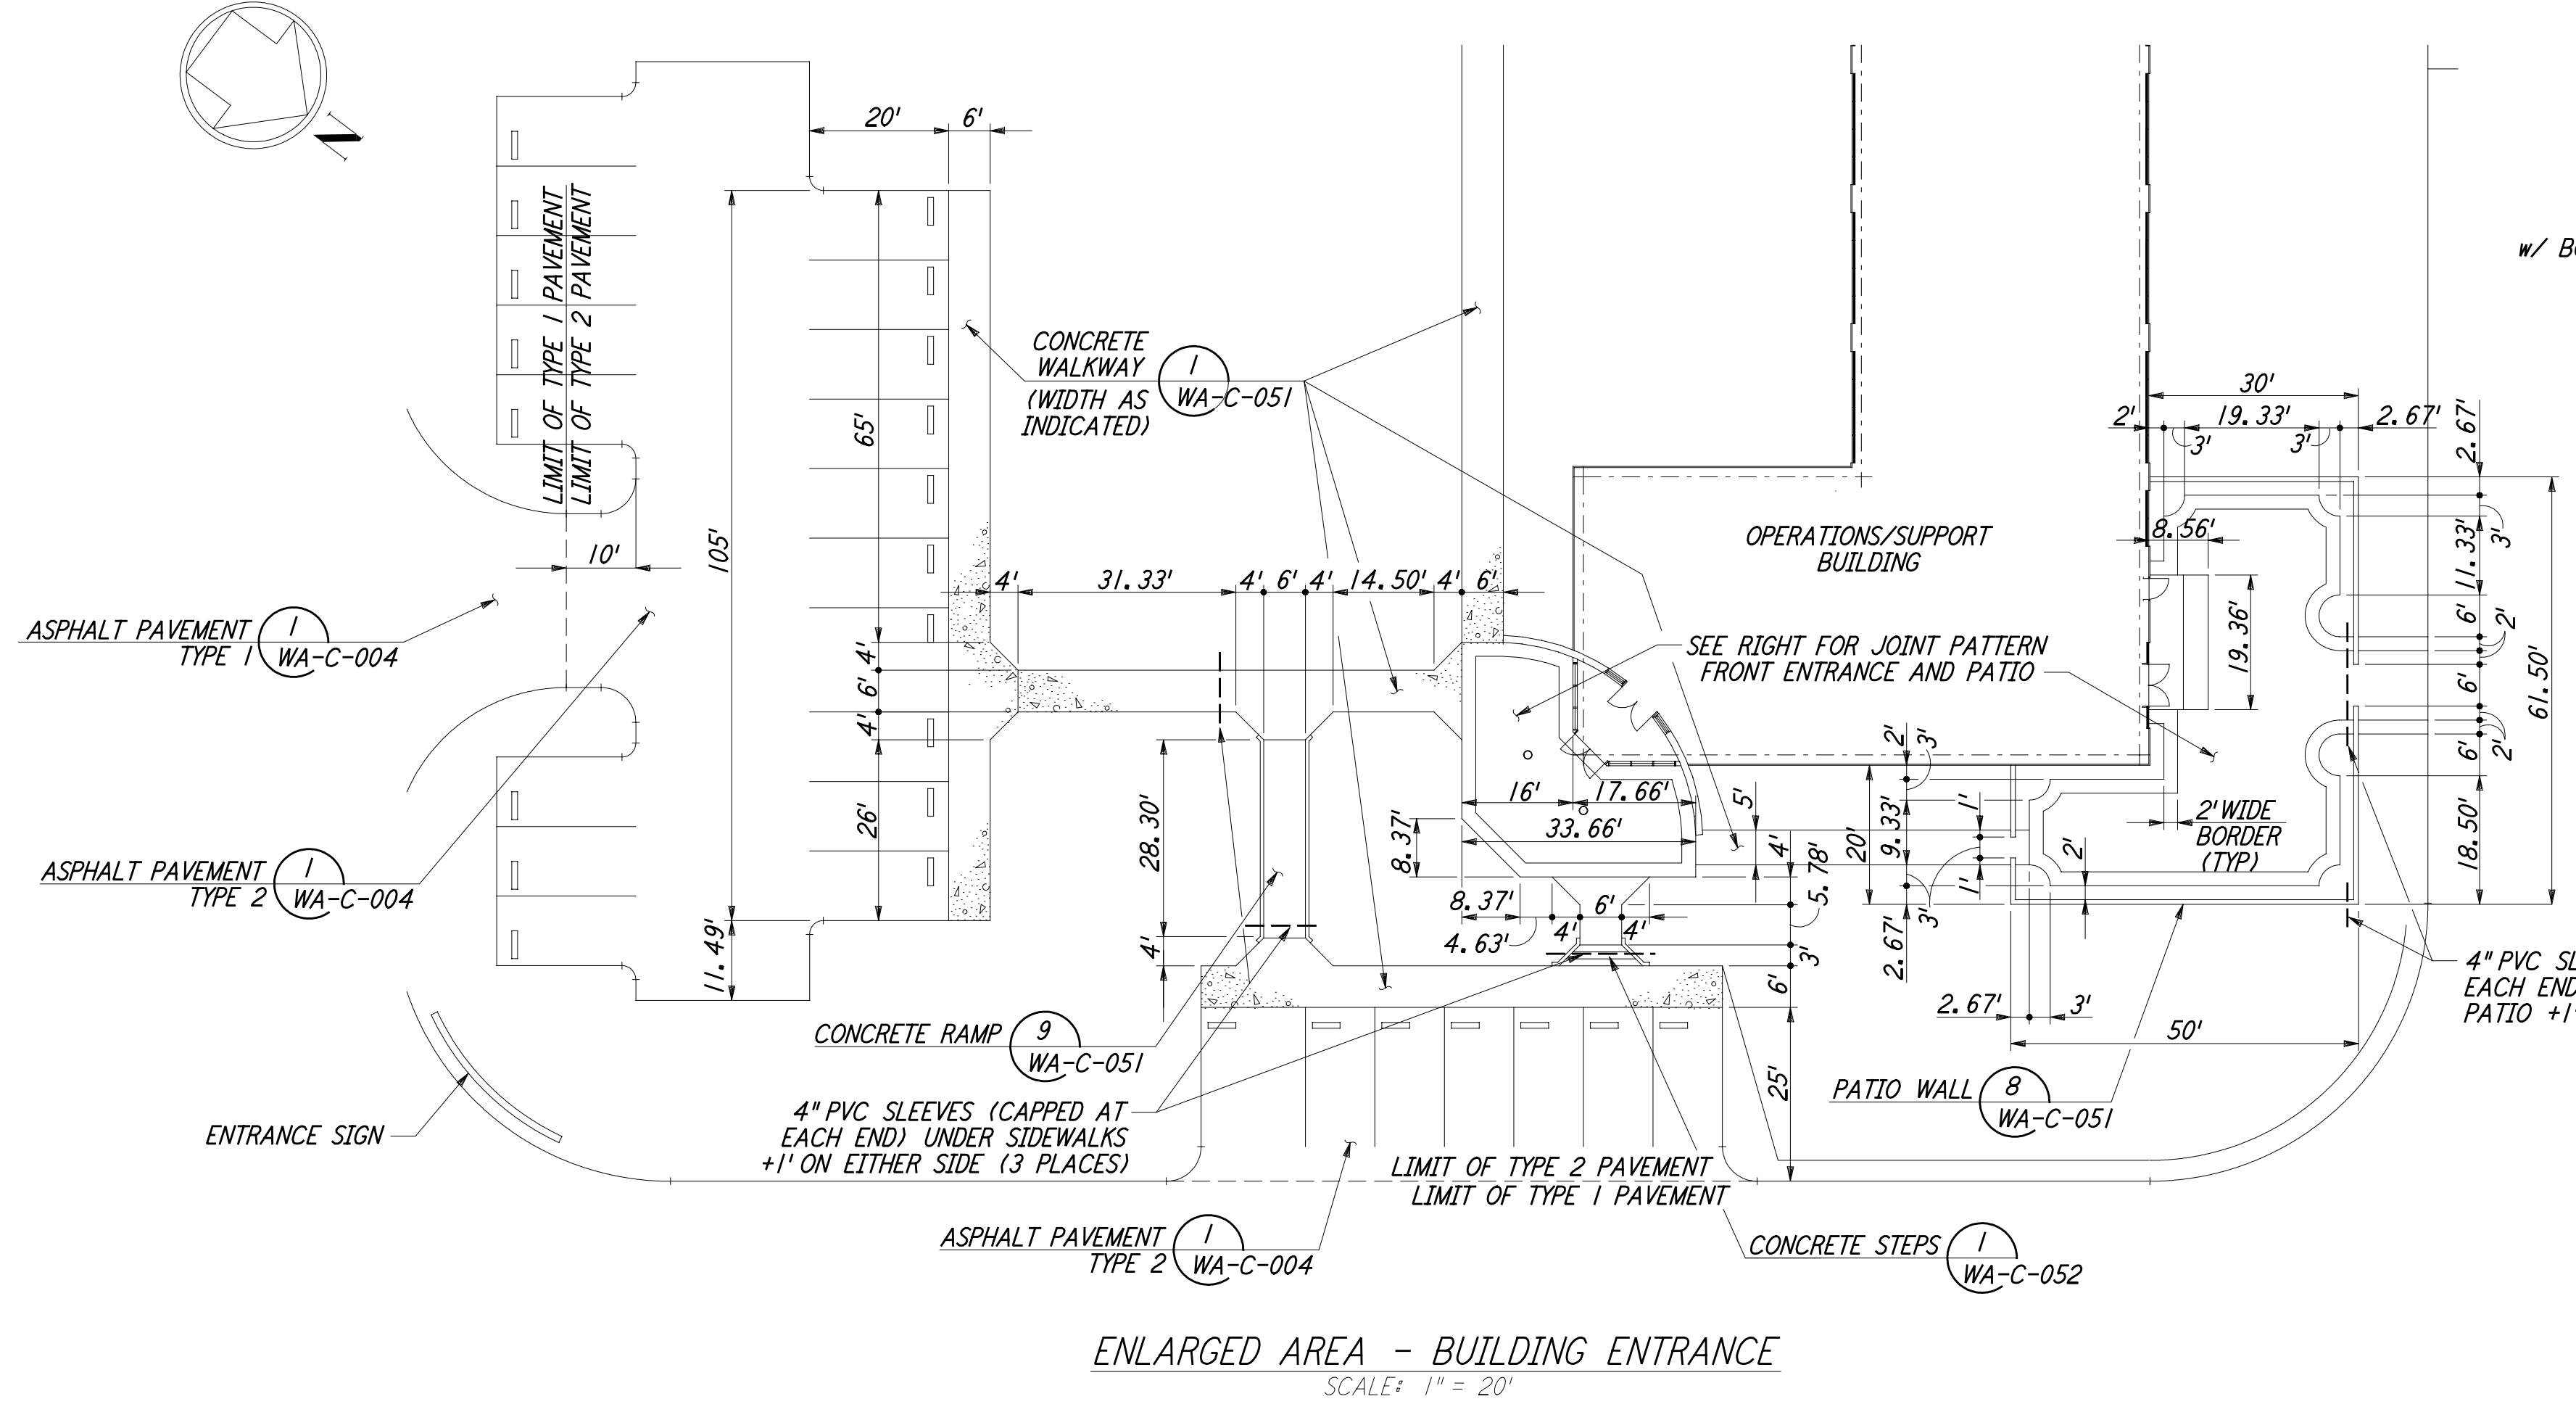


ENLARGED AREA - BUILDING ENTRANCE
 SCALE: 1" = 20"

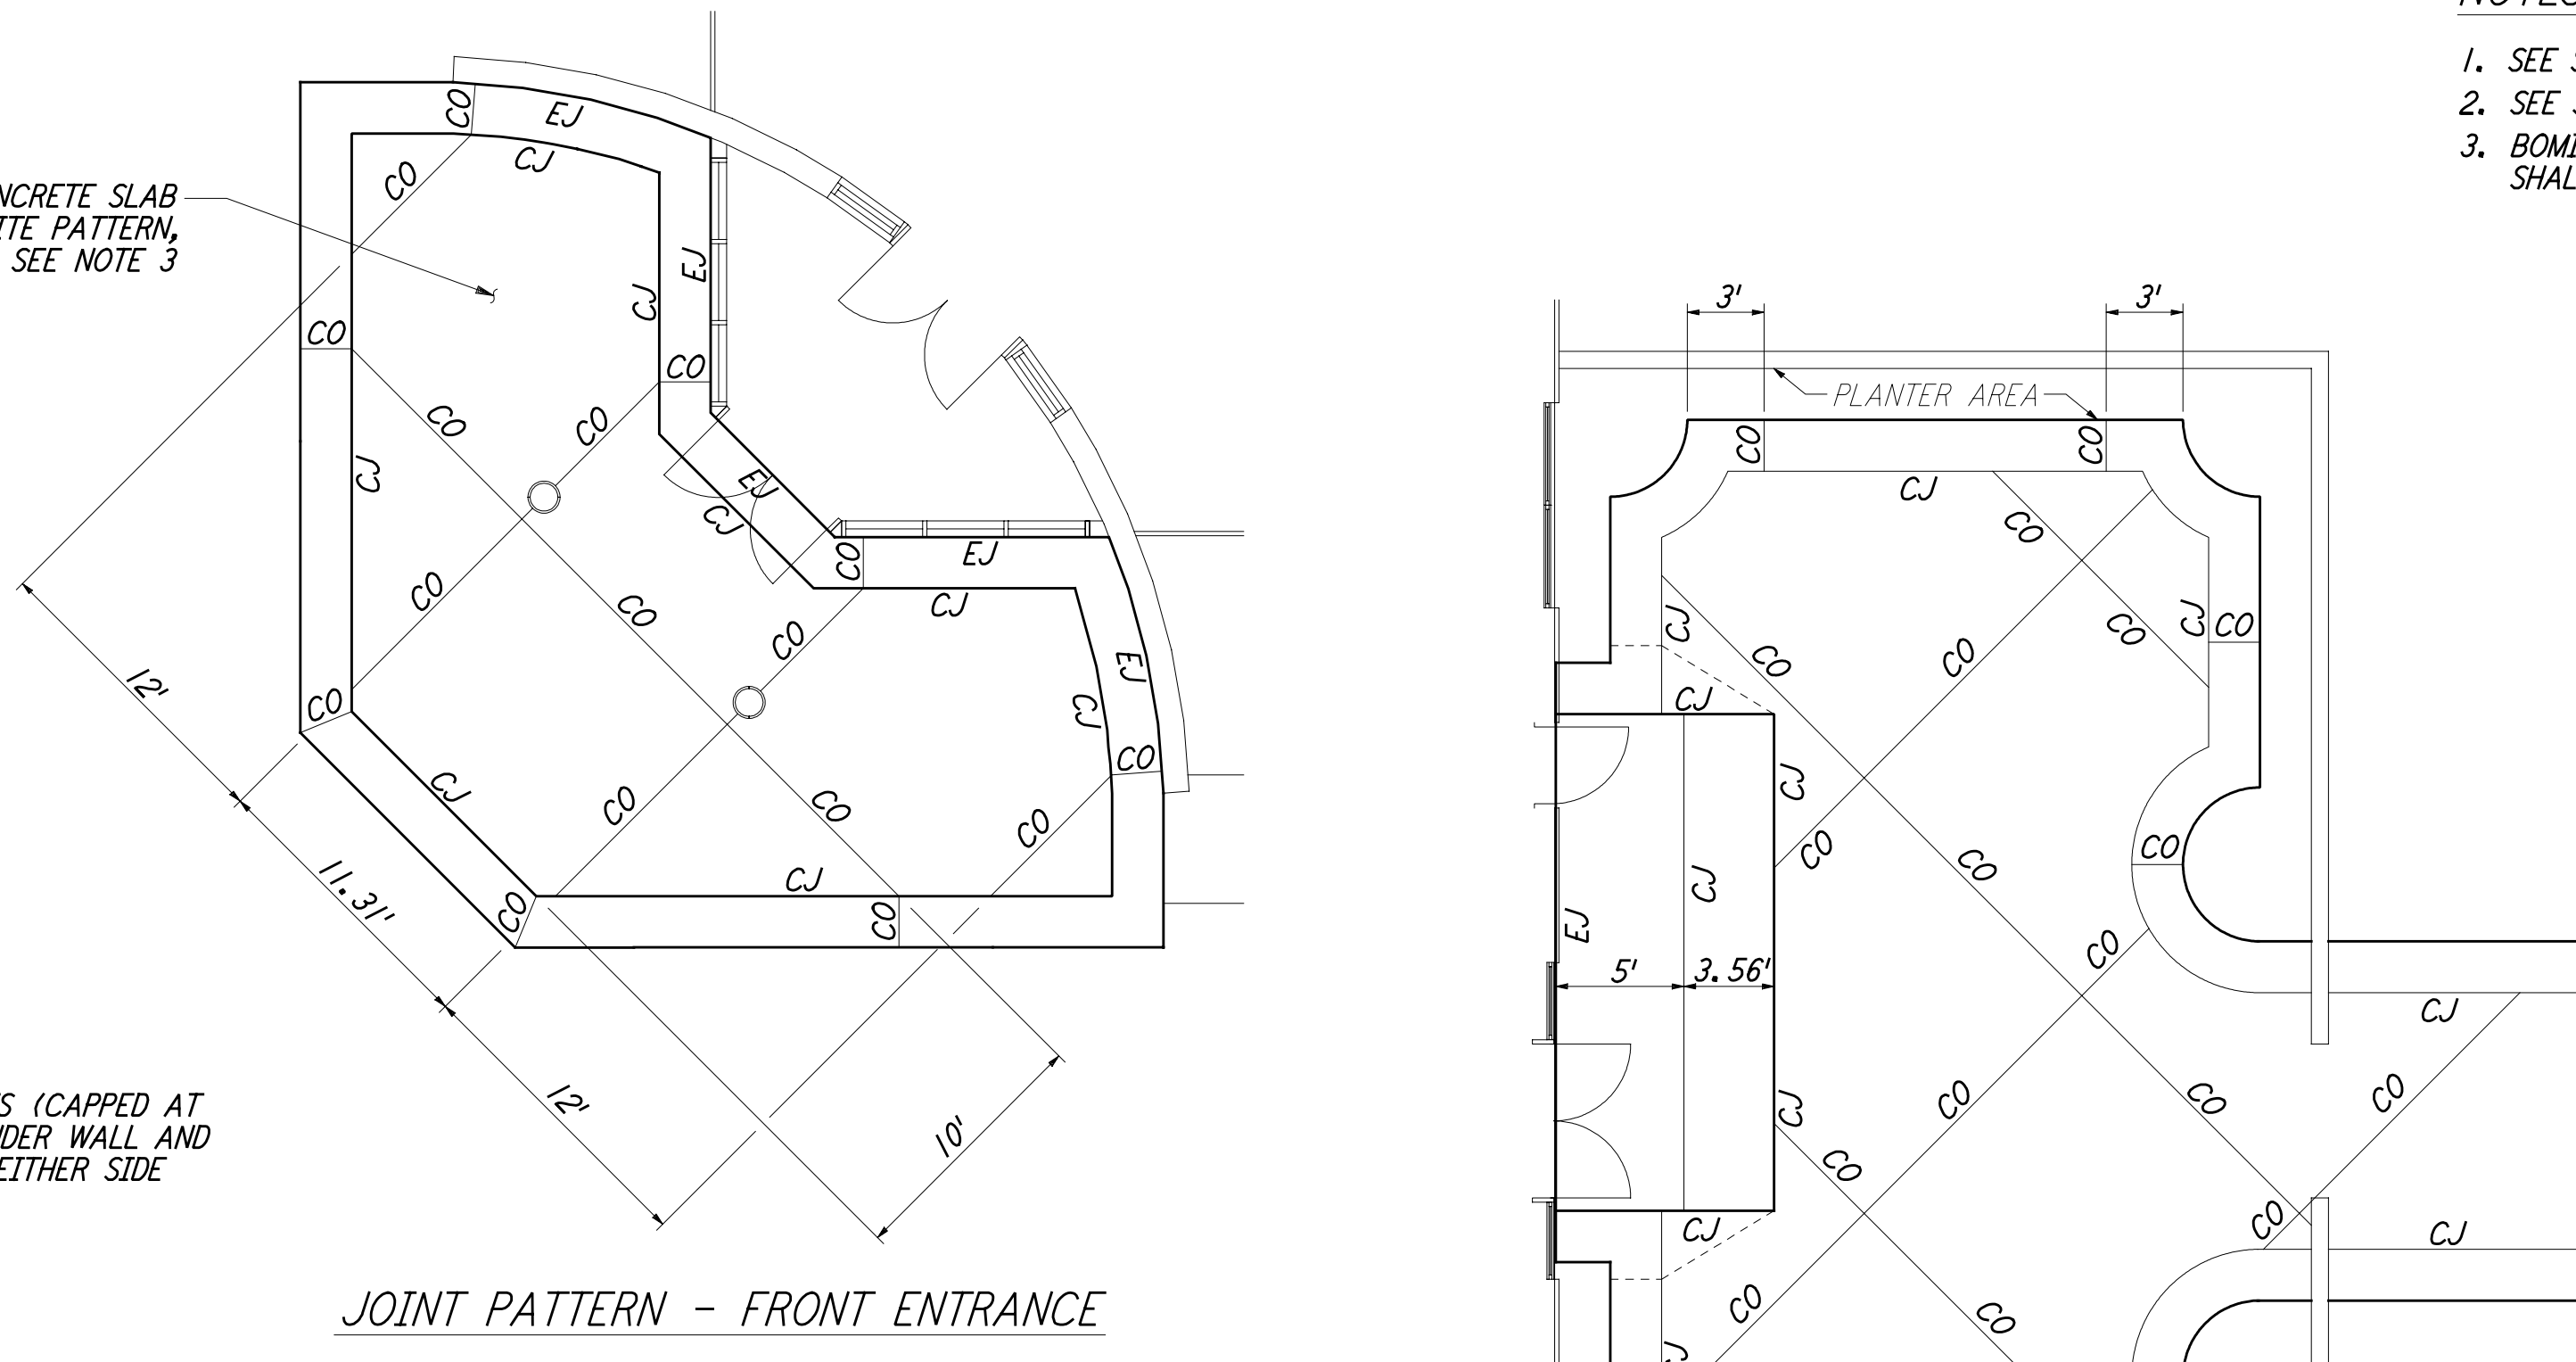


- NOTES:**
1. SEE SHEET WA-C-002 FOR GENERAL NOTES, LEGEND AND ABBREVIATIONS.
 2. SEE SHEET WA-C-505 FOR CURVE DATA.
 3. BOMINITE PATTERN AND COLOR FOR FRONT ENTRANCE AND PATIO SHALL BE SUBMITTED BY CONTRACTOR FOR CLIENT APPROVAL.

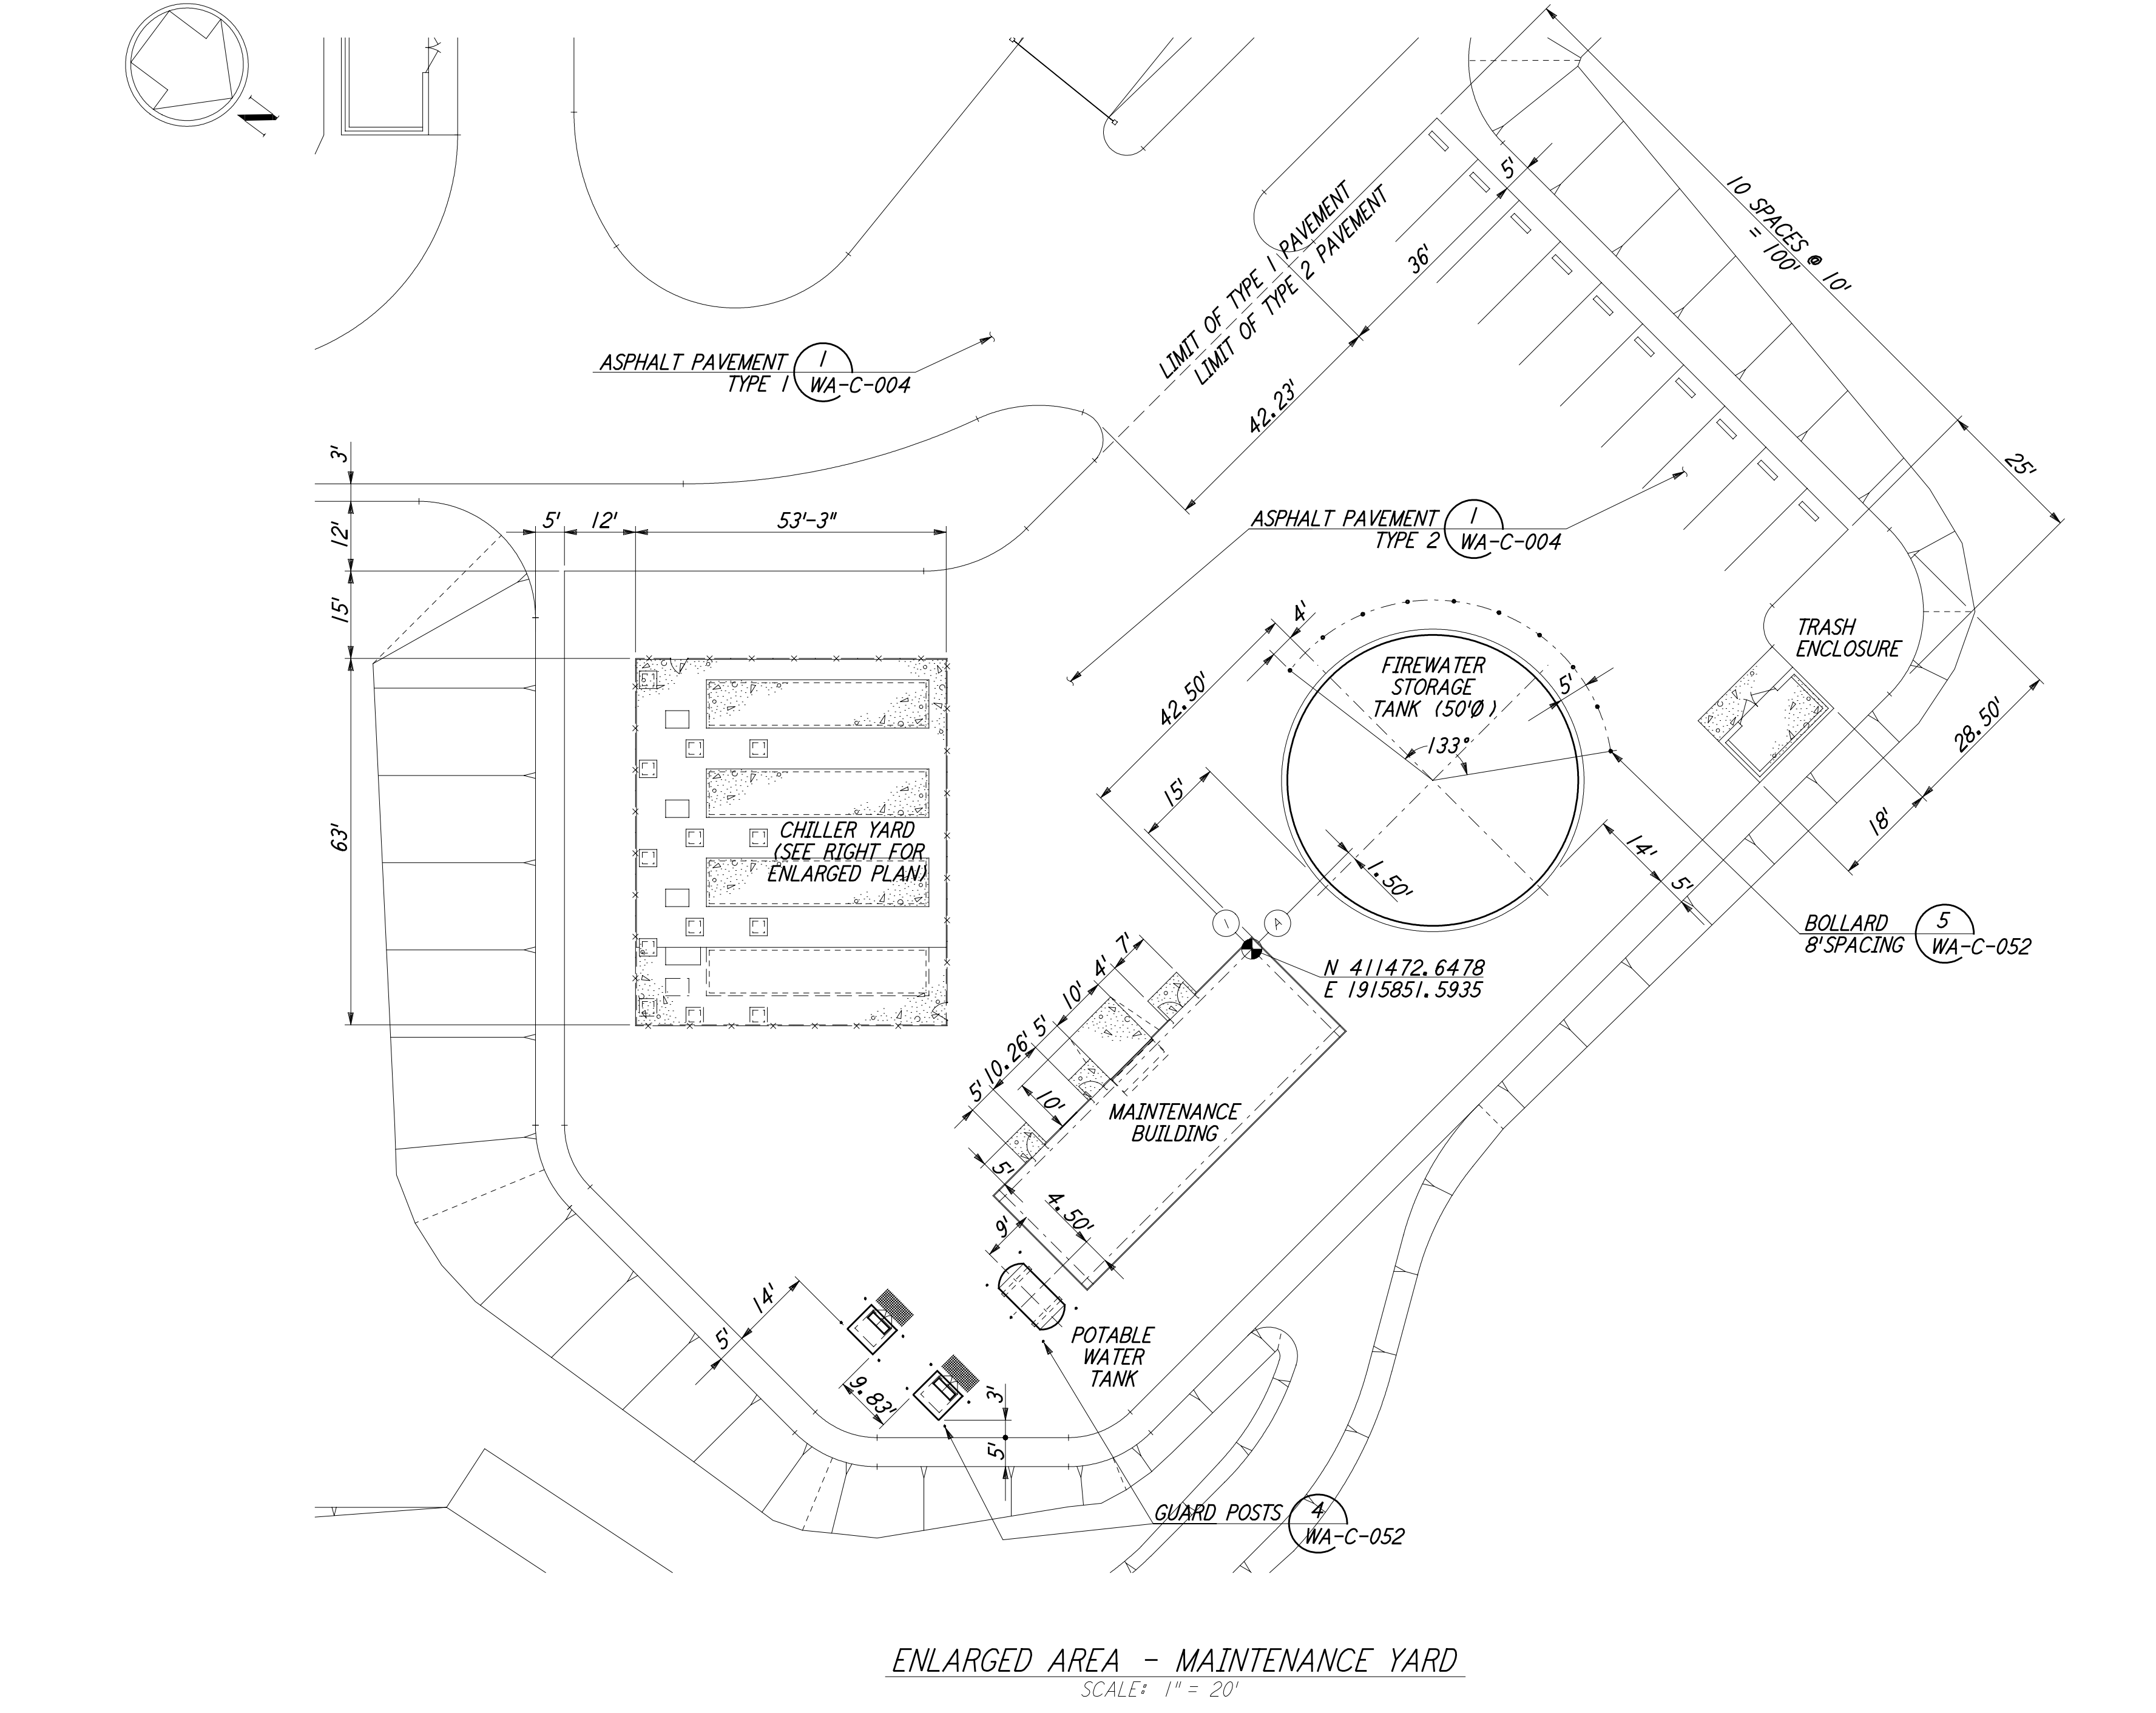


ENLARGED AREA - MAINTENANCE YARD
 SCALE: 1" = 20"

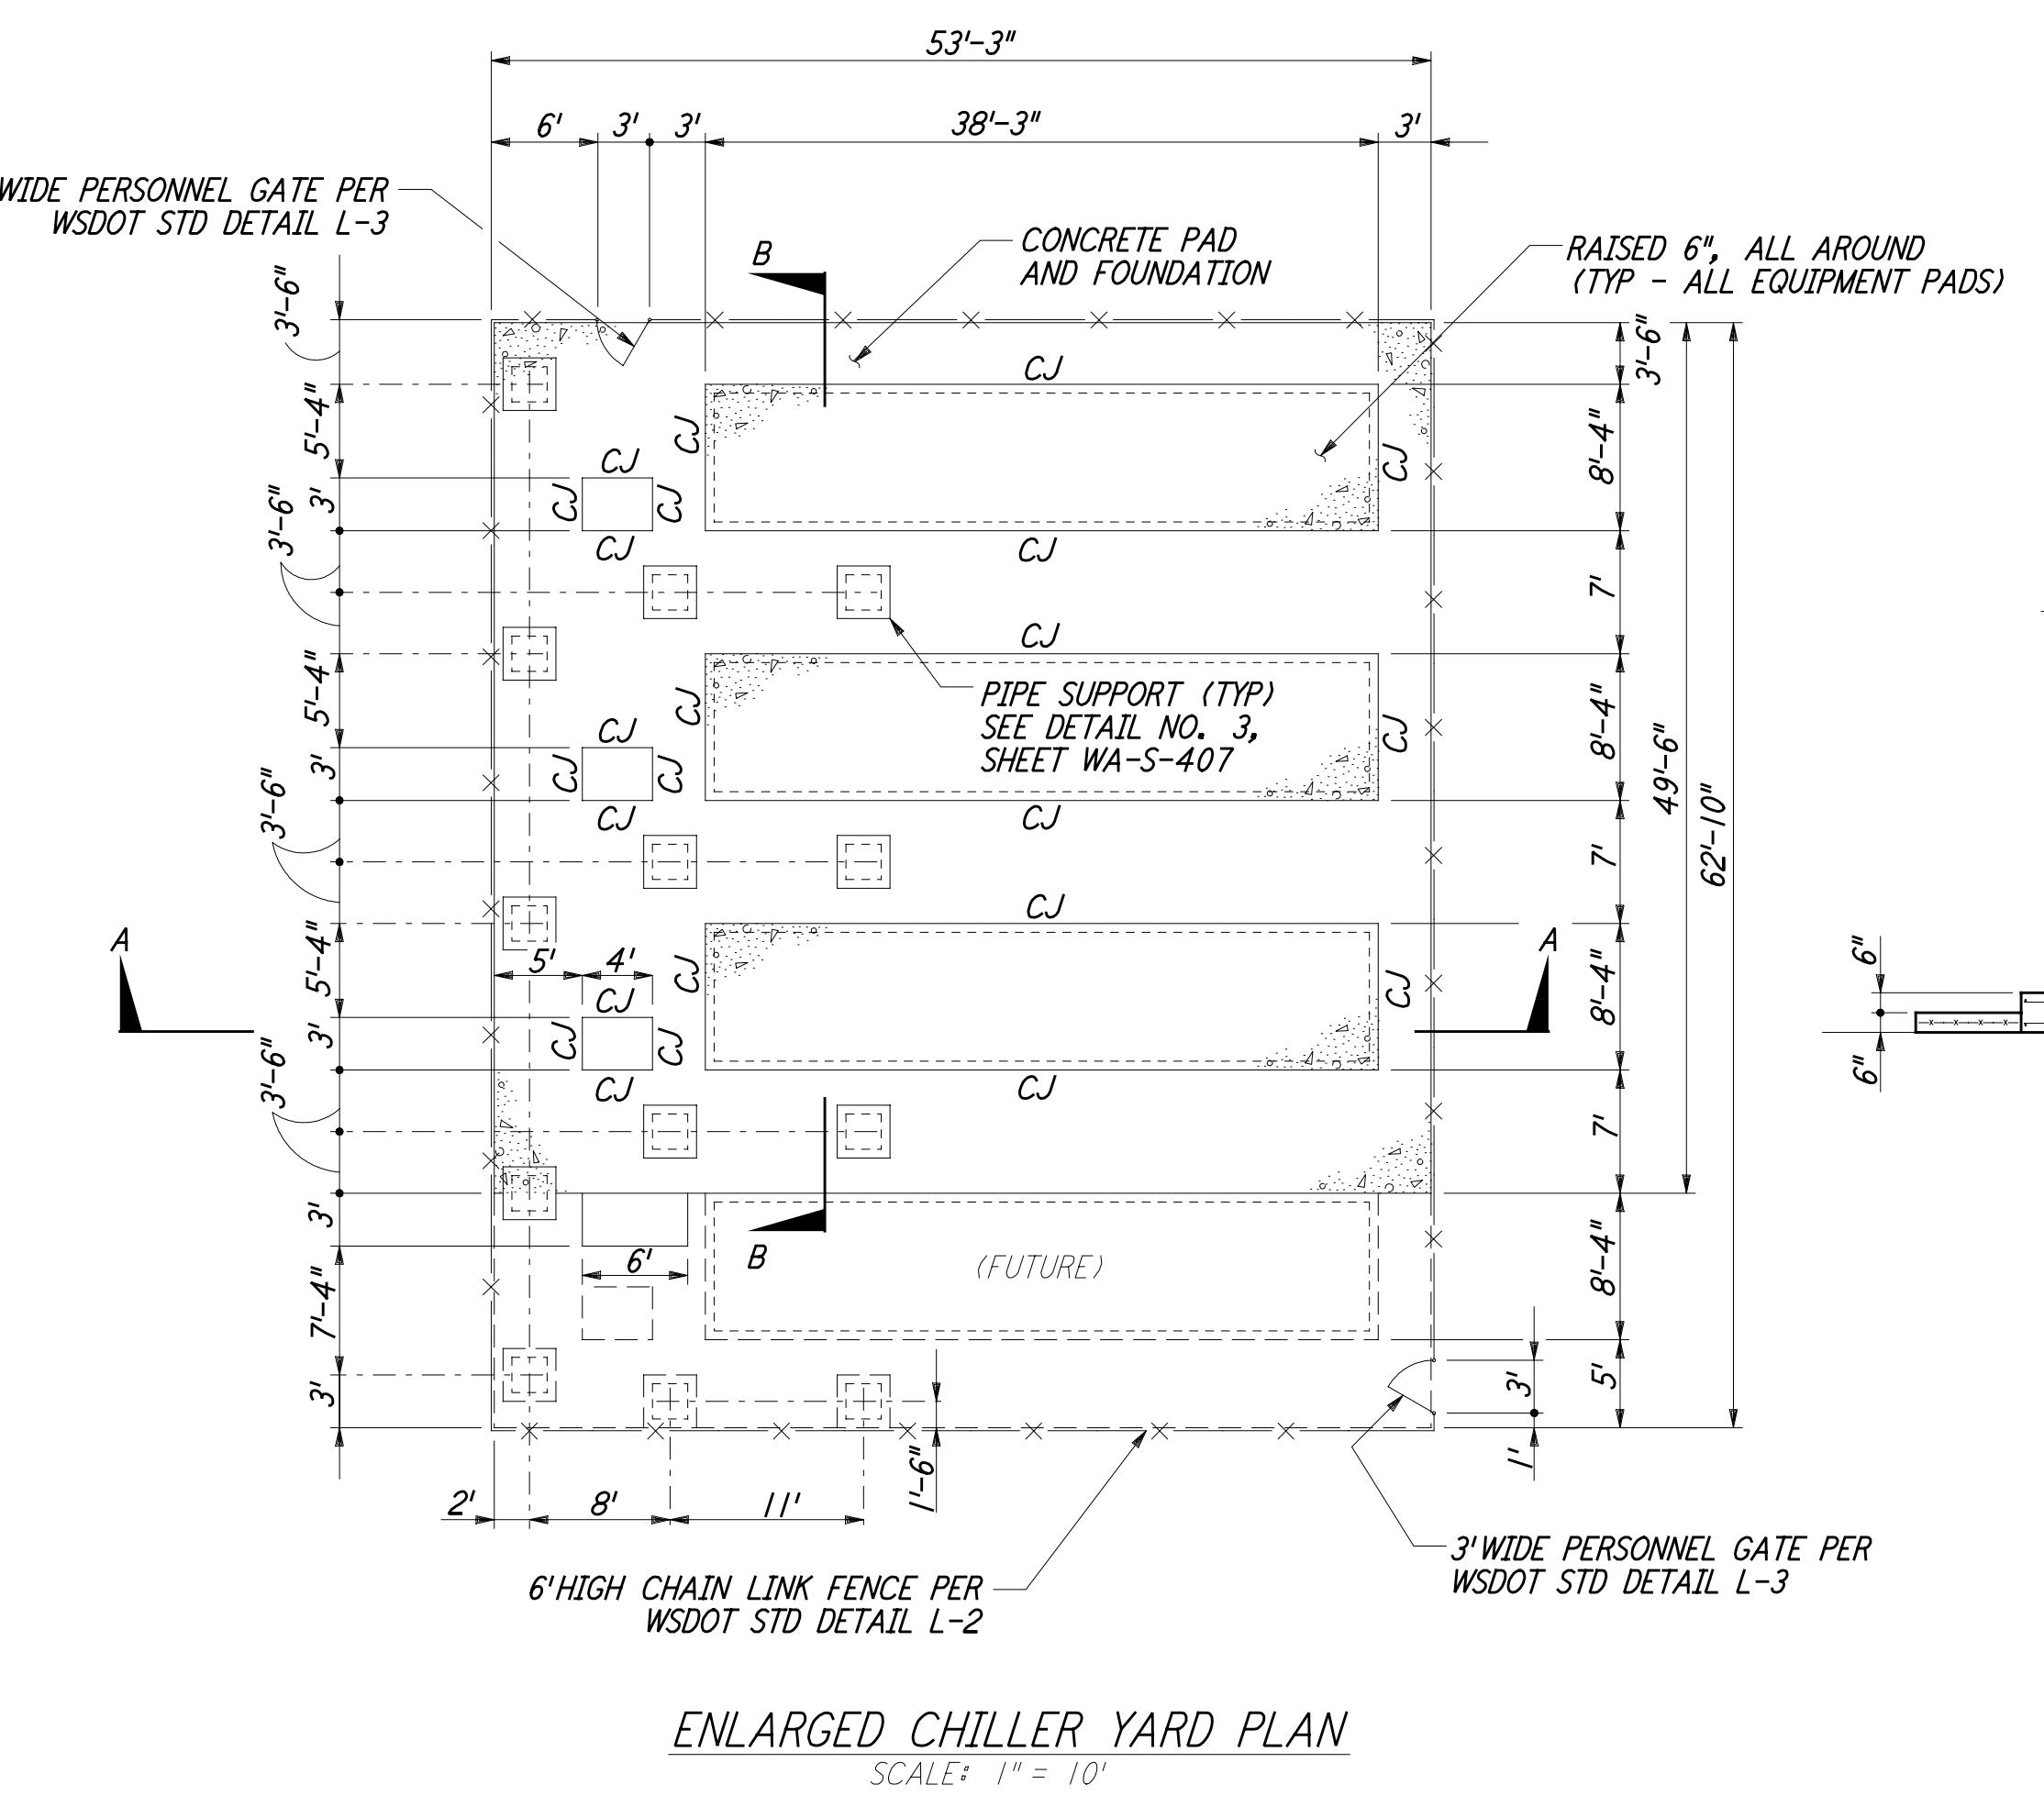

ENLARGED CHILLER YARD PLAN
 SCALE: 1" = 10"

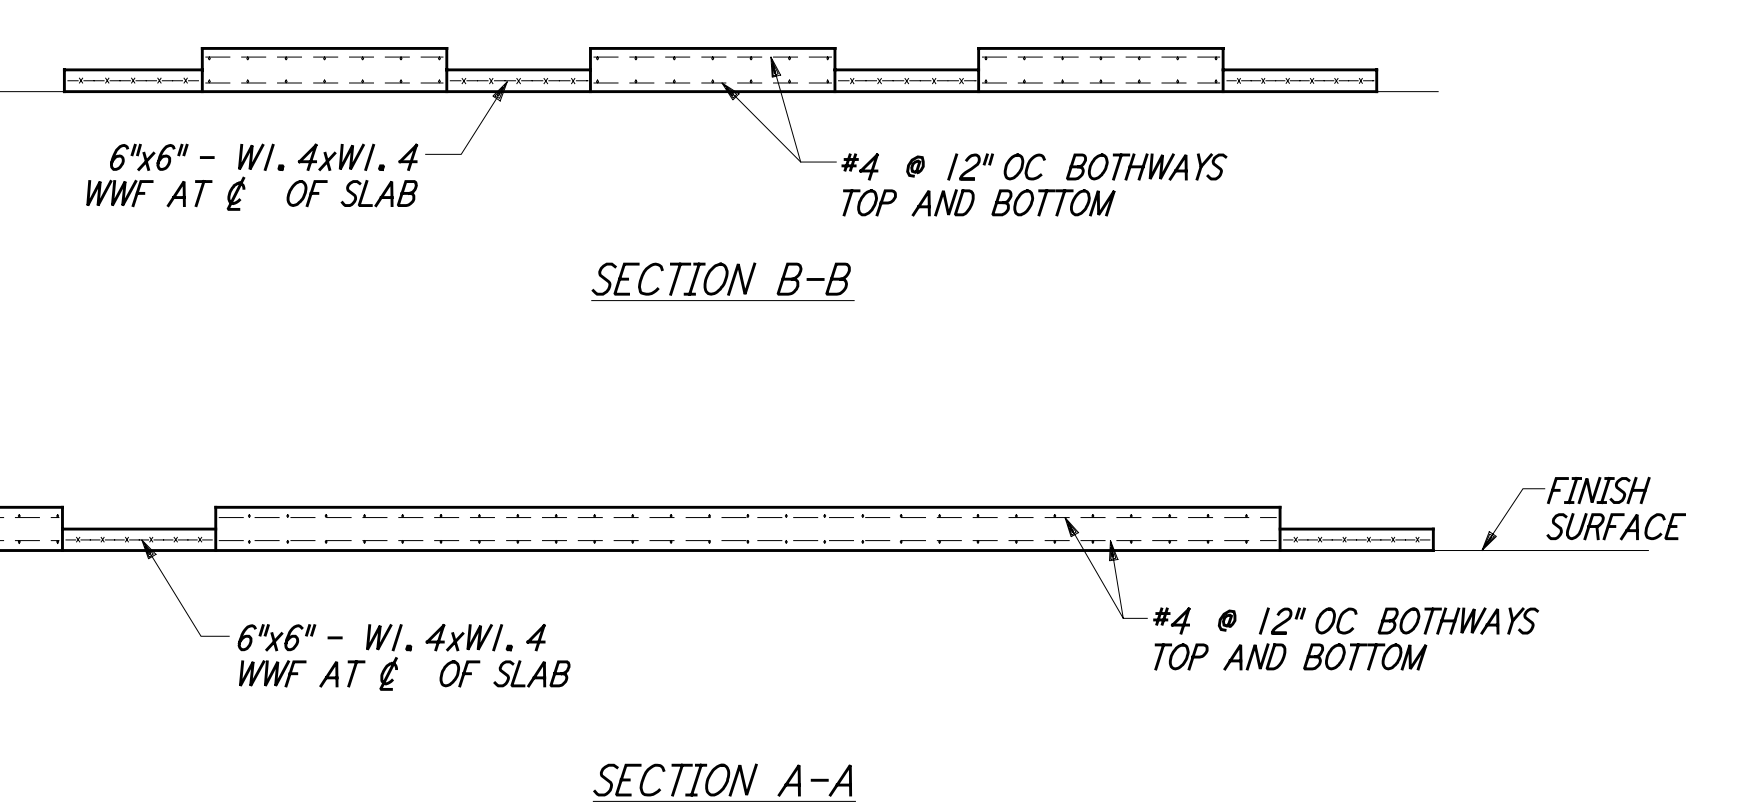

LIGO-D960200-02-O

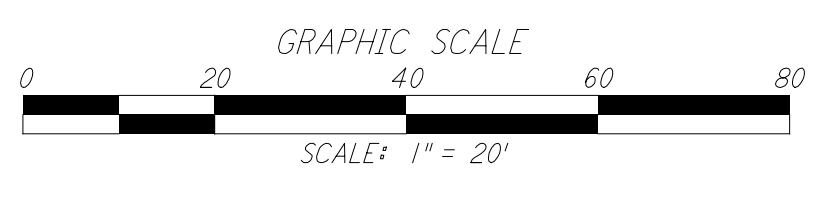

NO.	DATE	BY	CHKD	ENGR	PROJ	DESCRIPTION
1	2-28-97	WRB	ML	JB	MDW	ISSUED FOR AS-BUILT
2	5/15/98	WRB	ML	JB	MDW	ADDED WALK/WALL OPENING, REVISED GRADING

NO.	DATE	BY	CHKD	ENGR	PROJ	DESCRIPTION
1	2-28-97	WRB	ML	JB	MDW	ISSUED FOR AS-BUILT
2	5/15/98	WRB	ML	JB	MDW	ADDED WALK/WALL OPENING, REVISED GRADING

NO.	DATE	BY	CHKD	ENGR	PROJ	DESCRIPTION
1	2-28-97	WRB	ML	JB	MDW	ISSUED FOR AS-BUILT
2	5/15/98	WRB	ML	JB	MDW	ADDED WALK/WALL OPENING, REVISED GRADING

NO.	DATE	BY	CHKD	ENGR	PROJ	DESCRIPTION
1	2-28-97	WRB	ML	JB	MDW	ISSUED FOR AS-BUILT
2	5/15/98	WRB	ML	JB	MDW	ADDED WALK/WALL OPENING, REVISED GRADING

PARSONS
 100 WEST WALNUT STREET
 PASADENA, CALIFORNIA

LIGO
 CALIFORNIA INSTITUTE OF TECHNOLOGY
 MASSACHUSETTS INSTITUTE OF TECHNOLOGY

LASER INTERFEROMETER
 GRAVITATIONAL-WAVE OBSERVATORY
 SITE NO. I - HANFORD, WASHINGTON

TITLE	CIVIL CORNER STATION PLOT PLAN ENLARGED PLANS
SCALE	AS NOTED
DRAWING NUMBER	PP150969
PROJECT NUMBER	8094
SHEET NUMBER	WA-C-006

E
D
C
B
A