




VALVE BOX (1) REF
 NOT TO SCALE WA-C-055 WA-C-509
 NOTE: VALVE SIZE 12" MAXIMUM WA-C-510

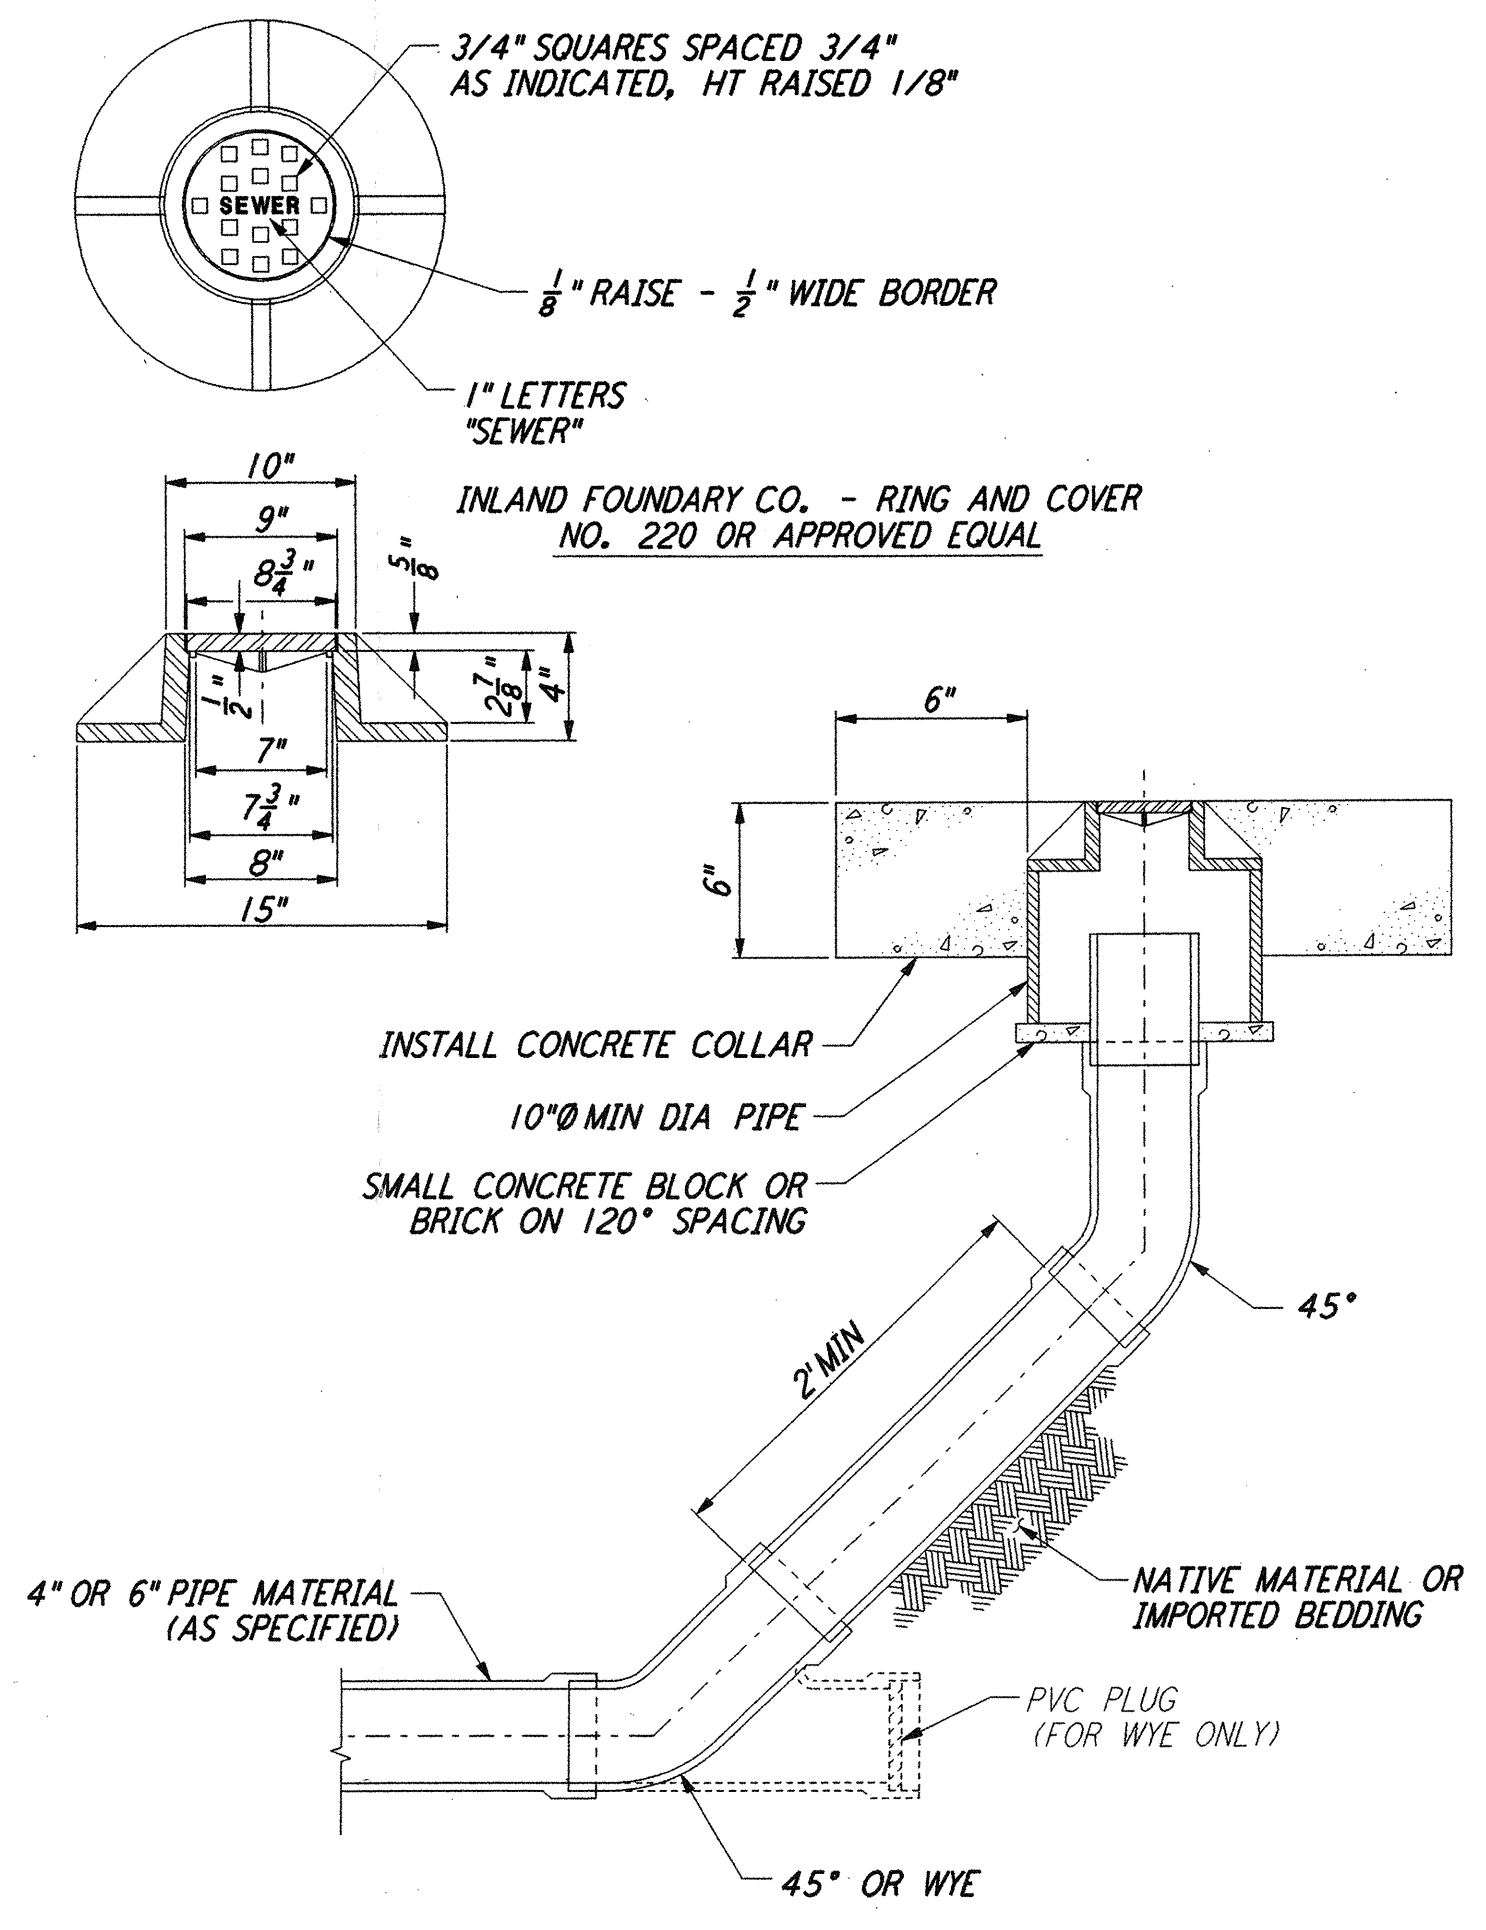


SANITARY SEWER CLEANOUT (2) REF
 NOT TO SCALE WA-C-055 WA-C-509
 WA-C-510

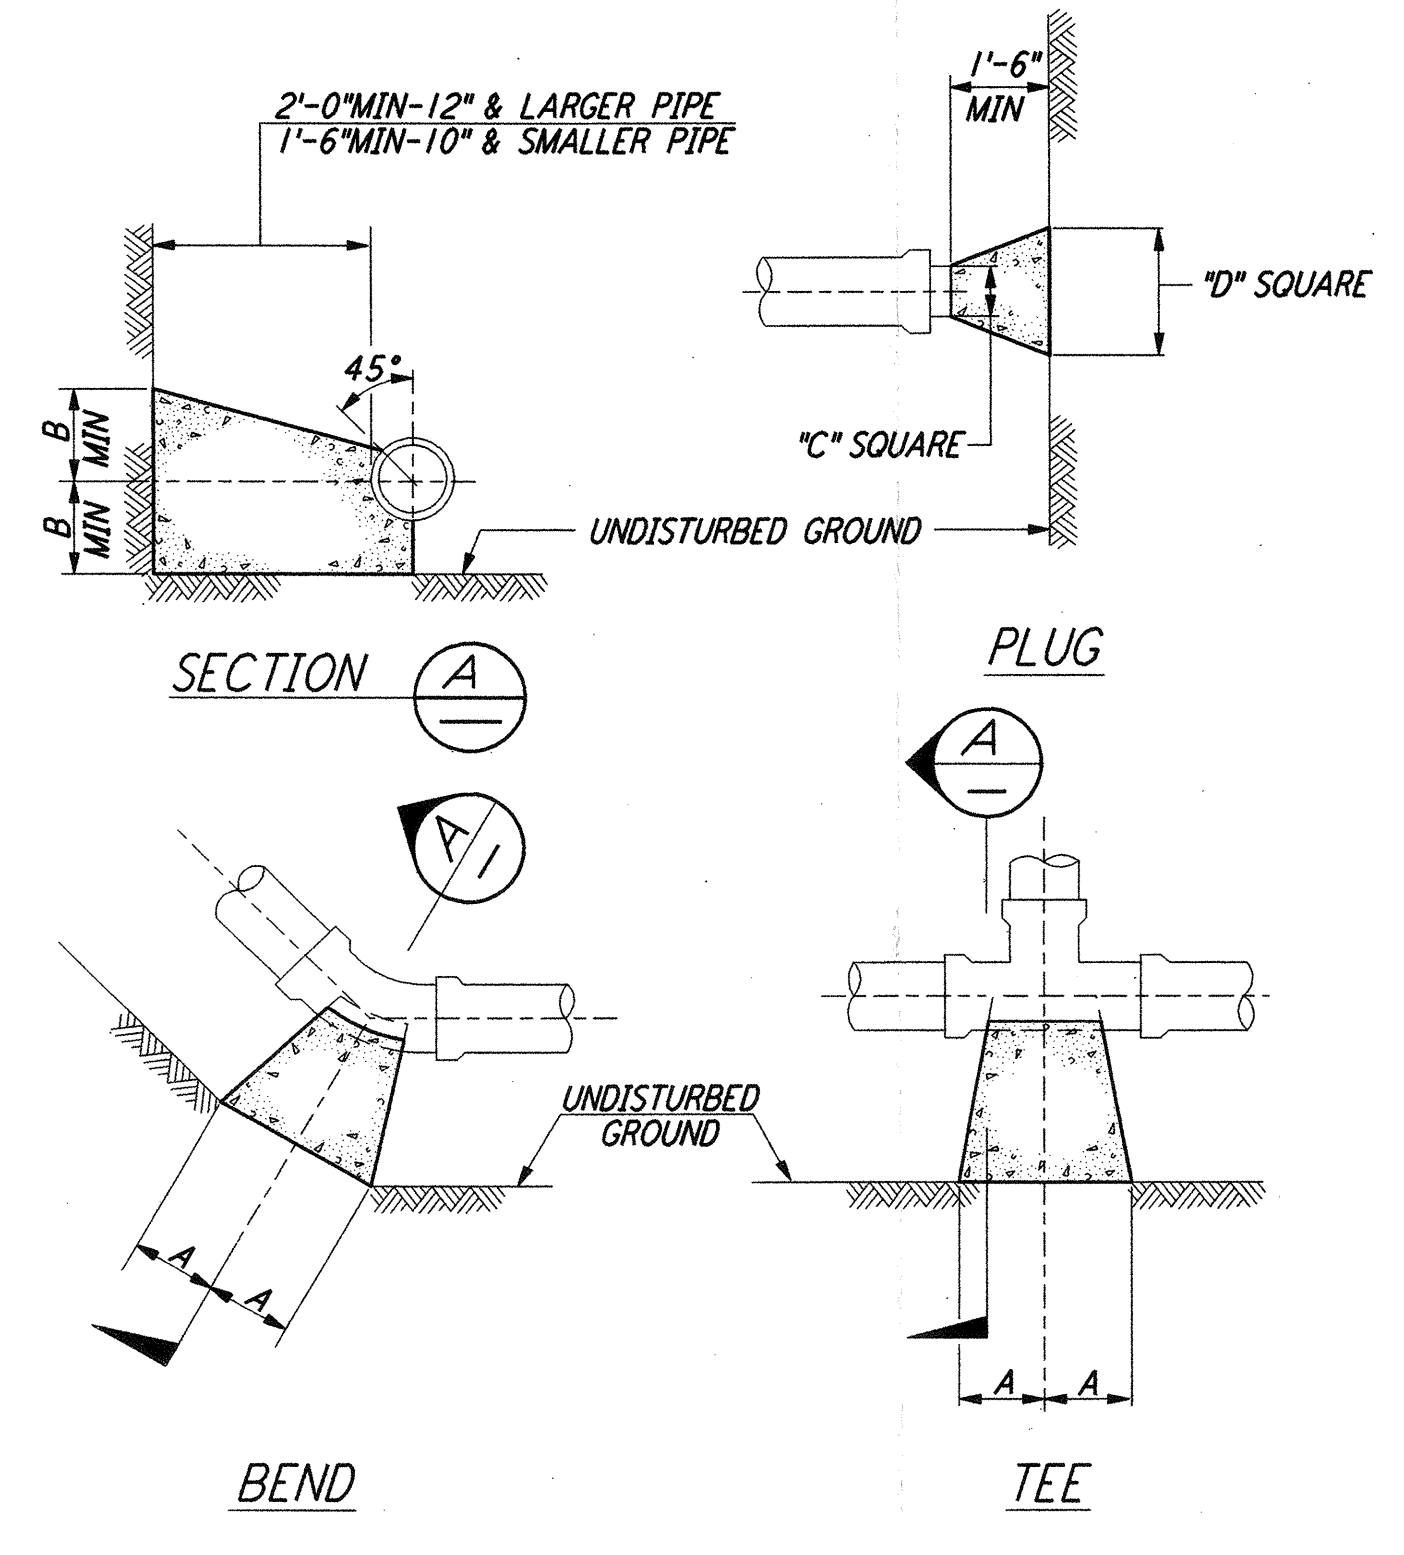


THRUST BLOCK (3) REF
 NOT TO SCALE WA-C-055 WA-C-509
 WA-C-510

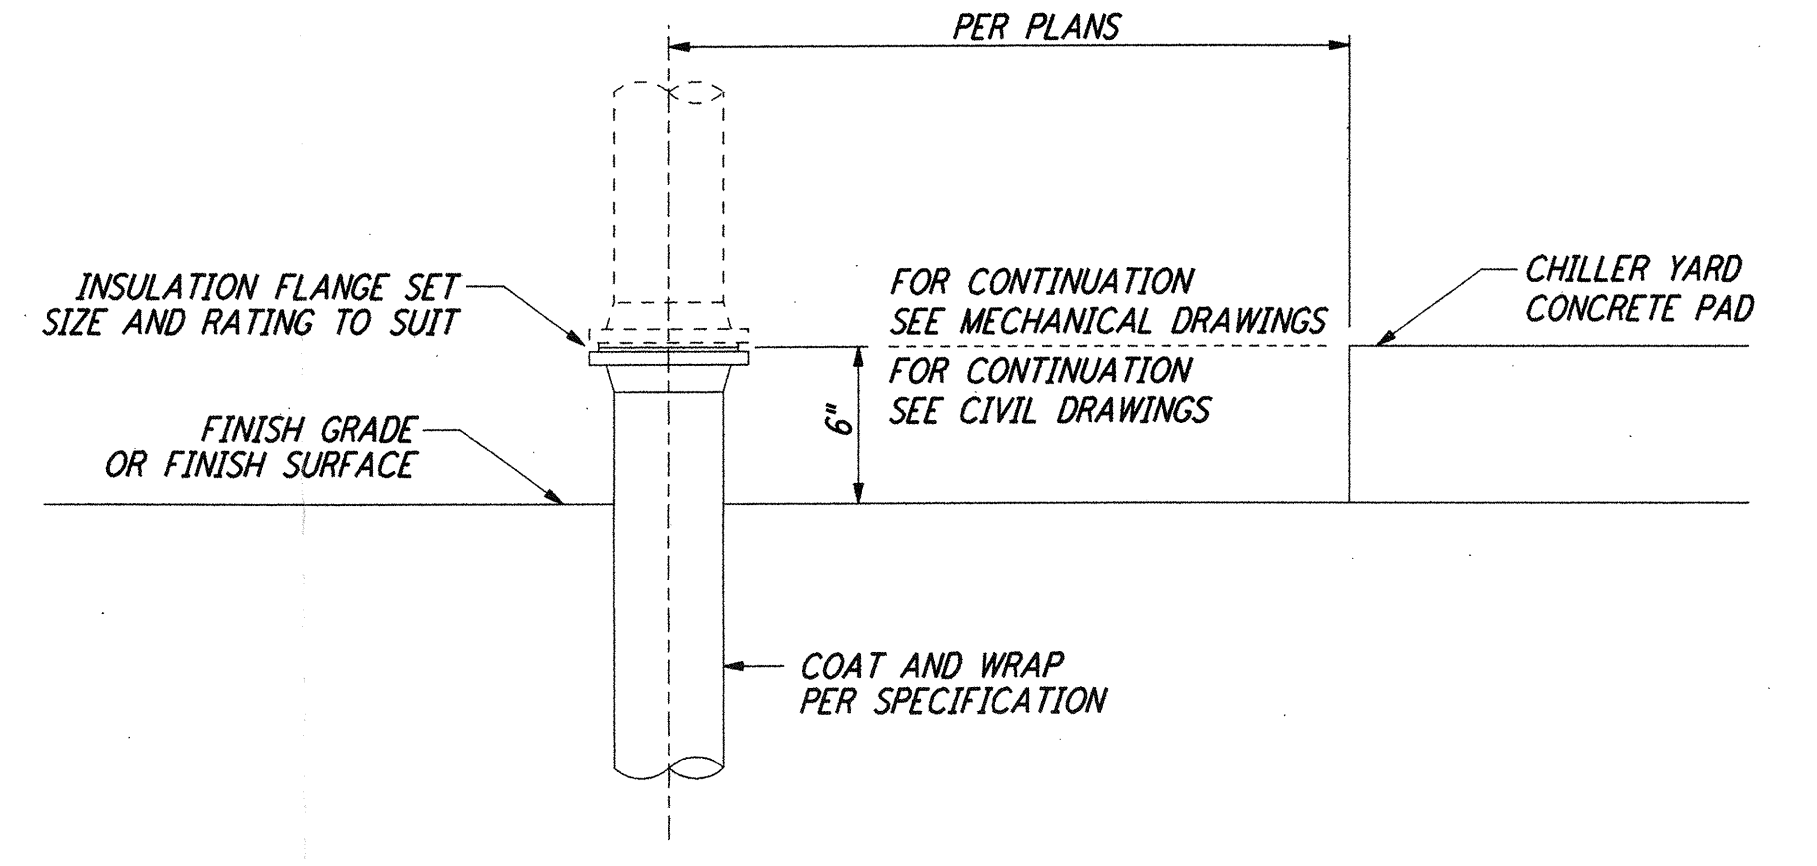


PIPE CONNECTION (4) REF
 (UNDERGROUND TO OVERHEAD) WA-C-055 WA-C-509
 NOT TO SCALE WA-C-510
 WA-C-023
 WA-C-027
 WA-C-043
 WA-C-047

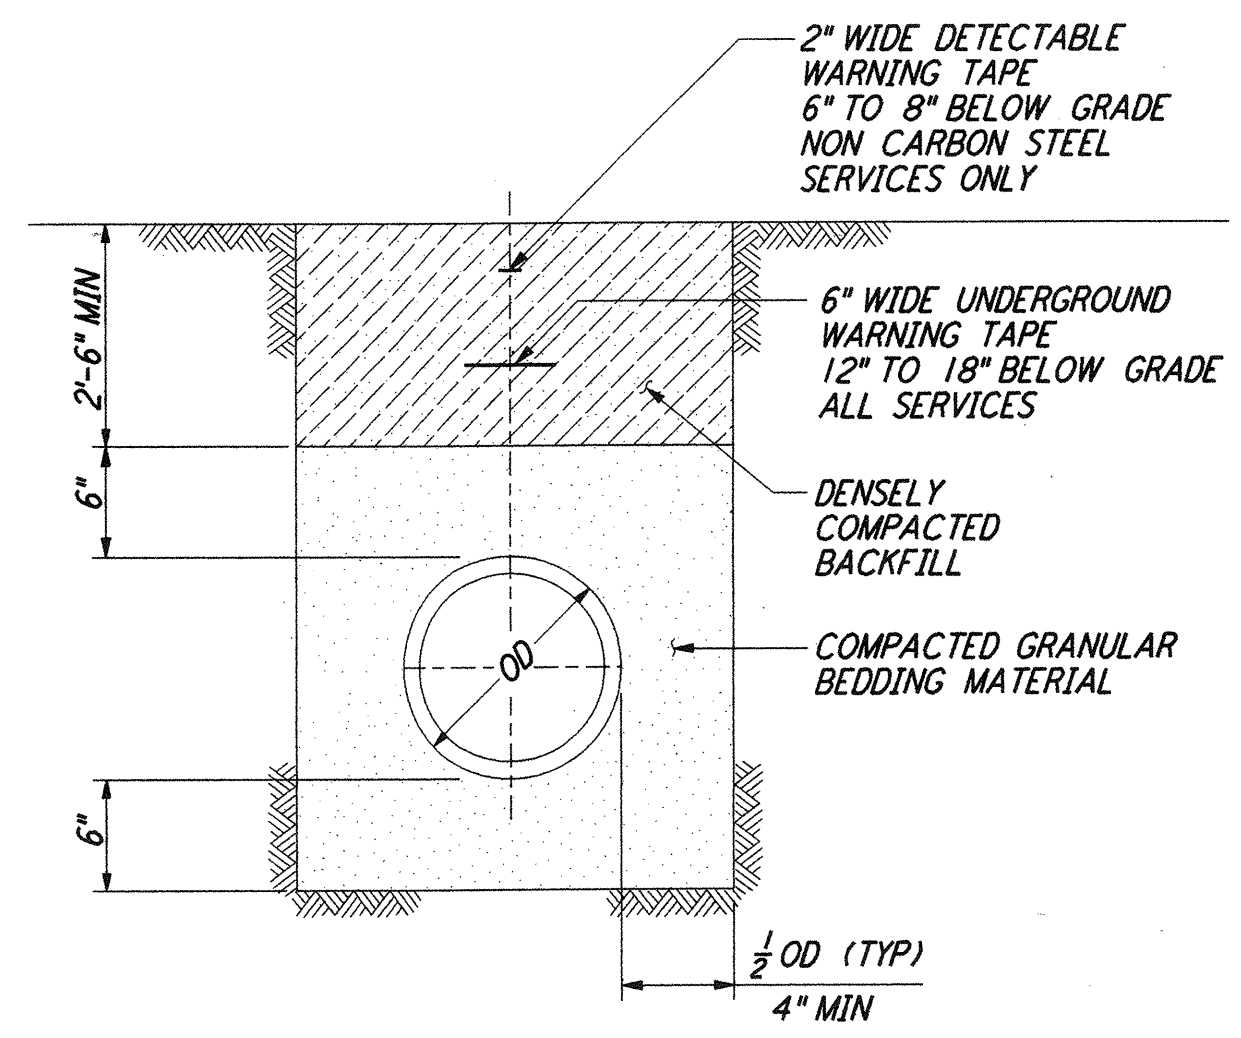


TRENCH BEDDING (5) REF
 NOT TO SCALE WA-C-055 WA-C-509
 WA-C-510
 WA-C-023
 WA-C-027
 WA-C-043
 WA-C-047

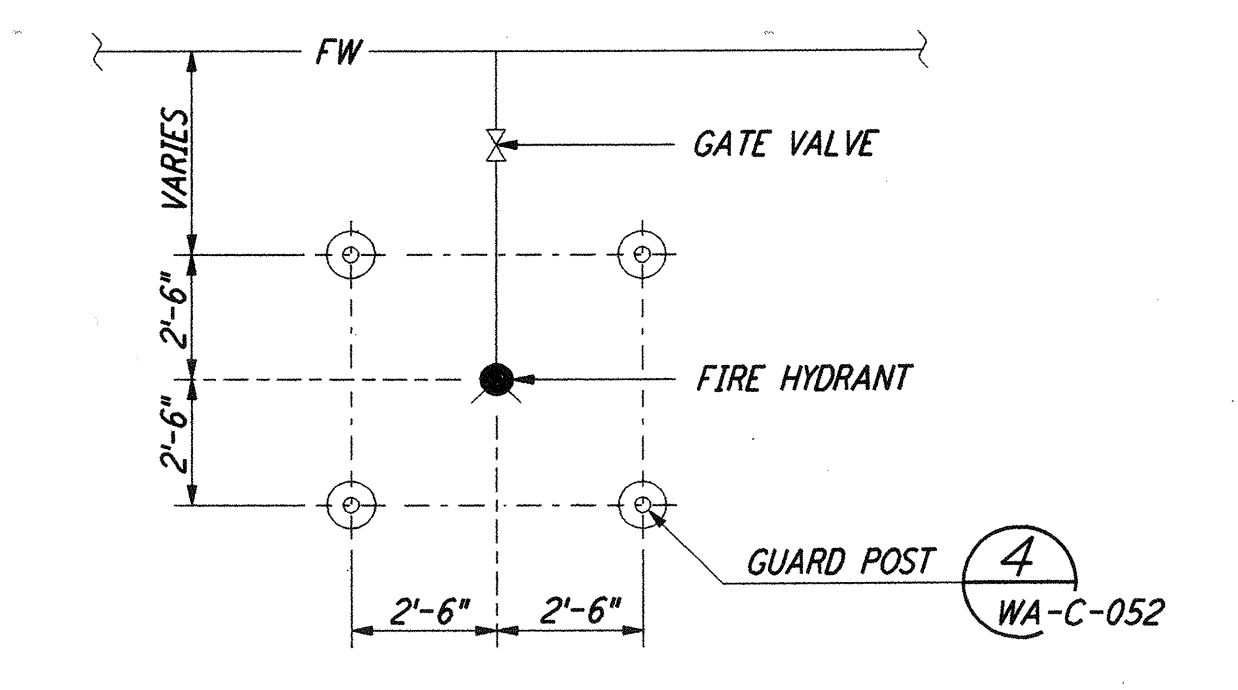


GUARD POST LOCATIONS (6) REF
 (FIRE HYDRANT) NOT TO SCALE WA-C-055 WA-C-509
 WA-C-510

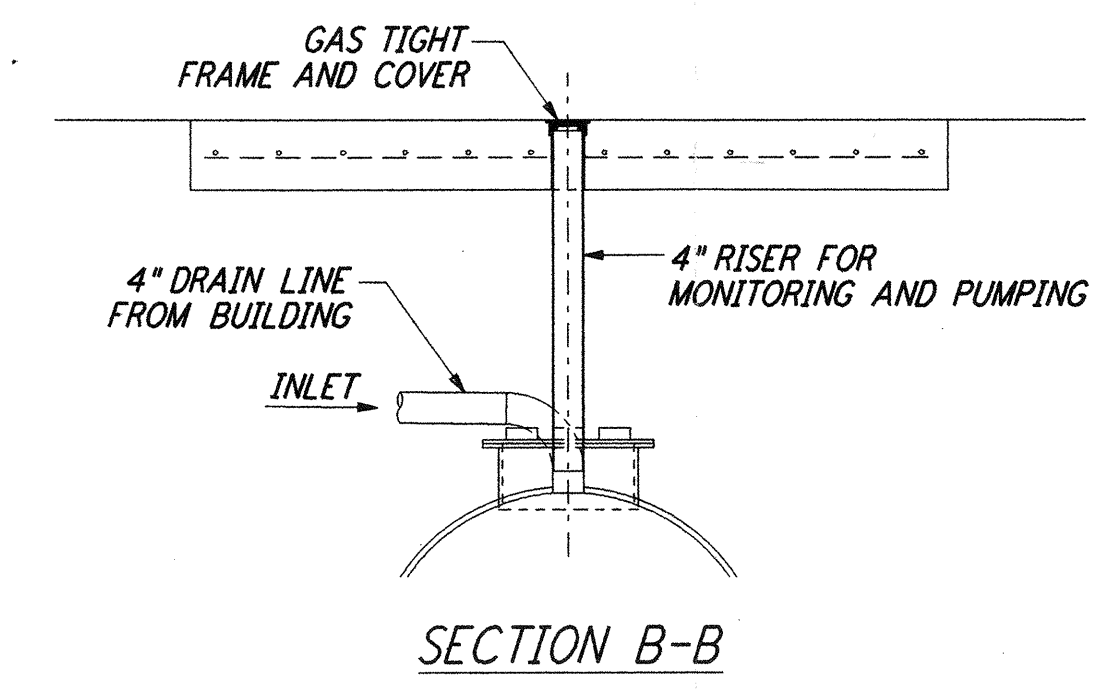


SECTION B-B

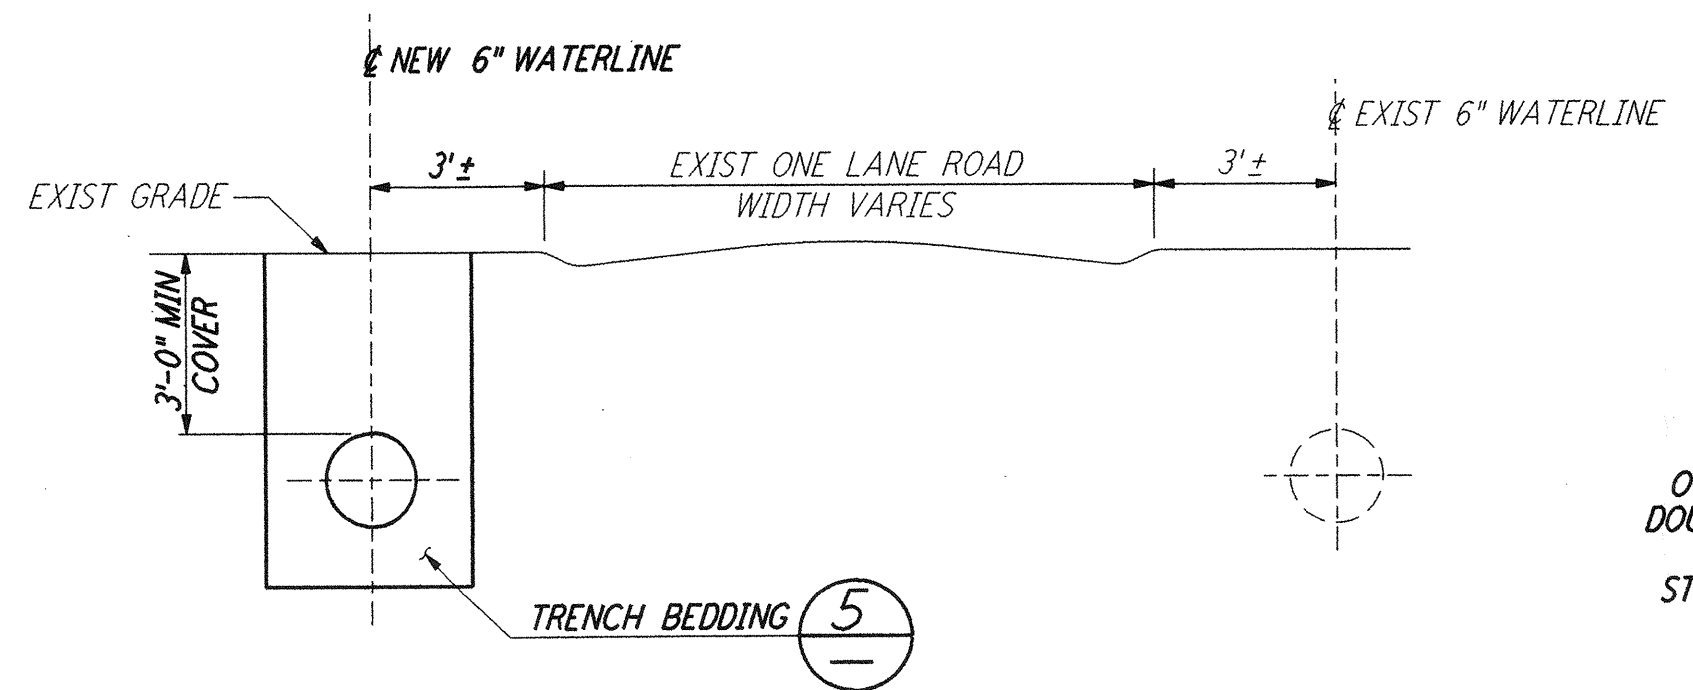

SECTION THRU EXISTING AND NEW WATERLINES (7) REF
 NOT TO SCALE WA-C-055

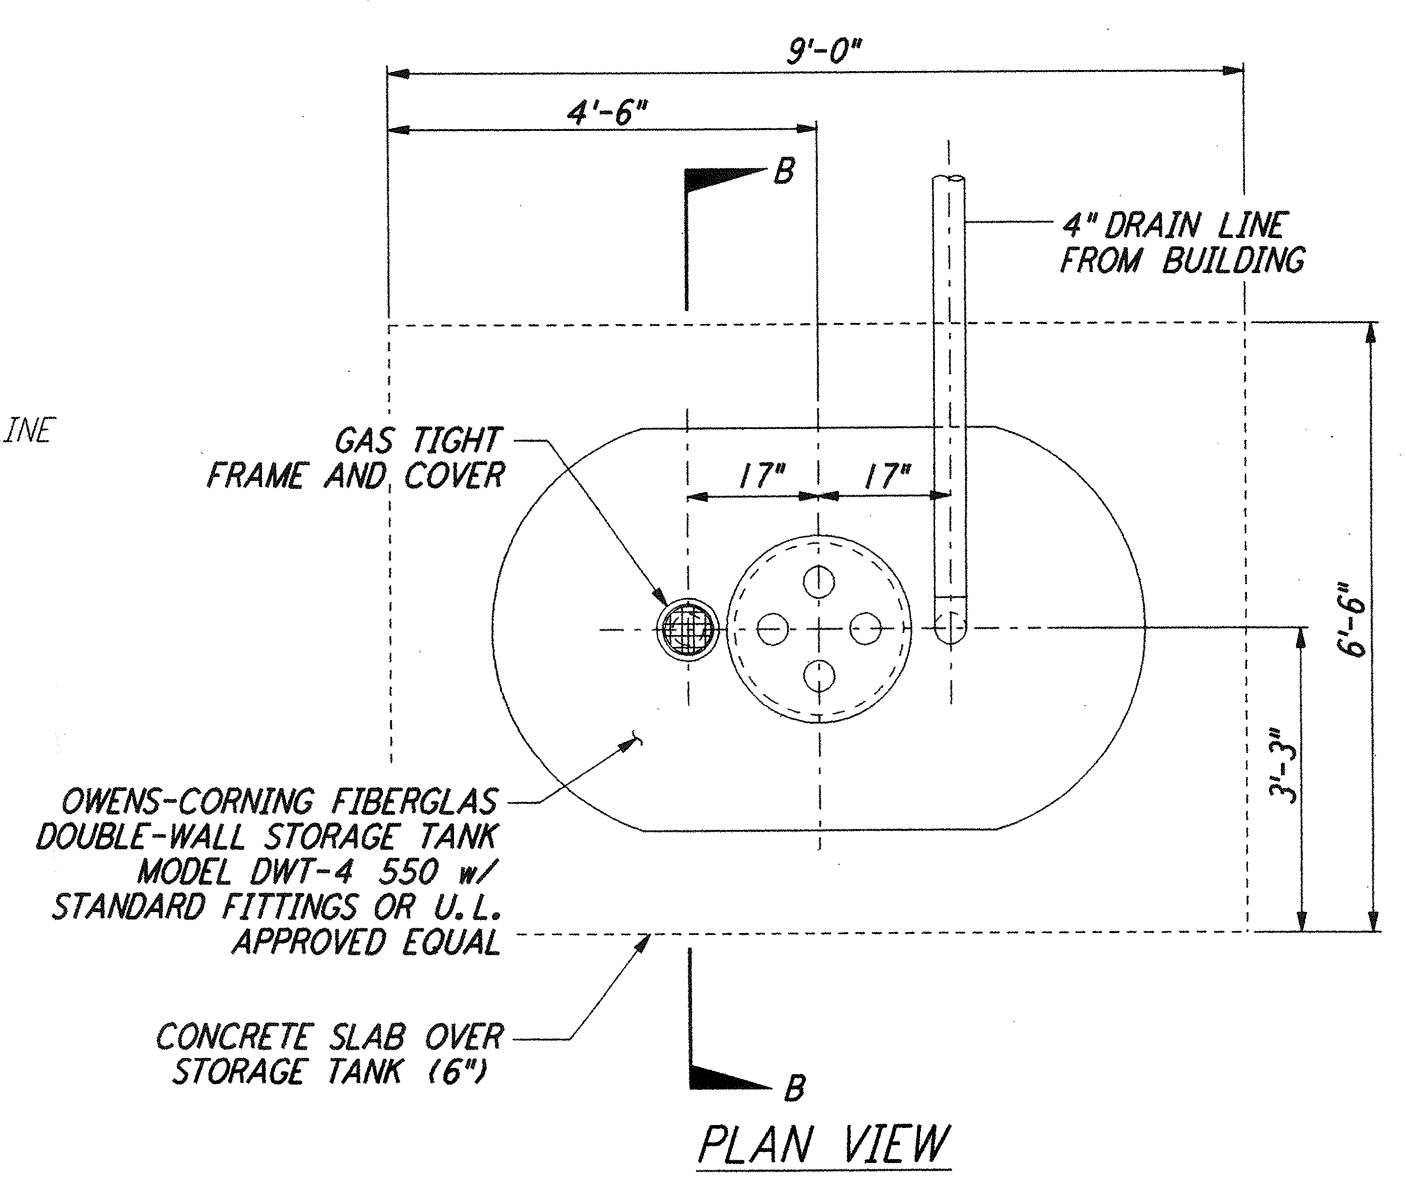


PLAN VIEW

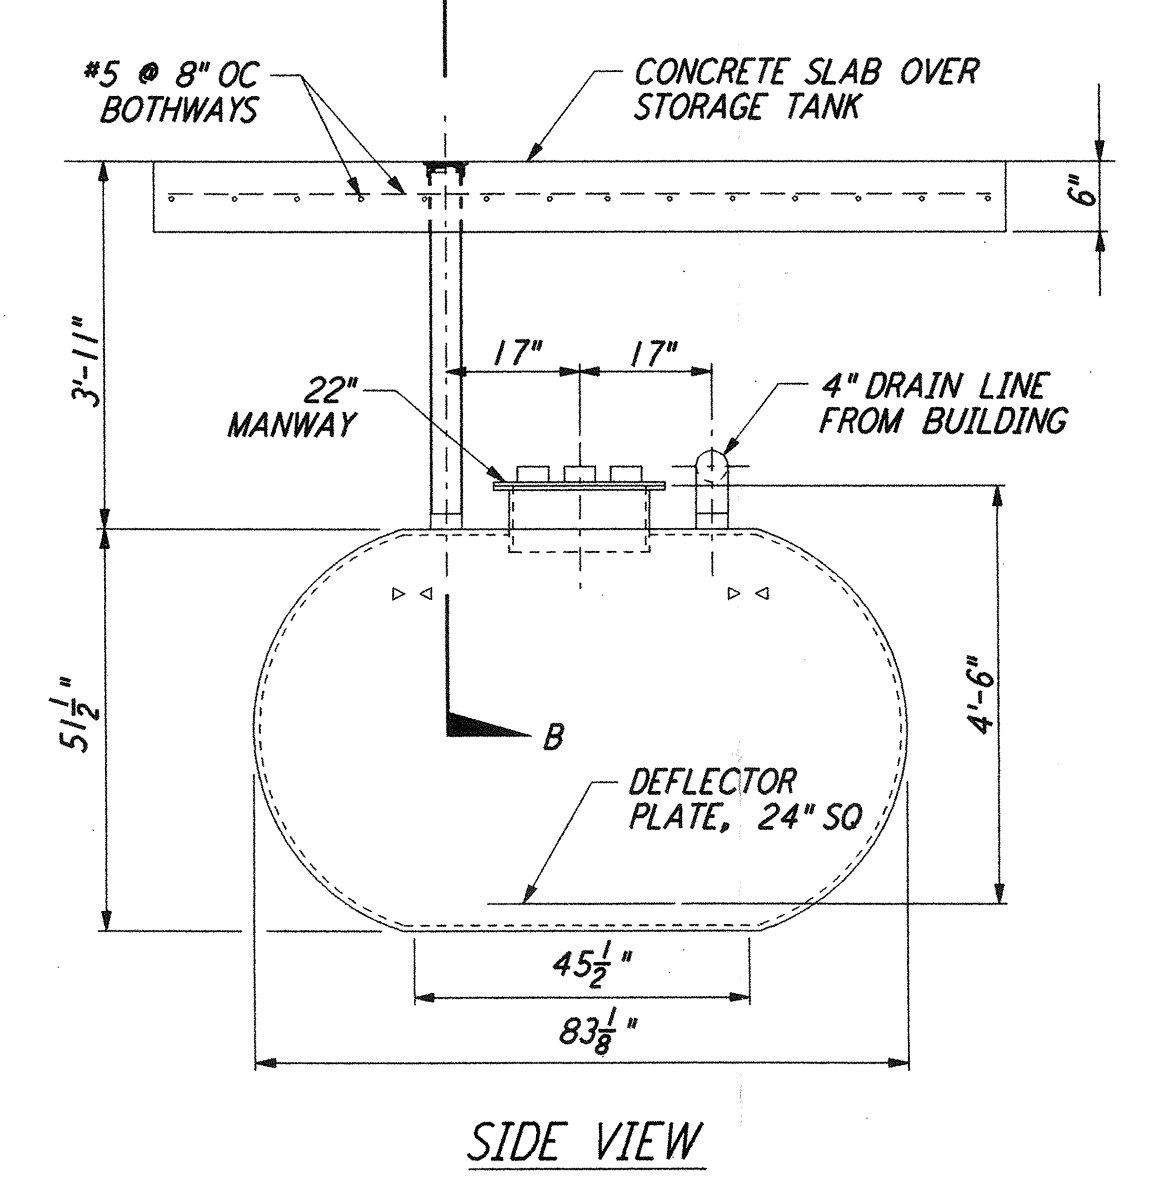


SIDE VIEW

DOUBLE-WALL HOLDING TANK 500 GALLONS (8) REF
 NOT TO SCALE WA-C-055 WA-C-023
 WA-C-027
 WA-C-043
 WA-C-047

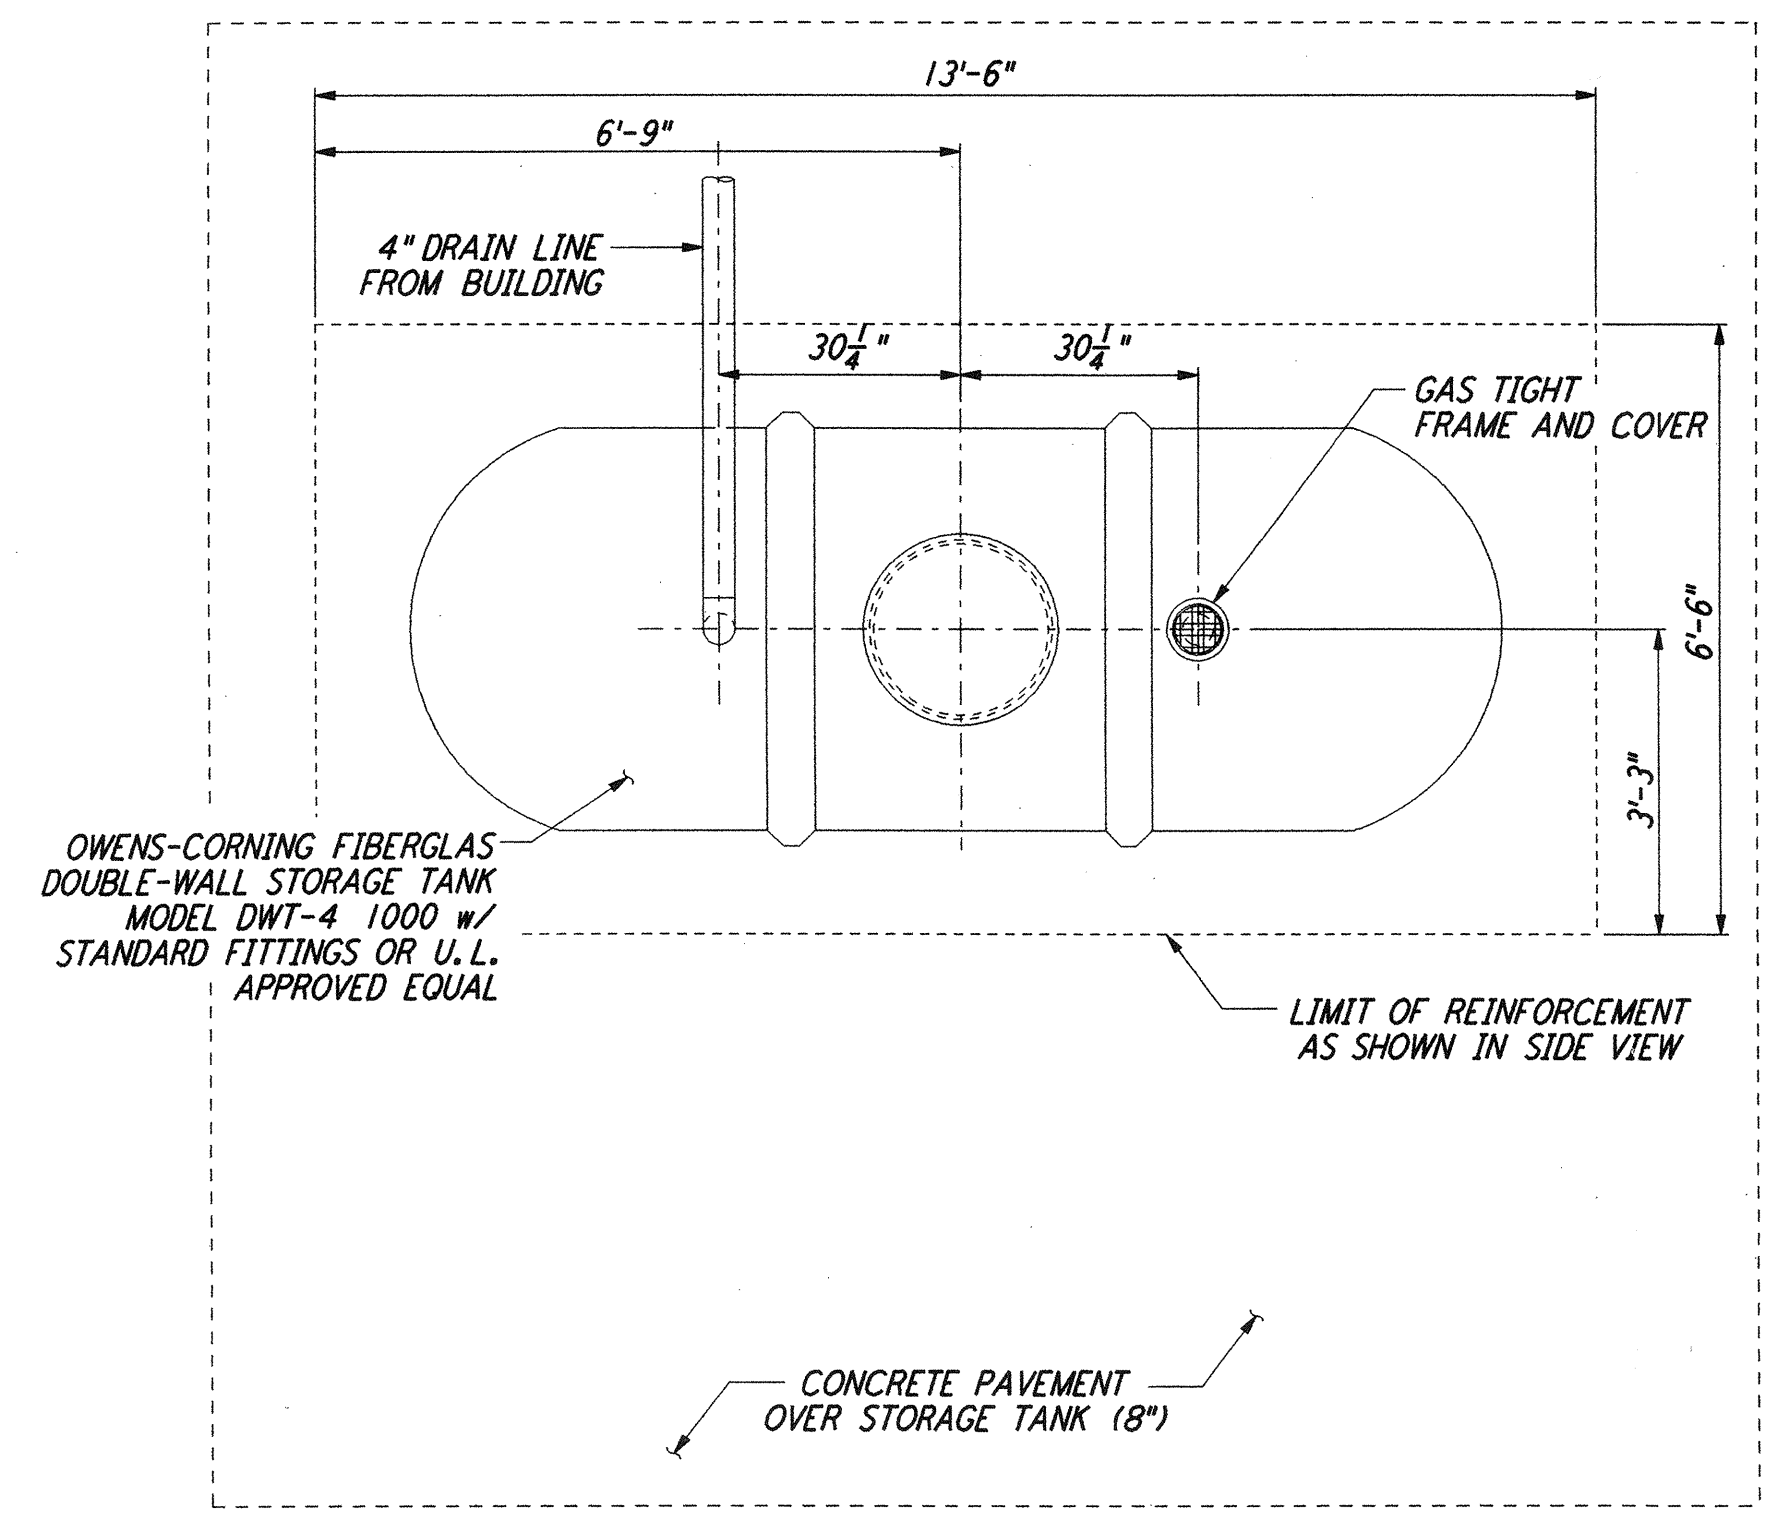

PLAN VIEW

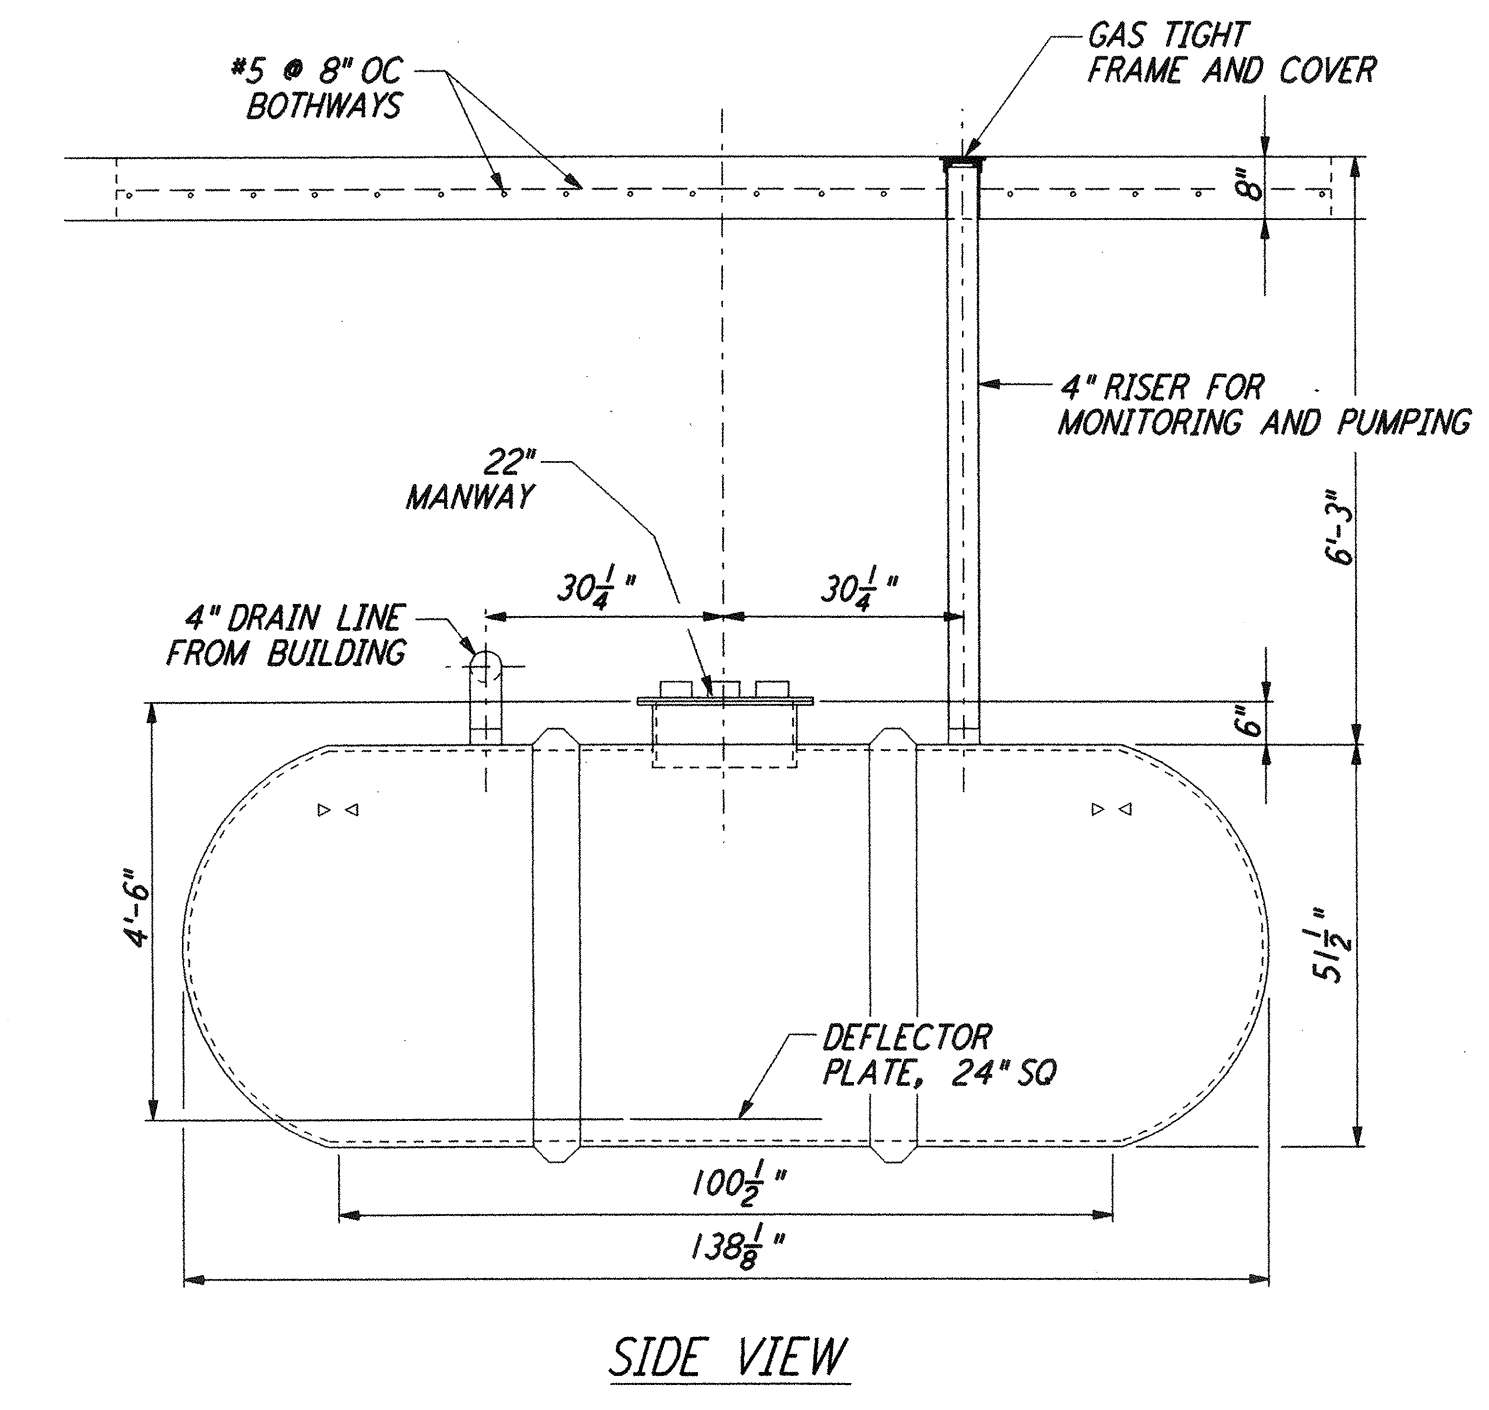

SIDE VIEW

DOUBLE-WALL HOLDING TANK 1000 GALLONS W/ PIPING SUMP (9) REF
 NOT TO SCALE WA-C-055 WA-C-509
 WA-C-510

NOTES:
 1. SEE SHEET WA-C-002 FOR GENERAL NOTES, LEGEND AND ABBREVIATIONS.

This document and the design it covers are the property of PARSONS. They are loaned only with the borrower's expressed written agreement that they will not be reproduced, copied, loaned, exhibited, or used in any other way, except by written consent from PARSONS to the borrower.

NO.	DATE	BY	CHKD	ENGR	PROJ	DESCRIPTION
1	5/15/98	WRB				ISSUED FOR AS-BUILT

AS-BUILT DRAWINGS

FOR CONSTRUCTION		
DRAWN	WRB	9/28/95
CHECKED	ML	7/9/96
ENGINEER	JB	7/9/96
PROJ	MDW	7/9/96

PARSONS
 100 WEST WALNUT STREET
 PASADENA, CALIFORNIA

LIGO
 CALIFORNIA INSTITUTE OF TECHNOLOGY
 MASSACHUSETTS INSTITUTE OF TECHNOLOGY

LASER INTERFEROMETER
 GRAVITATIONAL-WAVE OBSERVATORY
 SITE NO. 1 - HANFORD, WASHINGTON

CIVIL UTILITY DETAILS
 SHEET 1

AS NOTED PPI50969 8094
WA-C-055

I:\lgo\site\ce\wac055.dgz