



# ARCHITECTURAL LEGEND

## REFERENCE

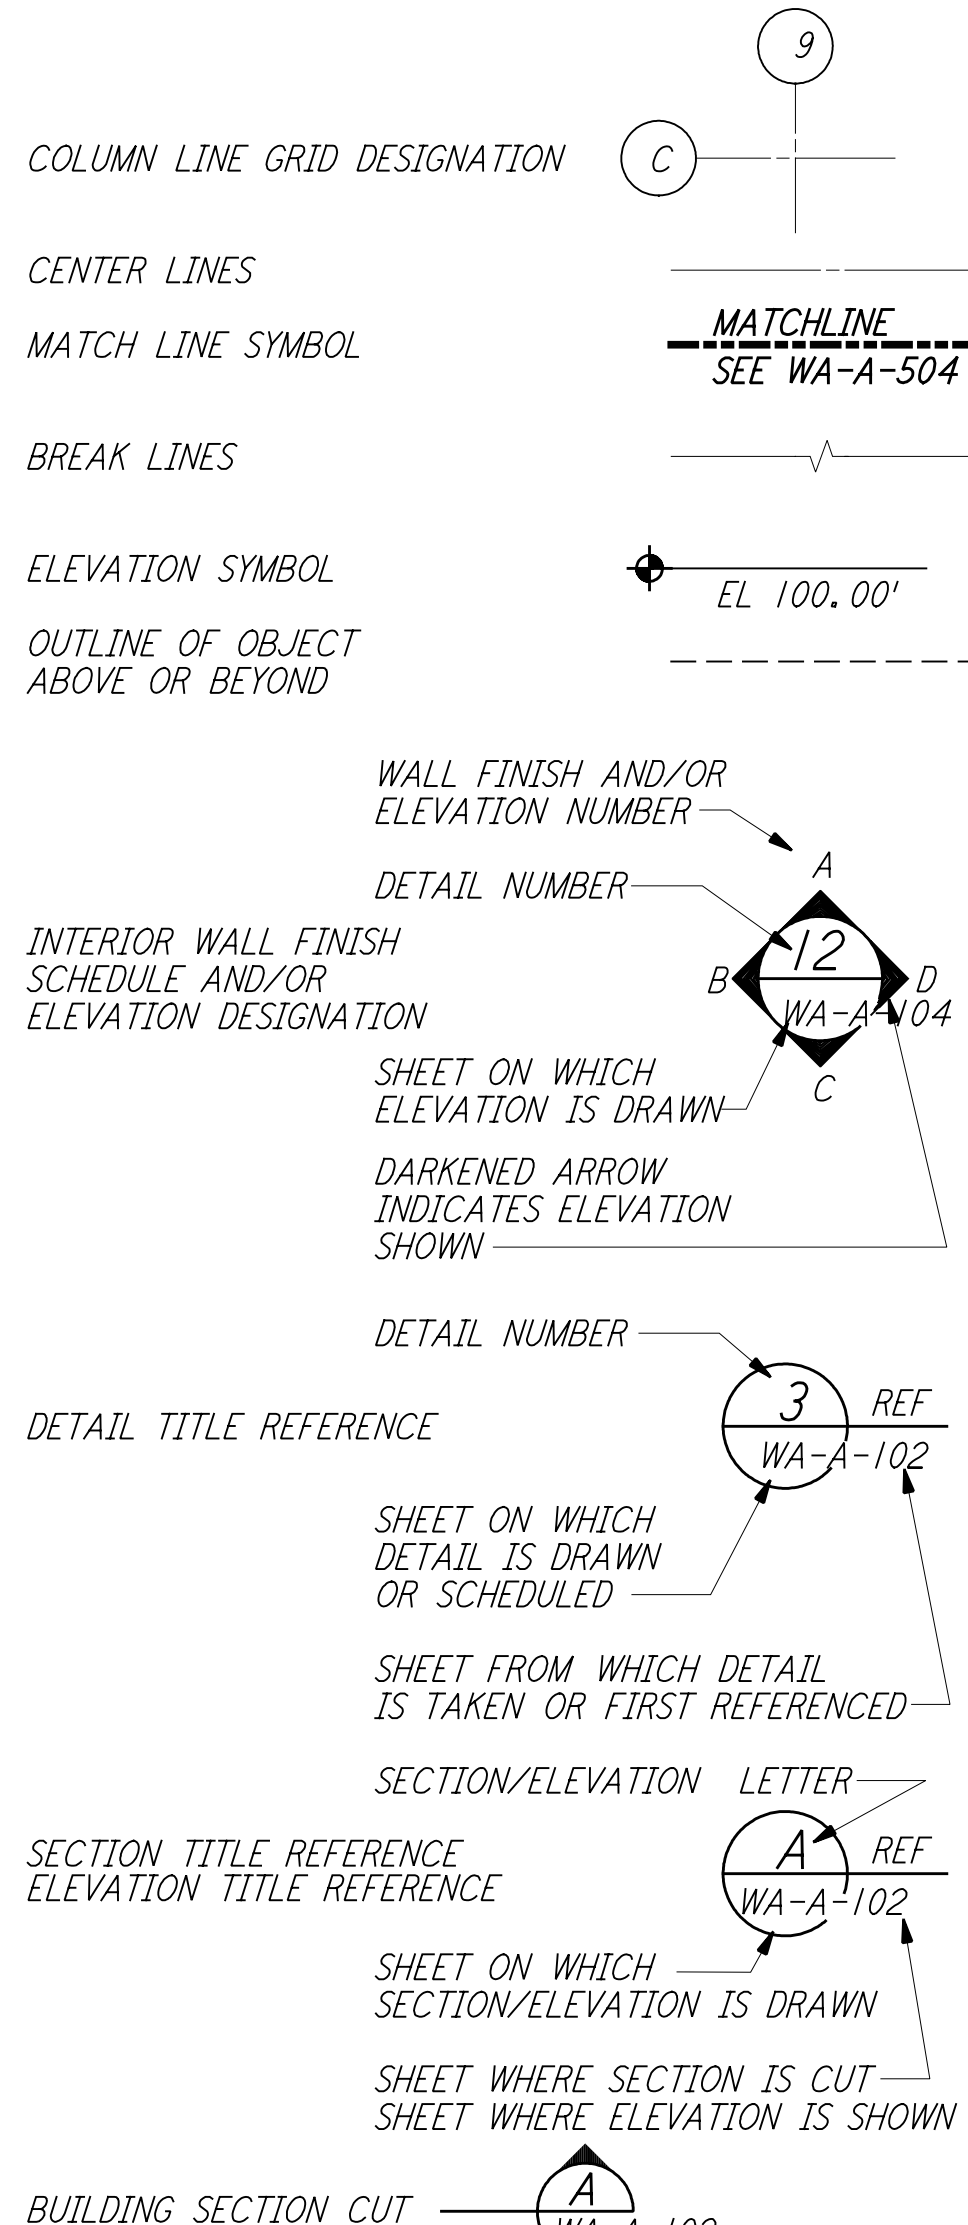

## SYMBOLS

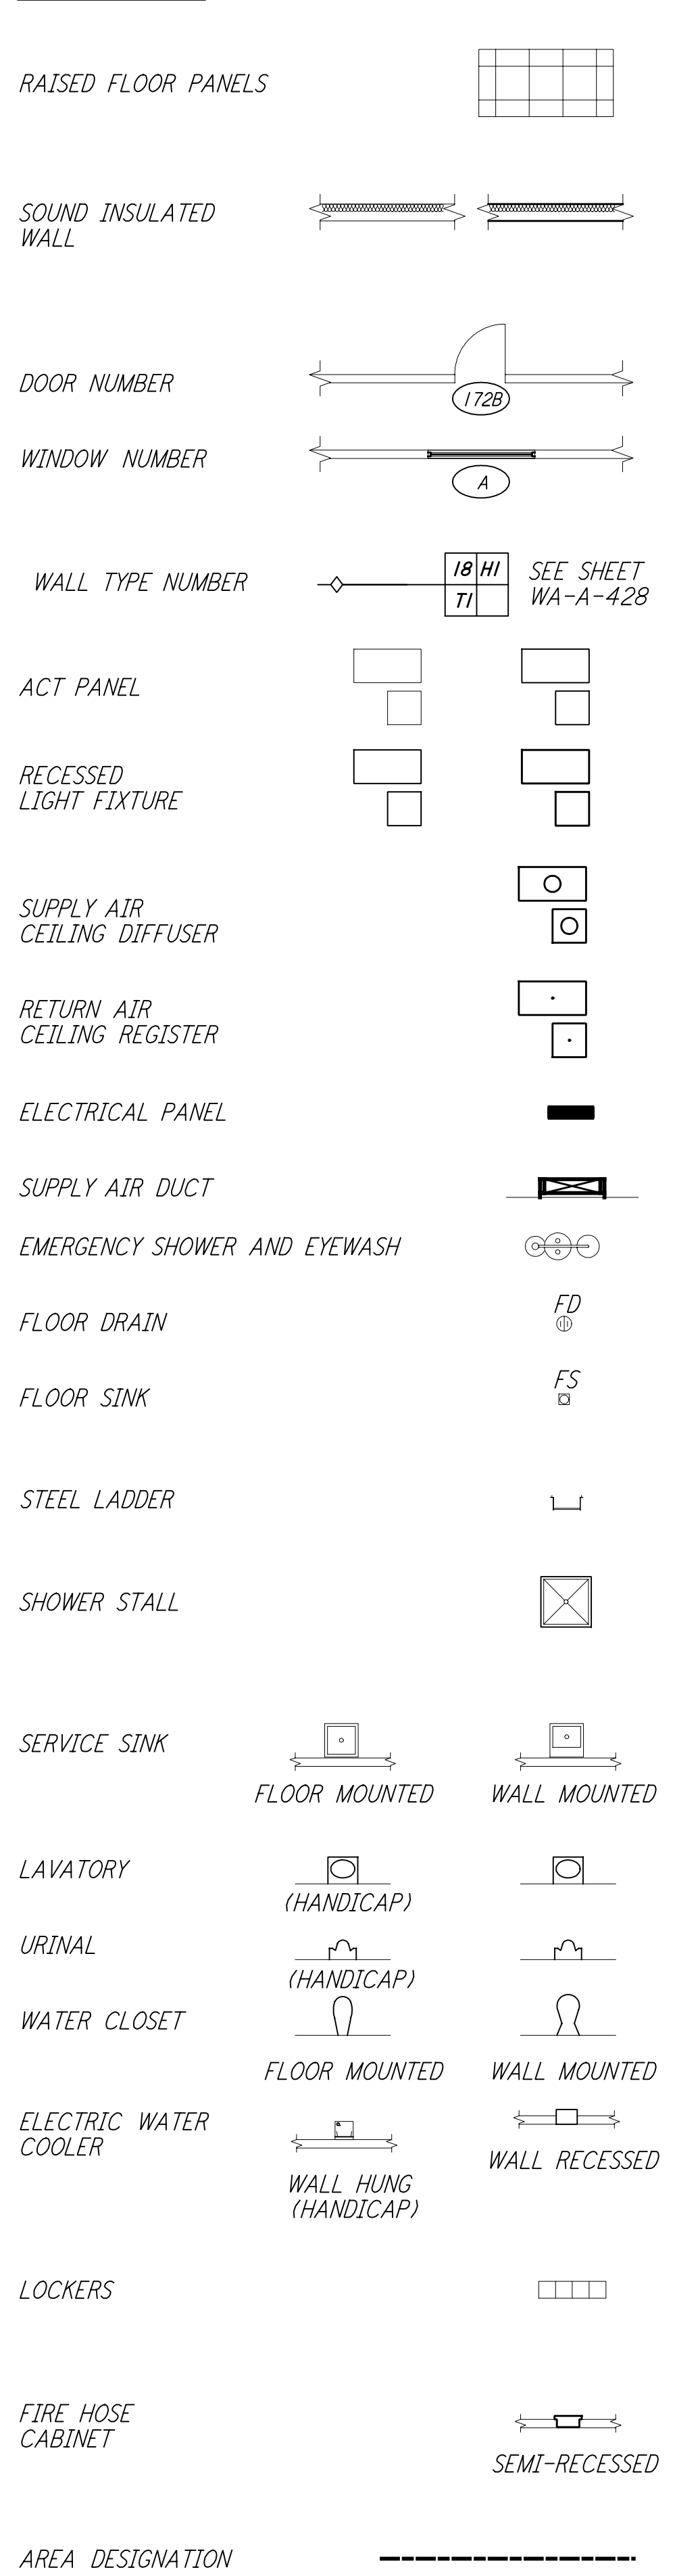

## DETAIL SYMBOLS

EARTH, ETC	EARTH	GRAVEL	SAND
CONCRETE, ETC	CONC	TER	ASPH
METALS	STEEL	ALUMINUM	OTHER
WOOD	FINISH EL	BLKG	STUD PART
	PLYWD		
GYP SUM			
GLASS	LG, SCALE	SM, SCALE	ELEV
INSULATION	BATT OR LOOSE	RIGID	RIGID

- A**
- A/C AIR CONDITIONING
  - AB ANCHOR BOLT
  - ABV ABOVE
  - AC ASPHALT CONCRETE
  - ACT ACOUSTICAL TILE CEILING
  - ADH ADHESIVE
  - ADJ ADJACENT, ADJUSTABLE
  - AFF ABOVE FINISHED FLOOR
  - AHU AIR HANDLING UNIT
  - AISC AMERICAN INSTITUTE OF STEEL CONSTRUCTION
  - AISI AMERICAN IRON AND STEEL INSTITUTE
  - AL ALUMINUM
  - ALT ALTERNATE
  - ANCH ANCHOR
  - ANSI AMERICAN NATIONAL STANDARDS INSTITUTE
  - APPROX APPROXIMATELY
  - ARCH ARCHITECT, ARCHITECTURAL
  - ASME AMERICAN SOCIETY OF MECHANICAL ENGINEERS
  - ASPH ASPHALT
  - ASSY ASSEMBLY
  - ASTM AMERICAN SOCIETY FOR TESTING AND MATERIALS
  - AUTO AUTOMATIC, AUTOMATION
  - AUX AUXILIARY
  - AVG AVERAGE

- B**
- BATT BATTEN
  - BC BOTTOM OF CURB, BEGIN CURVE
  - BOARD BOARD
  - BL BUILDING LINE
  - BLDG BUILDING
  - BLK BLOCK
  - BLKG BLOCKING
  - BM BEAM, BENCH MARK
  - BOC BOTTOM OF CONDUIT
  - BOCA BUILDING OFFICIALS & CODE ADMINISTRATION
  - BOD BOTTOM OF DUCT
  - BOF BOTTOM OF FOOTING
  - BOP BOTTOM OF PIPE
  - BOS BOTTOM OF STEEL
  - BOT BOTTOM
  - BR BROWN
  - BRG BEARING
  - BRKT BRACKET
  - BSMT BASEMENT
  - BTW BETWEEN

- C**
- \*C DEGREES CELSIUS
  - C COMMUNICATION DUCT OR LINE
  - C/C CENTER TO CENTER
  - CAB CABINET
  - CAP CAPACITY
  - CB CATCH BASIN
  - CF CUBIC FOOT/FEET
  - CHKD CHECKERED
  - CI CURB INLET, CAST IRON
  - CJ CONSTRUCTION JOINT
  - CL CENTERLINE
  - CLG CEILING
  - CLJ CONTROL JOINT
  - CLO CLOSET
  - CLR CLEAR
  - CMU CONCRETE MASONRY UNIT
  - CO CLEANOUT, COMPANY
  - COL COLUMN
  - COMM COMMUNICATIONS
  - CONC CONCRETE
  - CONN CONNECTION
  - CONSTR CONSTRUCTION
  - CONT CONTINUE, CONTINUATION, CONTINUOUS
  - CONTR CONTRACTOR
  - CP CONTROL PANEL
  - CPT CARPET
  - CR COLD ROLLED
  - CSK COUNTERSINK
  - CT CERAMIC TILE
  - CTR CENTER
  - CU FT CUBIC FOOT/FEET
  - CU YD CUBIC YARD(S)
  - CY CUBIC YARD(S)

- D**
- DB DECIBEL
  - DBL DOUBLE
  - DEG DEGREE
  - DET DETAIL
  - DF DRINKING FOUNTAIN
  - DIA DIAMETER
  - DIAG DIAGONAL
  - DIM DIMENSION
  - DISCH DISCHARGE
  - DISTR DISTRIBUTION
  - DN DOWN
  - DR DOOR, DRAIN
  - DS DOWNSPOUT
  - DTL DETAIL
  - DWG DRAWING
  - DWGS DRAWINGS

- E**
- E EAST
  - EA EACH
  - EF EACH FACE
  - EFF EFFICIENCY
  - EJ EXPANSION JOINT
  - EL ELEVATION
  - ELEC ELECTRICAL
  - EMERG EMERGENCY
  - ENCL ENCLOSURE
  - ENT ENTERING
  - ENTR ENTRANCE
  - EQ EQUAL
  - EQUIP EQUIPMENT
  - EST ESTIMATE
  - ET ELECTRICAL HEAT TRACE
  - ETC ETCETERA
  - EW EACH WAY
  - EWG ELECTRIC WATER COOLER
  - EWH ELECTRIC WATER HEATER
  - EXIST EXISTING
  - EXP EXPOSED, EXPANSION
  - EXT EXTERIOR, EXTERNAL

- F**
- \*F DEGREES FAHRENHEIT
  - F TO F FACE TO FACE
  - FA FIRE ALARM
  - FD FLOOR DRAIN
  - FDN FOUNDATION
  - FE FIRE EXTINGUISHER
  - FEC FIRE EXTINGUISHER CABINET
  - FF FINISH FLOOR
  - FFE FINISHED FLOOR ELEVATION
  - FG FINISHED GRADE
  - FHC FIRE HOSE CABINET
  - FH FIRE HYDRANT
  - FIN FINISH
  - FLG FLANGE
  - FLMT FLUSH MOUNT
  - FLR FLOOR
  - FLUOR FLUORESCENT
  - FM FACTORY MUTUAL
  - FOC FACE OF CONCRETE
  - FOG FACE OF GIRT
  - FOS FACE OF STUD
  - FOW FACE OF WALL
  - FP FIREPROOF, FIREPROOFED
  - FR FROM, FIRE RATED
  - FRP FIBERGLAS REINFORCED PANEL
  - FS FAR SIDE, FLOOR SINK, FLOW SWITCH
  - FT FOOT, FEET
  - FTG FOOTING, FITTING
  - FUT FUTURE
  - FVC FIRE VALVE CABINET
  - FW FIELD WELD
  - FWD FORWARD

- G**
- G GREEN, GUTTER
  - GA GAUGE
  - GAL GALLON
  - GALV GALVANIZED
  - GB GRADE BEAM, GRAB BAR
  - GEN GENERAL, GENERATOR
  - GI GALVANIZED IRON
  - GL GLASS, GLAZING
  - GND GROUND
  - GOVT GOVERNMENT
  - GR GRADE
  - GRTG GRATING
  - GWB GYPSUM WALLBOARD
  - GYP GYPSUM

- H**
- HC HANDICAPPED ACCESSIBLE
  - HD HEAD
  - HDNR HARDENER
  - HDR HEADER
  - HDW HARDWARE
  - HDWD HARDWOOD
  - HM HOLLOW METAL
  - HORIZ HORIZONTAL
  - HP HORSEPOWER, HIGH POINT
  - HR HOUR
  - HT HEIGHT
  - HTD HAND TOWEL DISPENSER
  - HVAC HEATING, VENTILATING, AND AIR CONDITIONING

# ABBREVIATIONS

- I**
- ID INSIDE DIAMETER
  - IE INVERT ELEVATION
  - IF INSIDE FACE
  - IN INCH
  - INCL INCLUDE
  - INST INSTANTANEOUS
  - INSTR INSTRUMENT
  - INSUL INSULATE, INSULATION, INSULATED
  - INT INTERIOR

- J**
- JAN JANITOR
  - JC JANITOR CLOSET
  - JCT JUNCTION
  - JST JOIST
  - JT JOINT

- K**
- K KJP

- L**
- L LENGTH
  - LAB LABORATORY
  - LAT LATERAL
  - LAV LAVATORY
  - LF LINEAR FEET
  - LG LARGE
  - LH LEFT HAND
  - LLH LONG LEG HORIZONTAL
  - LLV LONG LEG VERTICAL
  - LONG LONGITUDINAL
  - LP LOW POINT
  - LTG LIGHTING
  - LVR LOUVER
  - LVEA LASER VACUUM EQUIPMENT AREA

- M**
- MAINT MAINTENANCE
  - MATL MATERIAL
  - MAX MAXIMUM
  - MB MACHINE BOLT
  - MCC MOTOR CONTROL CENTER
  - MECH MECHANICAL
  - MED MEDIUM
  - MEMB MEMBRANE
  - MFR MANUFACTURER
  - MET METAL
  - MH MANHOLE
  - MIN MINIMUM, MINUTE
  - MISC MISCELLANEOUS
  - MOD MODIFY, MODIFICATION
  - MPH MILES PER HOUR
  - MTD MOUNTED
  - MULL MULLION

- N**
- NIC NOT IN CONTRACT
  - NOM NOMINAL

- O**
- OT QUARRY TILE
  - QTY QUANTITY

- R**
- R RED, RISER, RADIUS
  - RCP REINFORCED CONCRETE PIPE
  - RD ROOF DRAIN
  - RDR RADIATOR
  - REBAR REINFORCING STEEL BAR
  - REF REFERENCE
  - REFR REFRIGERATOR
  - REINF REINFORCEMENT, REINFORCED
  - REQD REQUIRED
  - REV REVISION
  - RH RIGHT HAND
  - RM ROOM
  - RO ROUGH OPENING
  - ROW ROW
  - RVS REVERSE

- S**
- S SOUTH
  - SAP SOUND ABSORBING PANEL
  - SCHED SCHEDULE
  - SCHEM SCHEMATIC
  - SECT SECTION
  - SEP SEPARATOR
  - SGL SINGLE
  - SHT SHEET
  - SIM SIMILAR
  - SPEC SPECIFICATIONS
  - SPKR SPEAKER
  - SO SQUARE
  - SO FT SQUARE FOOT/FEET
  - SS SANITARY SEWER/SERVICE SINK
  - SST STAINLESS STEEL
  - STD STANDARD
  - STIF STIFFENER
  - STL STEEL
  - STOR STORAGE
  - STRD STRANDED
  - STRUCT STRUCTURAL
  - SURF SURFACE
  - SUSP SUSPENDED
  - SYM SYMMETRICAL
  - SYS SYSTEM

- T**
- T TREAD, TANGENT DISTANCE
  - T&B TOP AND BOTTOM
  - T&G TONGUE AND GROOVE
  - TBD TO BE DETERMINED
  - TC TOP OF CURB
  - TEL TELEPHONE
  - TEMP TEMPERATURE, TEMPORARY
  - TEMP TERRAZZO
  - THK THICK/THICKNESS
  - TOC TOP OF CONCRETE
  - TOD TOP OF DUCT
  - TOS TOP OF STEEL
  - TOW TOP OF WALL
  - TPD TOP OF PAVEMENT
  - TS TUBE STEEL
  - TYP TYPICAL

- U**
- UBC UNIFORM BUILDING CODE
  - UC UNDERCUT
  - UG UNDERGROUND
  - UL UNDERWRITERS LABORATORIES
  - UNO UNLESS OTHERWISE NOTED
  - UPC UNIFORM PLUMBING CODE
  - UPS UNINTERRUPTIBLE POWER SUPPLY
  - UR URINAL
  - UTIL UTILITY

- V**
- VB VINYL BASE
  - VBT VINYL BASE AND TRIM
  - VC VERTICAL CURVE
  - VCT VINYL COMPOSITION TILE
  - VEL VELOCITY
  - VERT VERTICAL
  - VEST VESTIBULE
  - VIF VERIFY IN FIELD

- W**
- W/ WITH
  - W/O WITHOUT
  - WC WATER CLOSET
  - WCP WALL AND CEILING PAINT
  - WD WOOD
  - WH WATER HEATER, WALL HYDRANT
  - WO WINDOW OPENING
  - WP WATERPROOF, WORKING POINT
  - WR WATER RESISTANT
  - WSCT WAJNSCOT
  - WT WEIGHT
  - WWF WELDED WIRE FABRIC

- Y**
- Y YELLOW

- MISCELLANEOUS**
- # NUMBER, POUNDS
  - & AND
  - @ AT
  - ⊕ CENTERLINE
  - ' FEET OR MINUTES
  - " INCHES OR SECONDS
  - ° DEGREES
  - ∅ DIAMETER, ROUND

LIGO-D960245-01-0

ISSUED FOR CONSTRUCTION	DRAWN	CKT	5-12-96
CHECKED	TB	5-26-96	
ENGINEER	bkk	7-12-96	
PROJ	MDW	7-12-96	
<b>AS-BUILT DRAWINGS</b>			
ISSUED FOR AS-BUILT			
REV	NO.	DATE	BY
1	5-15-98	CKT	
DRAWING NO. DESCRIPTION			

LASER INTERFEROMETER GRAVITATIONAL-WAVE OBSERVATORY SITE NO. 1 - HANFORD, WASHINGTON			
TITLE	SCALE	DRAWING NUMBER	PROJECT NUMBER
ARCHITECTURAL LEGEND, SYMBOLS & ABBREVIATIONS	NONE	PP150969	8094
SHEET NUMBER	WA-A-001		REVISIONS

This document and the design it covers are the property of PARSONS. They are loaned only with the borrower's expressed written agreement that they will not be reproduced, copied, loaned, exhibited, or used in any other way, except by written consent from PARSONS to the borrower.



*Note 1, Linda L Turner, 04/13/99 03:10:17 PM*  
LIGO-D960245-01-O