



ENLARGED PLAN


JANITOR 136 / SHOWER TOILET 137
 1/4" = 1'-0"

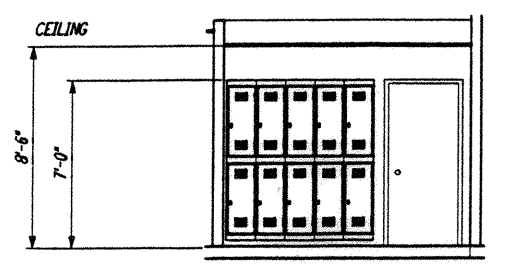


ELEVATION A

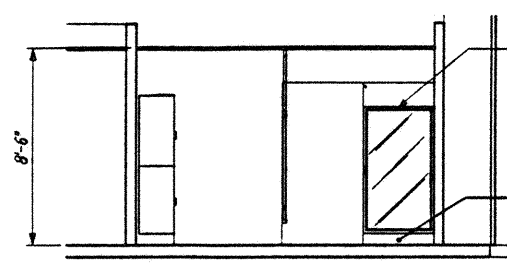

ELEVATION B

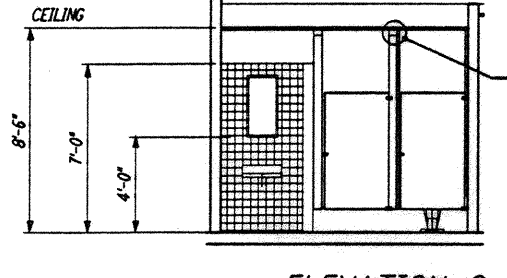


ELEVATION C

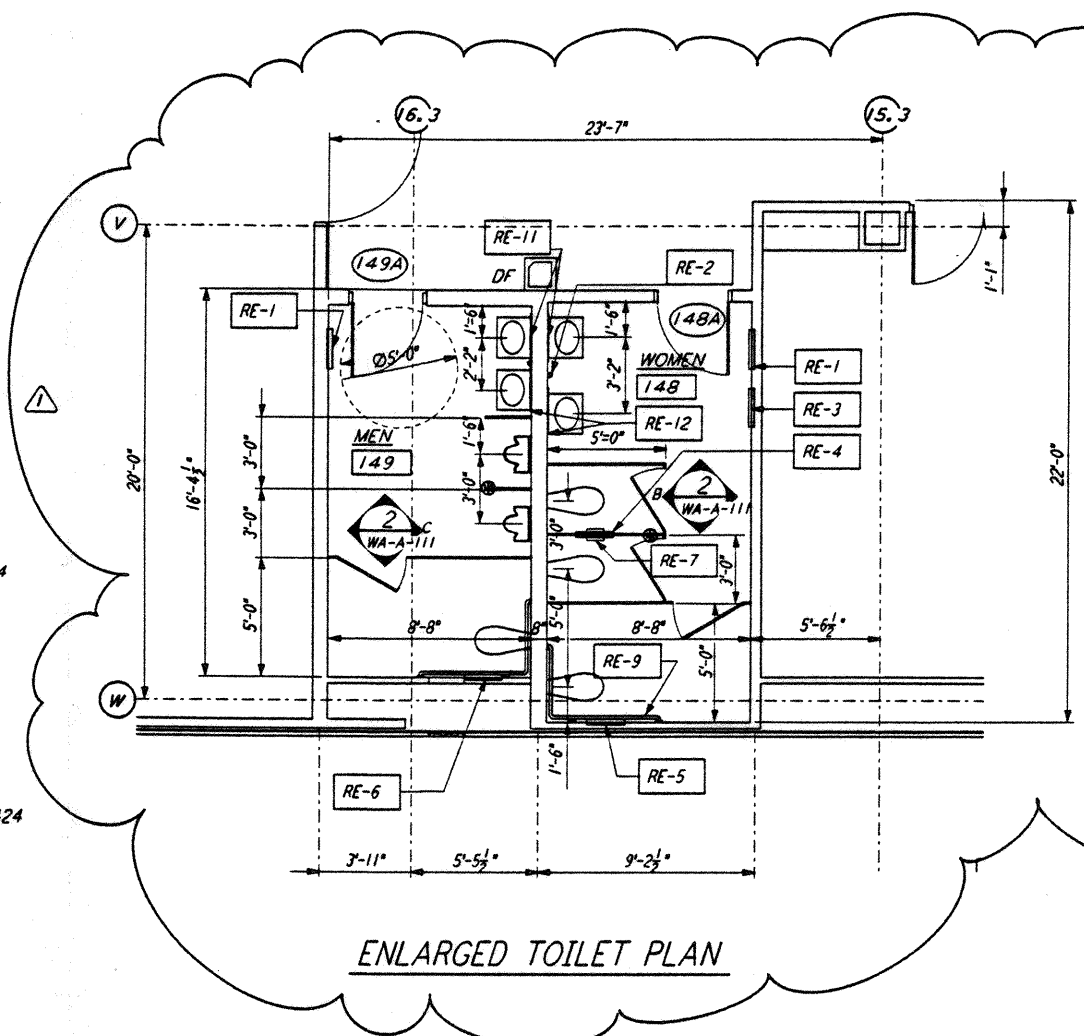

ENLARGED TOILET PLAN


MEN 149 / WOMEN 148
 1/4" = 1'-0"

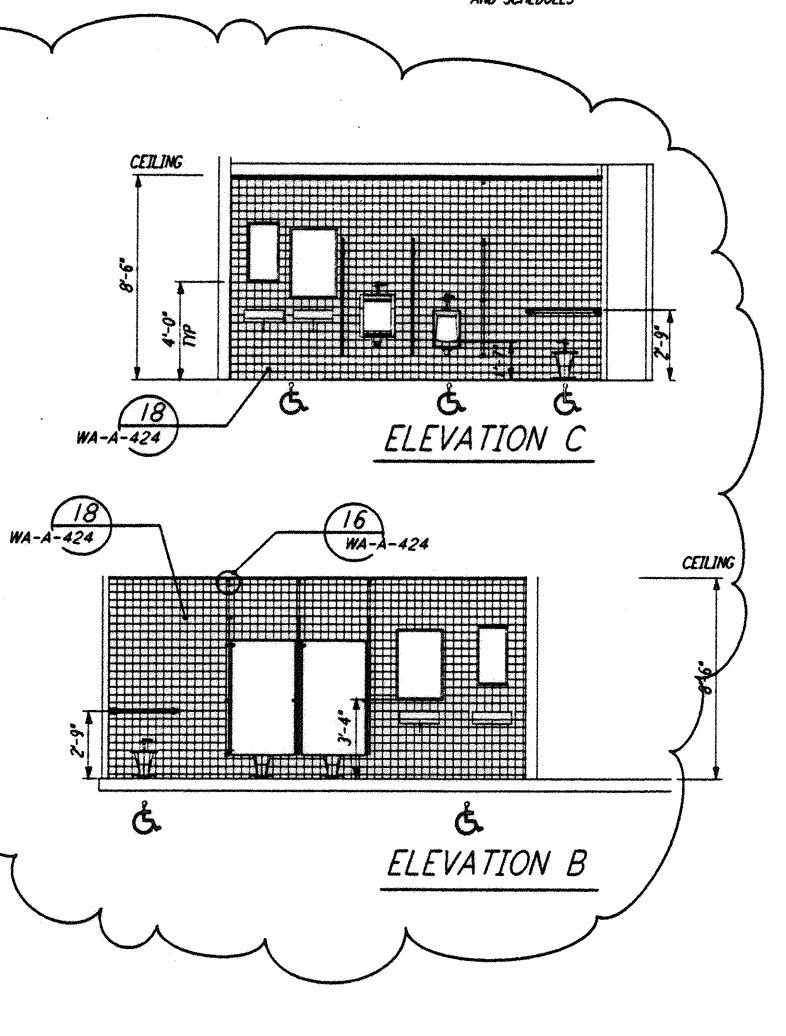

ELEVATION C


ELEVATION B

NOTE: SEE SPECIFICATIONS FOR ADDITIONAL INFORMATION AND SCHEDULES

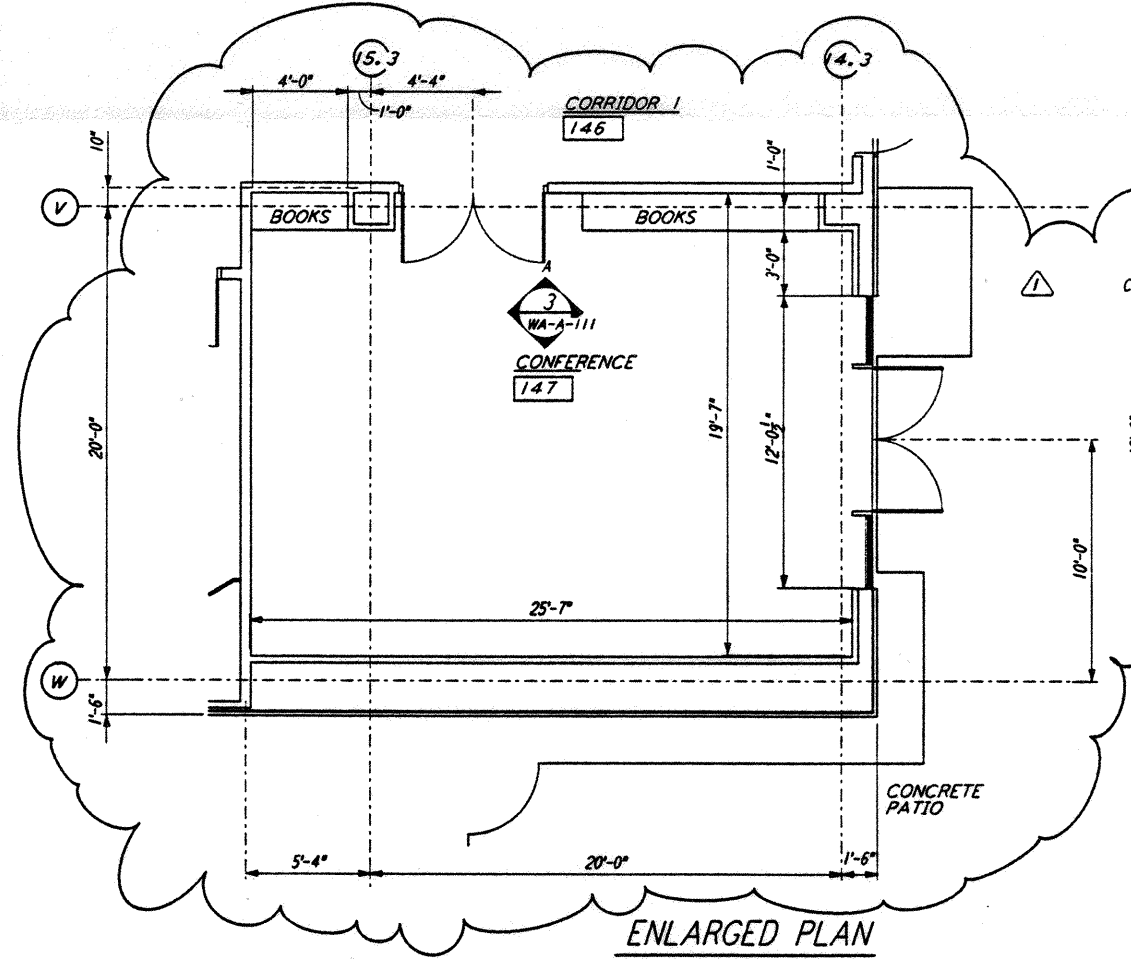


ENLARGED PLAN

CONFERENCE ROOM 147
 1/4" = 1'-0"

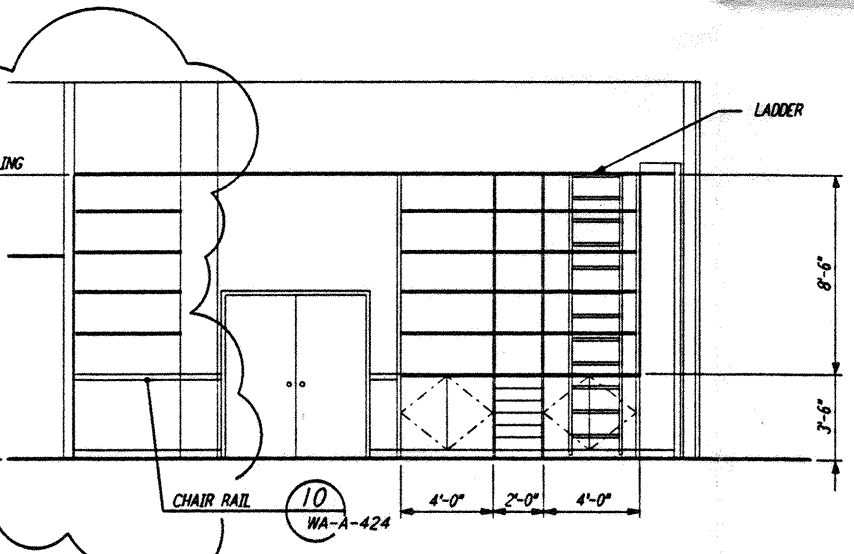


ELEVATION A

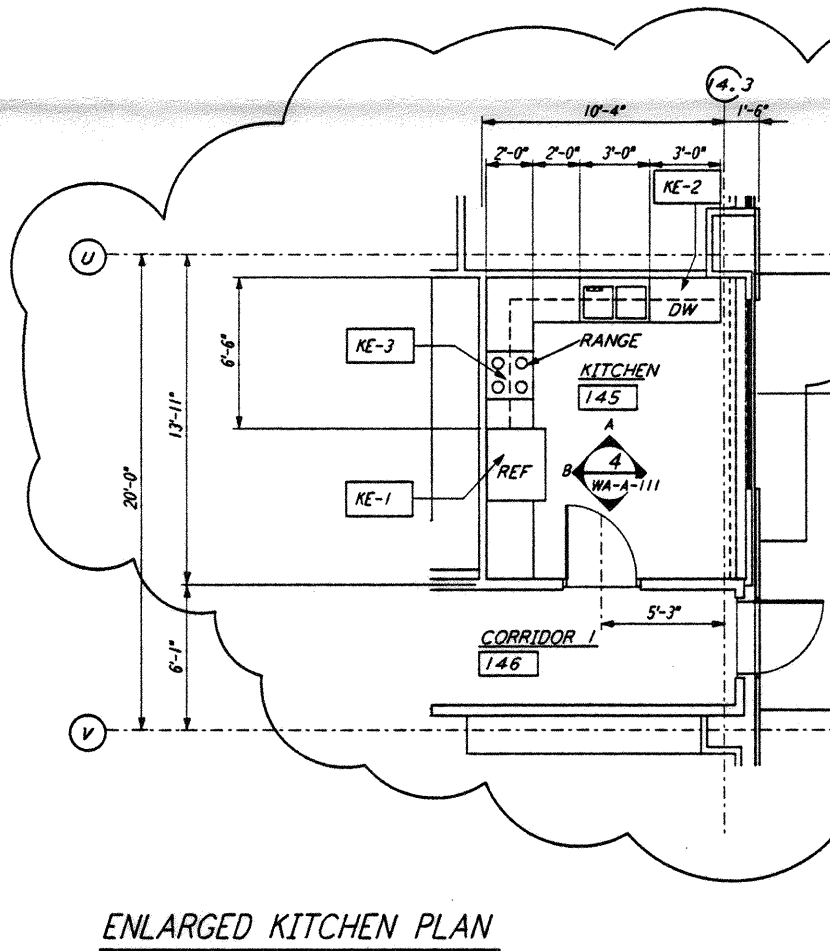

ENLARGED KITCHEN PLAN

KITCHEN PLAN 145
 1/4" = 1'-0"

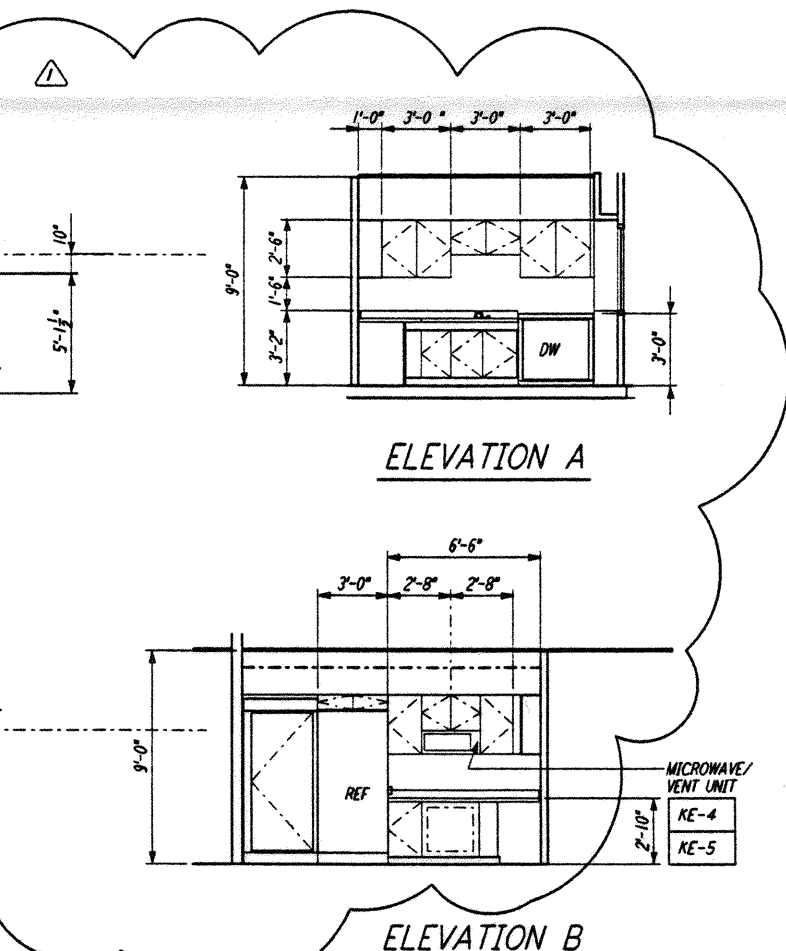

ELEVATION A

ELEVATION B

0 4 8 12 16 FT
 1/4" = 1'-0"

LIGO-D960250-01-O

This document and the design it covers are the property of PARSONS. They are loaned only with the borrower's expressed written agreement that they will not be reproduced, copied, loaned, exhibited, or used in any other way, except by written consent from PARSONS to the borrower.


This document and the design it covers are the property of PARSONS. They are loaned only with the borrower's expressed written agreement that they will not be reproduced, copied, loaned, exhibited, or used in any other way, except by written consent from PARSONS to the borrower.

000 000 11 12/01/97 1171 5742002 KATLUSUBUESYVREKARU000000

000 000 11 12/01/97 1171 5742002 KATLUSUBUESYVREKARU000000

NO.	DATE	BY	CHKD	ENGR	PROJ	OSB REVISION	DESCRIPTION
1	2-28-97	CKT	TB	AK	TOM	OSB	REVISION

ISSUED FOR CONSTRUCTION	DATE
DRAWN	CKT 5-12-96
CHECKED	TB 5-26-96
ENGINEER	DAK 7-12-96
PROJ	MDW 7-12-96

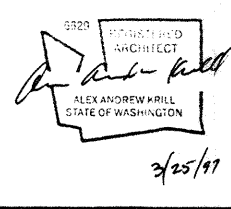

PARSONS
 100 WEST WALNUT STREET
 PASADENA, CALIFORNIA

LIGO
 CALIFORNIA INSTITUTE OF TECHNOLOGY
 MASSACHUSETTS INSTITUTE OF TECHNOLOGY

LASER INTERFEROMETER
 GRAVITATIONAL-WAVE OBSERVATORY
 SITE NO. 1 - HANFORD, WASHINGTON

ARCHITECTURAL
 CORNER STATION
 OSB ENLARGED PLANS

AS NOTED PPI50969 8094
WA-A-111