
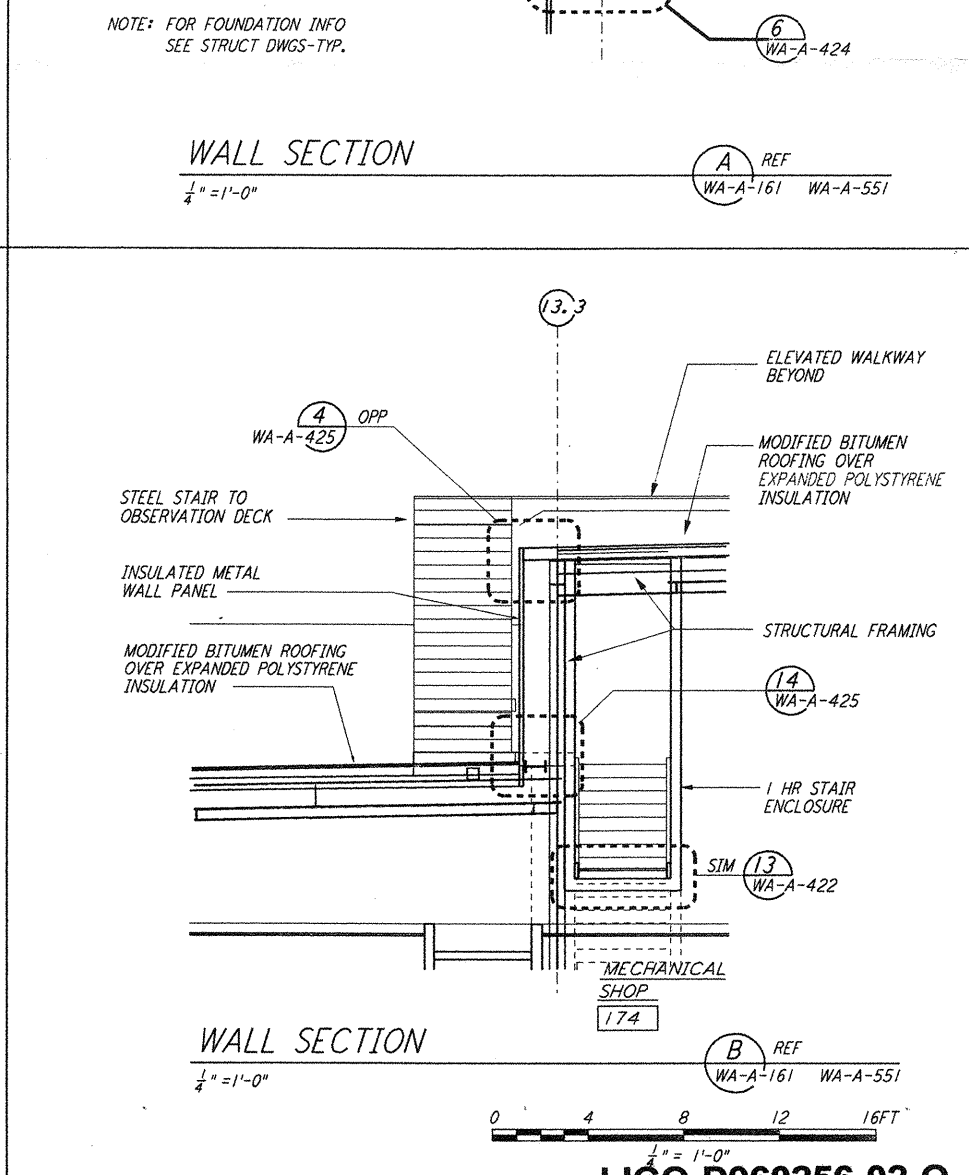
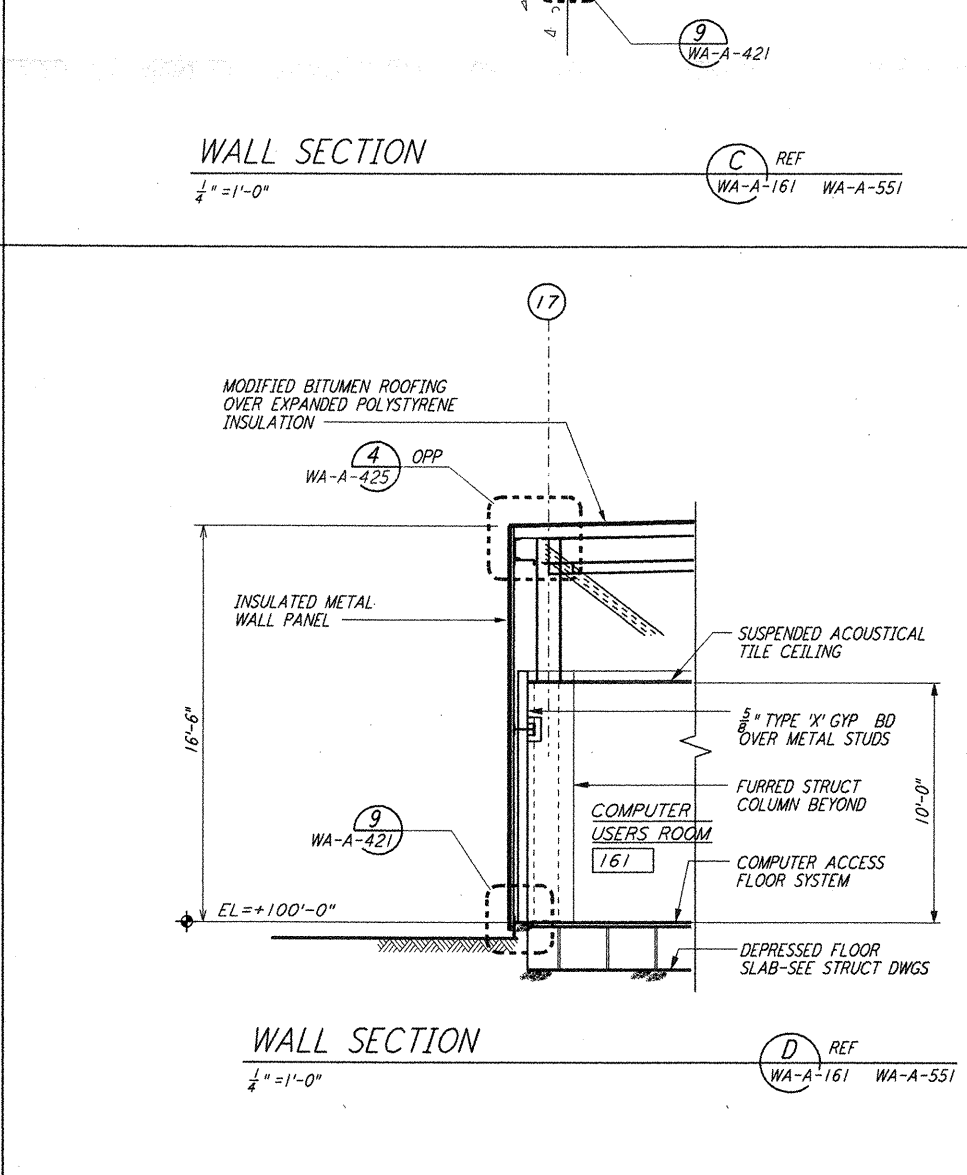
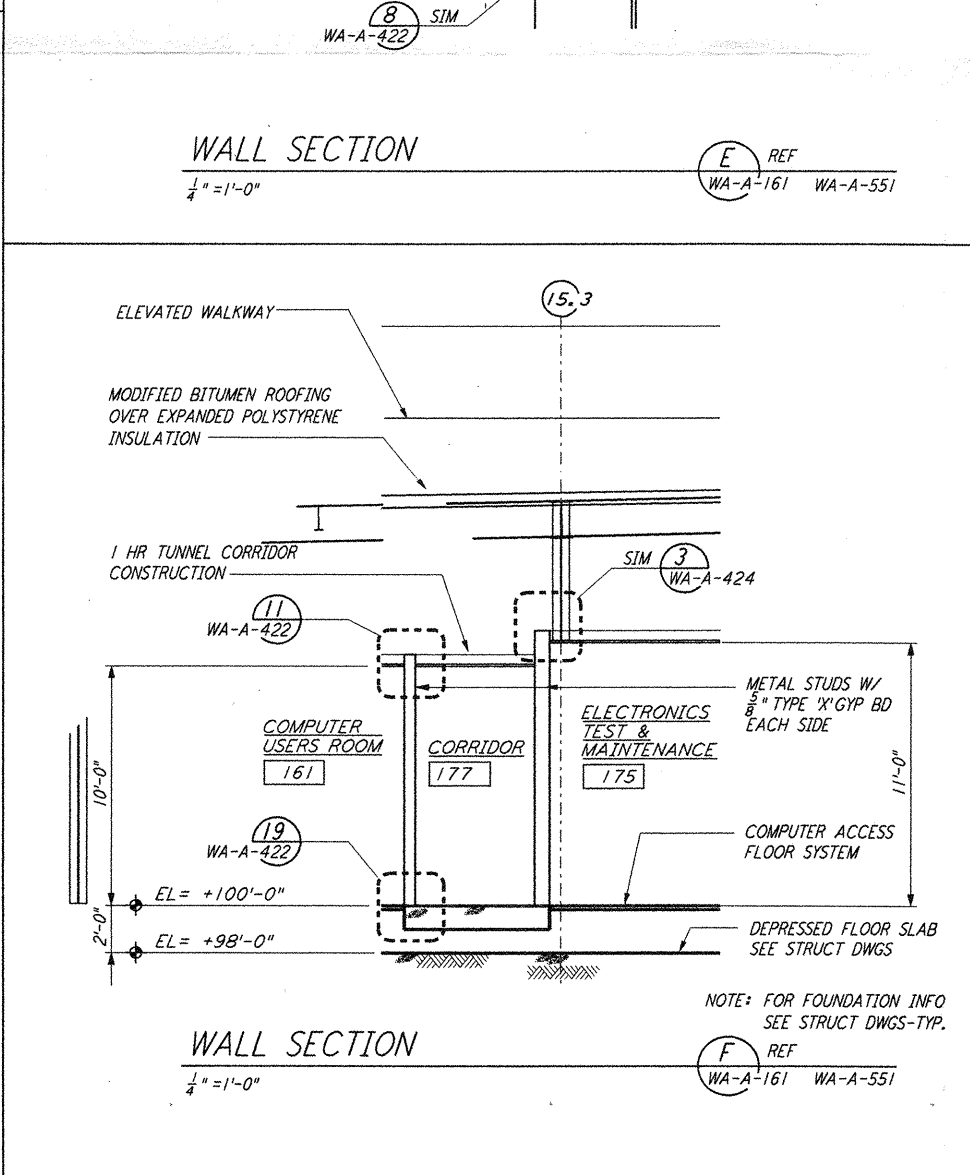
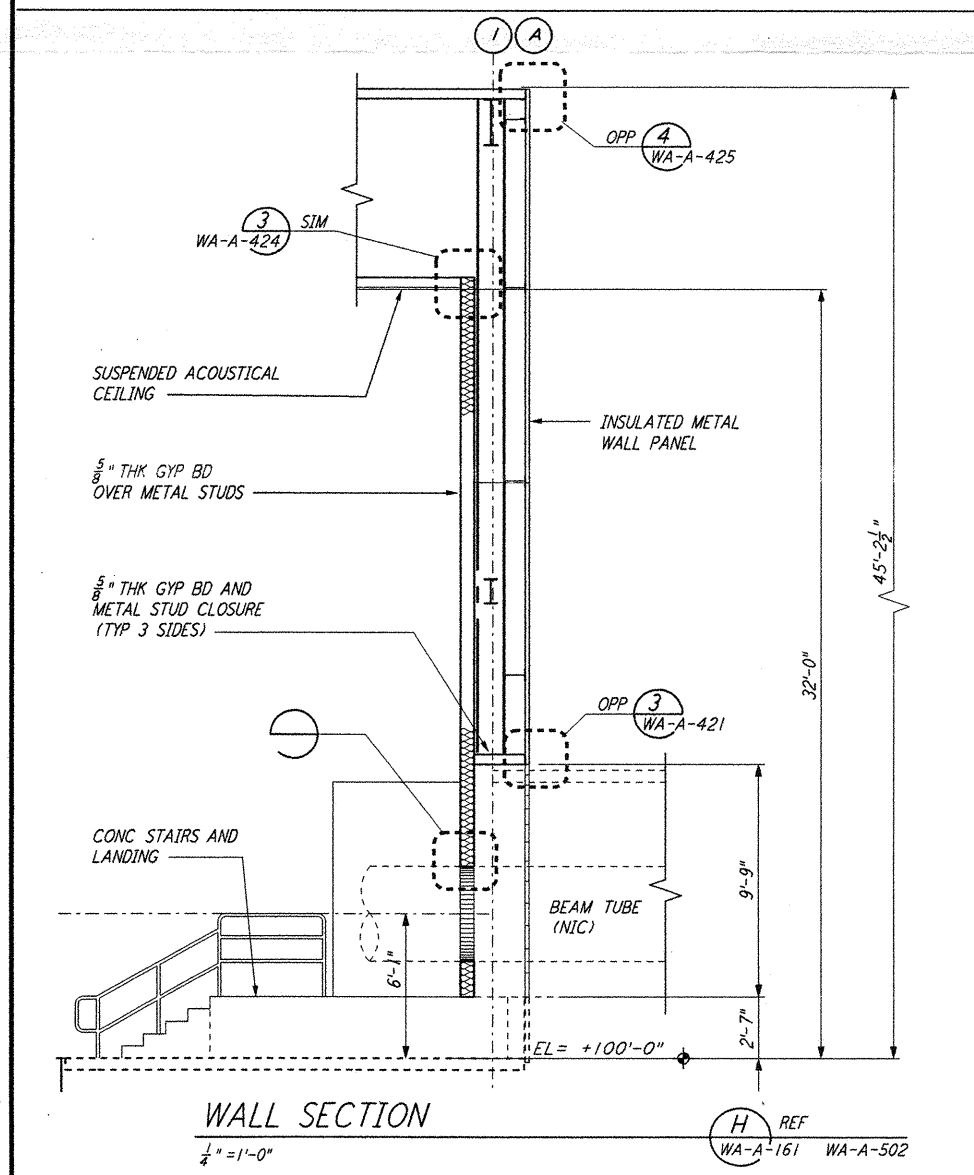
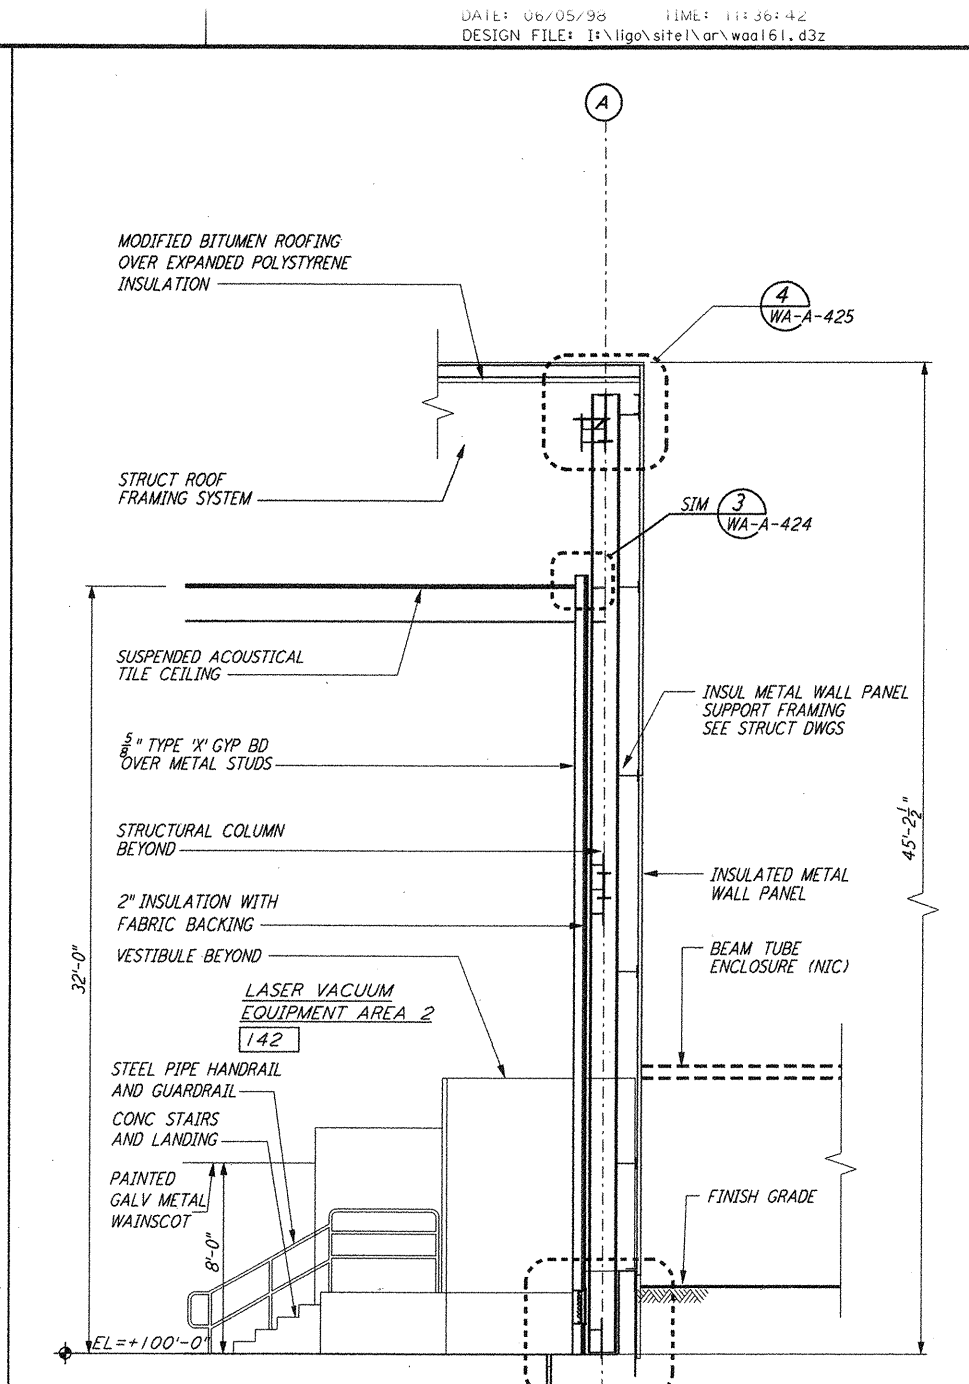
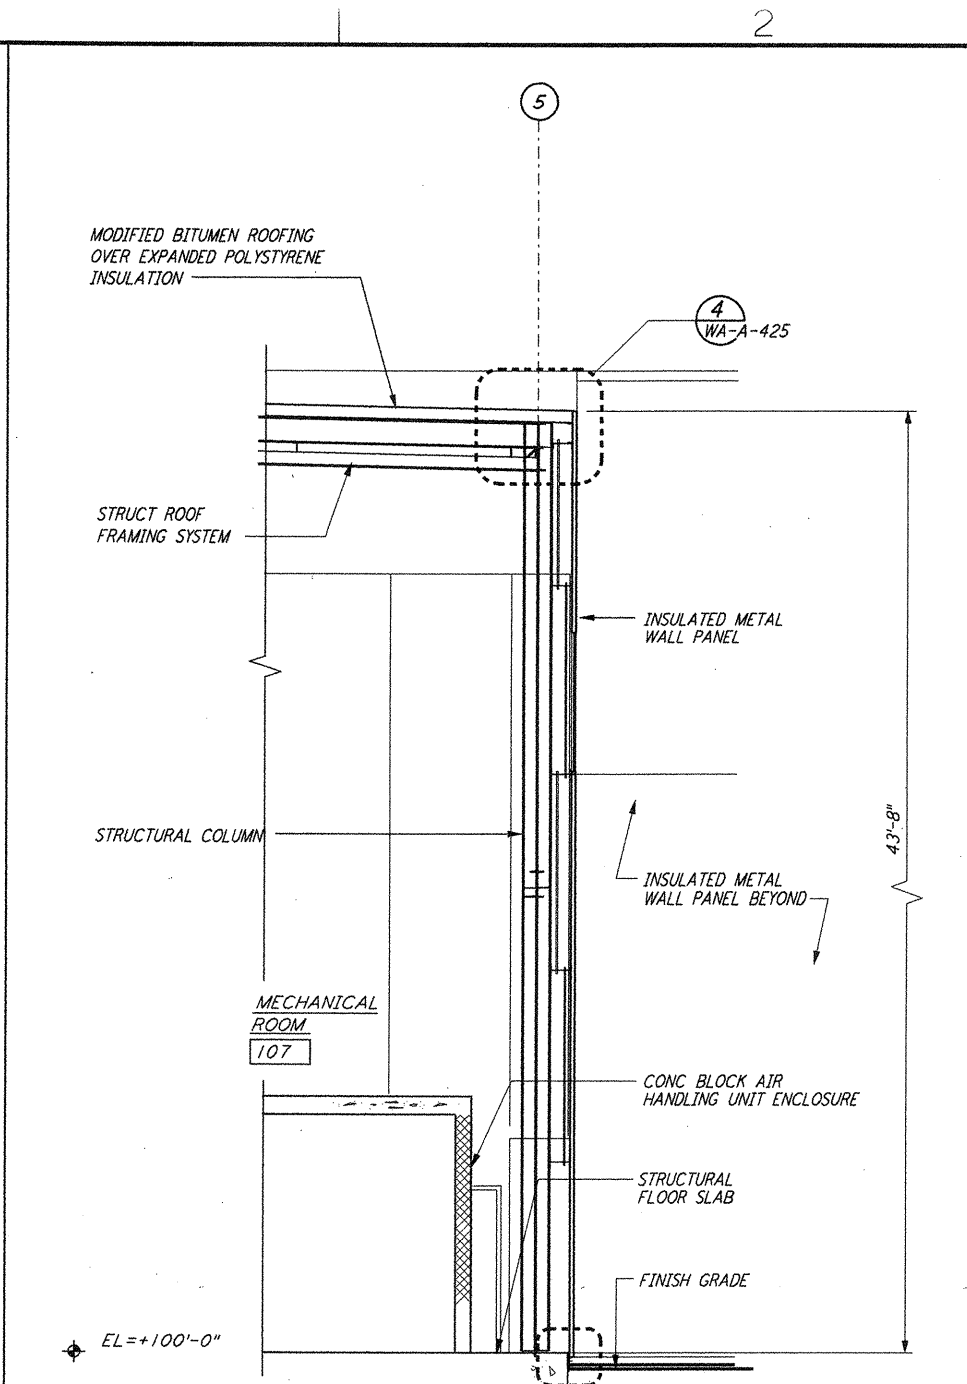
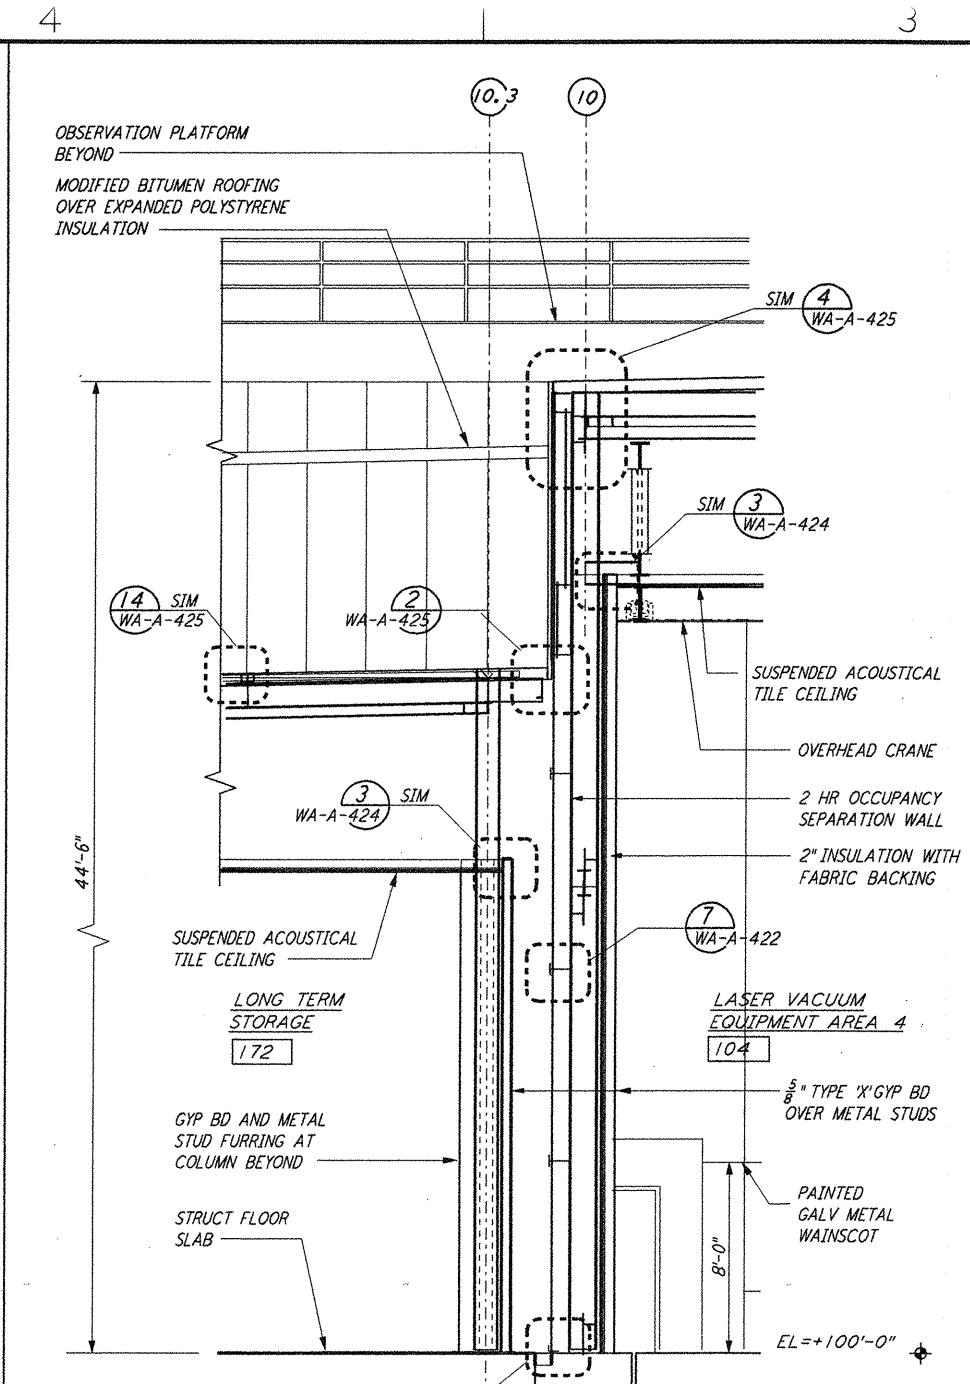


This document and the design it covers are the property of PARSONS. They are loaned only with the borrower's expressed written agreement that they will not be reproduced, copied, loaned, exhibited, or used in any other way, except by written consent from PARSONS.

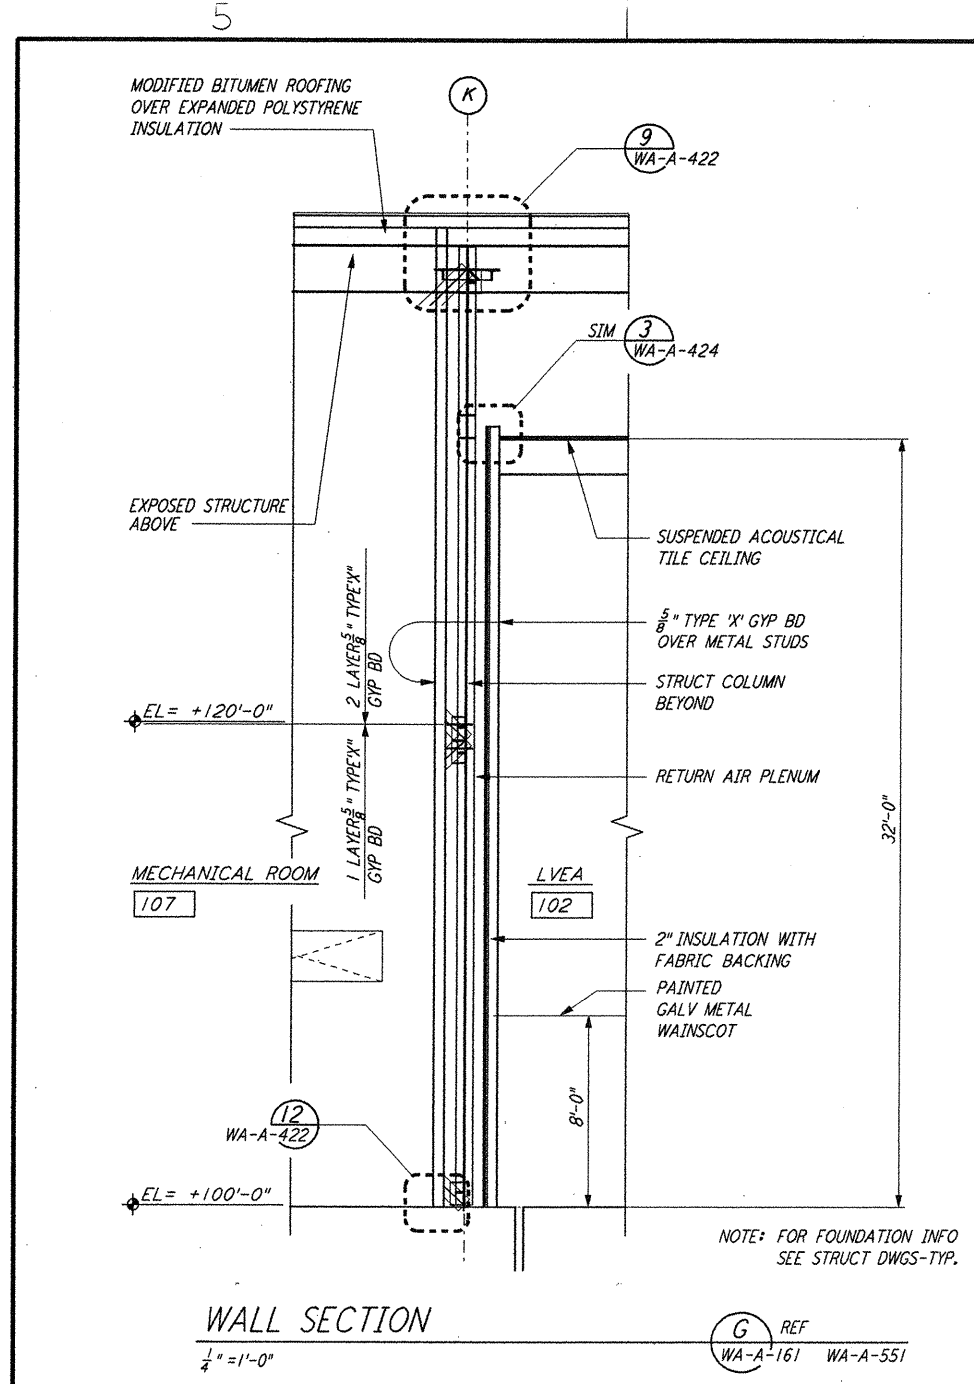

NO.	DATE	BY	CHKD	ENGR	PROJ	DESCRIPTION
2	5-15-98	CKT	WAL	MDW	MDW	ISSUED FOR AS-BUILT
1	2-28-97	CKT	TB	AK	TDM	CORNER STATION VSEA PARTITION

NO.	DATE	BY	CHKD	ENGR	PROJ	DESCRIPTION
1	7-12-96	MDW	MDW	MDW	MDW	ISSUED FOR CONSTRUCTION
2	5-12-96	CKT	WAL	MDW	MDW	DRAWN
3	5-26-96	TB	WAL	MDW	MDW	CHECKED
4	7-12-96	MDW	WAL	MDW	MDW	ENGINEER
5	7-12-96	MDW	WAL	MDW	MDW	PROJ

**AS-BUILT DRAWINGS**

**PARSONS**  
 100 WEST WALNUT STREET  
 PASADENA, CALIFORNIA

**LIGO**  
 CALIFORNIA INSTITUTE OF TECHNOLOGY  
 MASSACHUSETTS INSTITUTE OF TECHNOLOGY

**LIGO-D960256-02-0**  
 LASER INTERFEROMETER  
 GRAVITATIONAL-WAVE OBSERVATORY  
 SITE NO. 1 - HANFORD, WASHINGTON

TITLE: **ARCHITECTURAL CORNER STATION WALL SECTIONS SHEET 1**

PROJECT NUMBER: **AS NOTED PPI 150969**

CONTRACT NUMBER: **8094**

REVISION: **WA-A-161**

5 4 3 2 1  
 E D C B A  
 LIGOWF3.BDR  
 11/26/98 11:26:39 AM C:\PLOT\IGOE\31\9862AC\52085 K:\V3882\8\161.rvt