



This document and the design it covers are the property of PARSONS. They are loaned only with the borrower's expressed written agreement that they will not be reproduced, copied, loaned, exhibited, or used in any other way, except by written consent from PARSONS to the borrower.


This document and the design it covers are the property of PARSONS. They are loaned only with the borrower's expressed written agreement that they will not be reproduced, copied, loaned, exhibited, or used in any other way, except by written consent from PARSONS to the borrower.

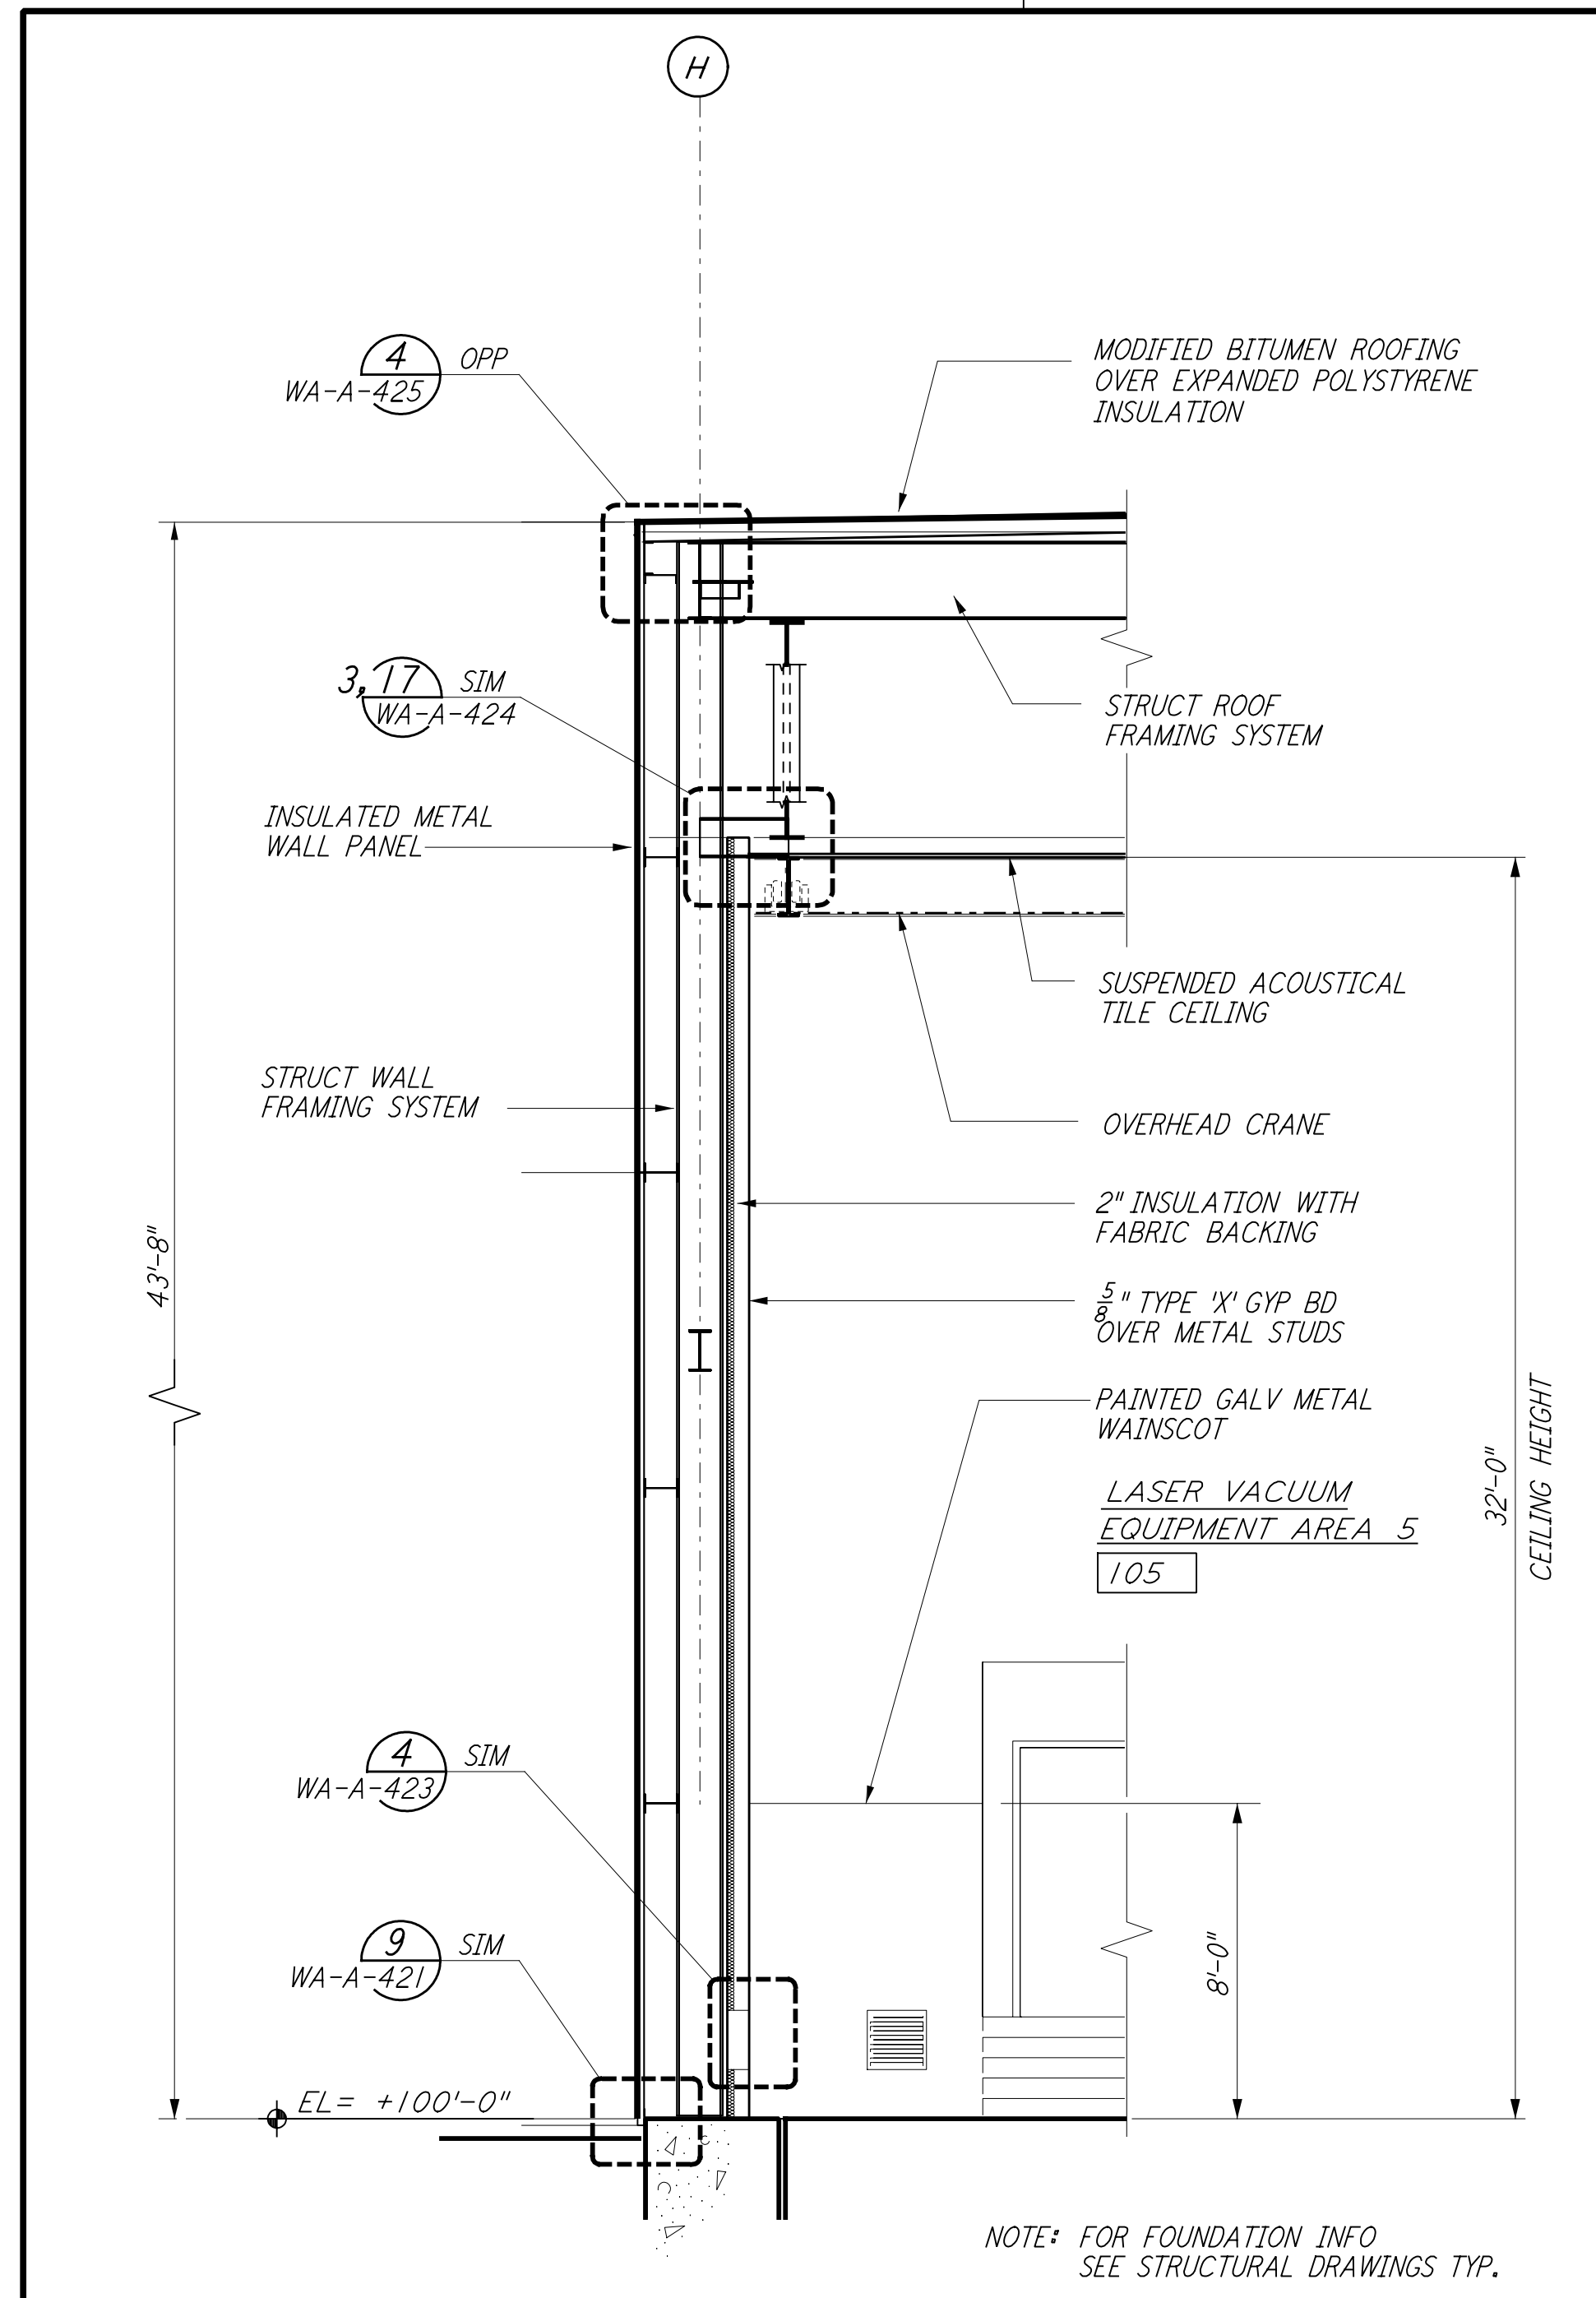


WALL SECTION G
 1/4" = 1'-0"
 REF: WA-A-162 WA-A-552

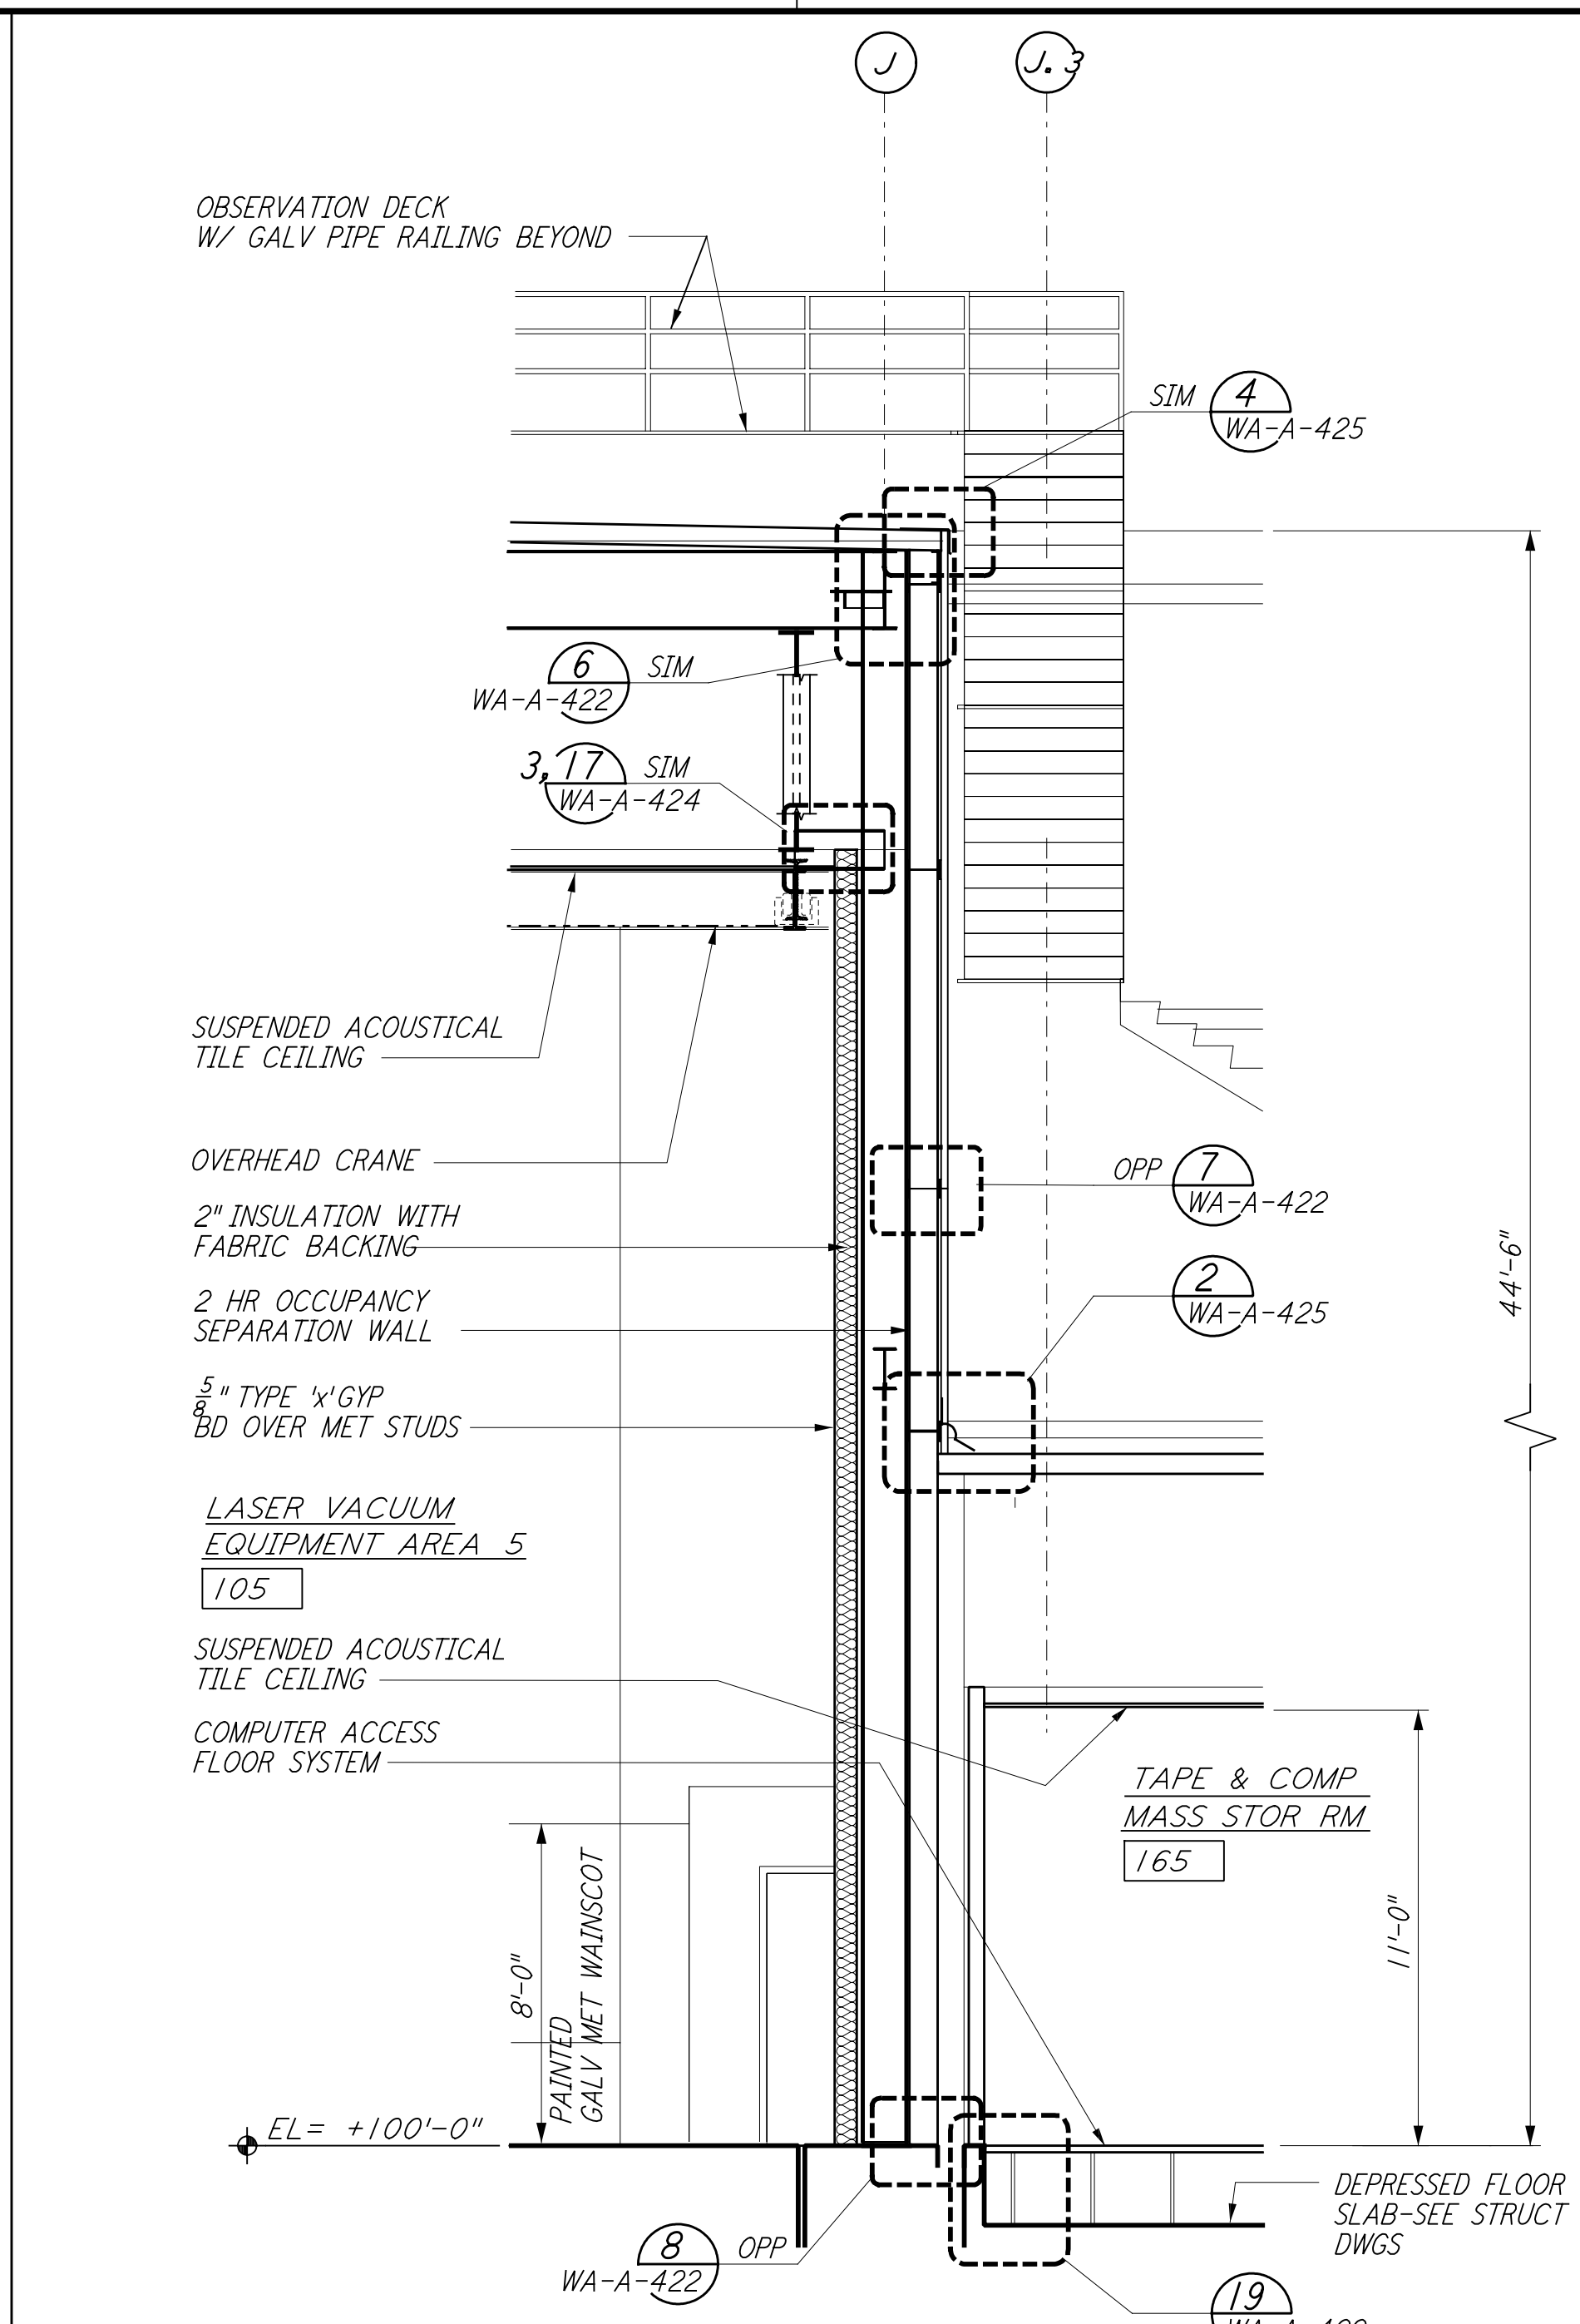


WALL SECTION E
 1/4" = 1'-0"
 REF: WA-A-162 WA-A-552

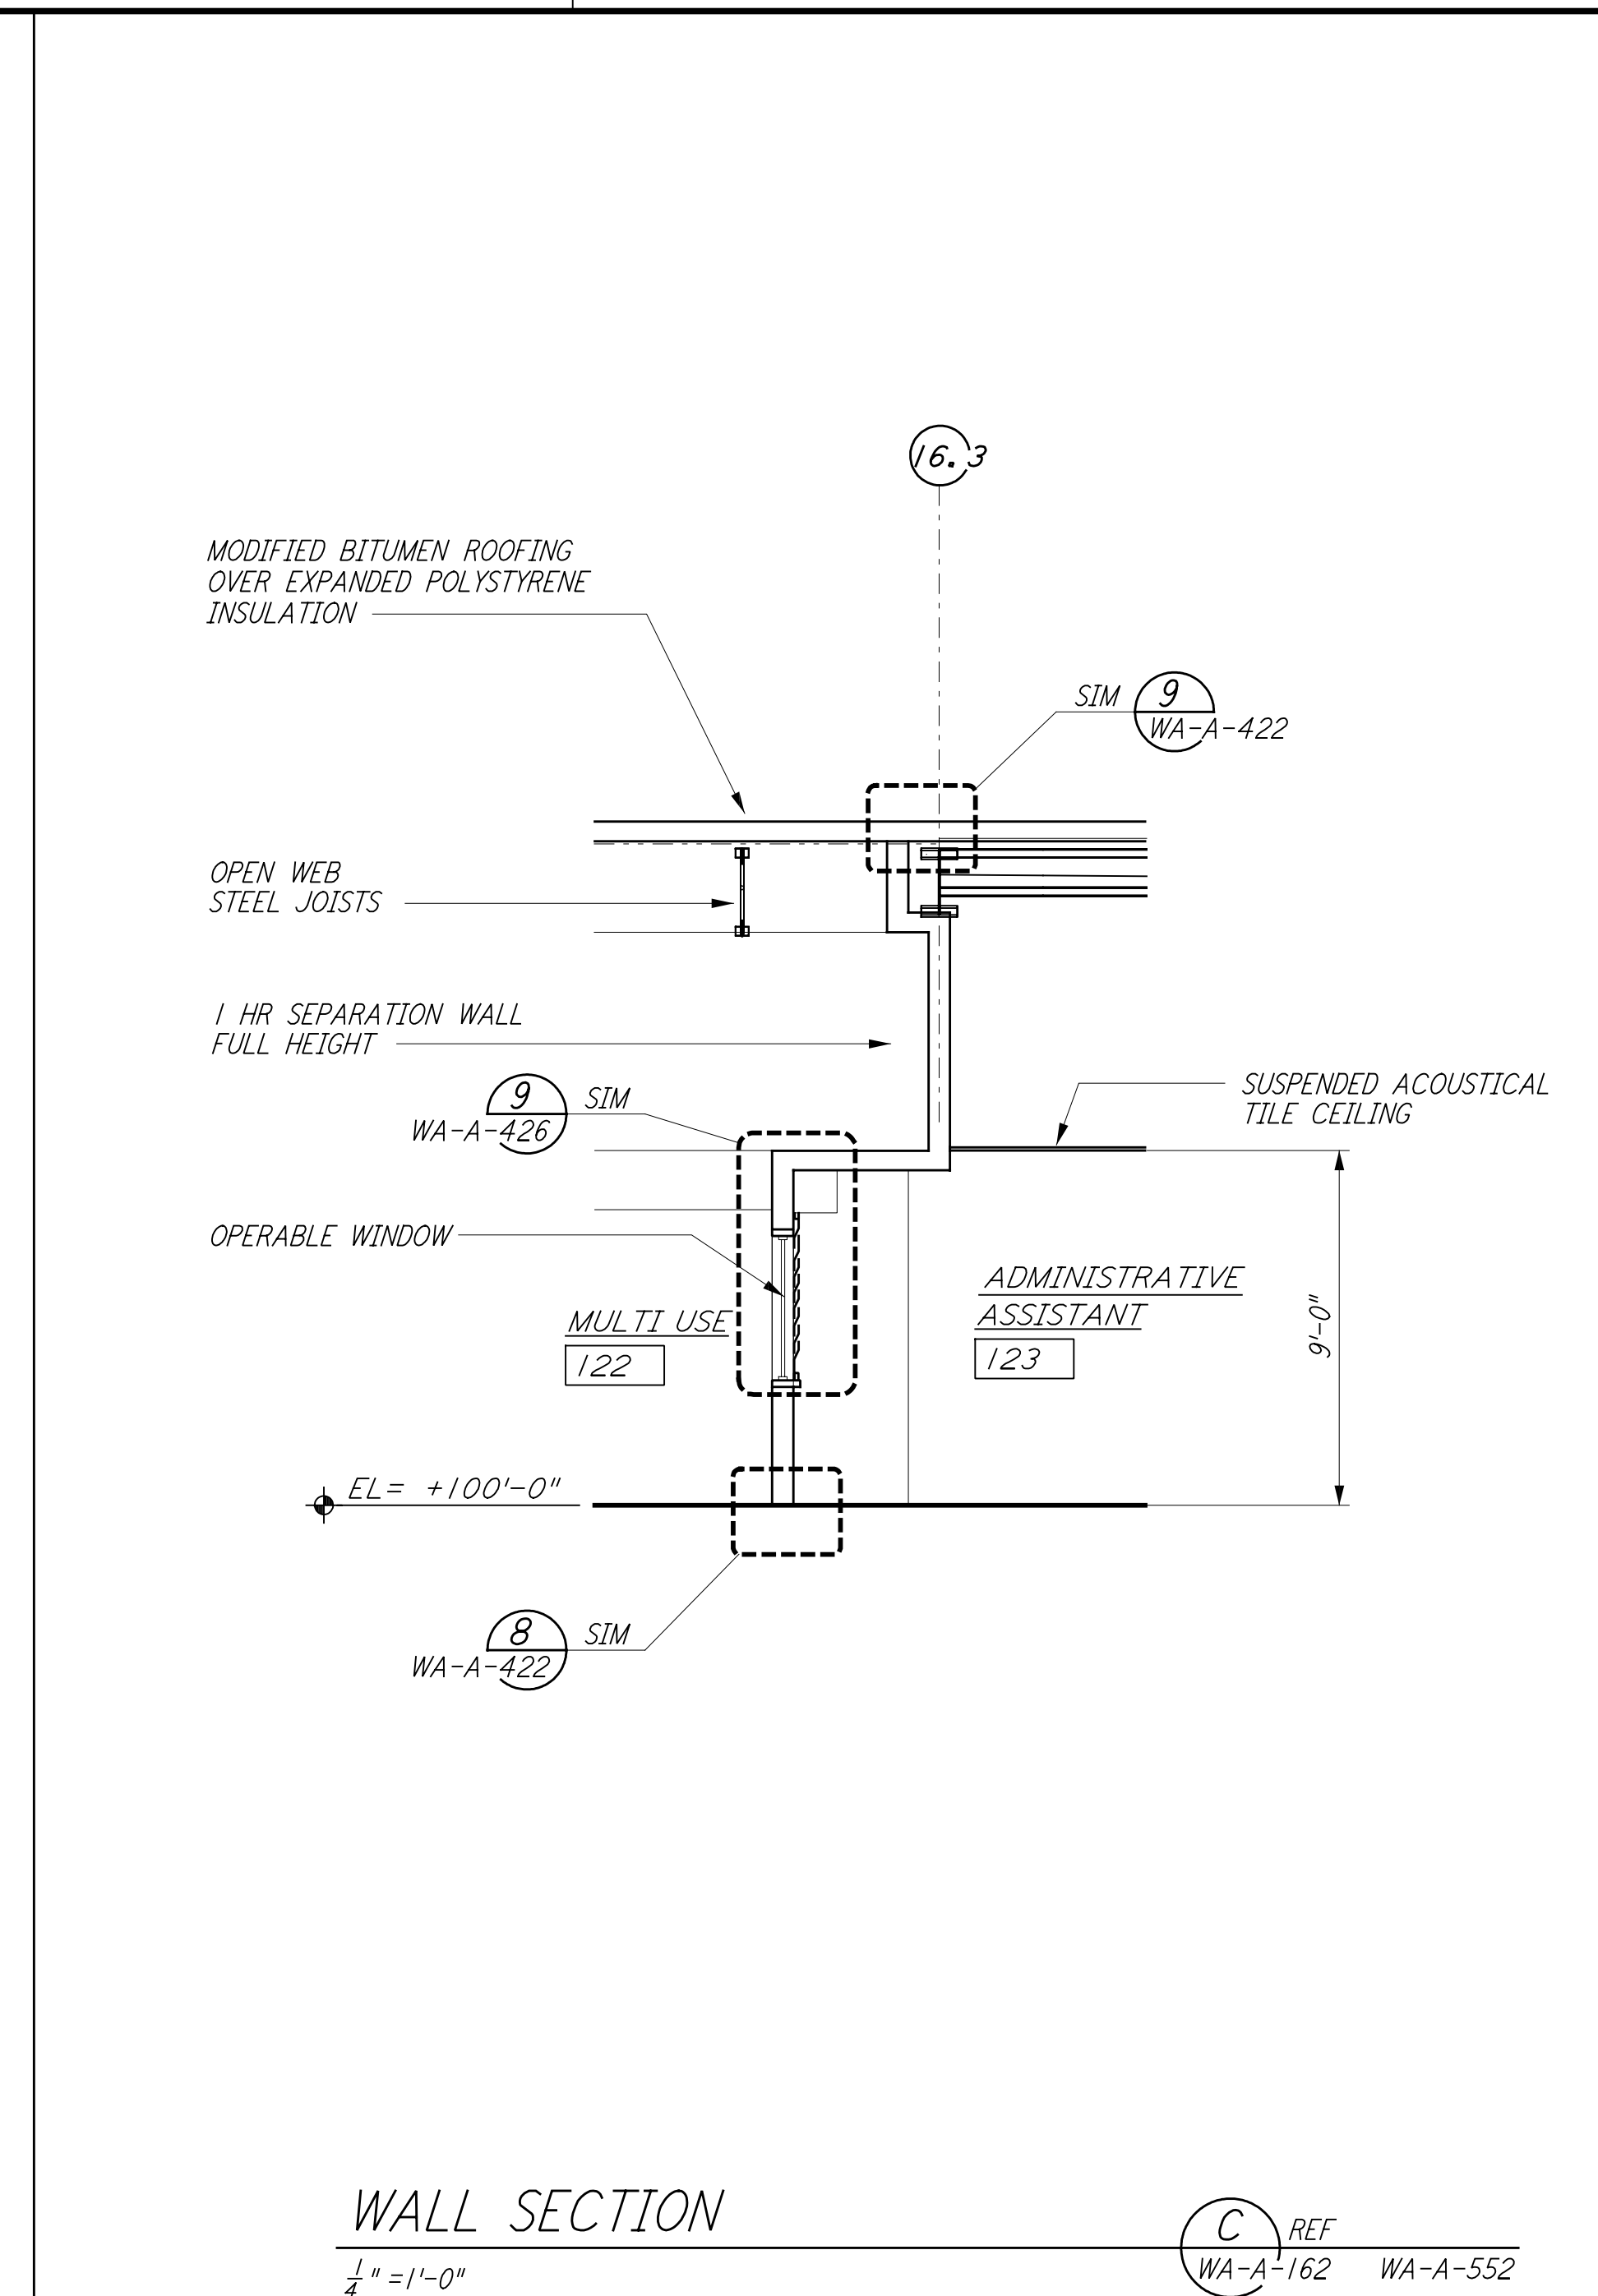


WALL SECTION C
 1/4" = 1'-0"
 REF: WA-A-162 WA-A-552

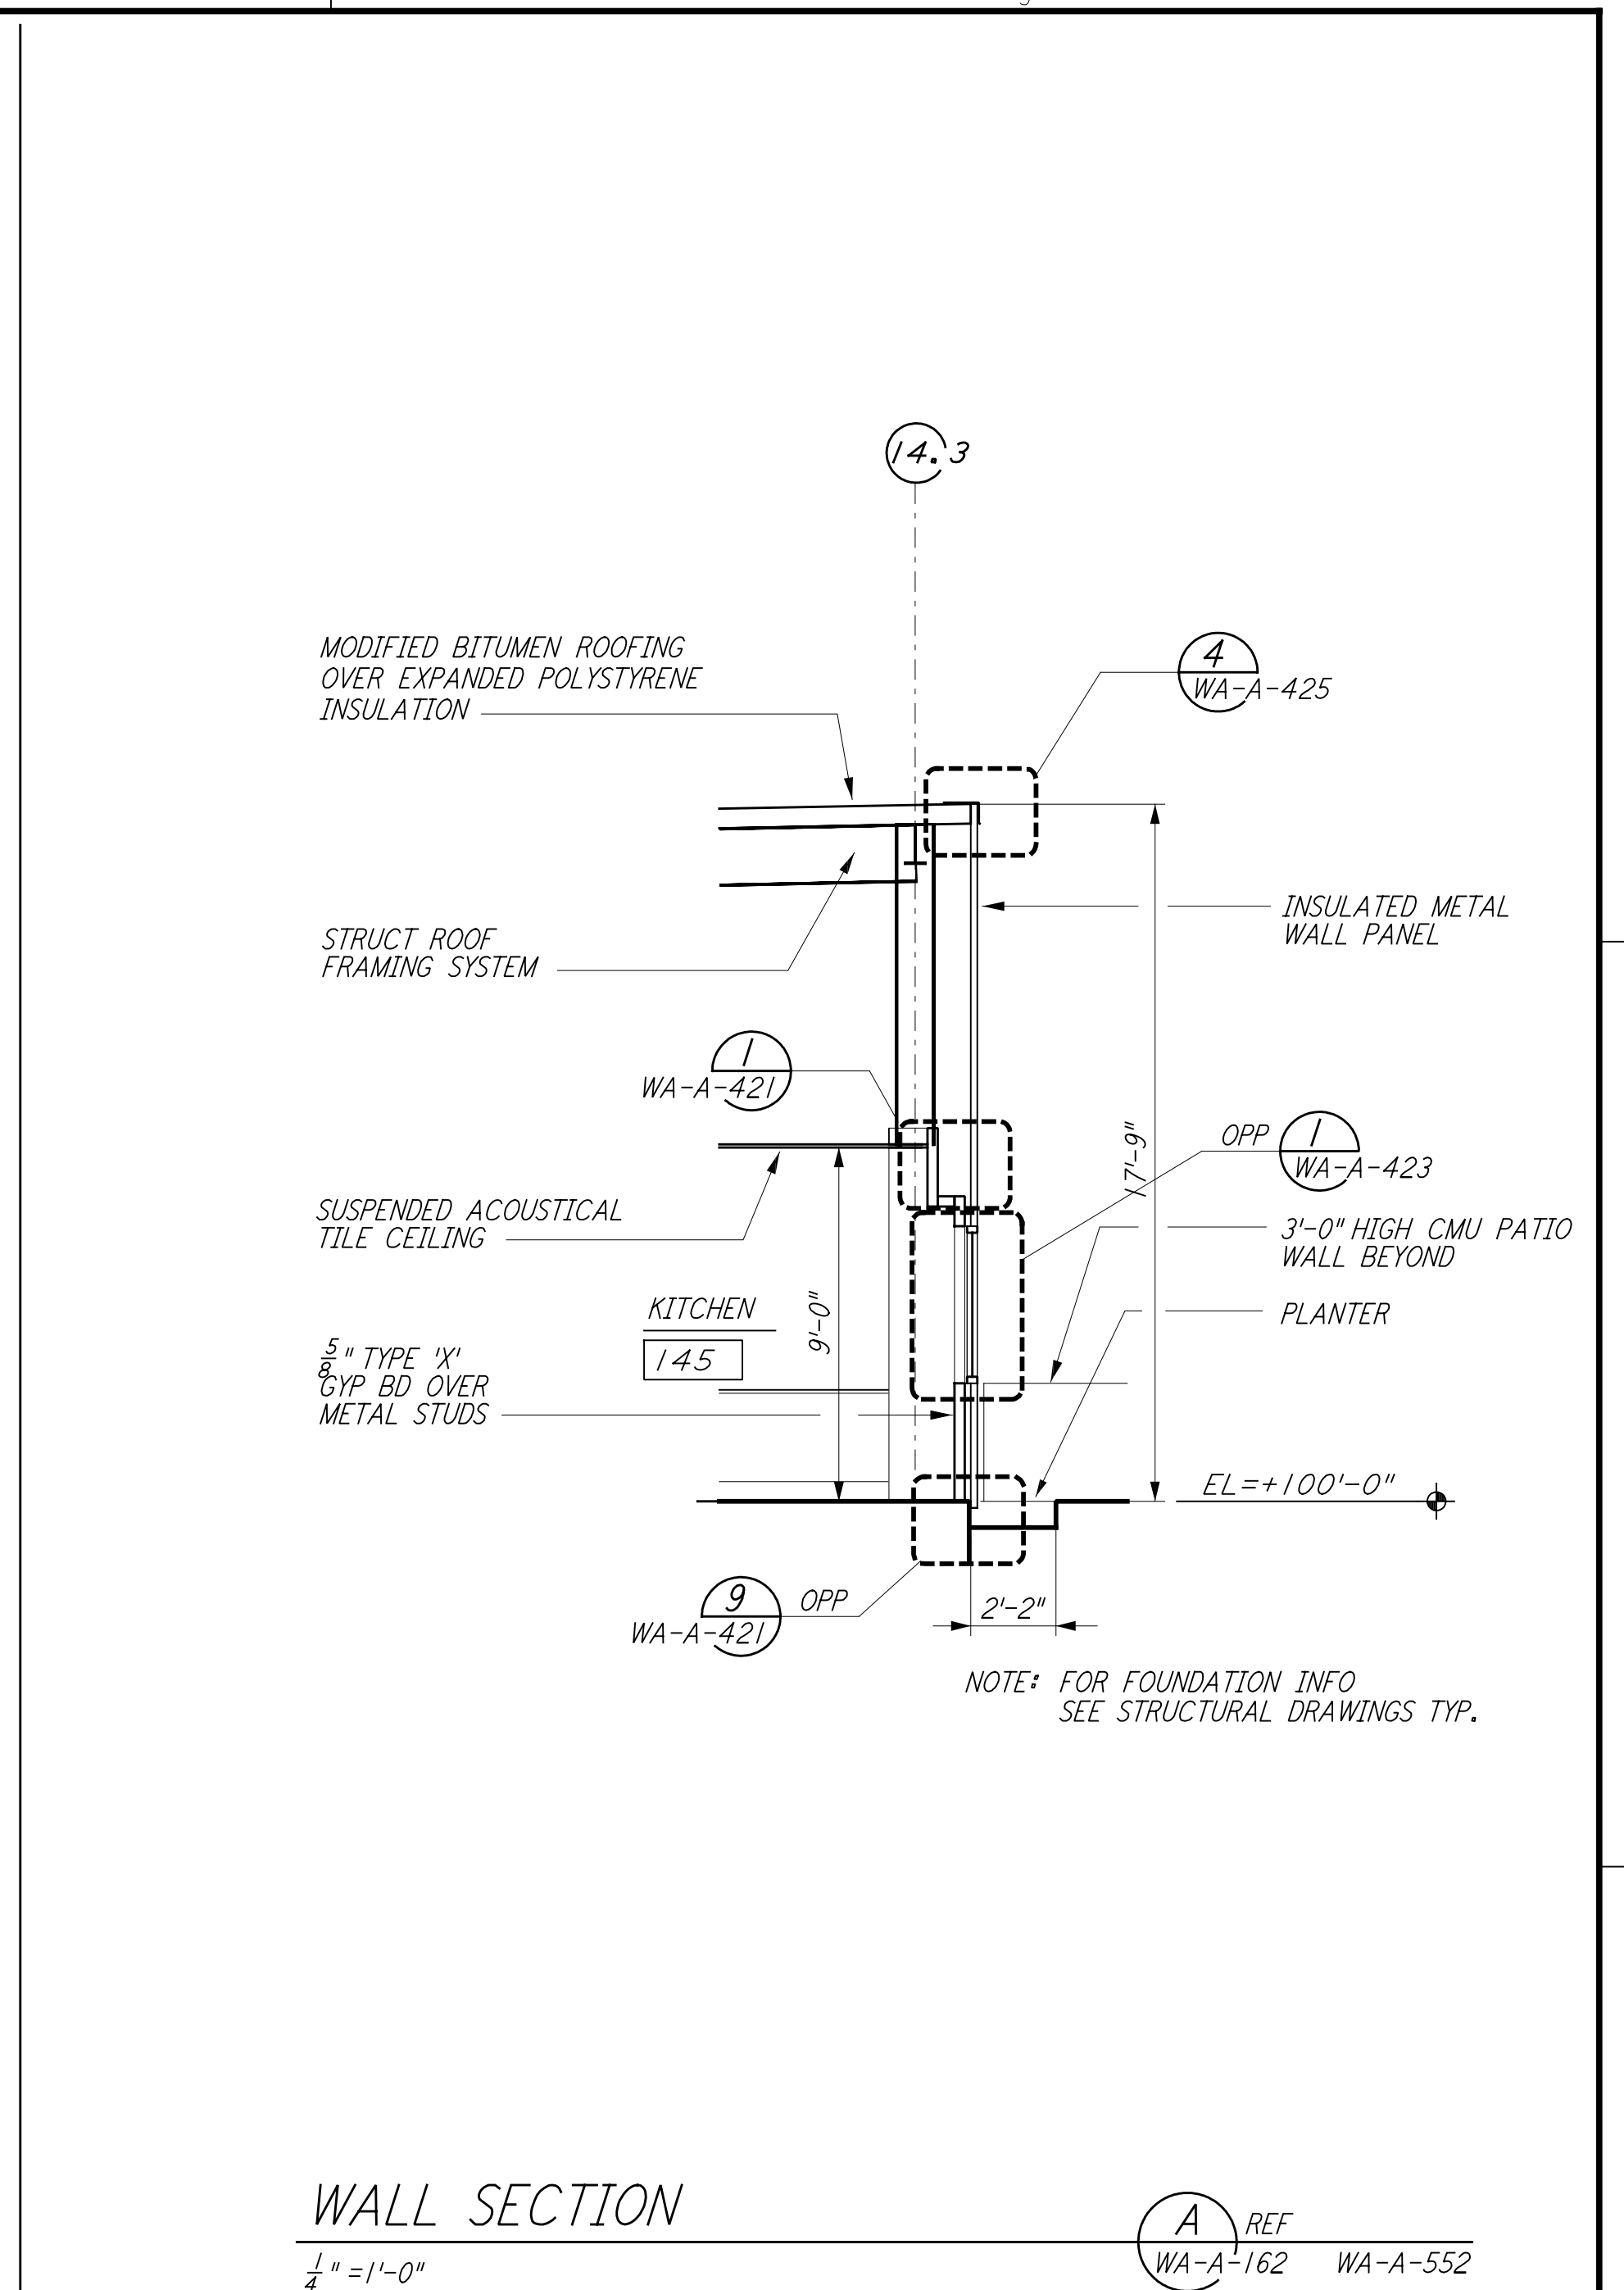


WALL SECTION A
 1/4" = 1'-0"
 REF: WA-A-162 WA-A-552

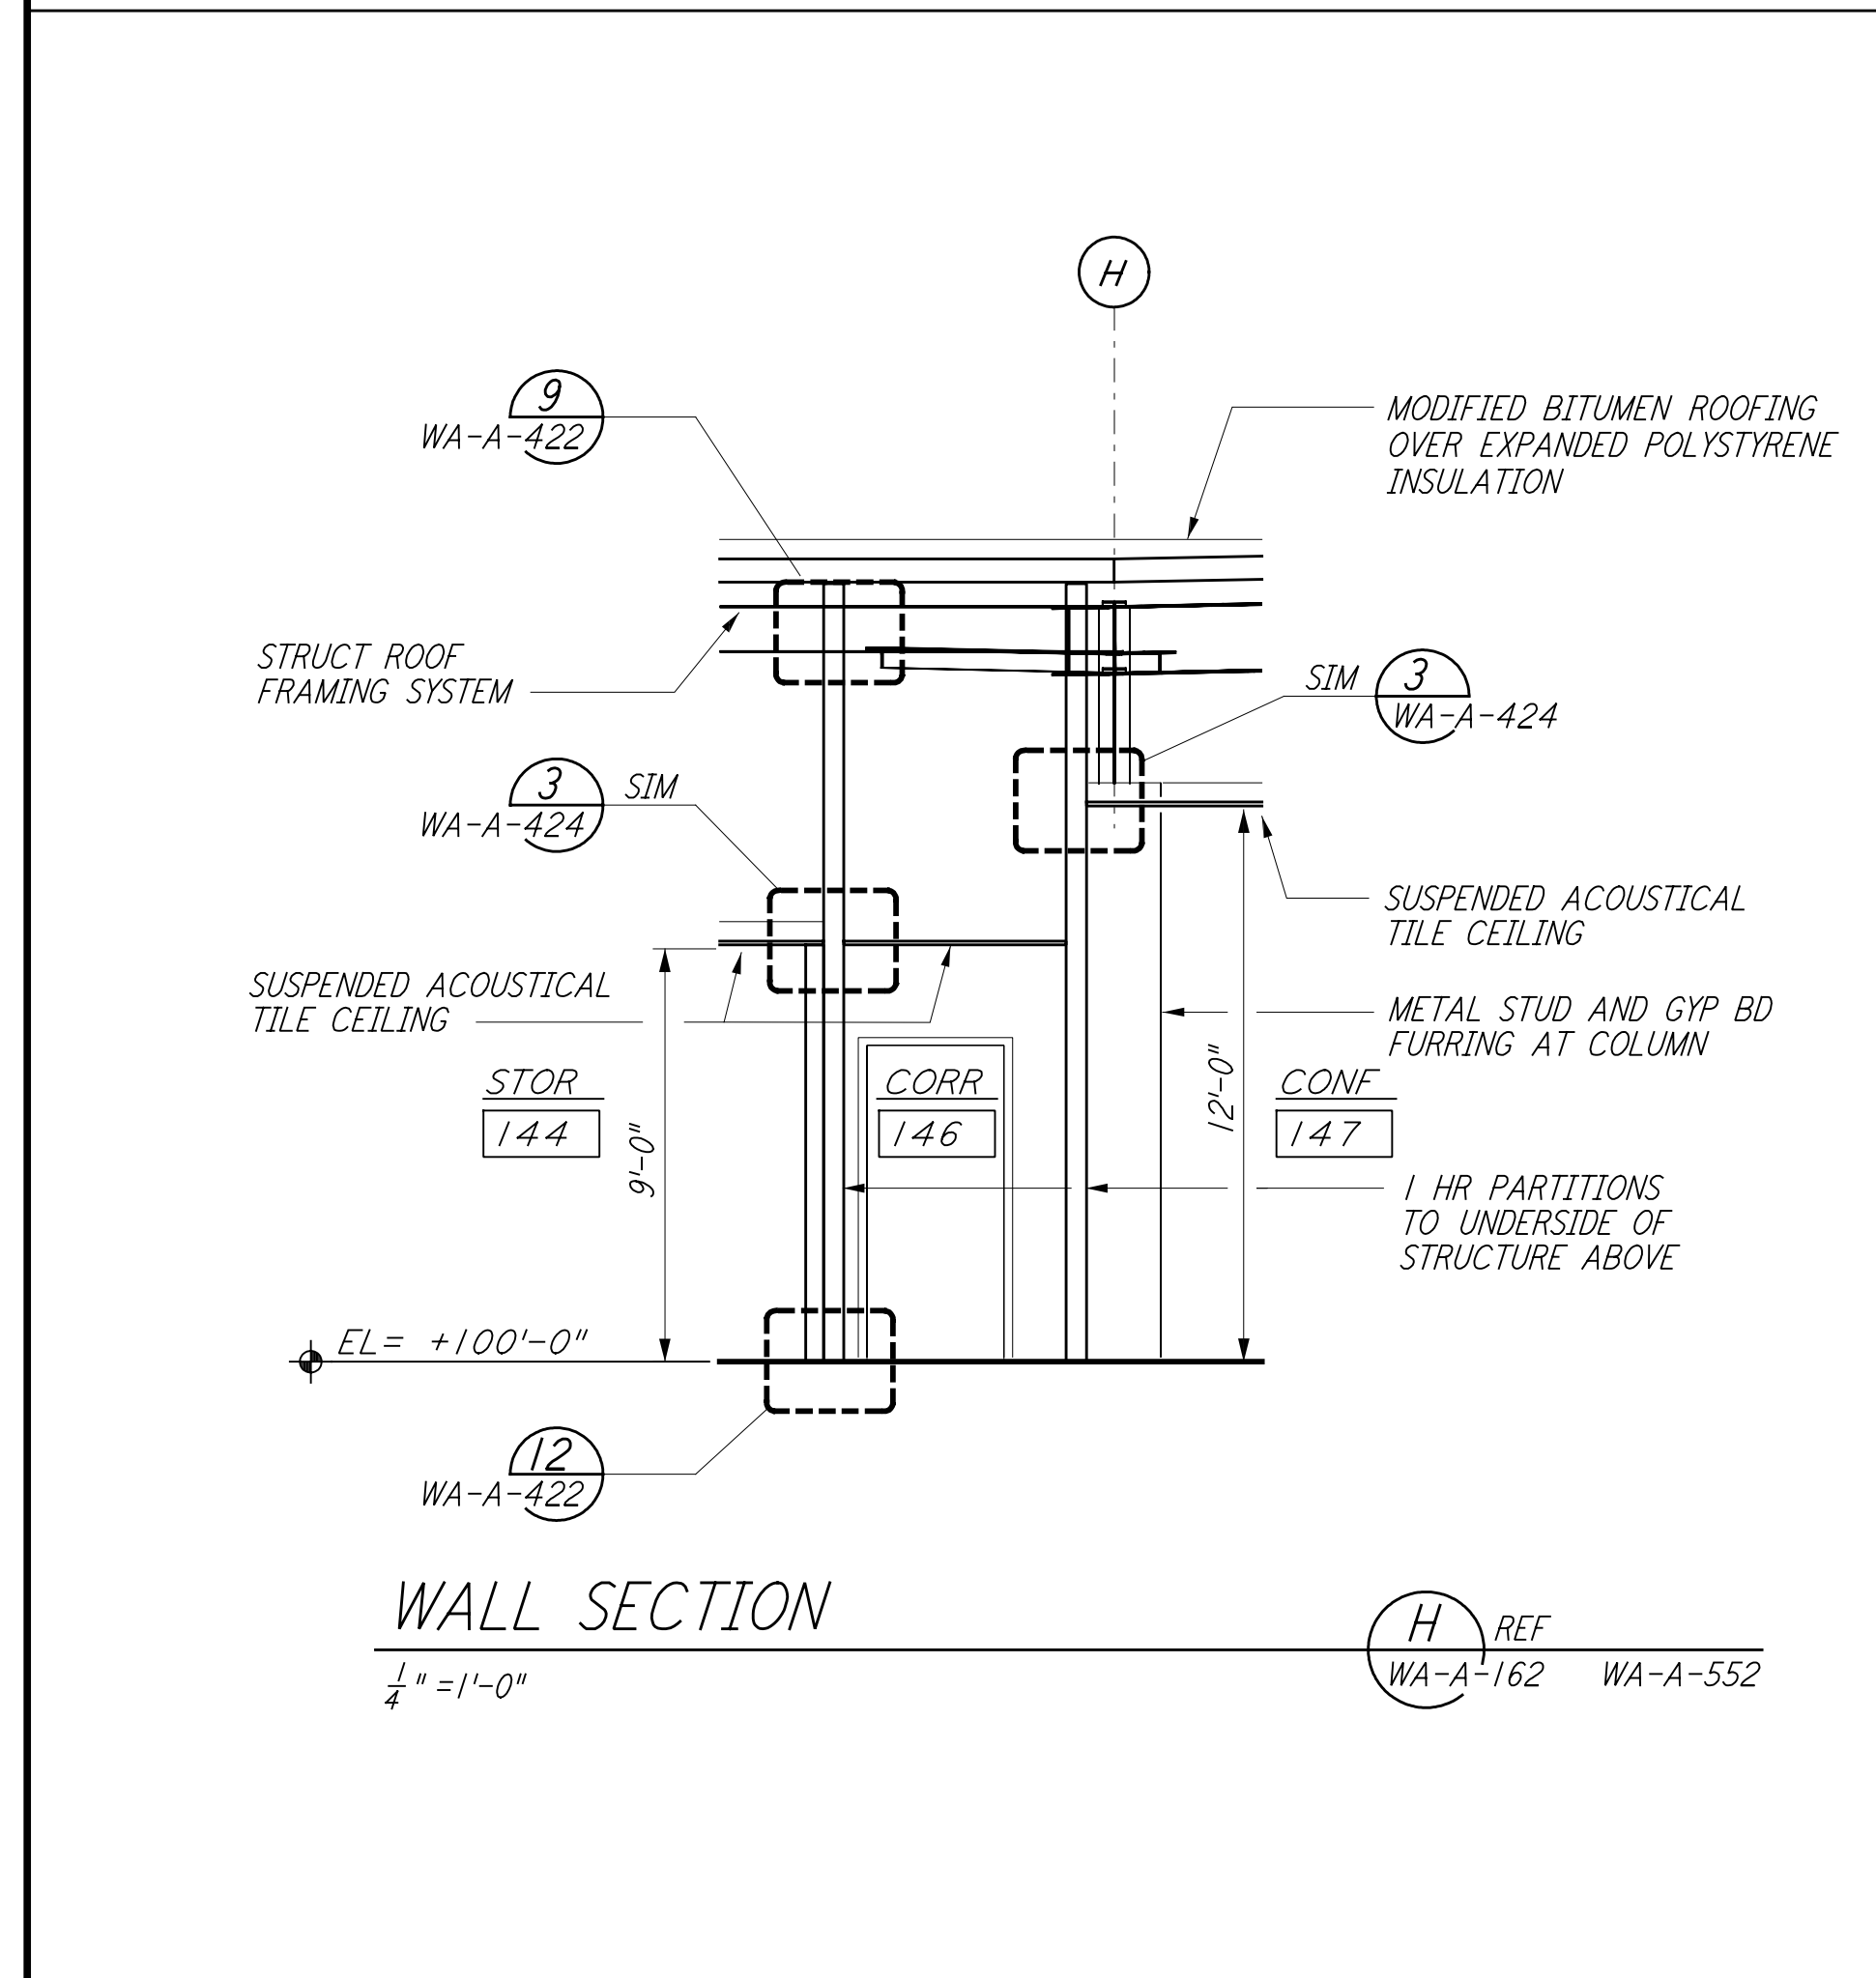


WALL SECTION H
 1/4" = 1'-0"
 REF: WA-A-162 WA-A-552

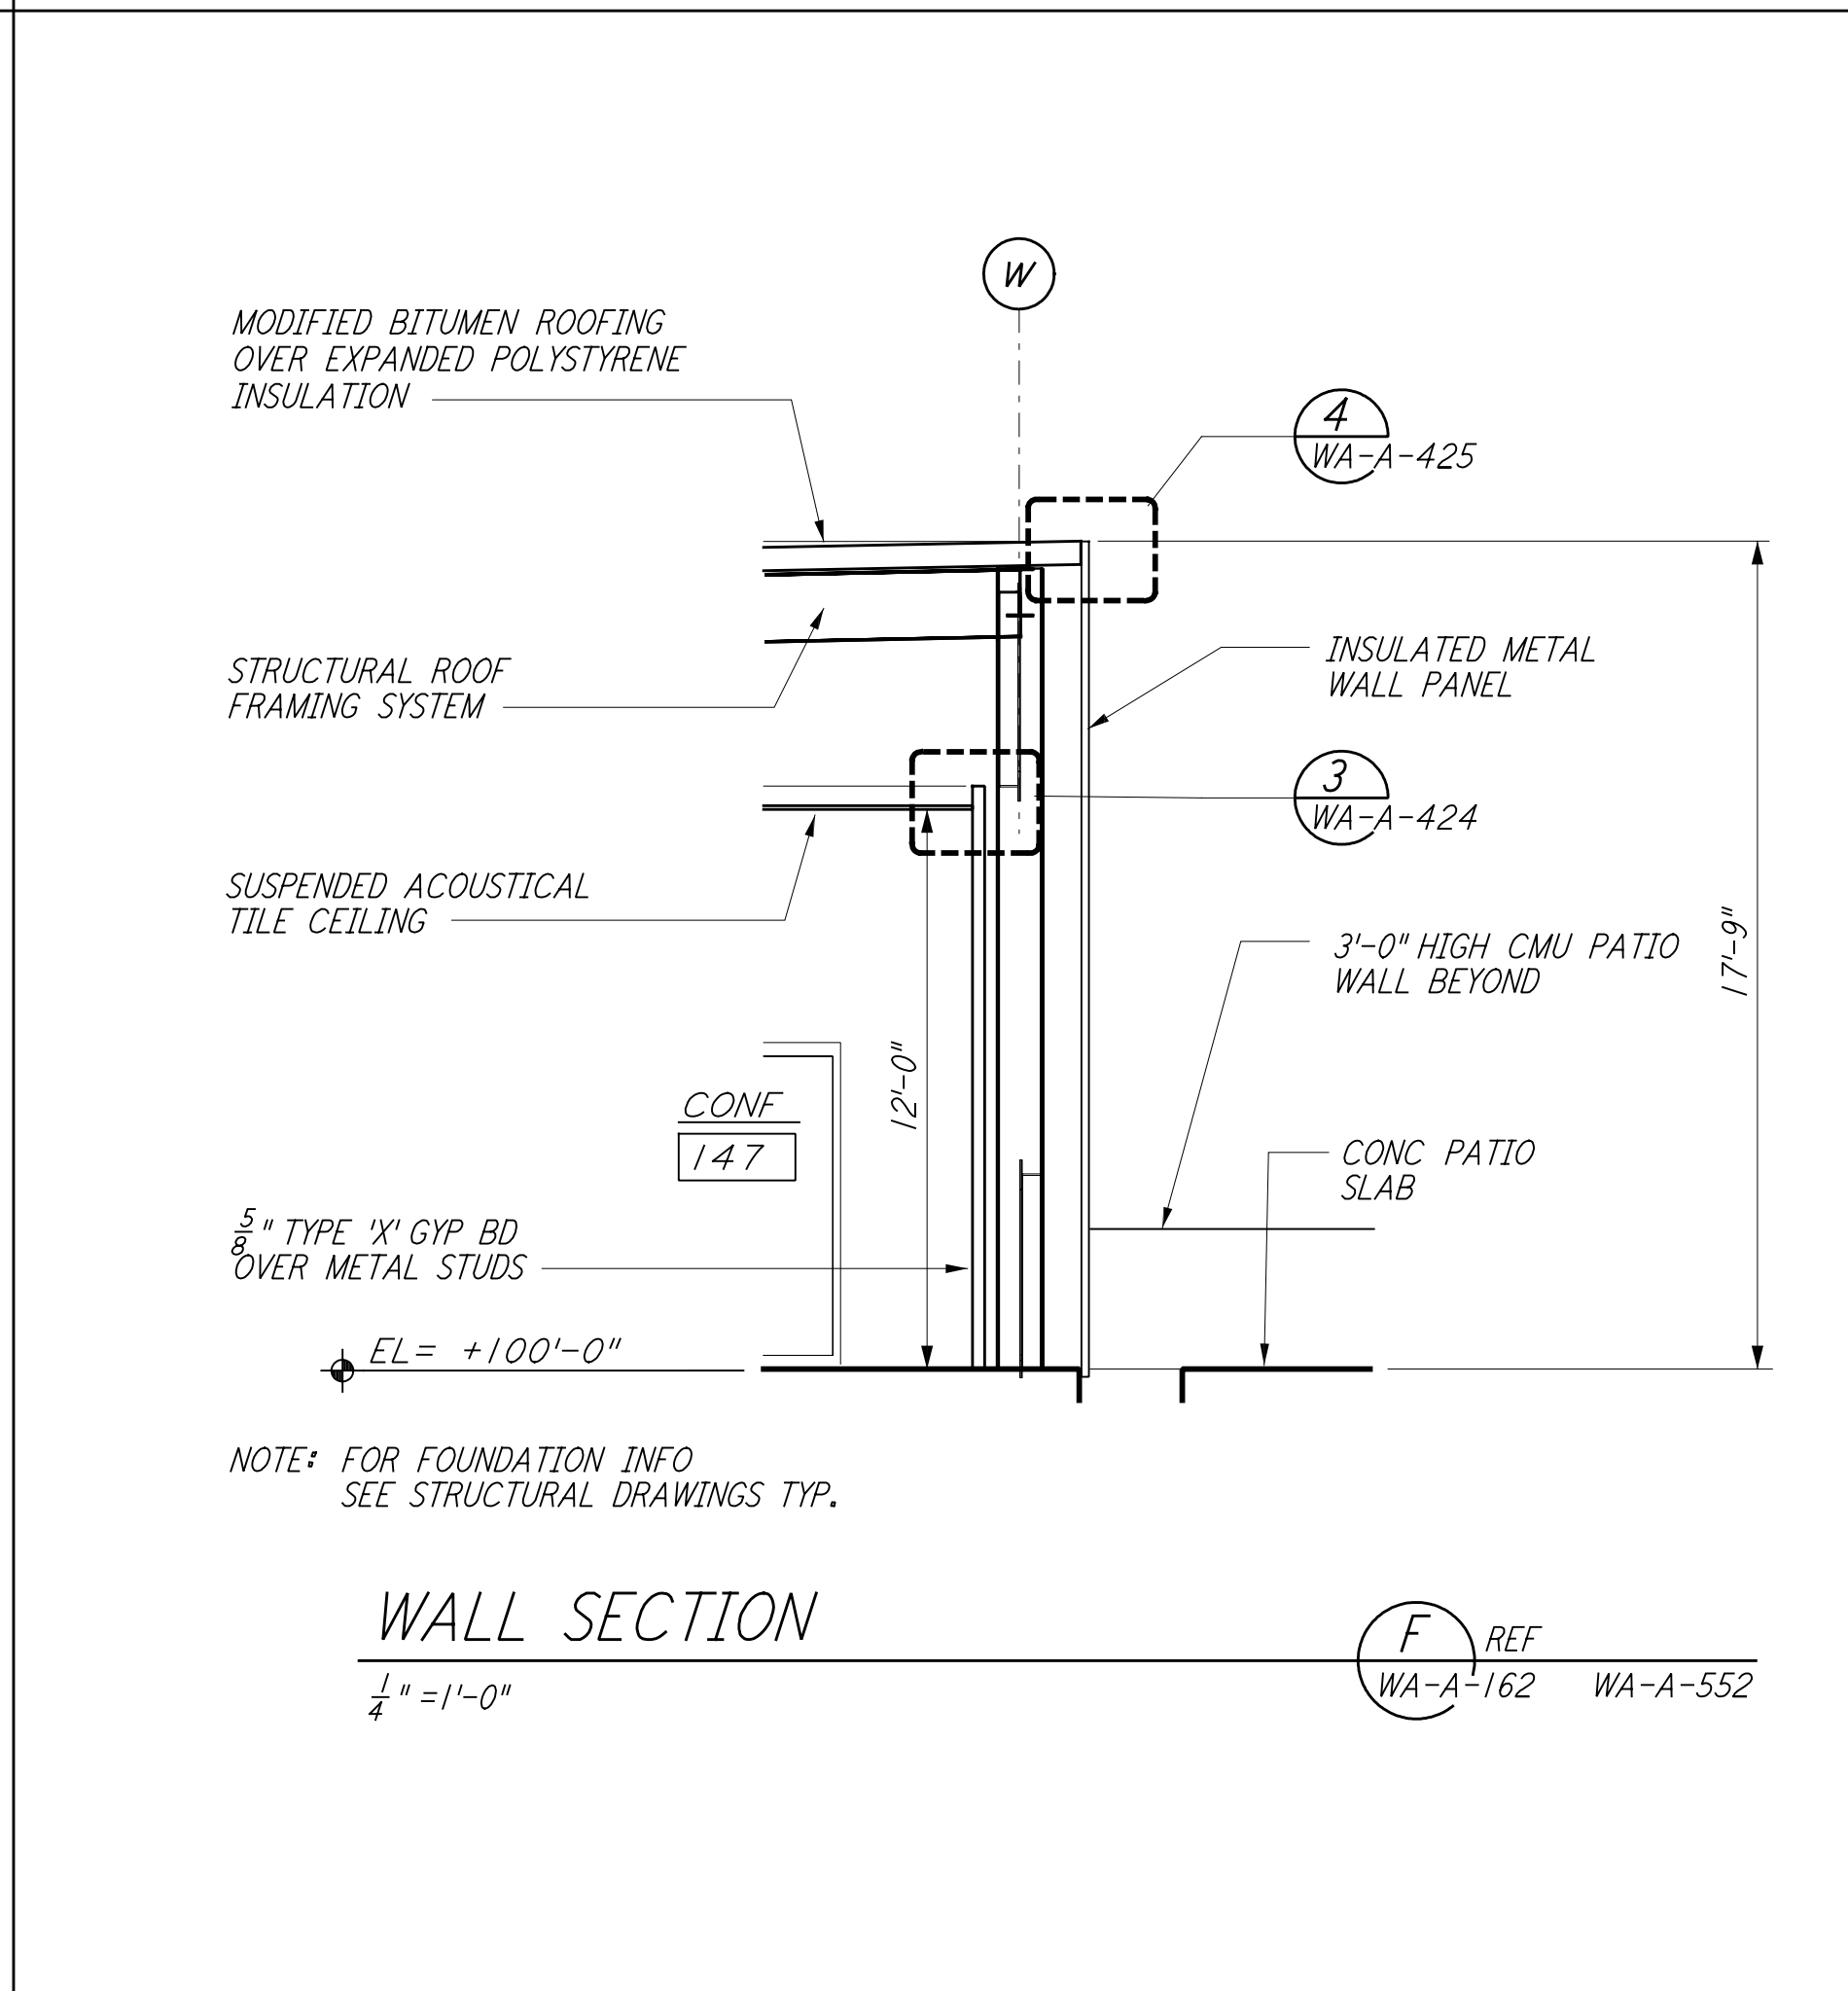

WALL SECTION F
 1/4" = 1'-0"
 REF: WA-A-162 WA-A-552

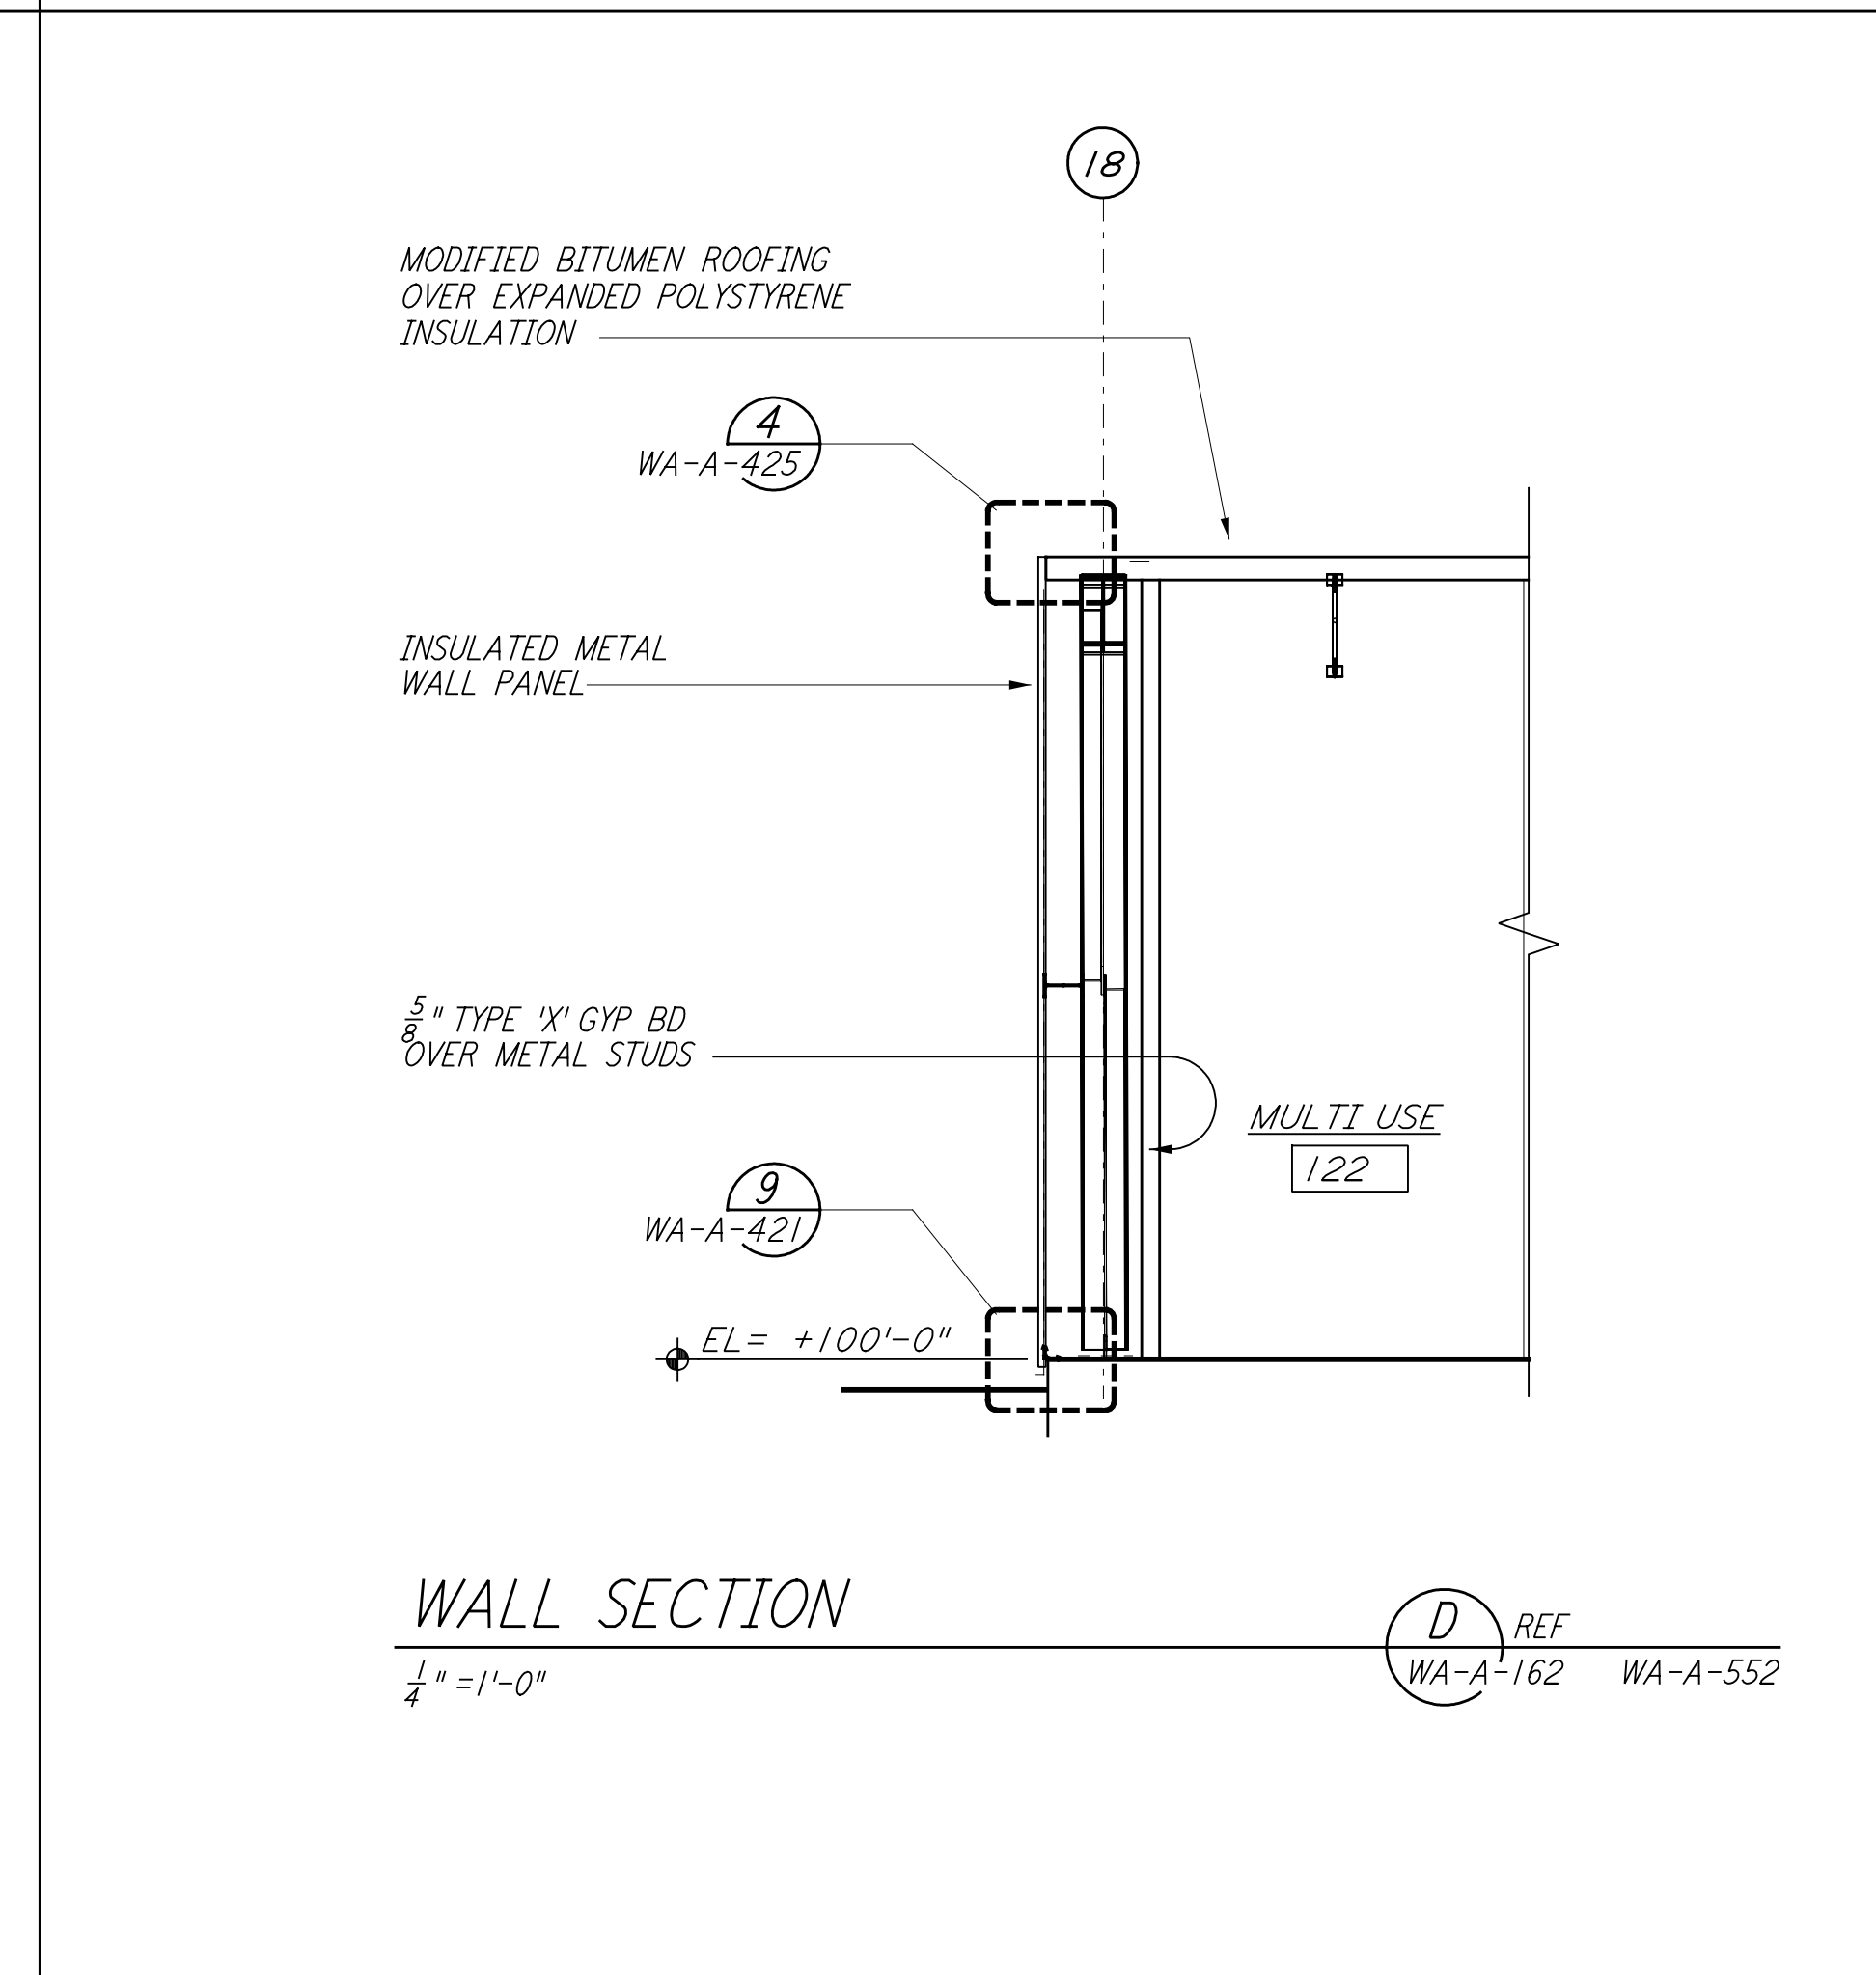

WALL SECTION D
 1/4" = 1'-0"
 REF: WA-A-162 WA-A-552

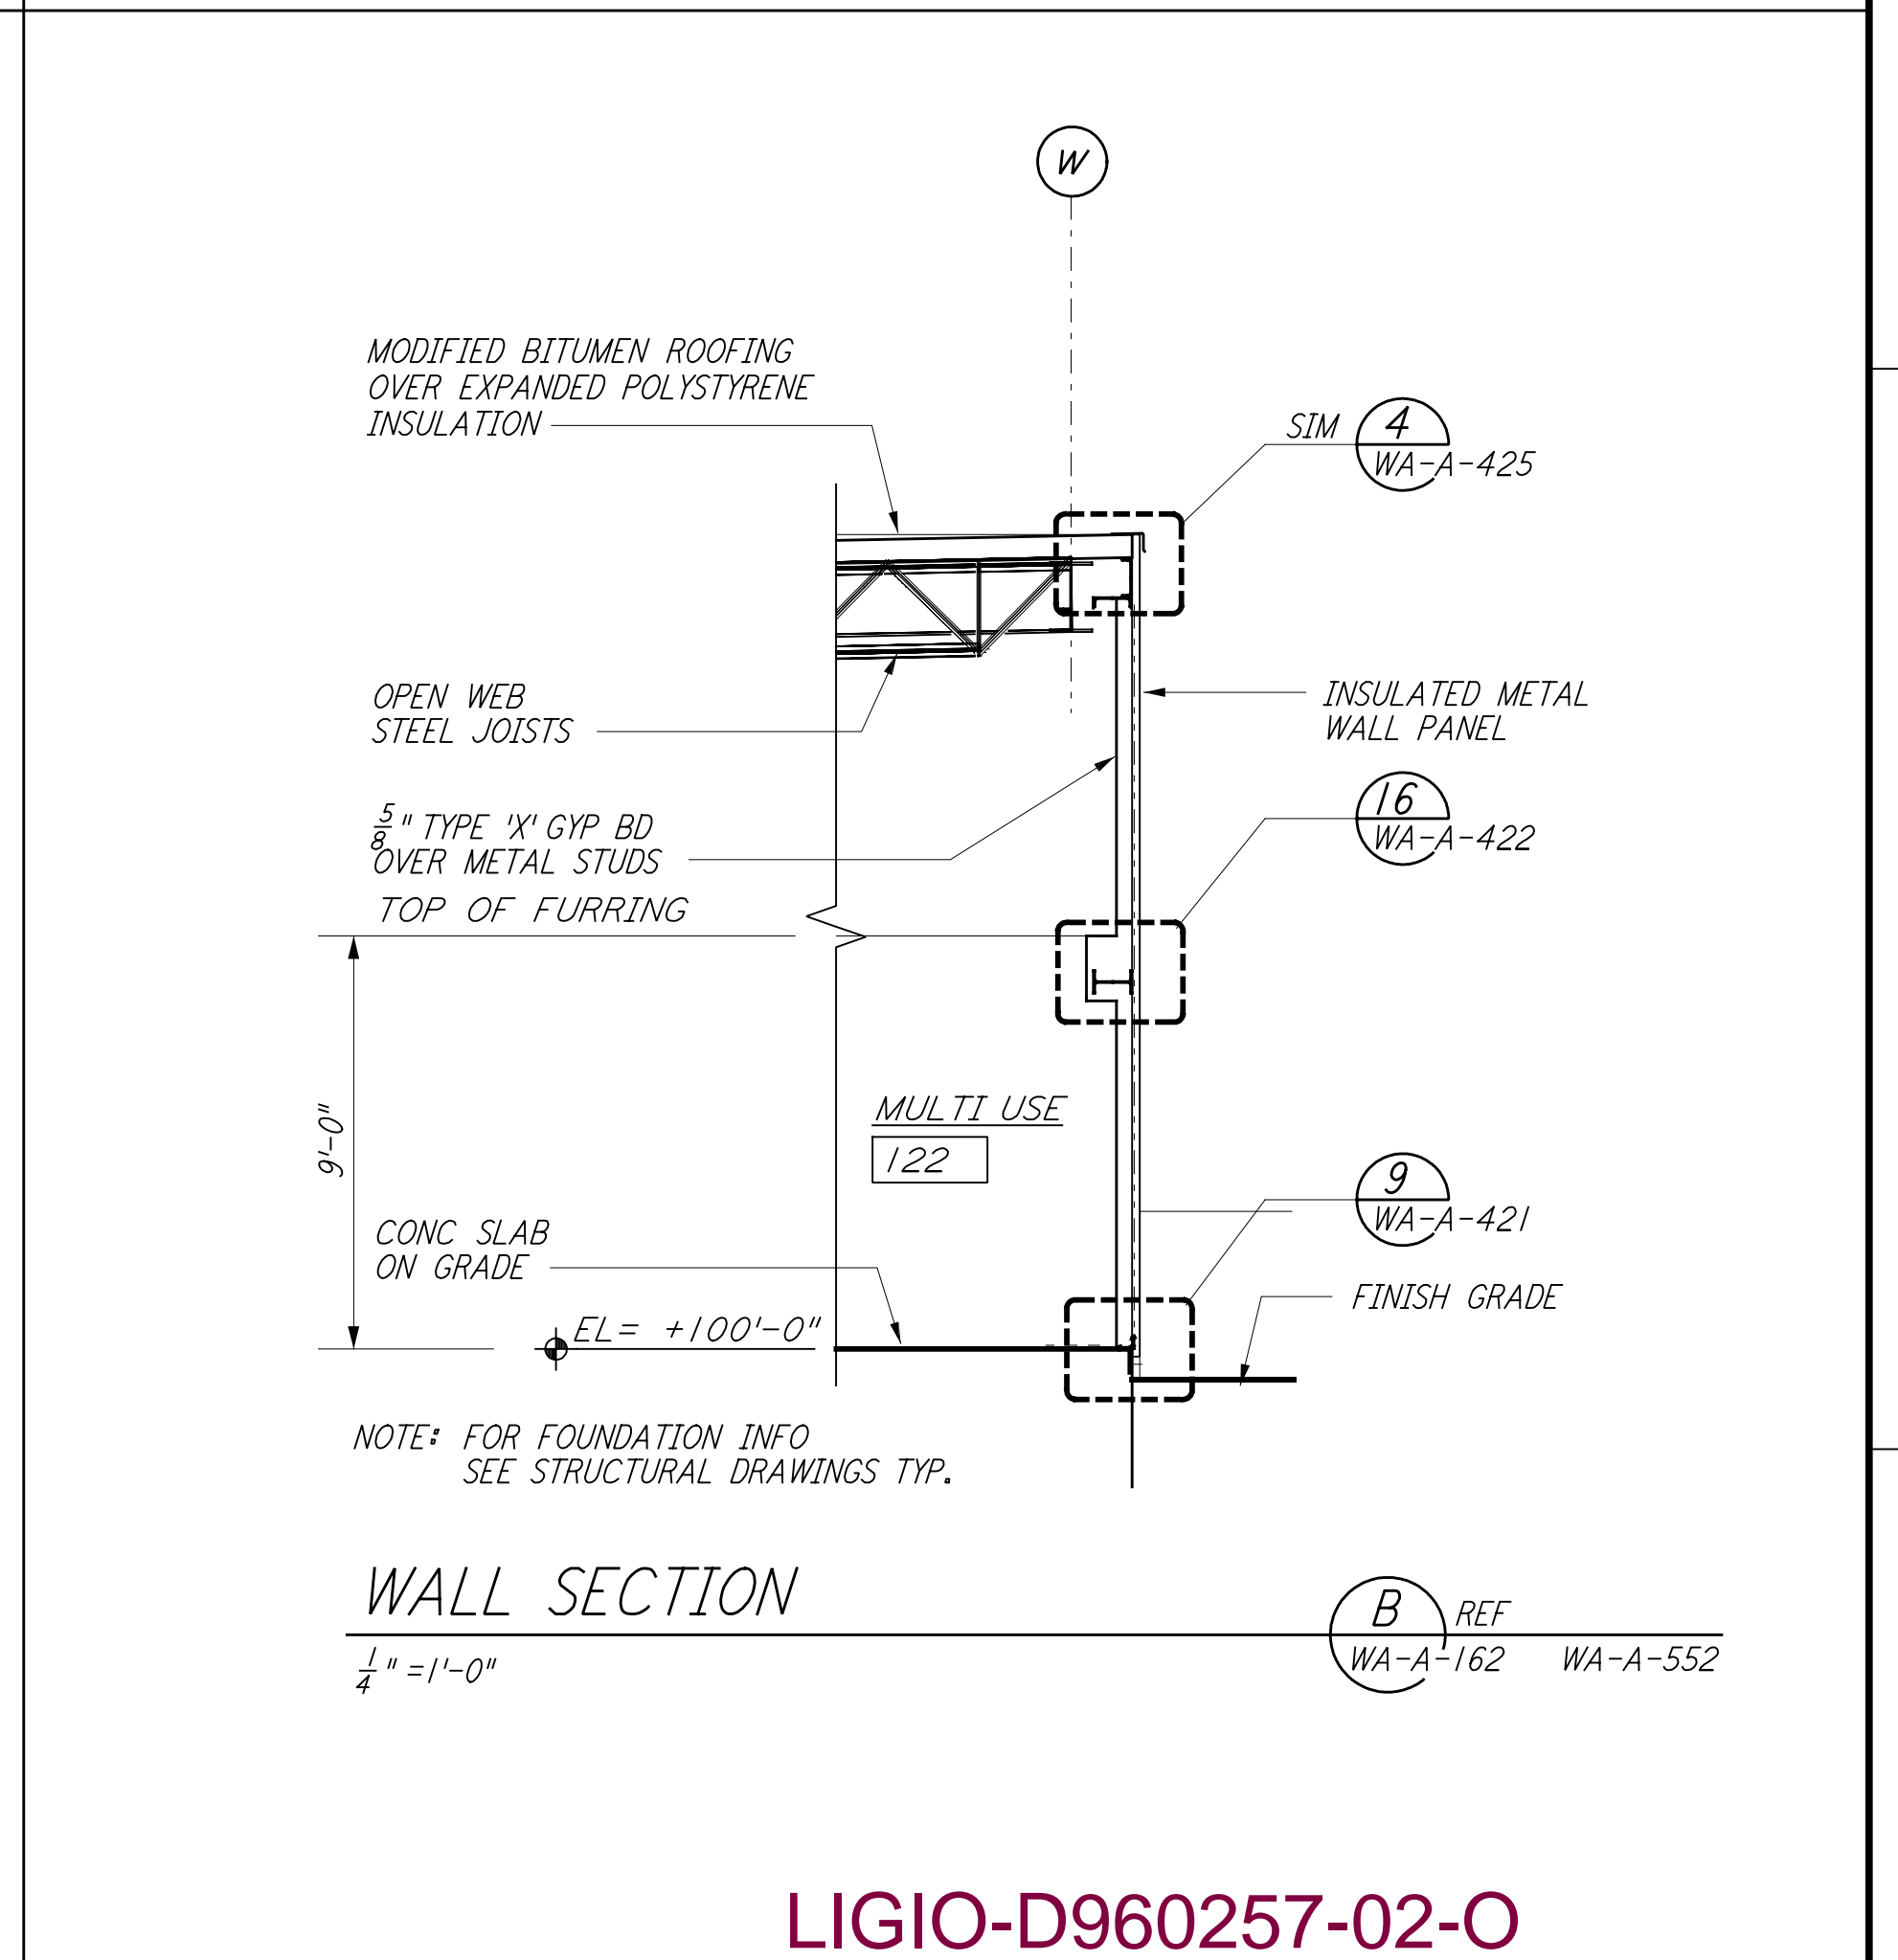

WALL SECTION B
 1/4" = 1'-0"
 REF: WA-A-162 WA-A-552

NO.	DATE	BY	CHKD	ENGR	PROJ	DESCRIPTION
1	2-28-97	CKT	TB	AK	TDM	ISSUED FOR AS-BUILT OSB REVISION
2	5-15-98	CKT	TB	AK	TDM	ISSUED FOR AS-BUILT OSB REVISION

NO.	DATE	BY	CHKD	ENGR	PROJ	DESCRIPTION
1	5-12-96	CKT	TB	AK	TDM	ISSUED FOR CONSTRUCTION
2	5-26-96	TB	TB	AK	TDM	CHECKED
3	7-12-96	bkk	TB	AK	TDM	ENGINEER
4	7-12-96	MDW	TB	AK	TDM	PROJ

AS-BUILT DRAWINGS

PARSONS
 100 WEST WALNUT STREET
 PASADENA, CALIFORNIA

LIGO
 CALIFORNIA INSTITUTE OF TECHNOLOGY
 MASSACHUSETTS INSTITUTE OF TECHNOLOGY

LIGIO-D960257-02-O

LASER INTERFEROMETER
 GRAVITATIONAL-WAVE OBSERVATORY
 SITE NO. 1 - HANFORD, WASHINGTON

ARCHITECTURAL
 CORNER STATION
 WALL SECTIONS
 SHEET 2

SCALE: AS NOTED
 SHEET NUMBER: PP150969
 PROJECT NUMBER: 8094

WA-A-162

Note 1, Linda L Turner, 04/14/99 08:37:27 AM
LIGIO-D960257-02-O