

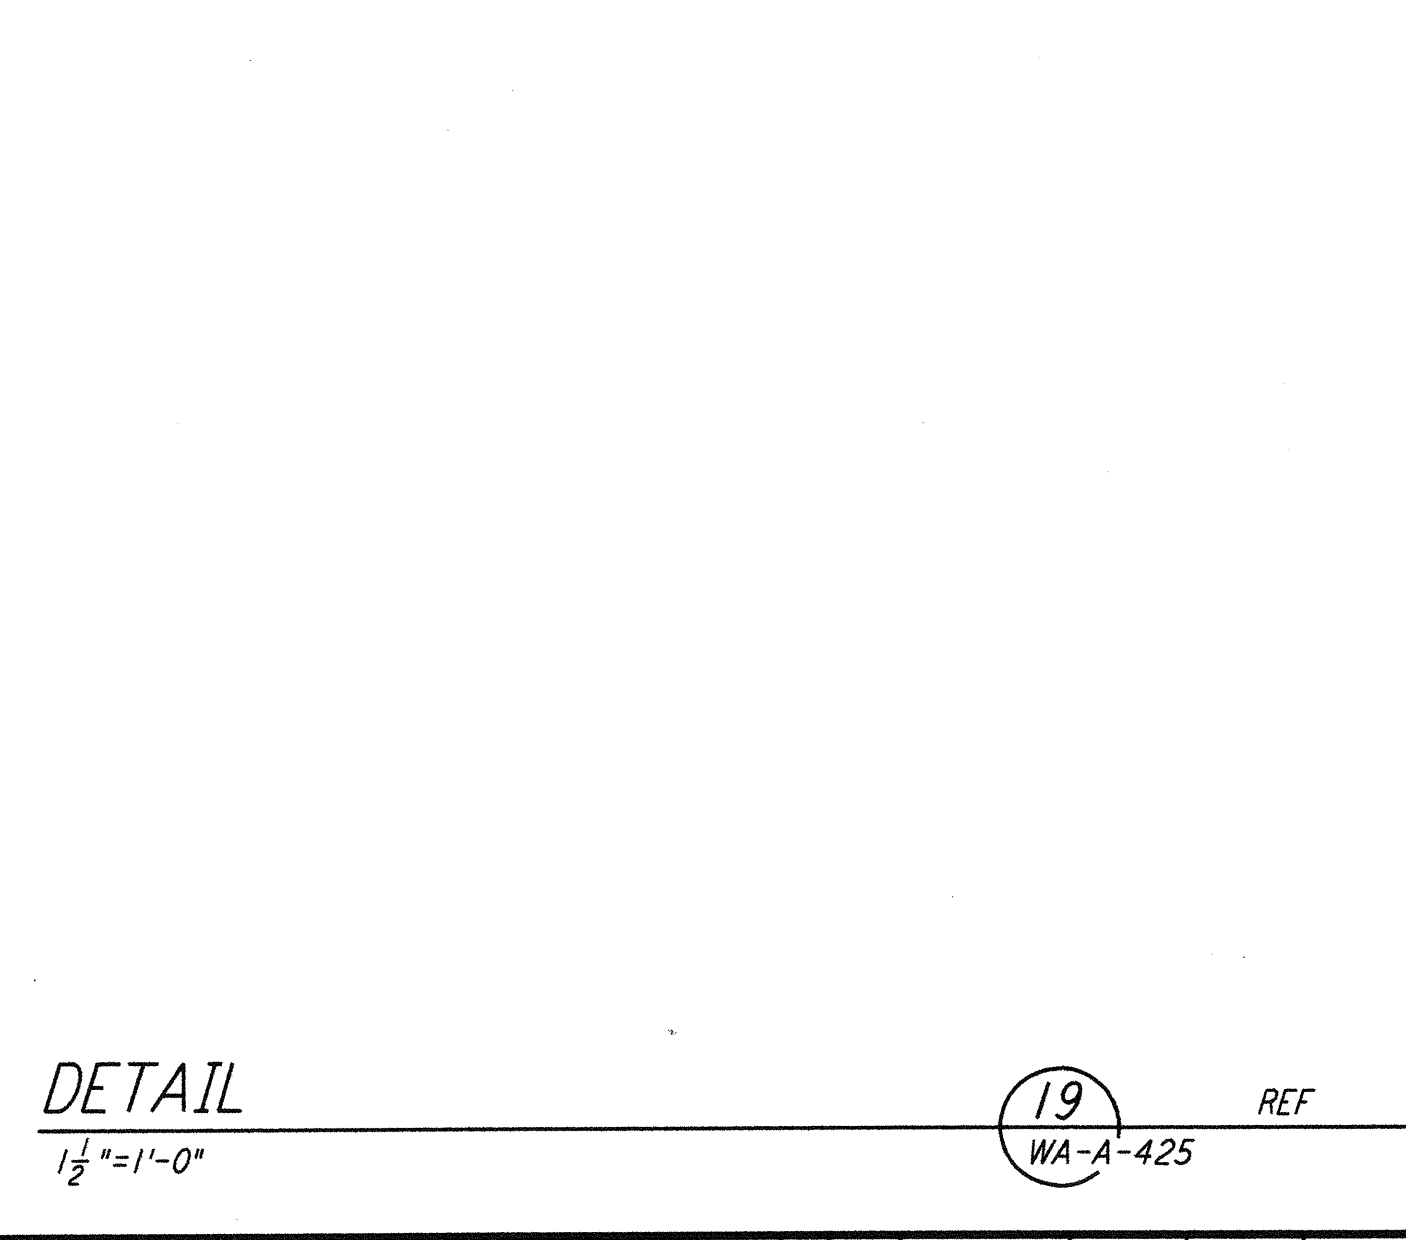
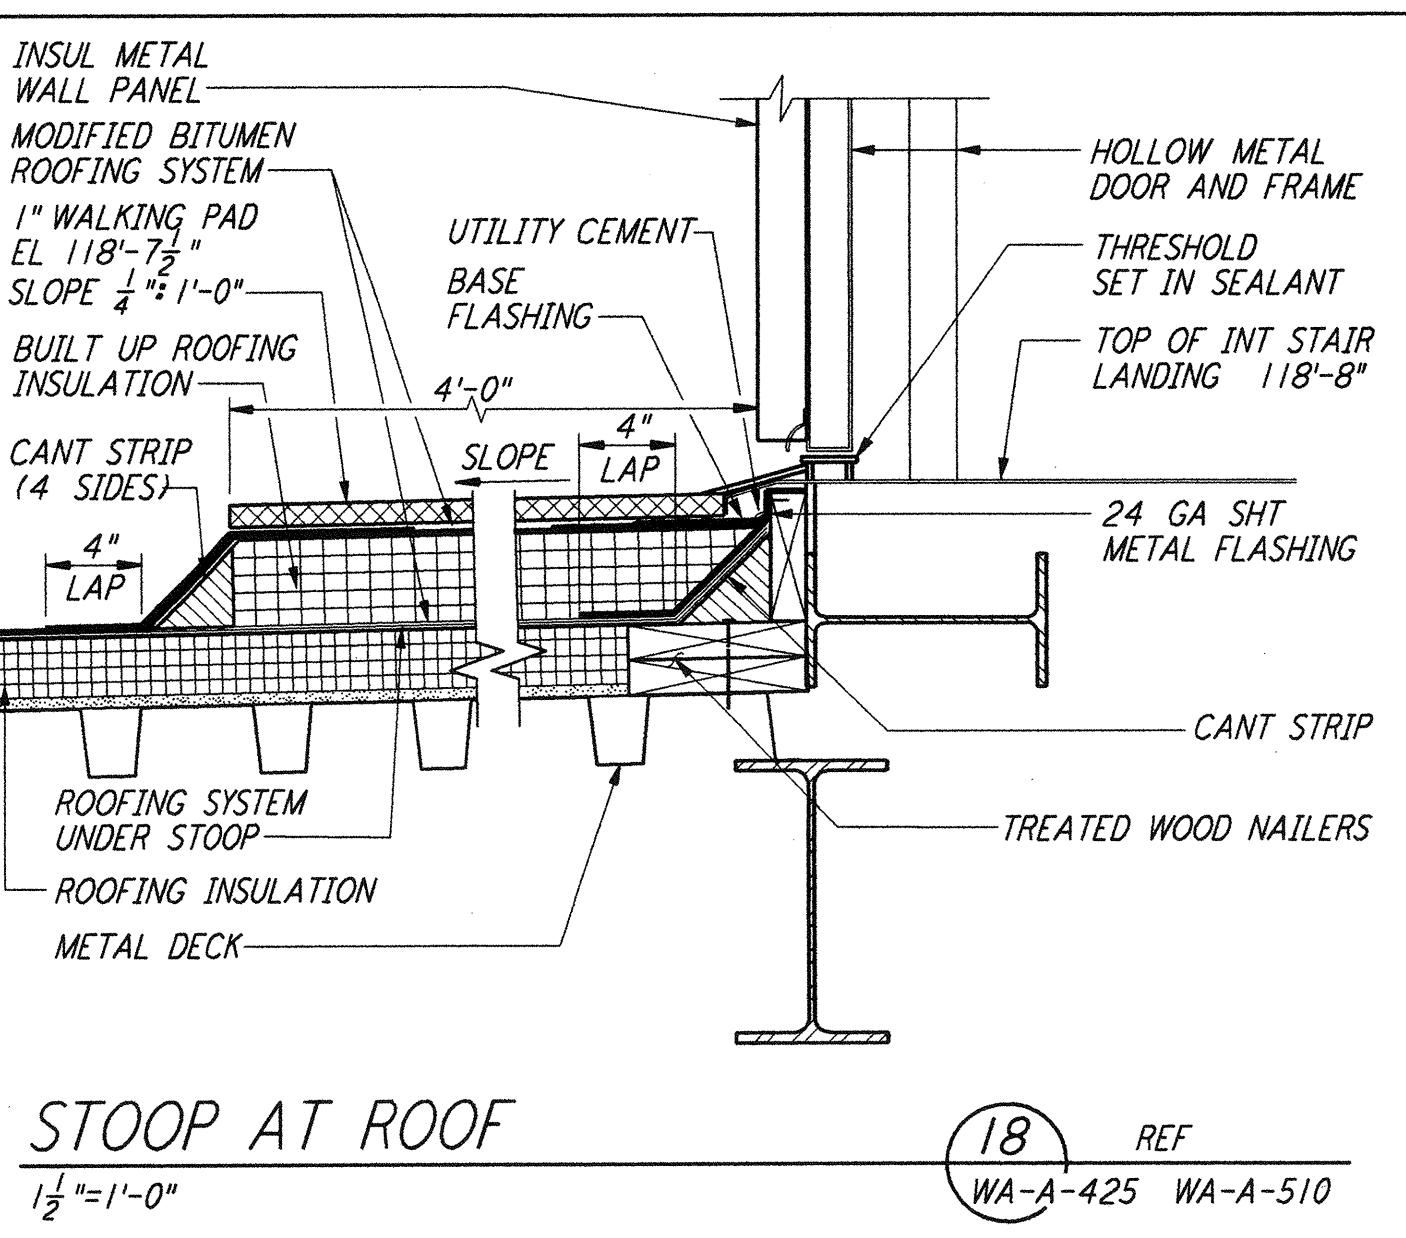
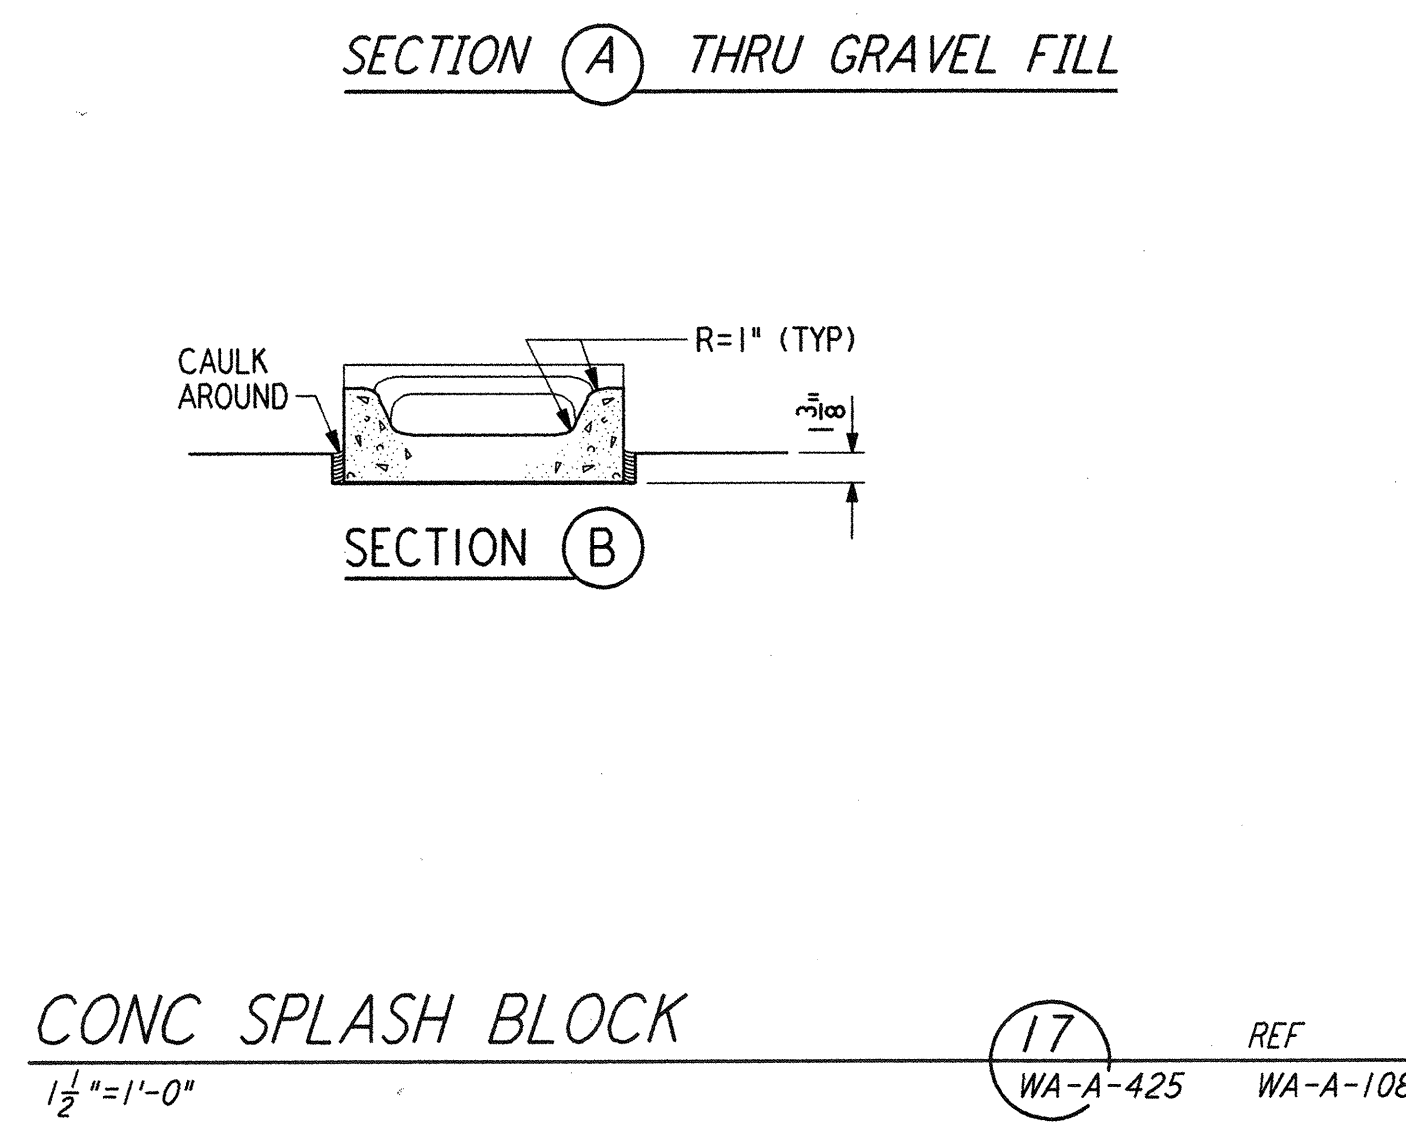
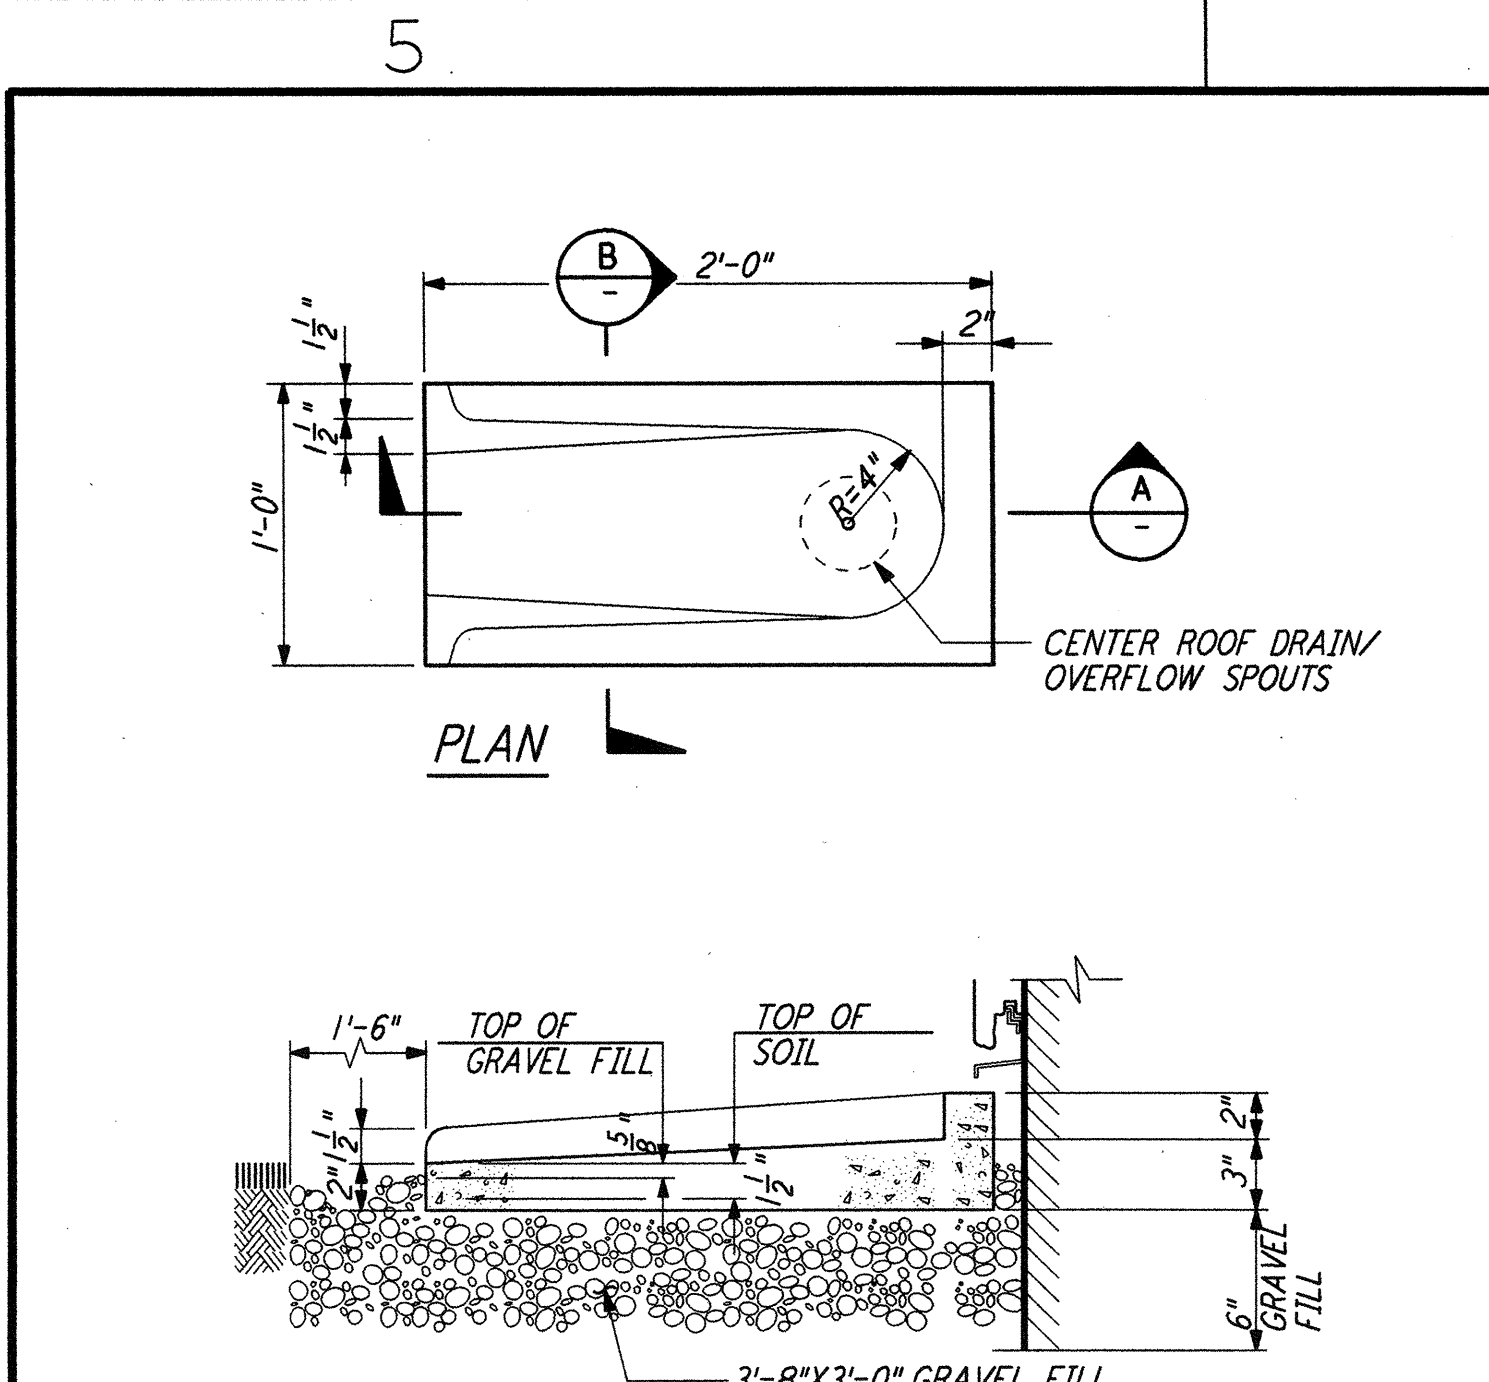
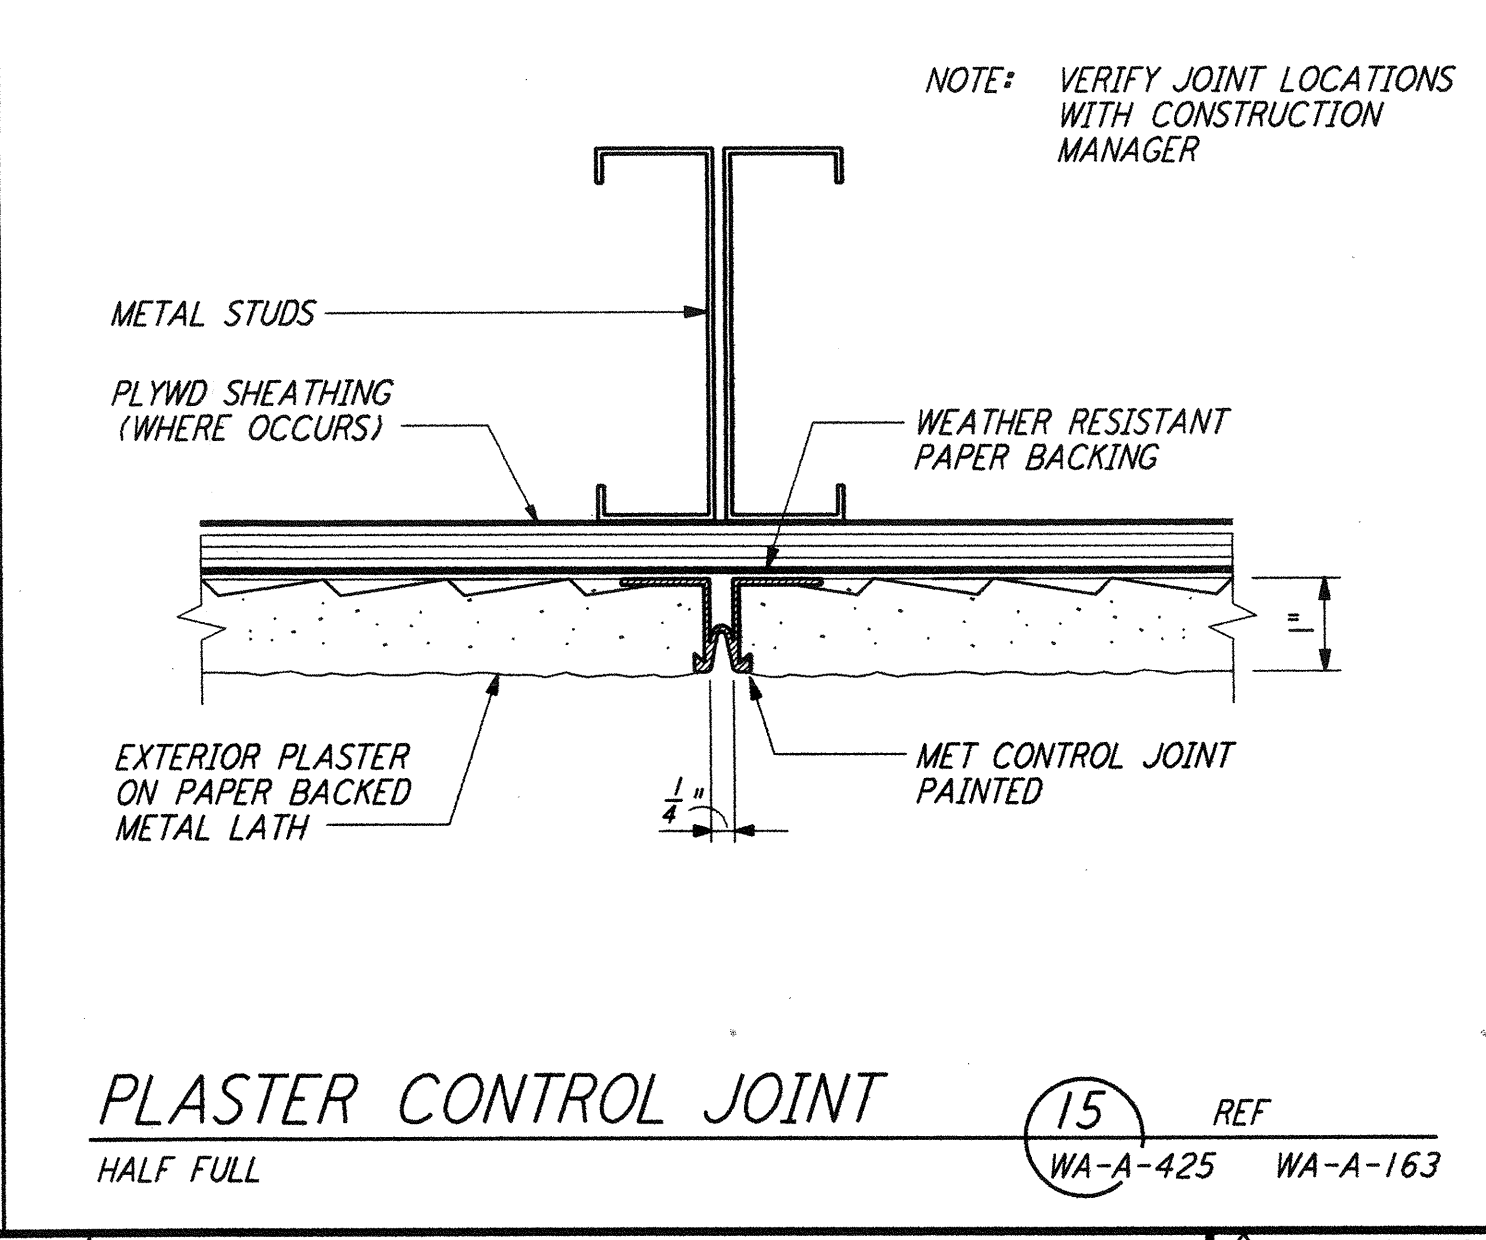
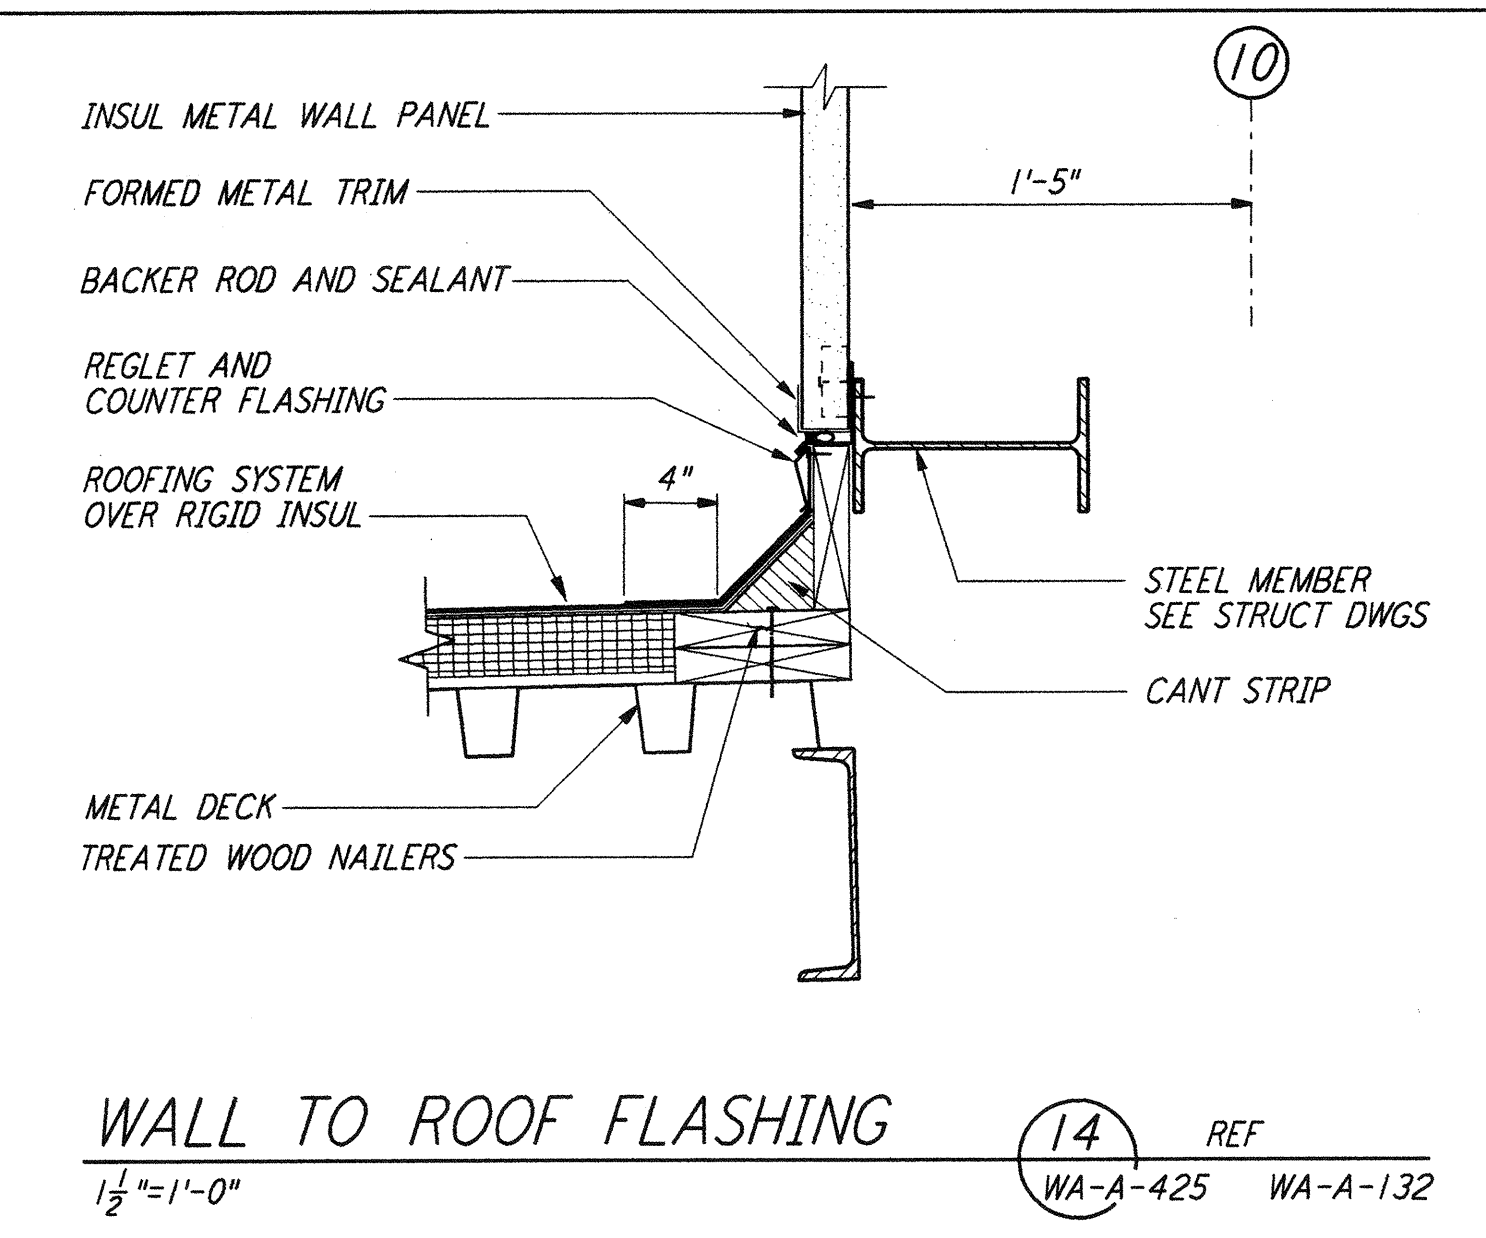






This document and the design it covers are the property of PARSONS. They are loaned only with the borrower's expressed written agreement that they will not be reproduced, copied, loaned, exhibited, or used in any other way, except by written consent from PARSONS to the borrower.

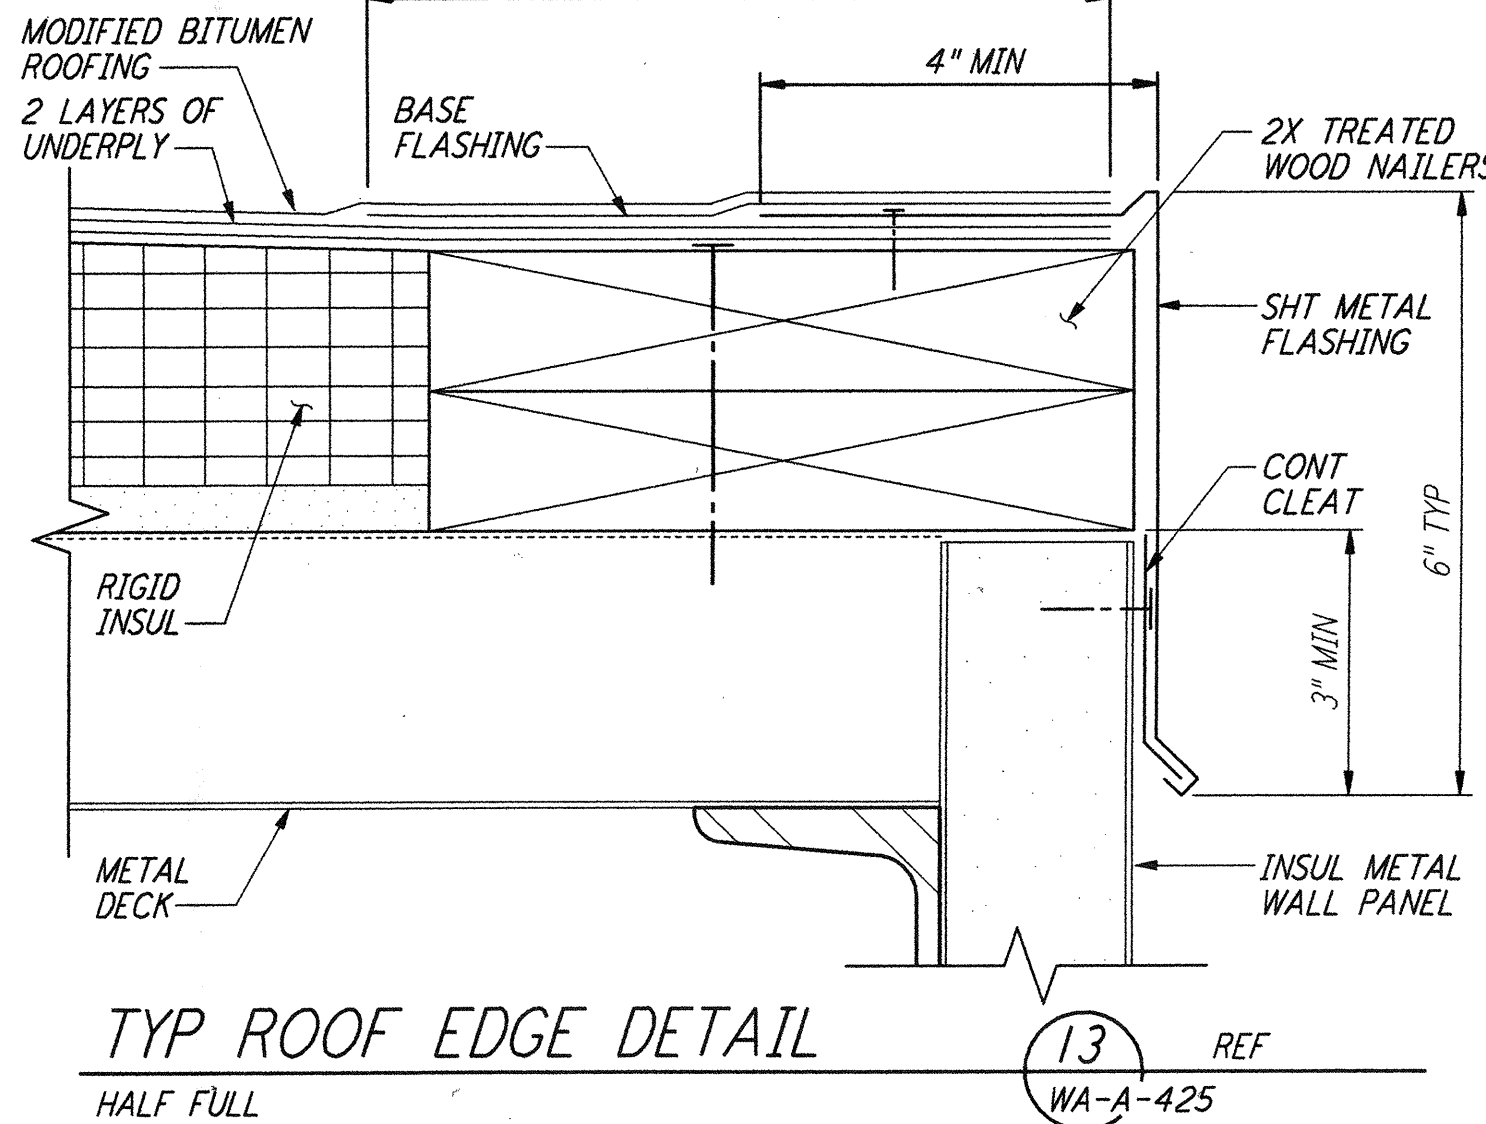





NO.	DATE	BY	CHKD	ENGR	PROJ	DESCRIPTION
1	5-15-98	CRT	MM	MM	MM	ISSUED FOR AS-BUILT

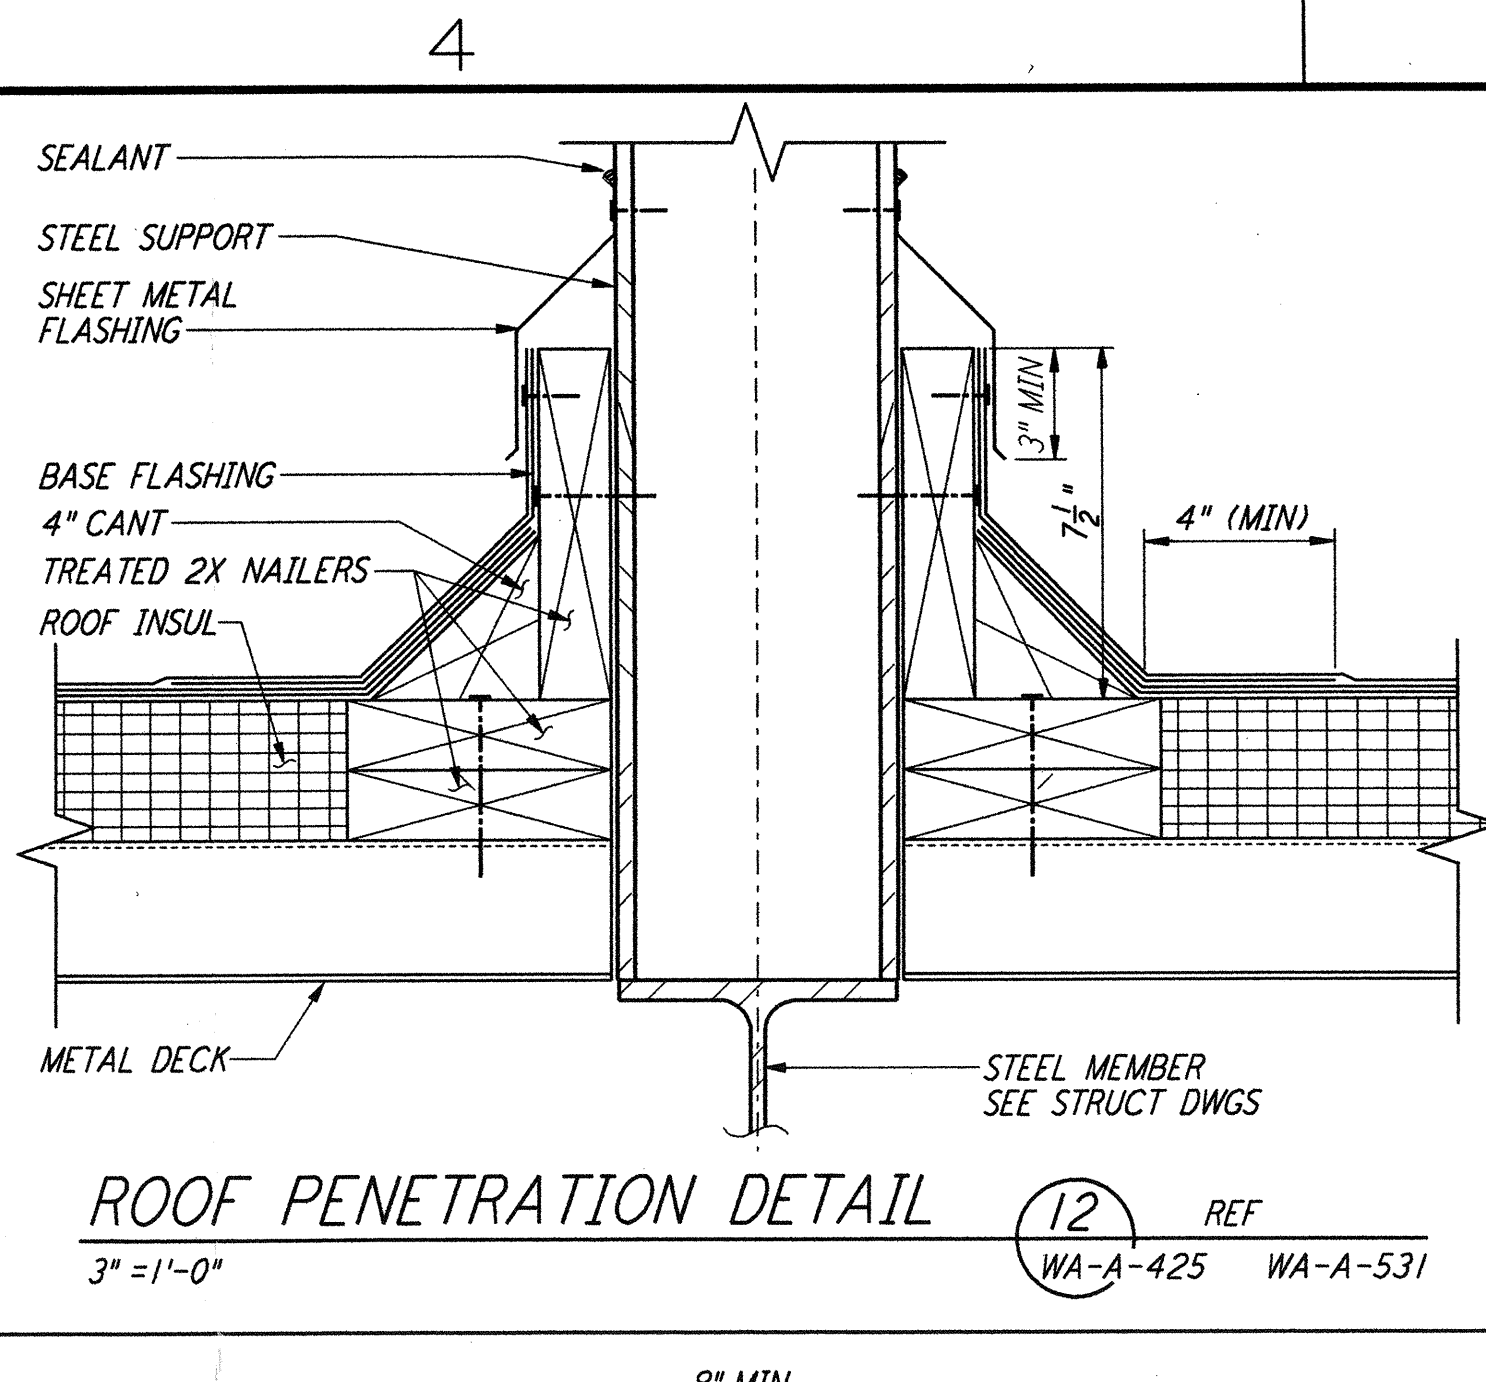





NO.	DATE	BY	CHKD	ENGR	PROJ	DESCRIPTION
1	5-15-98	CRT	MM	MM	MM	ISSUED FOR AS-BUILT

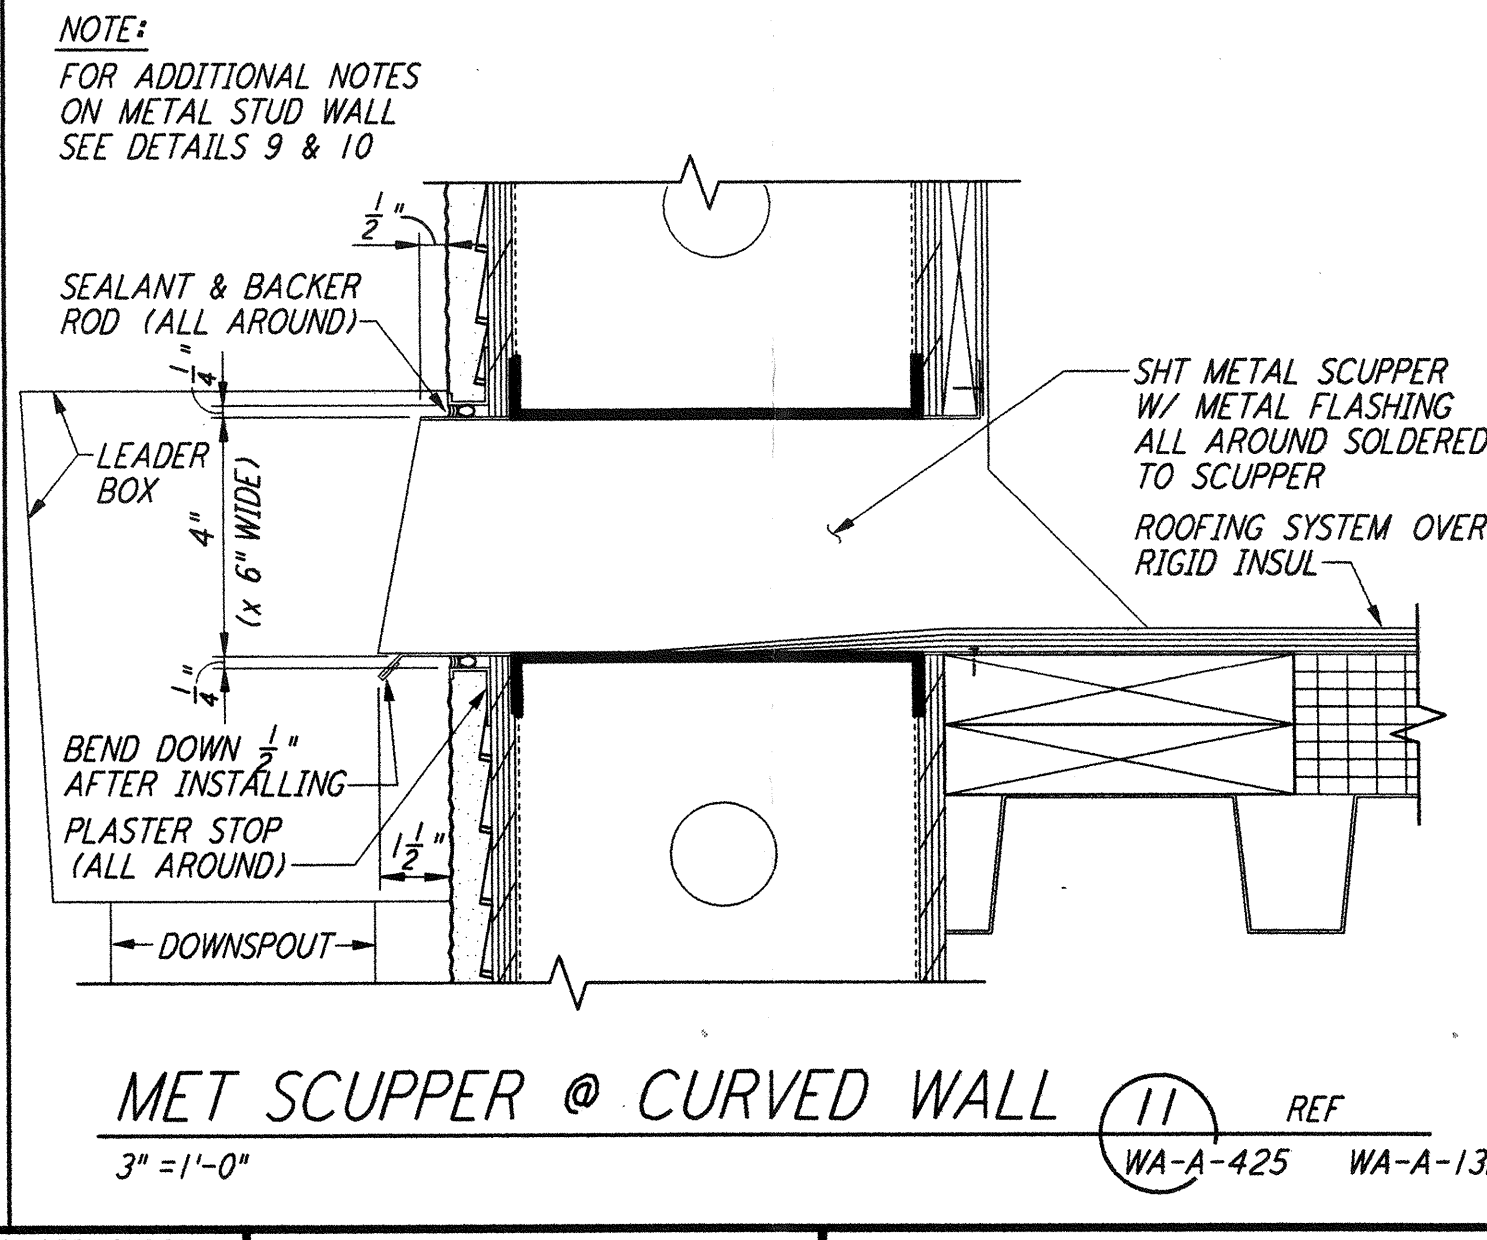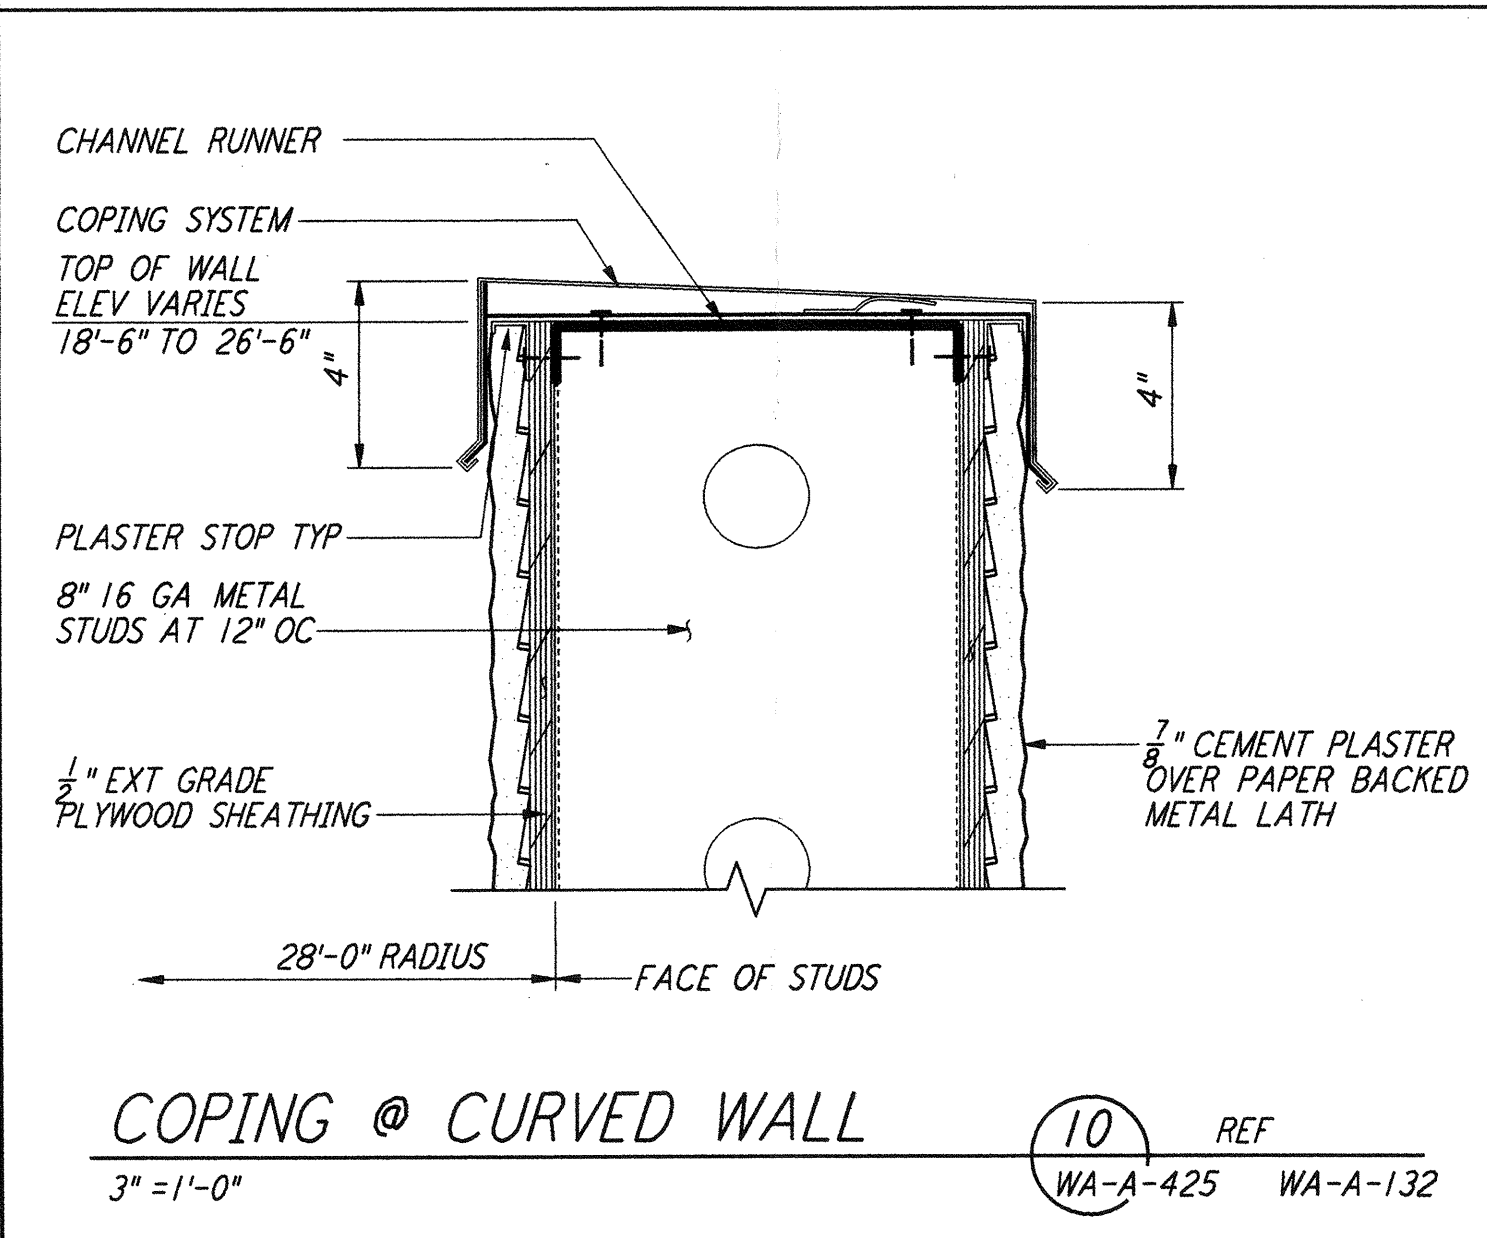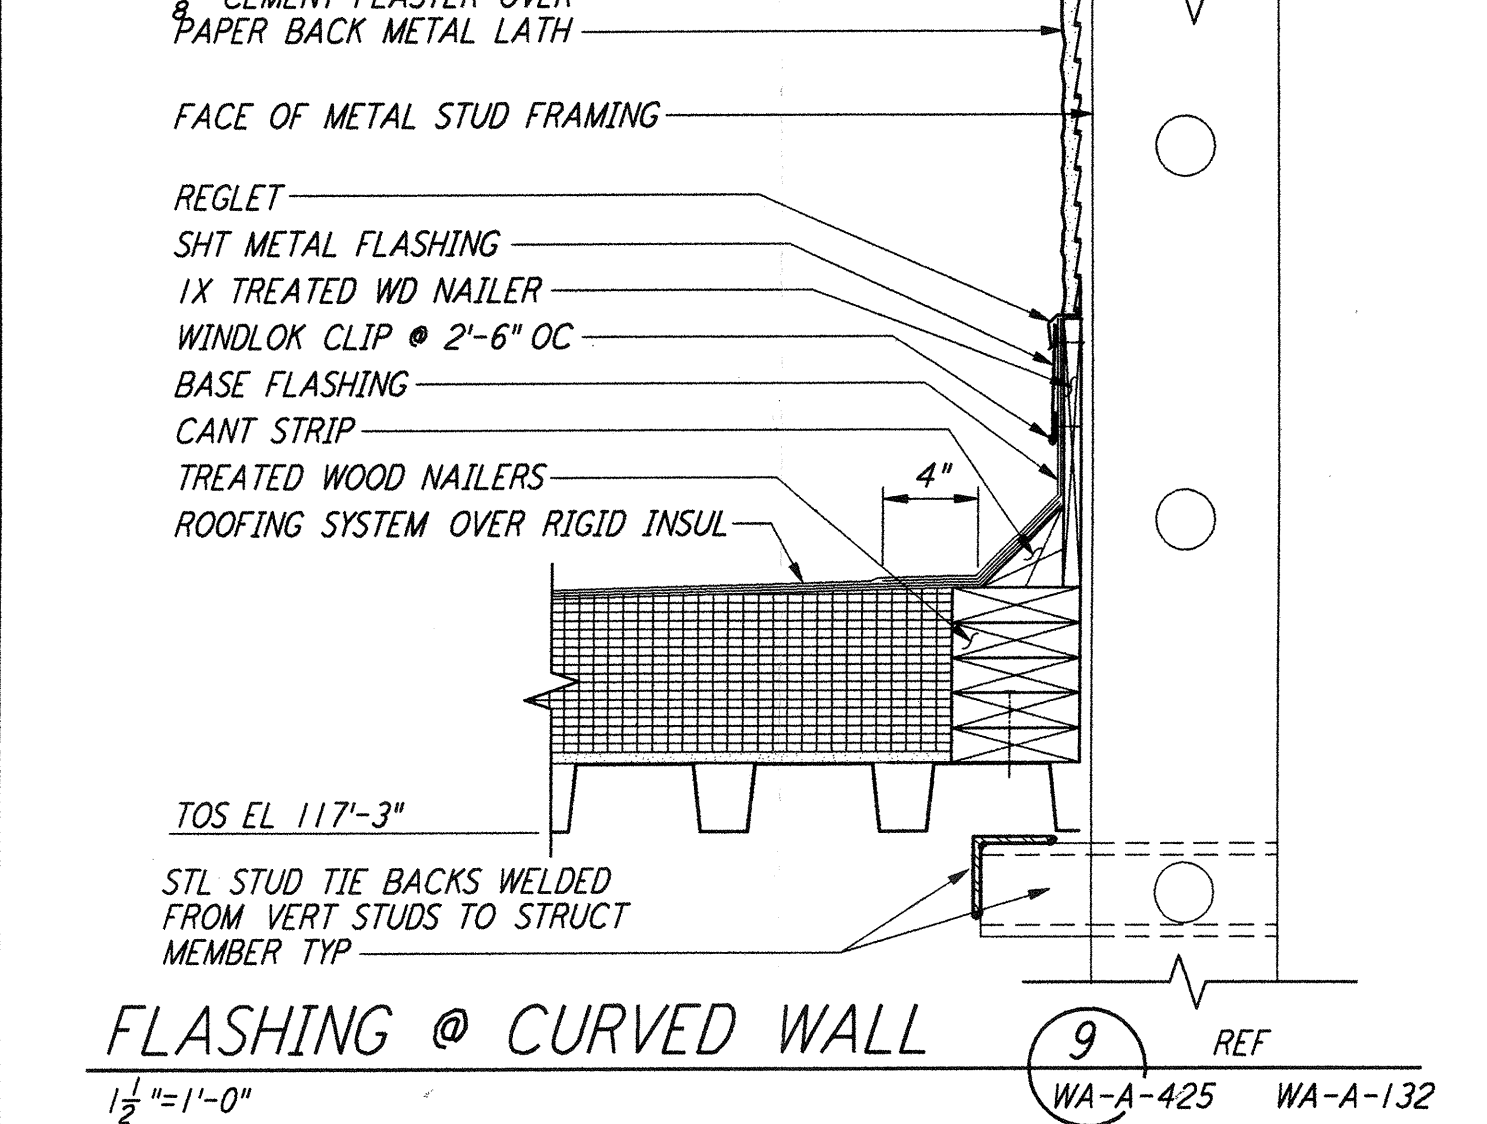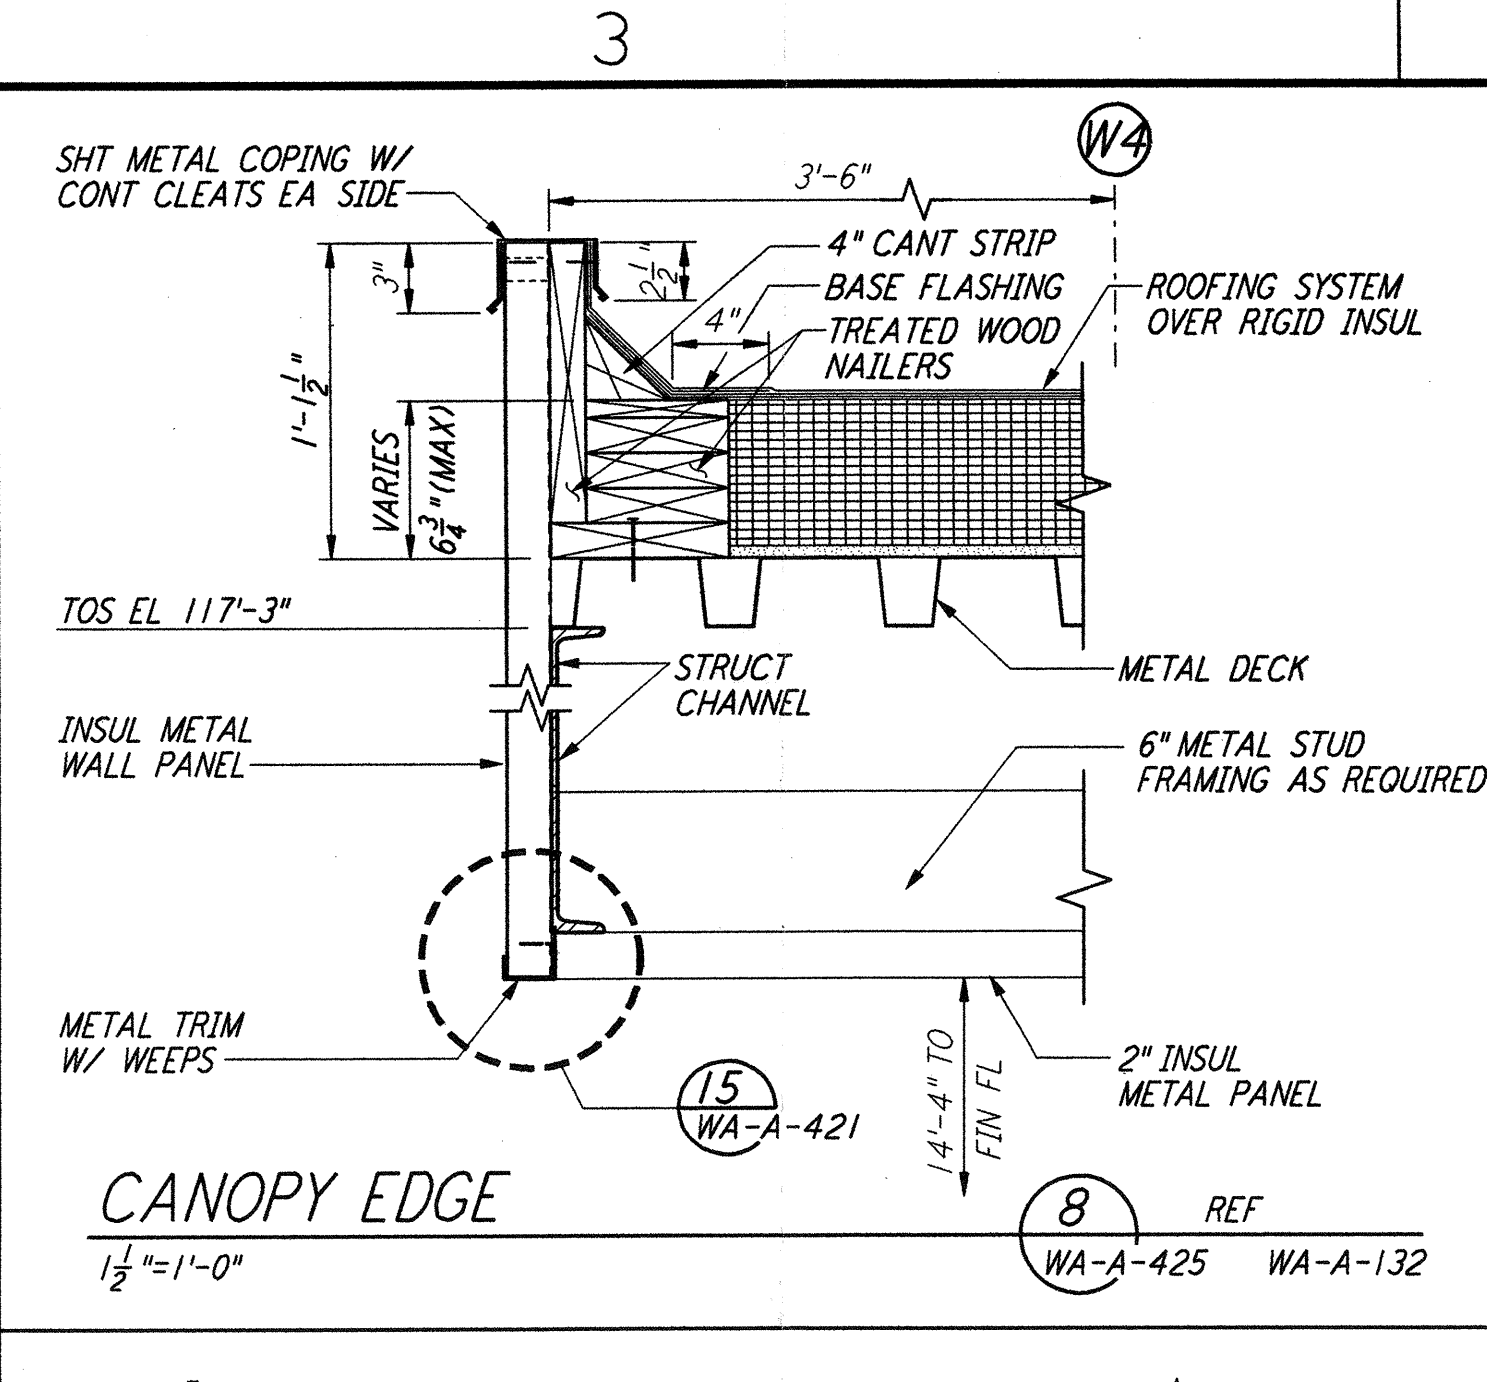


NO.	DATE	BY	CHKD	ENGR	PROJ	DESCRIPTION
1	5-15-98	CRT	MM	MM	MM	ISSUED FOR AS-BUILT

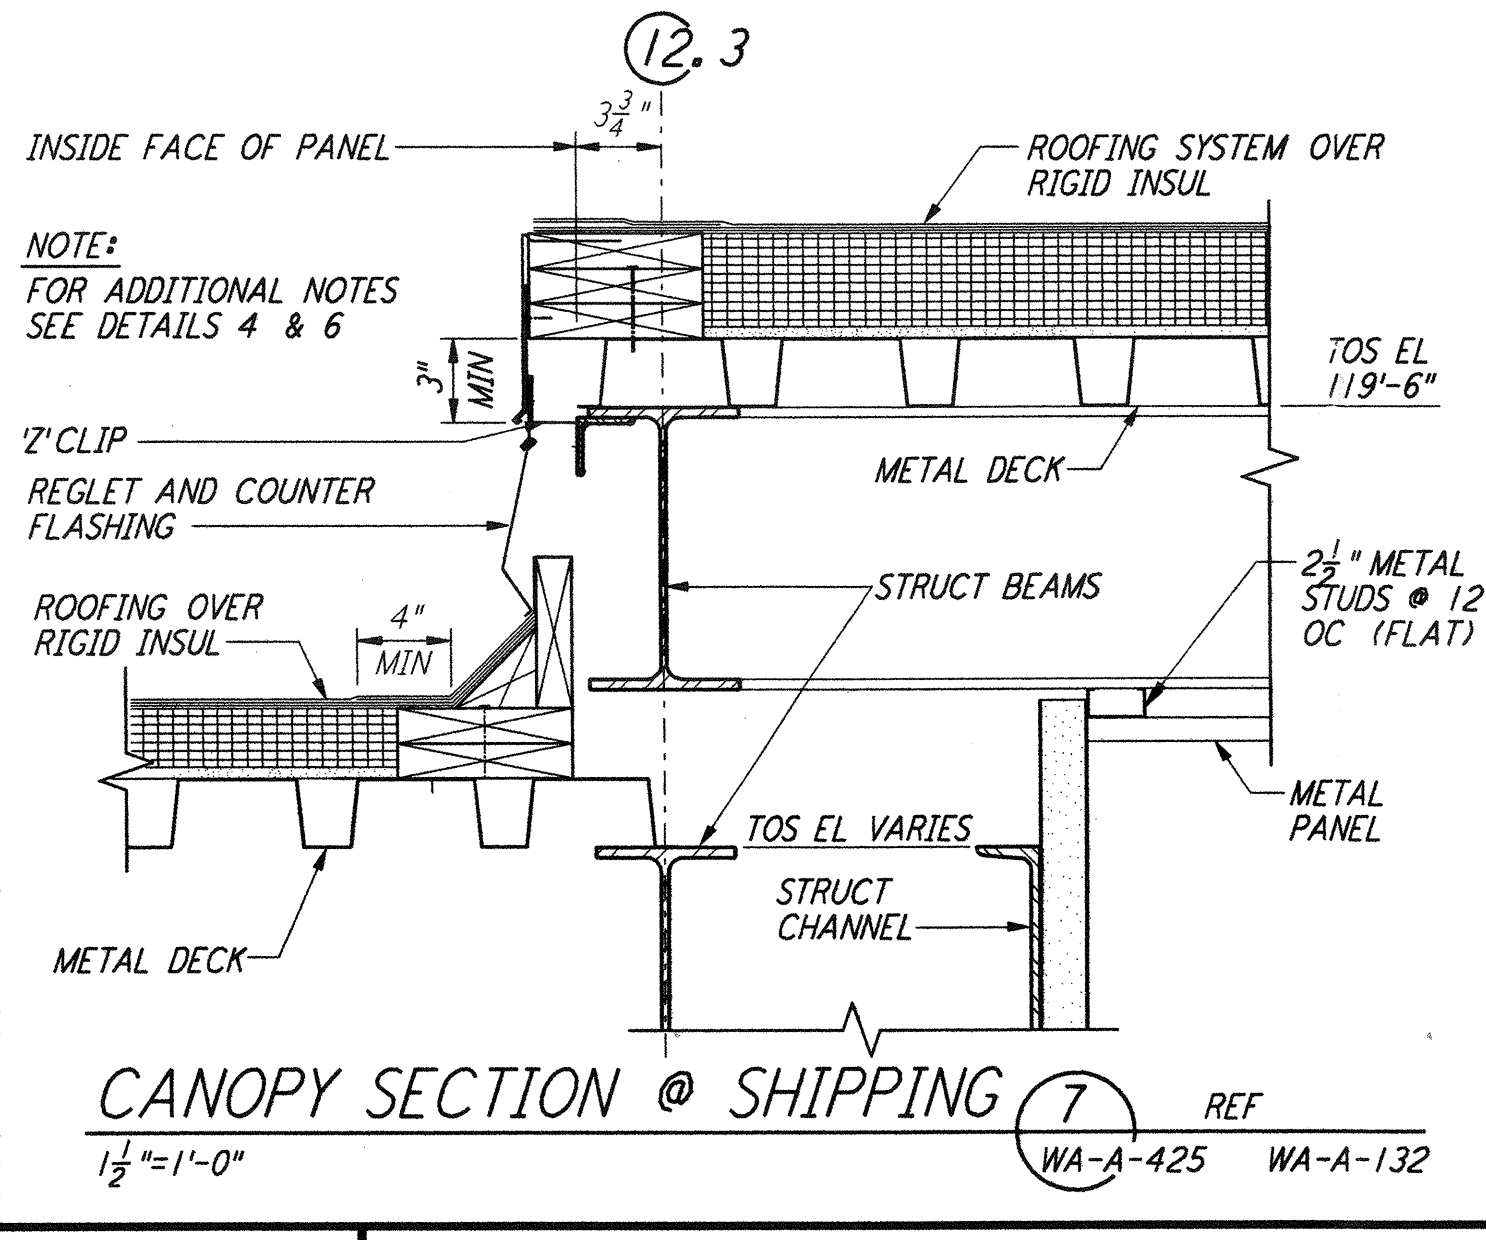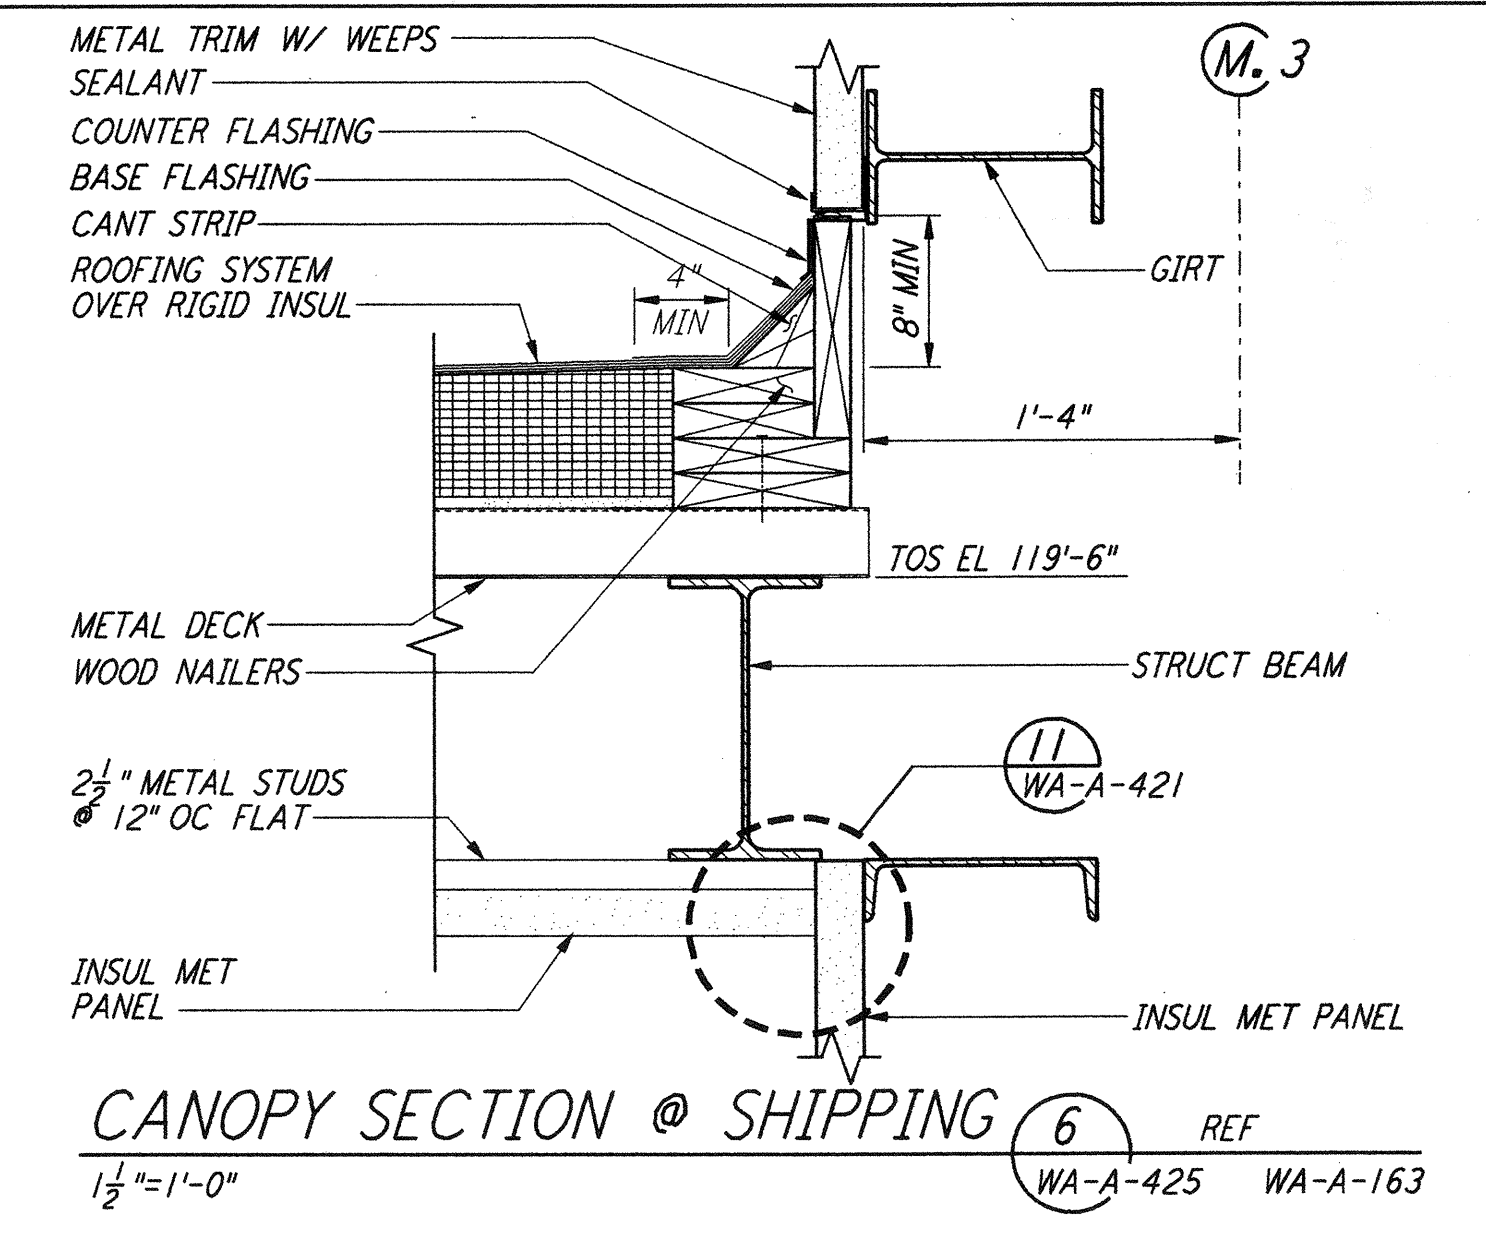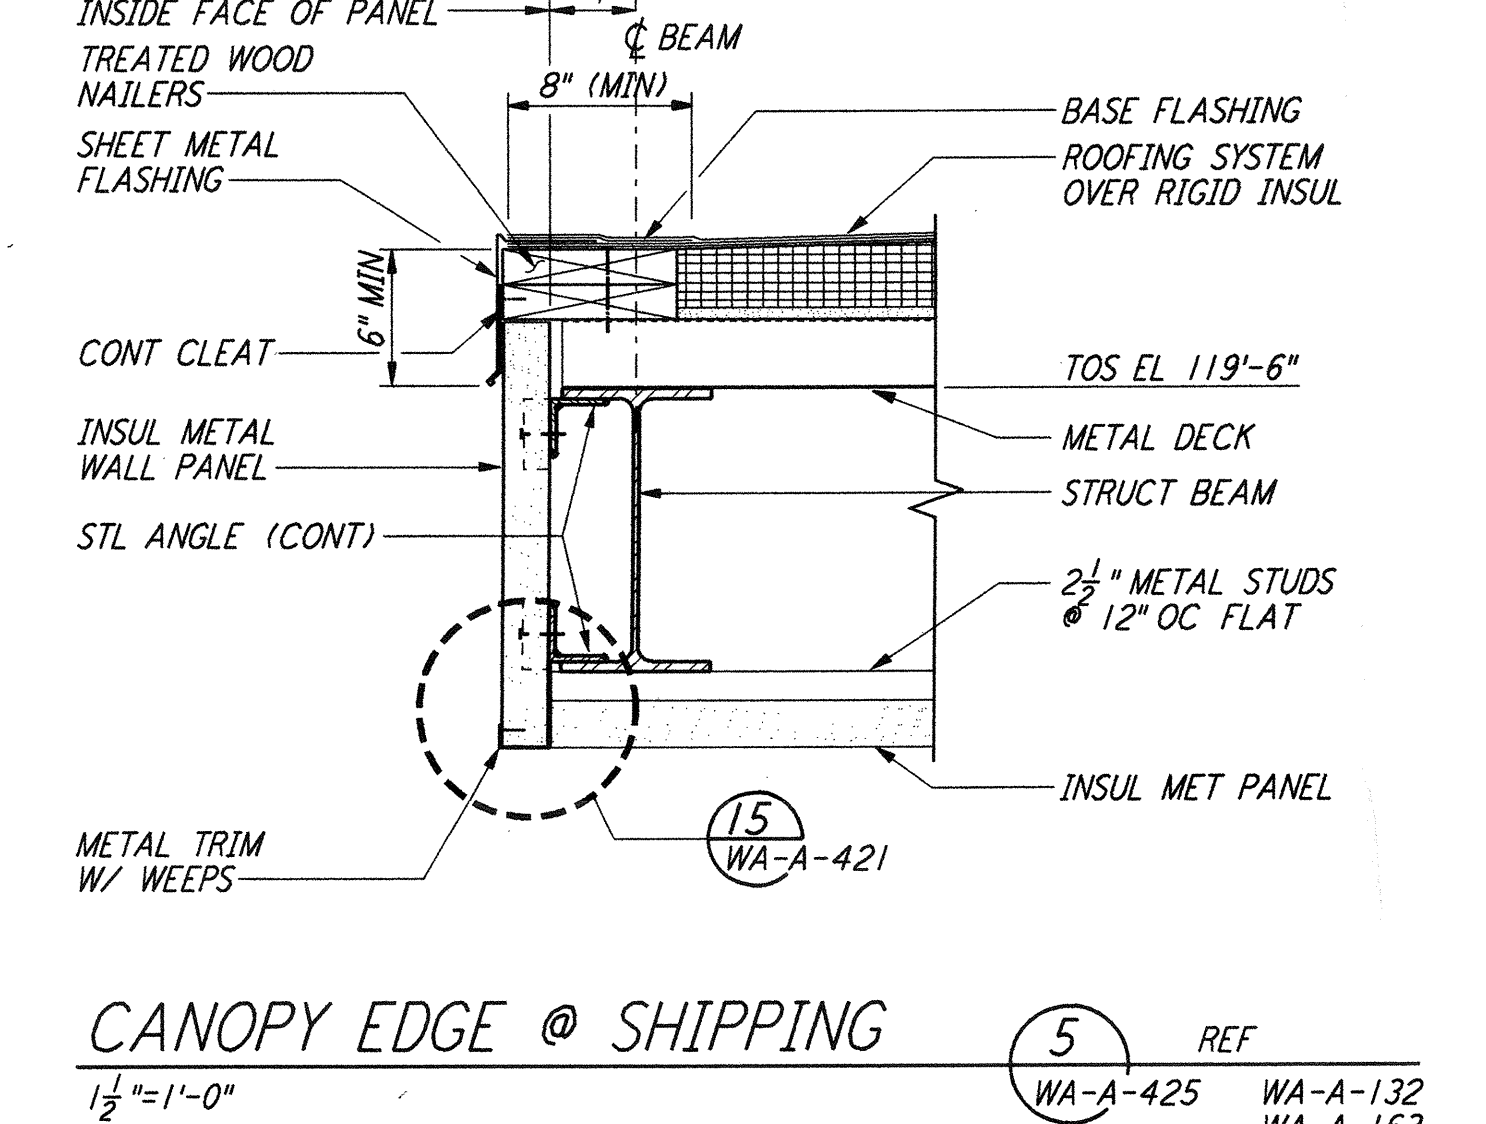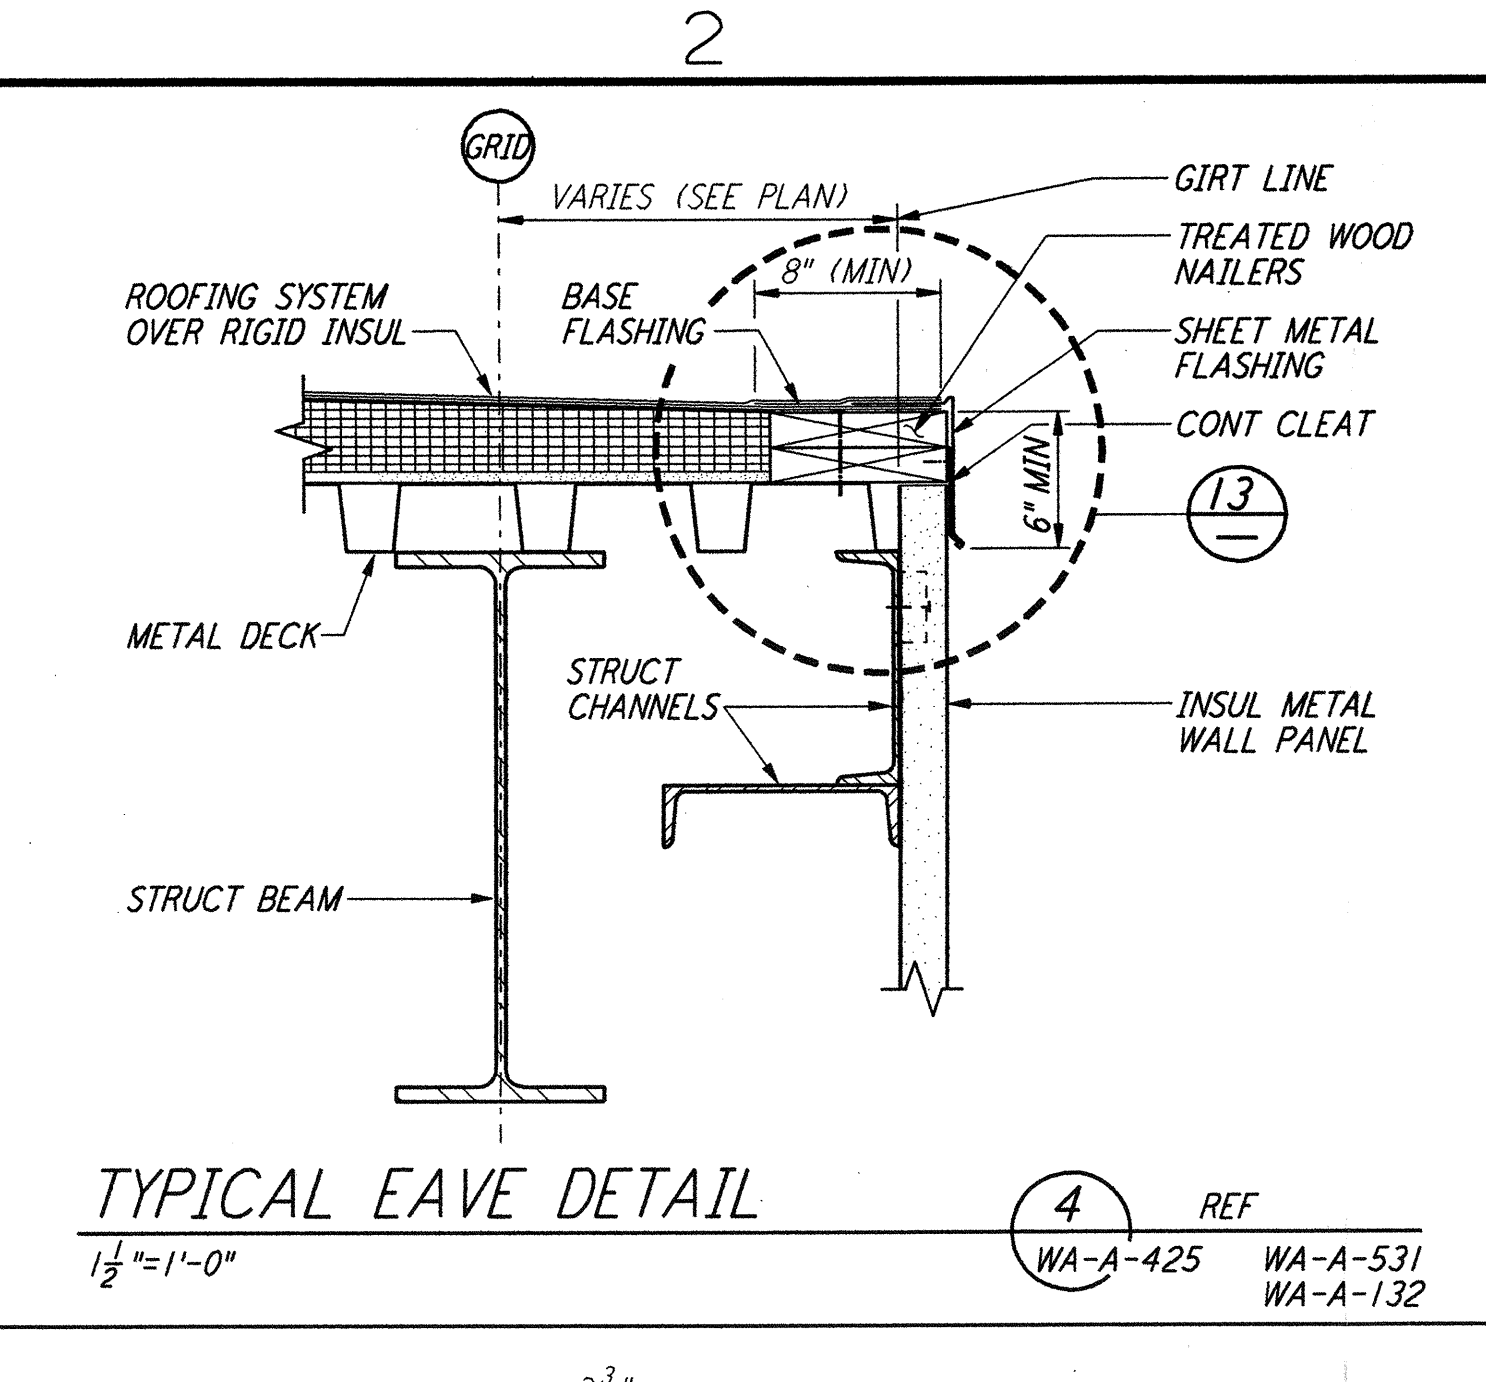

NO.	DATE	BY	CHKD	ENGR	PROJ	DESCRIPTION
1	5-15-98	CRT	MM	MM	MM	ISSUED FOR AS-BUILT

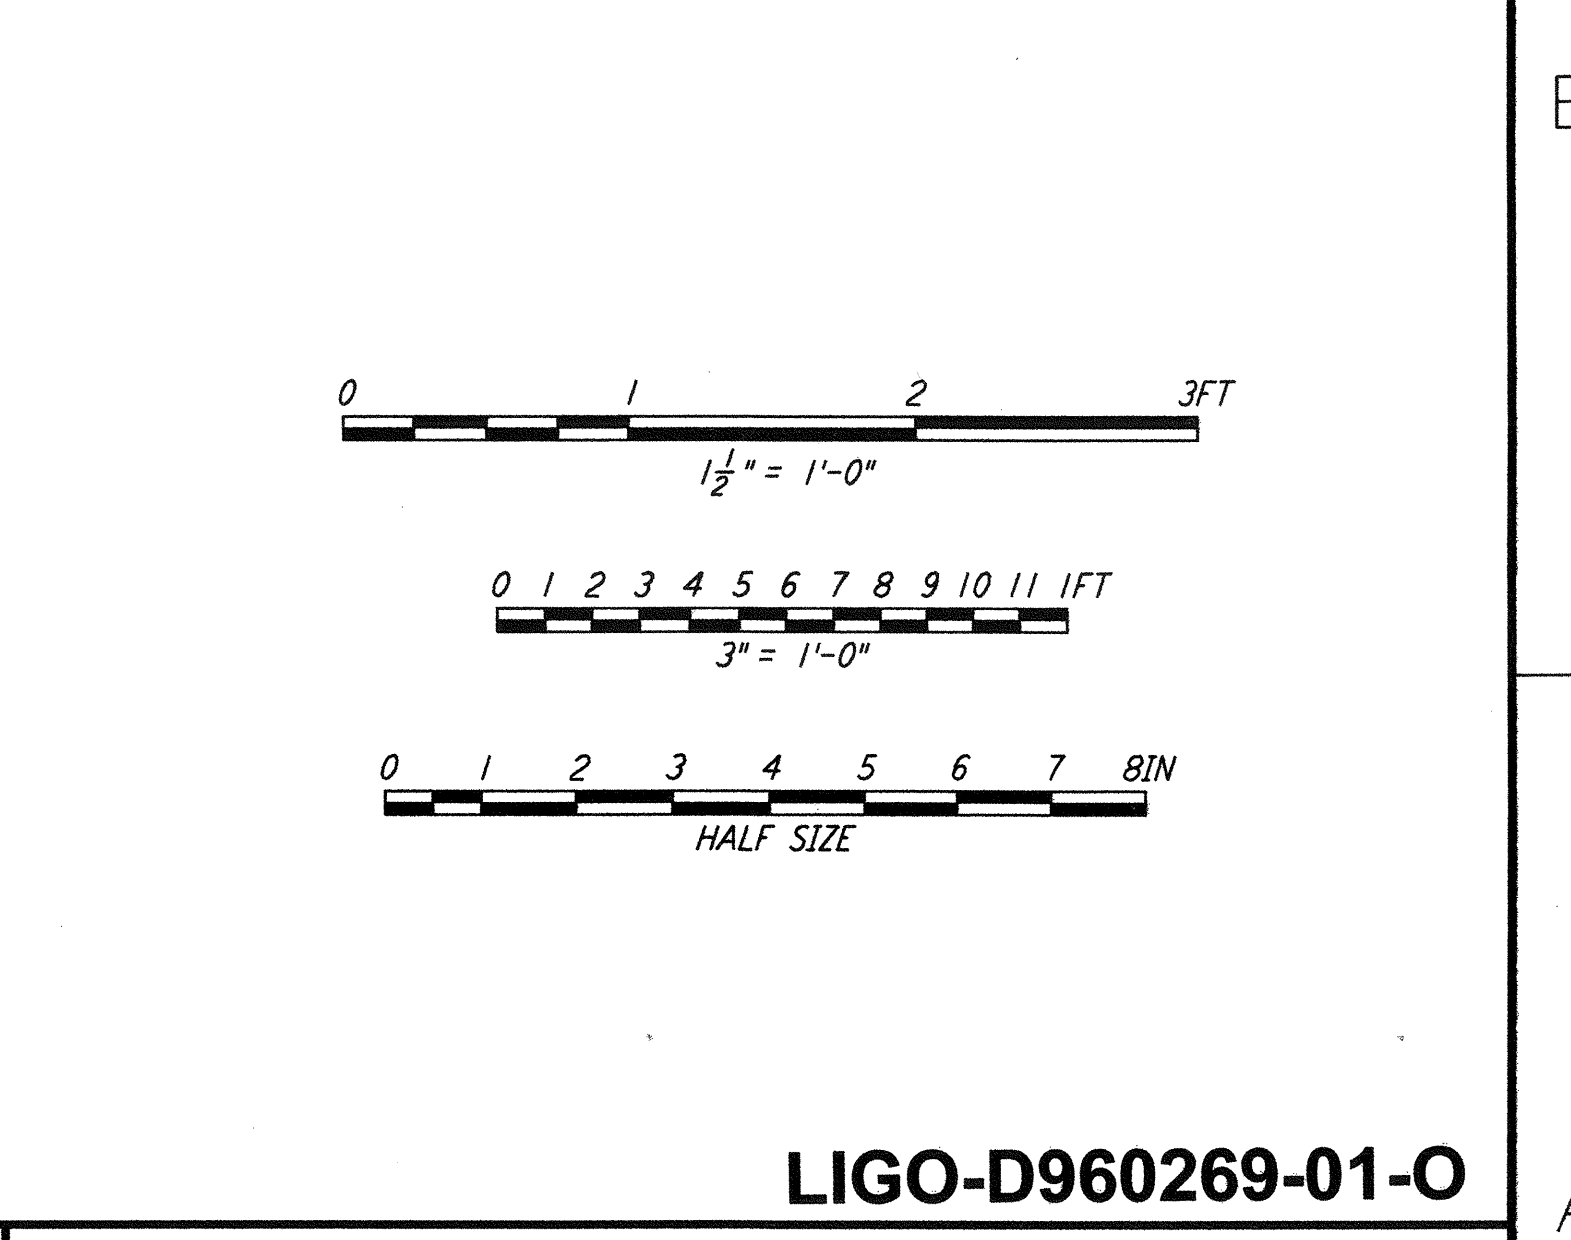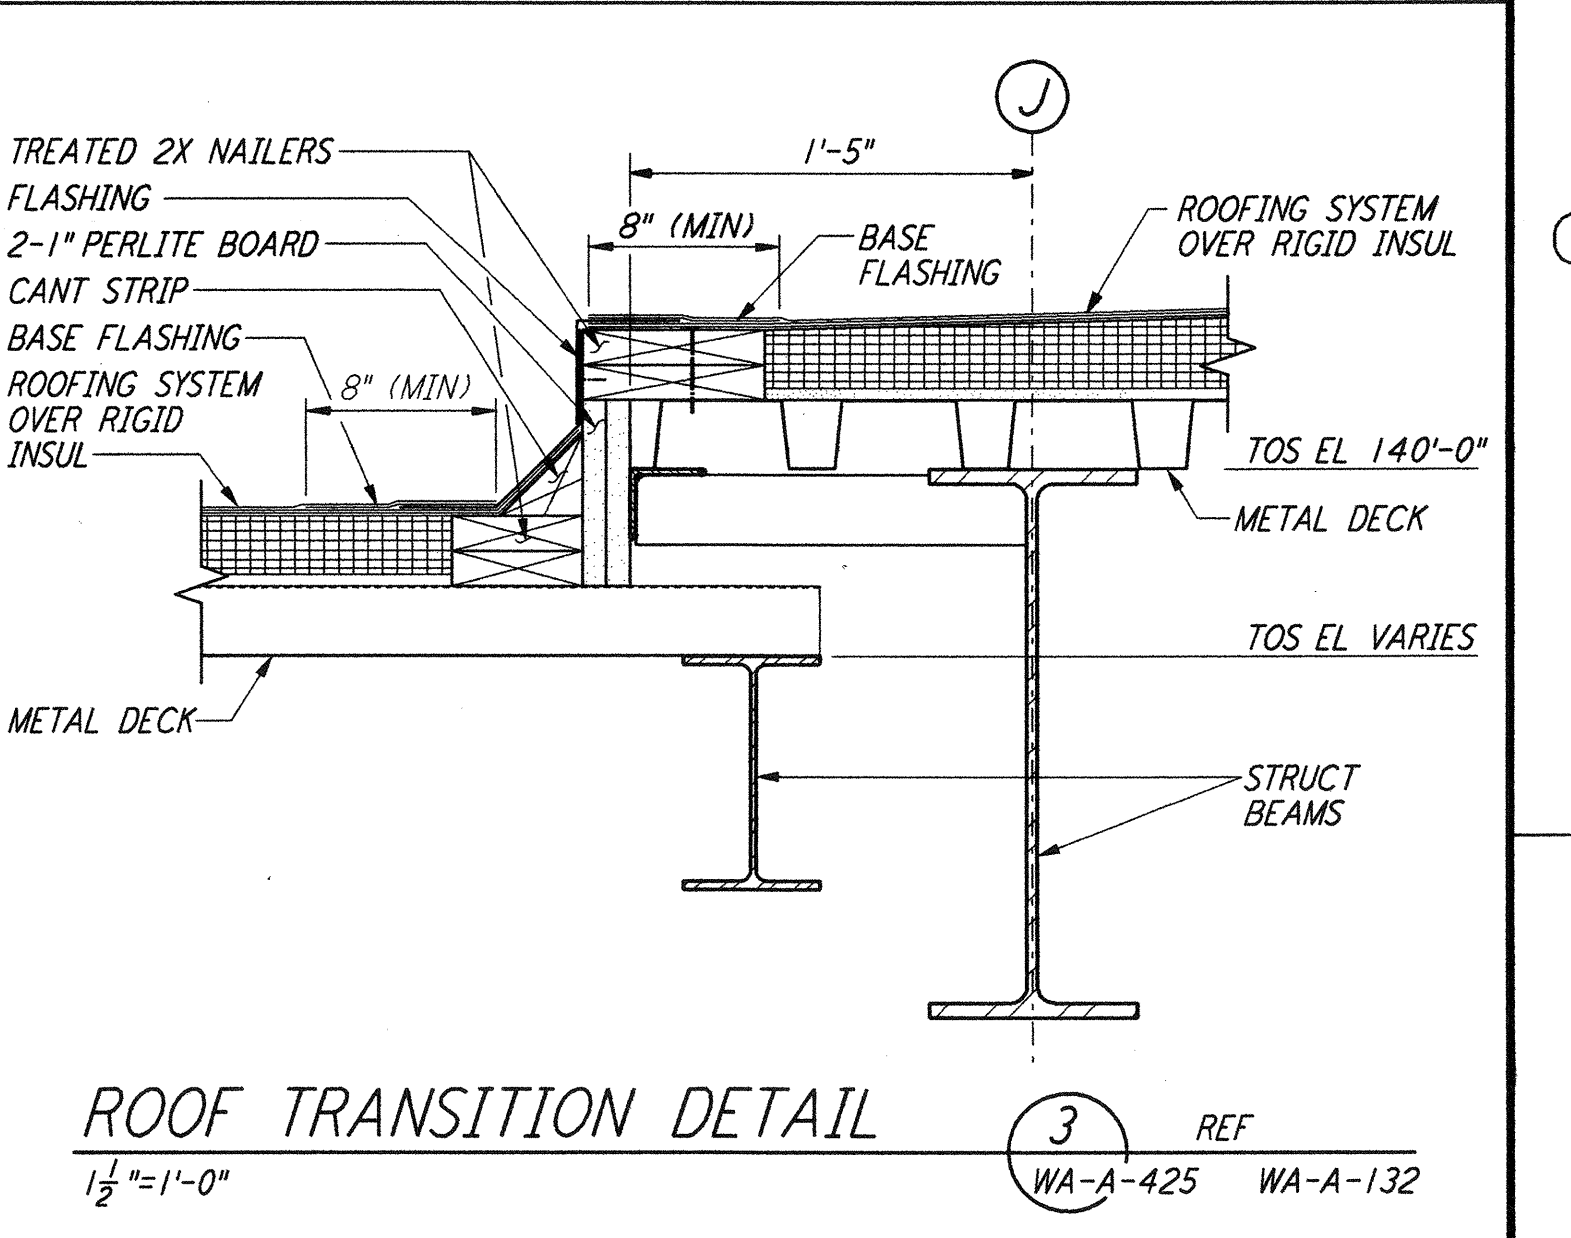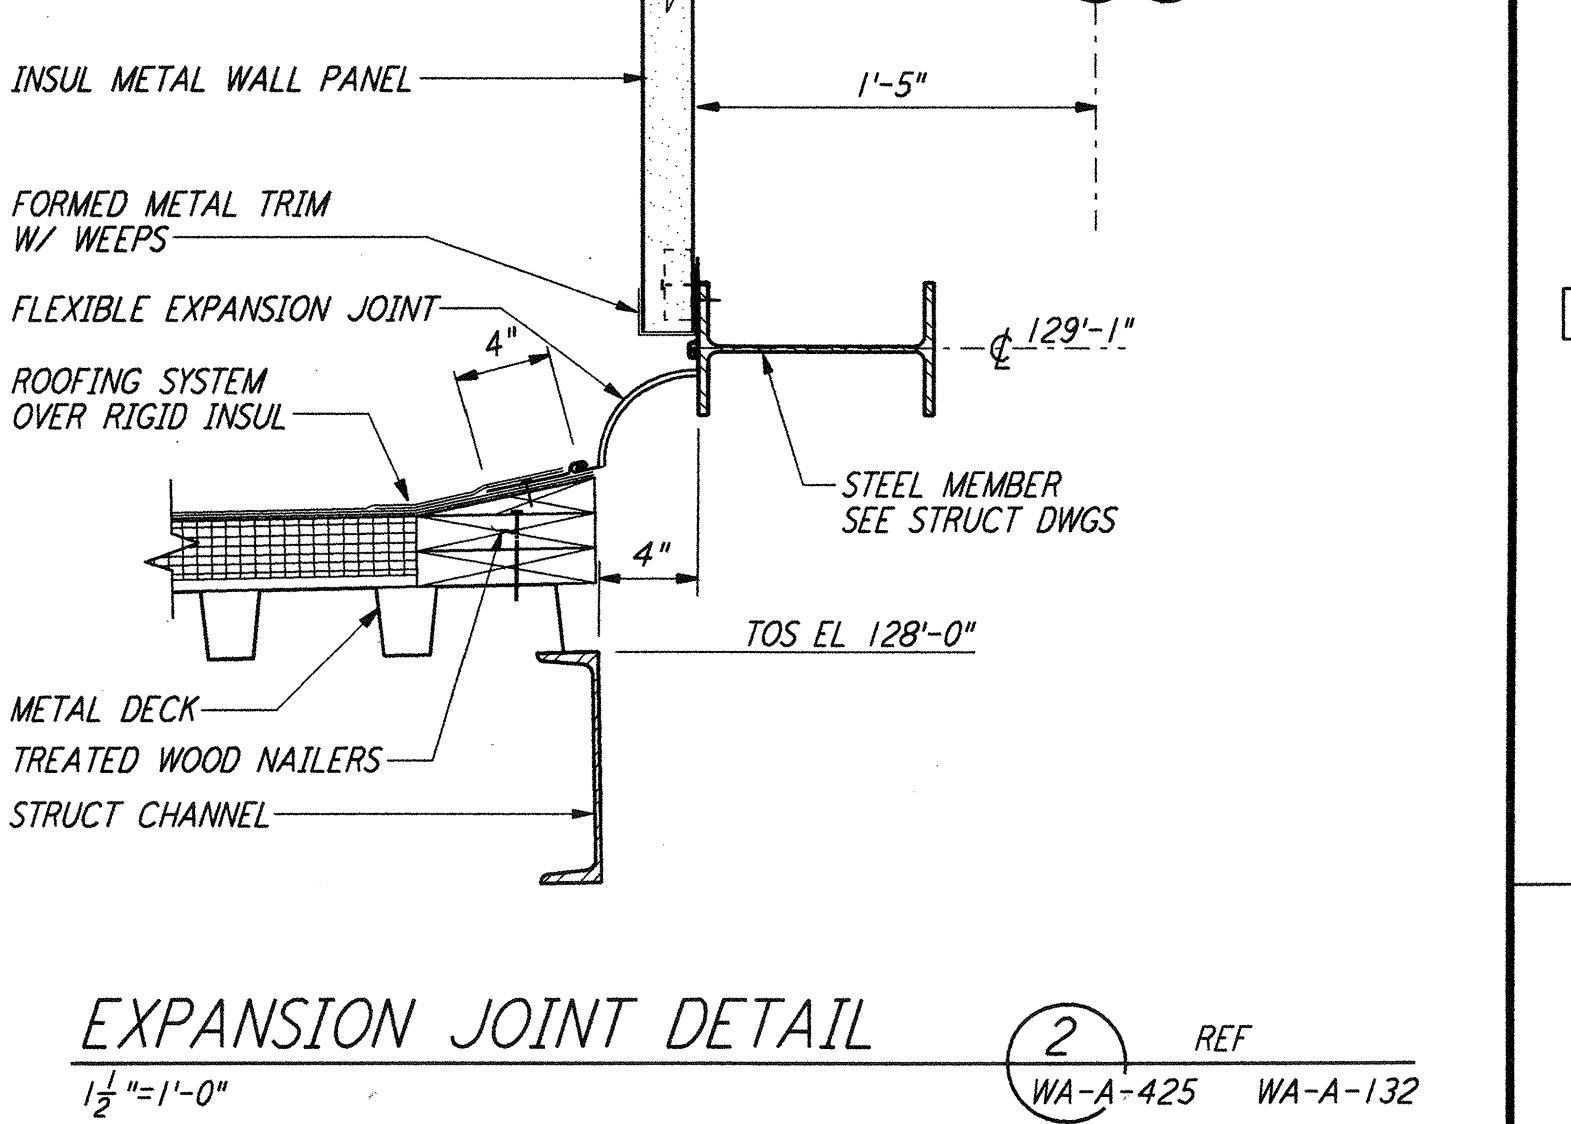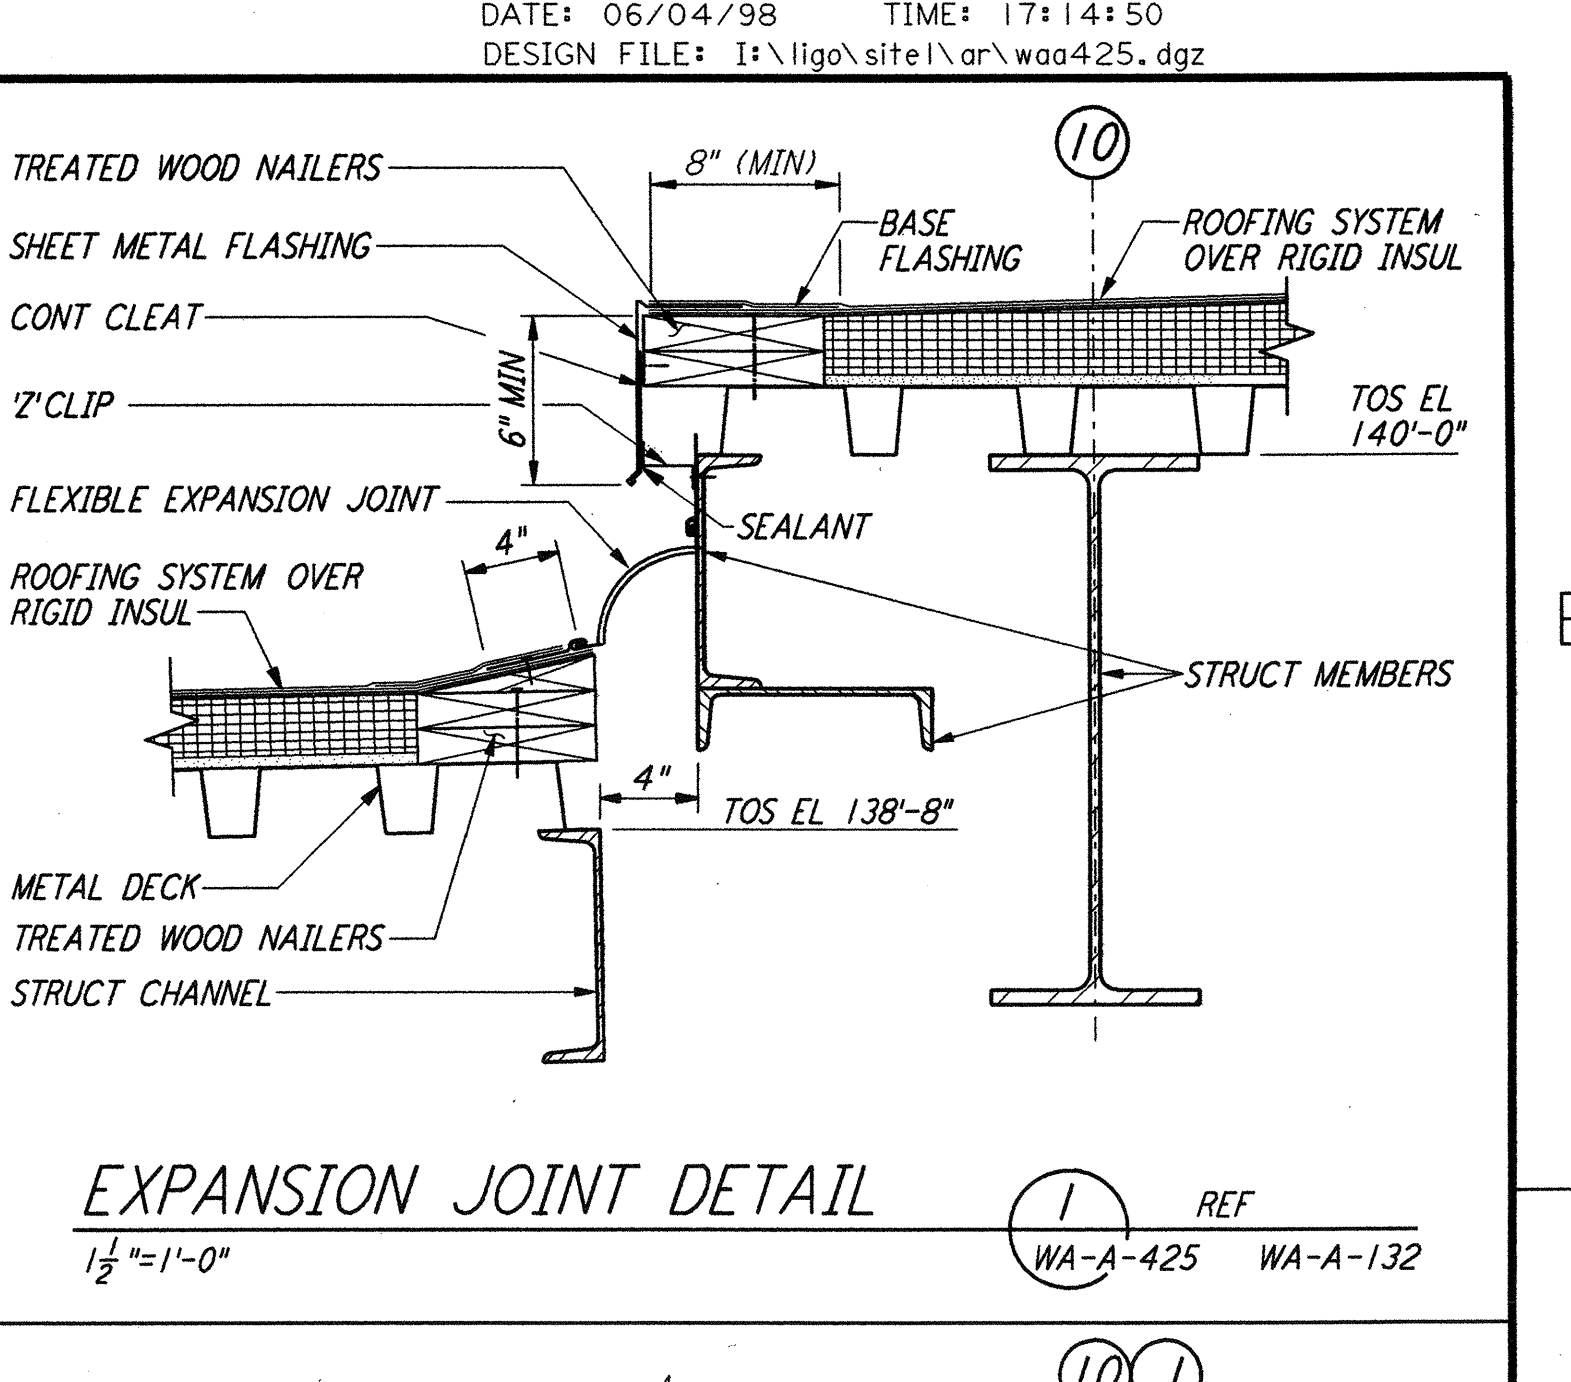

NO.	DATE	BY	CHKD	ENGR	PROJ	DESCRIPTION
1	5-15-98	CRT	MM	MM	MM	ISSUED FOR AS-BUILT

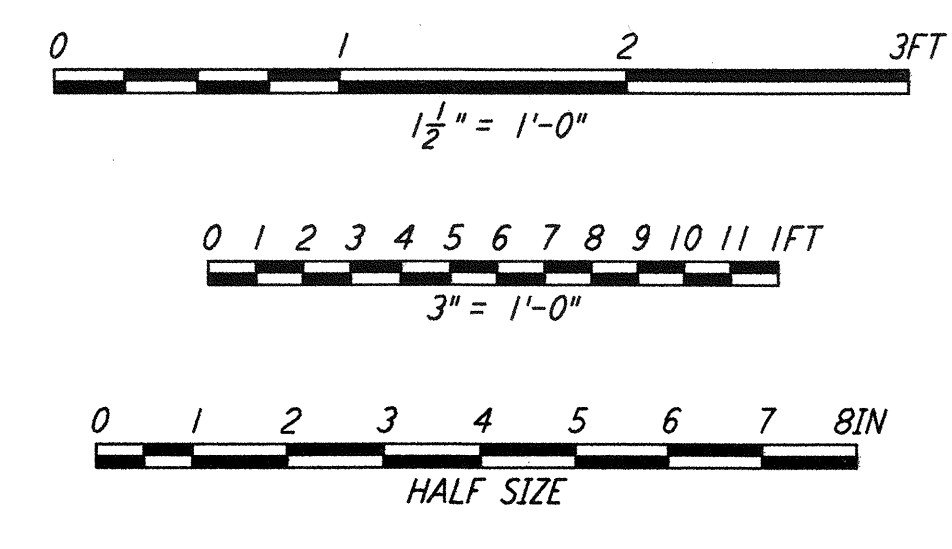

ISSUED FOR CONSTRUCTION  
 DRAWN SH 5-12-96  
 CHECKED TB 5-26-96  
 ENGINEER bhk 7-12-96  
 PROJ MDW 7-12-96

**PARSONS**  
 100 WEST WALNUT STREET  
 PASADENA, CALIFORNIA

**LIGO**  
 CALIFORNIA INSTITUTE OF TECHNOLOGY  
 MASSACHUSETTS INSTITUTE OF TECHNOLOGY

LASER INTERFEROMETER  
 GRAVITATIONAL-WAVE OBSERVATORY  
 SITE NO. 1 - HANFORD, WASHINGTON

ARCHITECTURAL  
 ROOF AND  
 MISCELLANEOUS  
 EXTERIOR DETAILS

AS NOTED PP150969 8094  
**WA-A-425**

Thu Jun 04 17:42:20 1998 C:\PLOT\JOB\53-9382\JOB\F 52085 K:\V382\w-425.dwg