




This document and the design it covers are the property of PARSONS. They are loaned only with the borrower's expressed written agreement that they will not be reproduced, copied, loaned, exhibited, or used in any other way, except by written consent from PARSONS to the borrower.

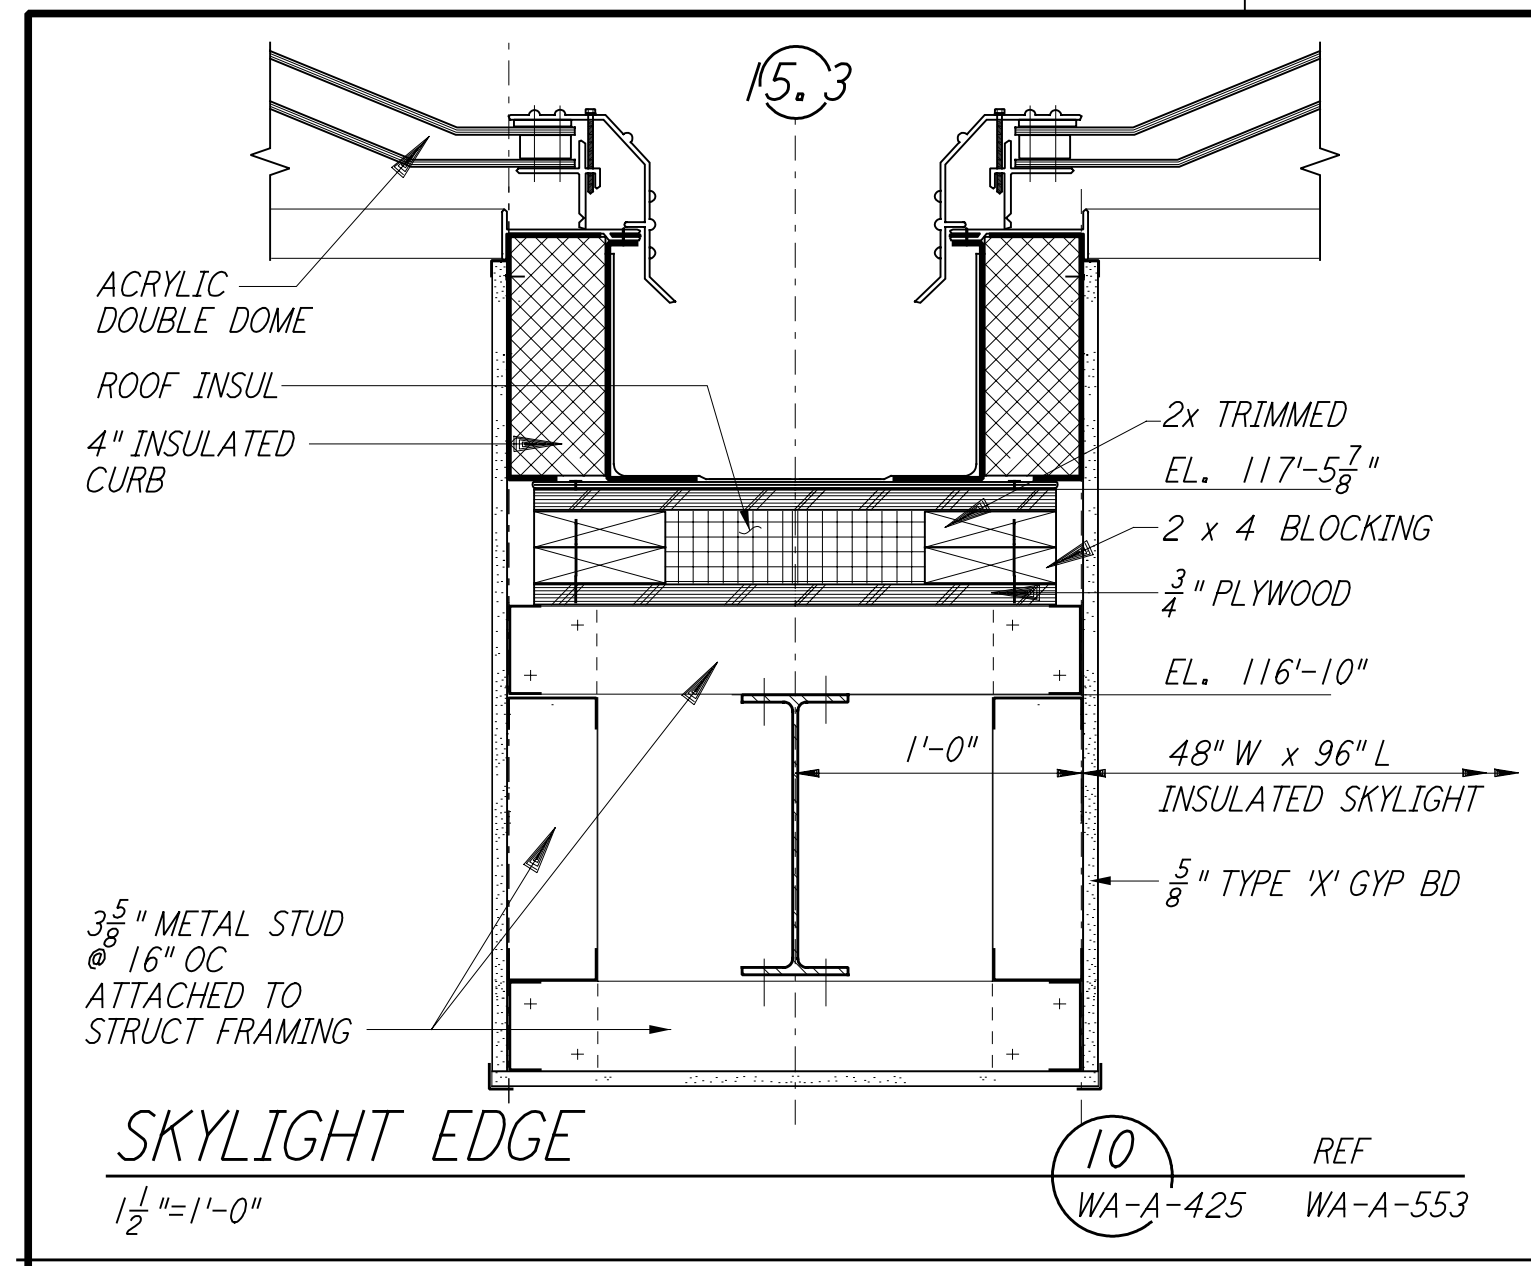


SKYLIGHT EDGE
 1/2" = 1'-0"
 REF WA-A-425 WA-A-553

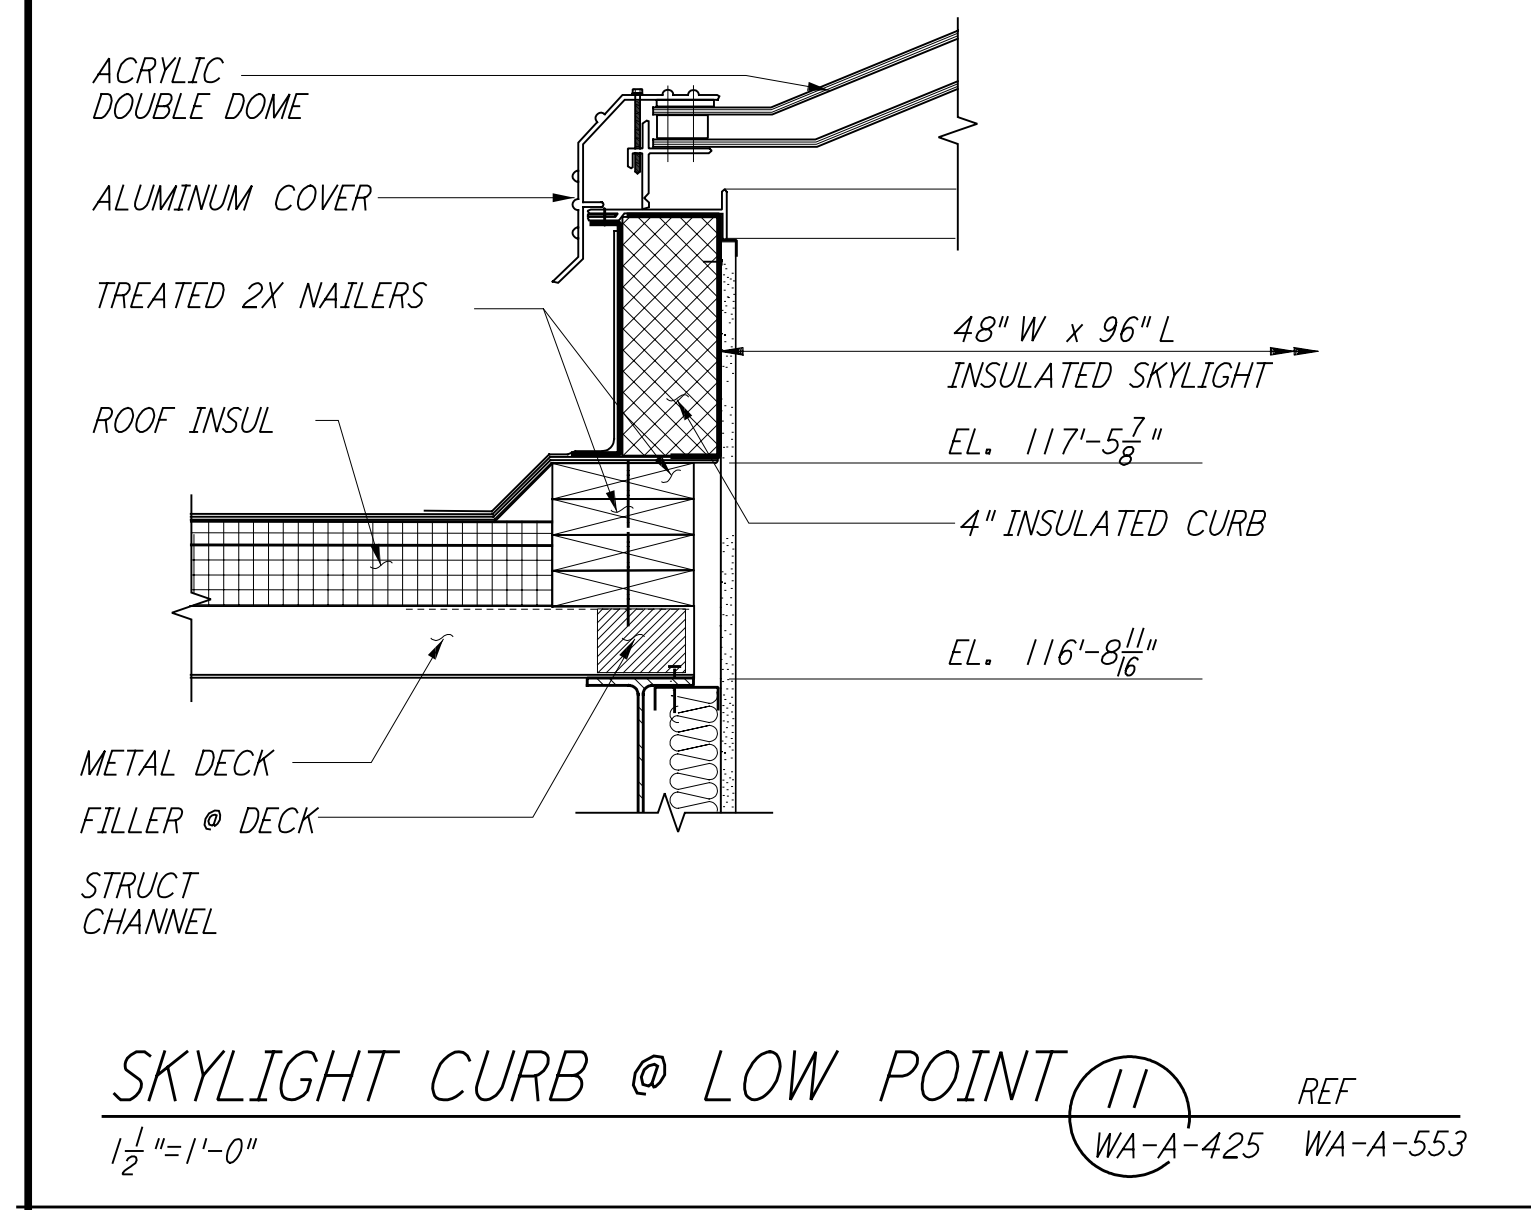


SKYLIGHT CURB @ LOW POINT
 1/2" = 1'-0"
 REF WA-A-425 WA-A-553

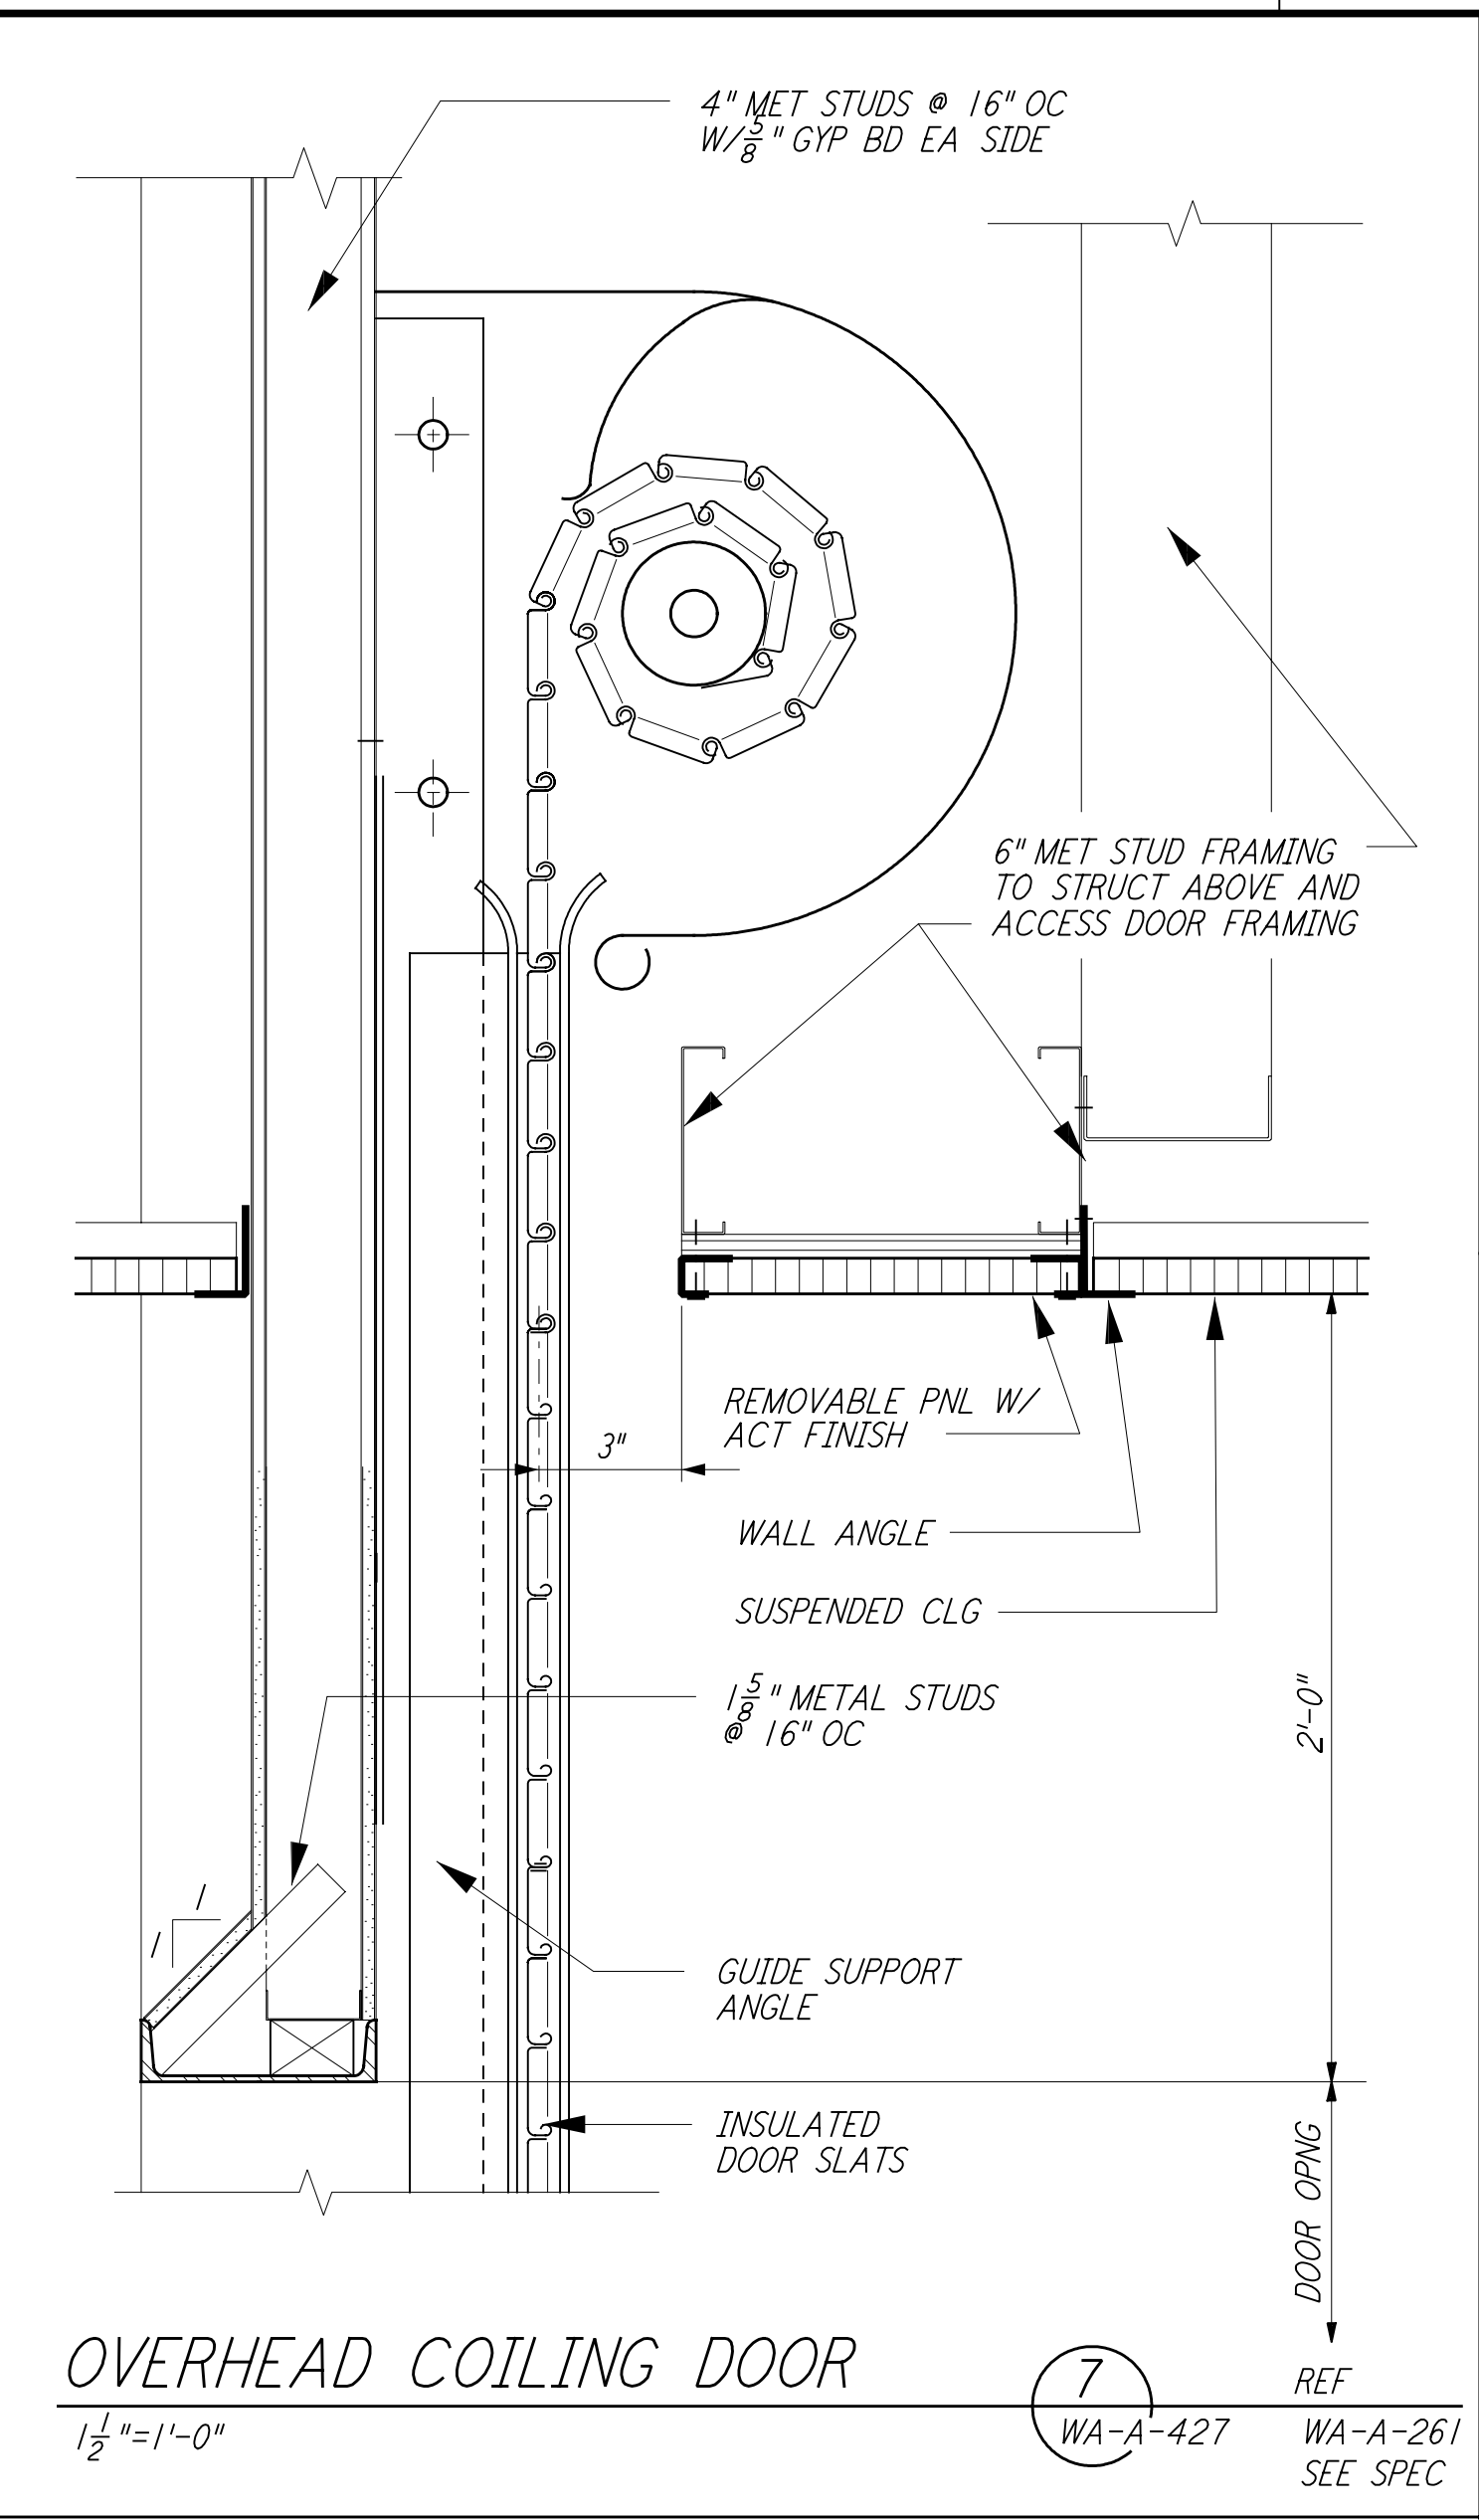


OVERHEAD COILING DOOR
 1/2" = 1'-0"
 REF WA-A-427 WA-A-261 SEE SPEC

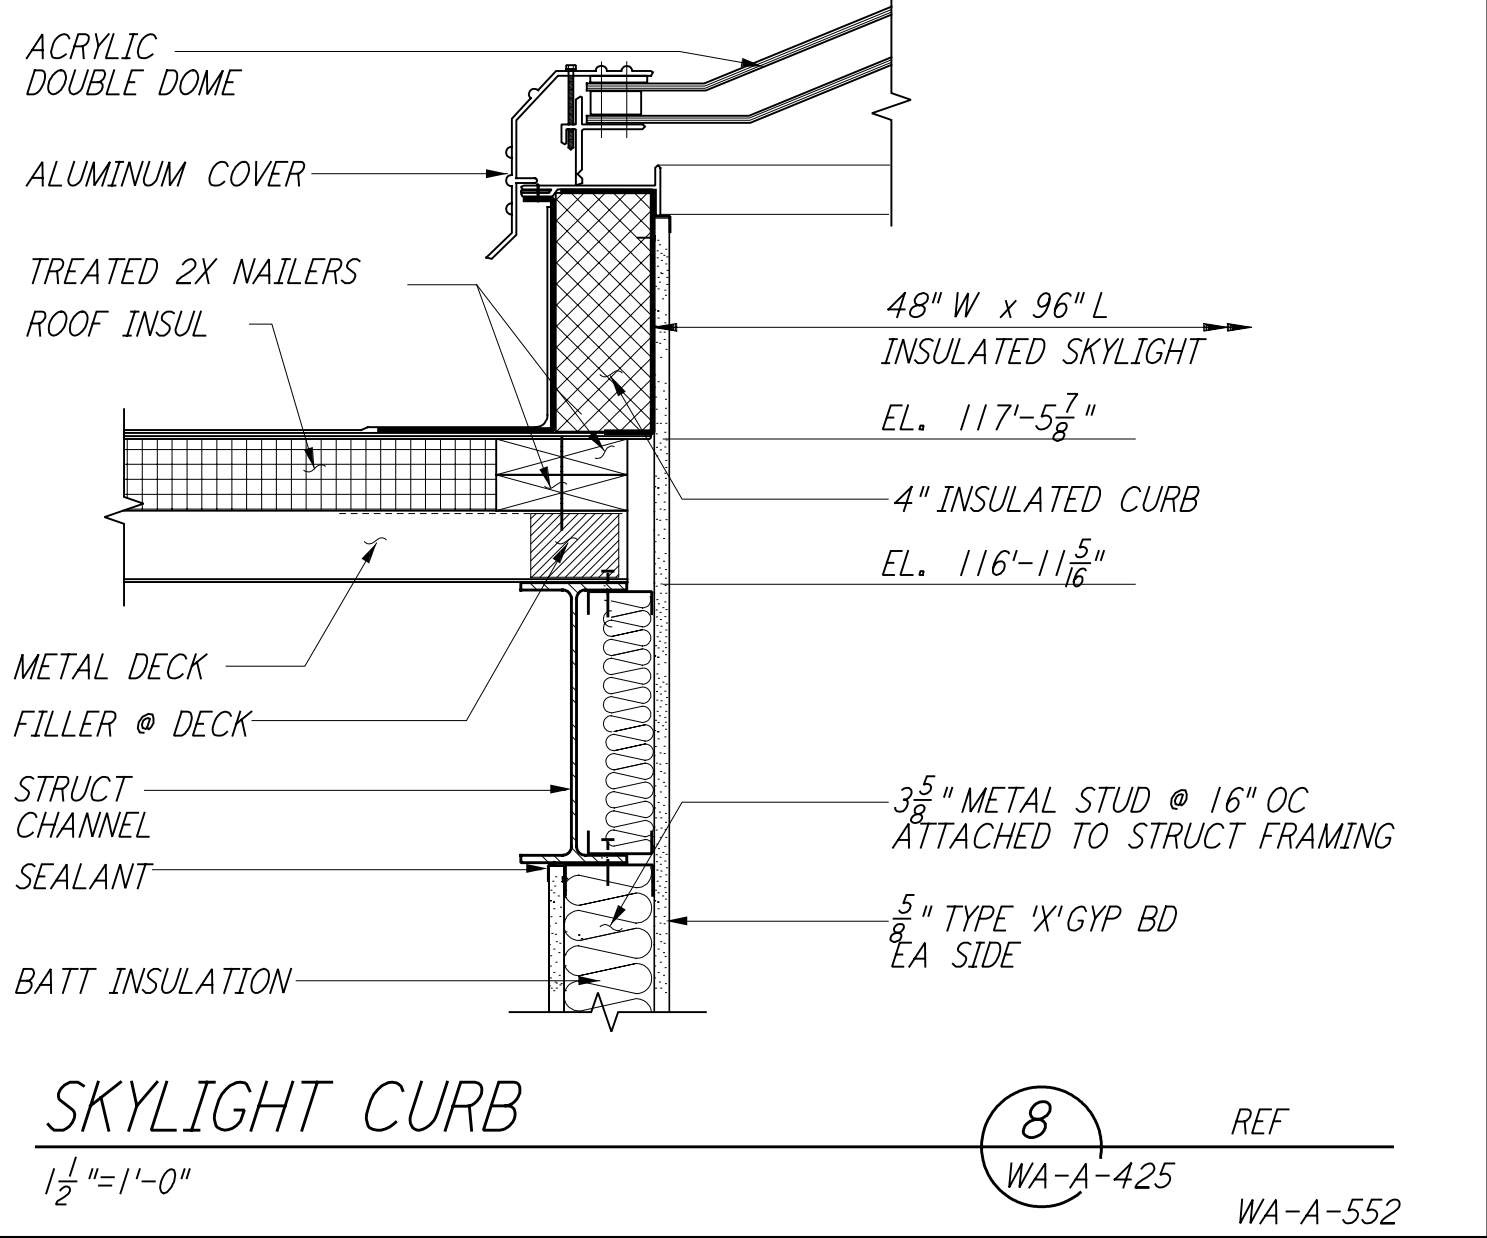


SKYLIGHT CURB
 1/2" = 1'-0"
 REF WA-A-425 WA-A-552

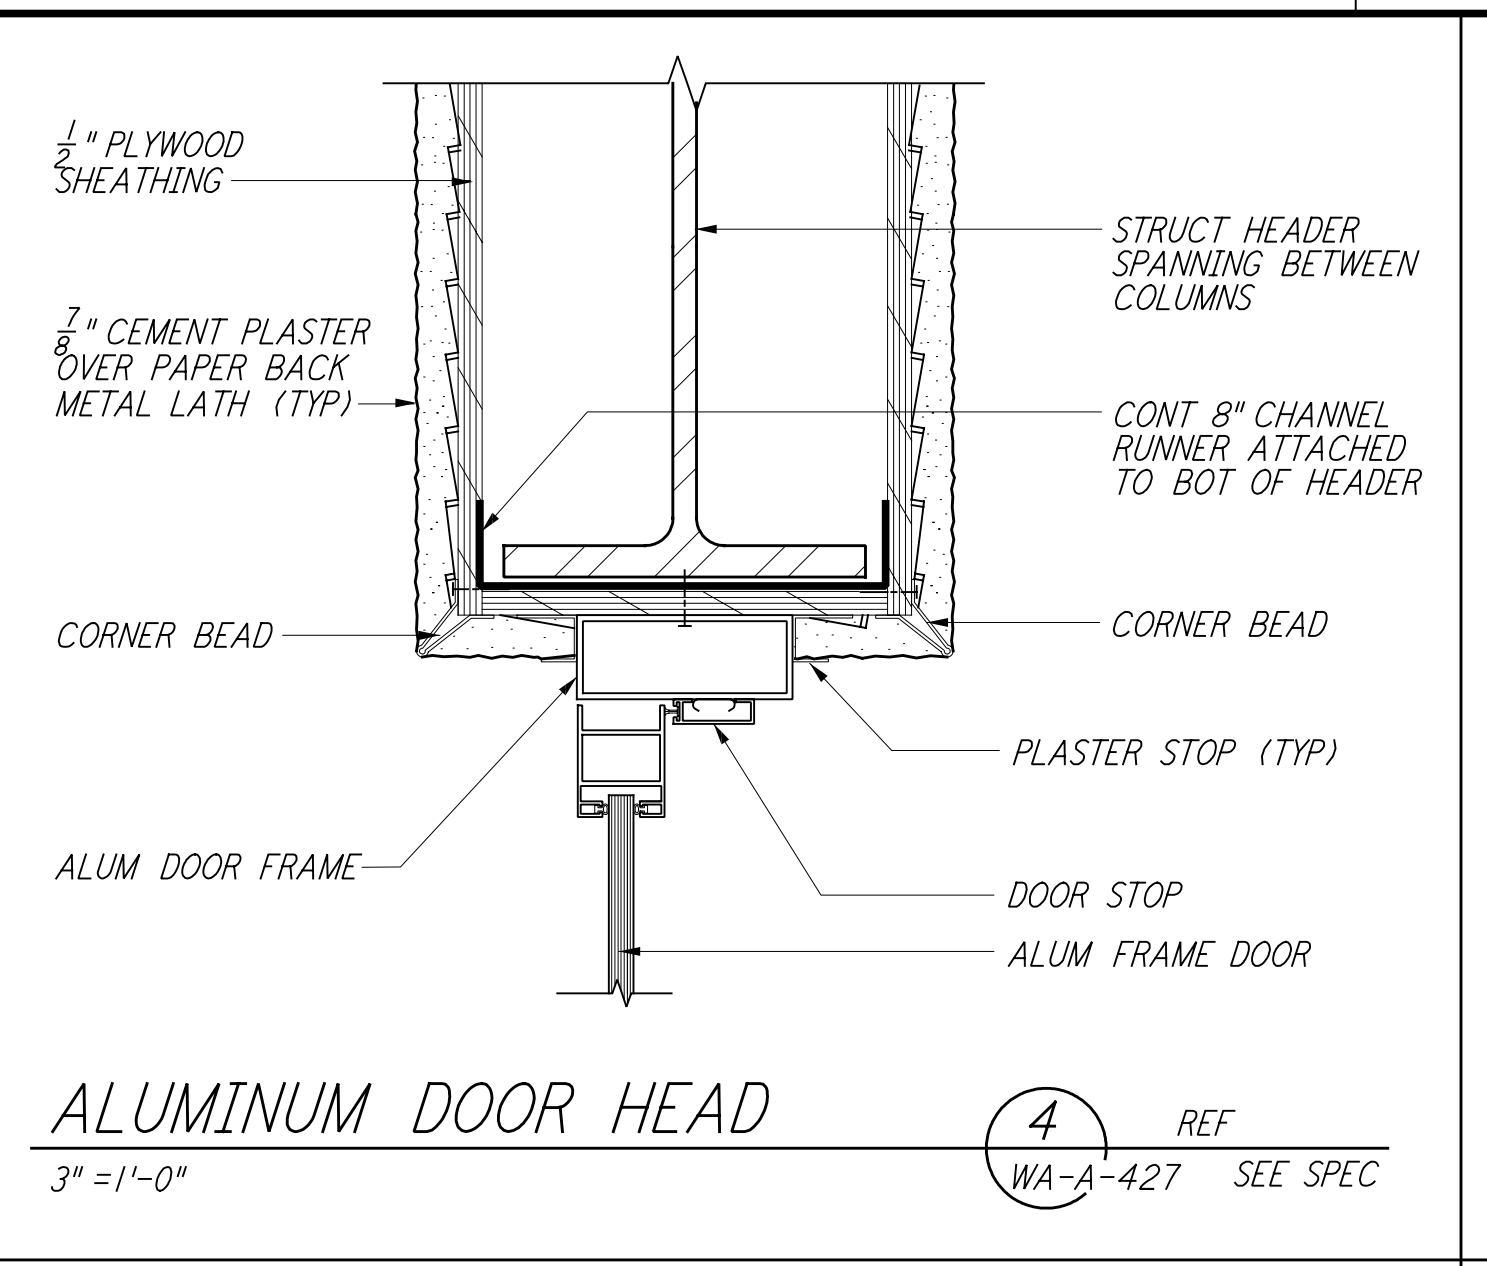


ALUMINUM DOOR HEAD
 3" = 1'-0"
 REF WA-A-427 SEE SPEC

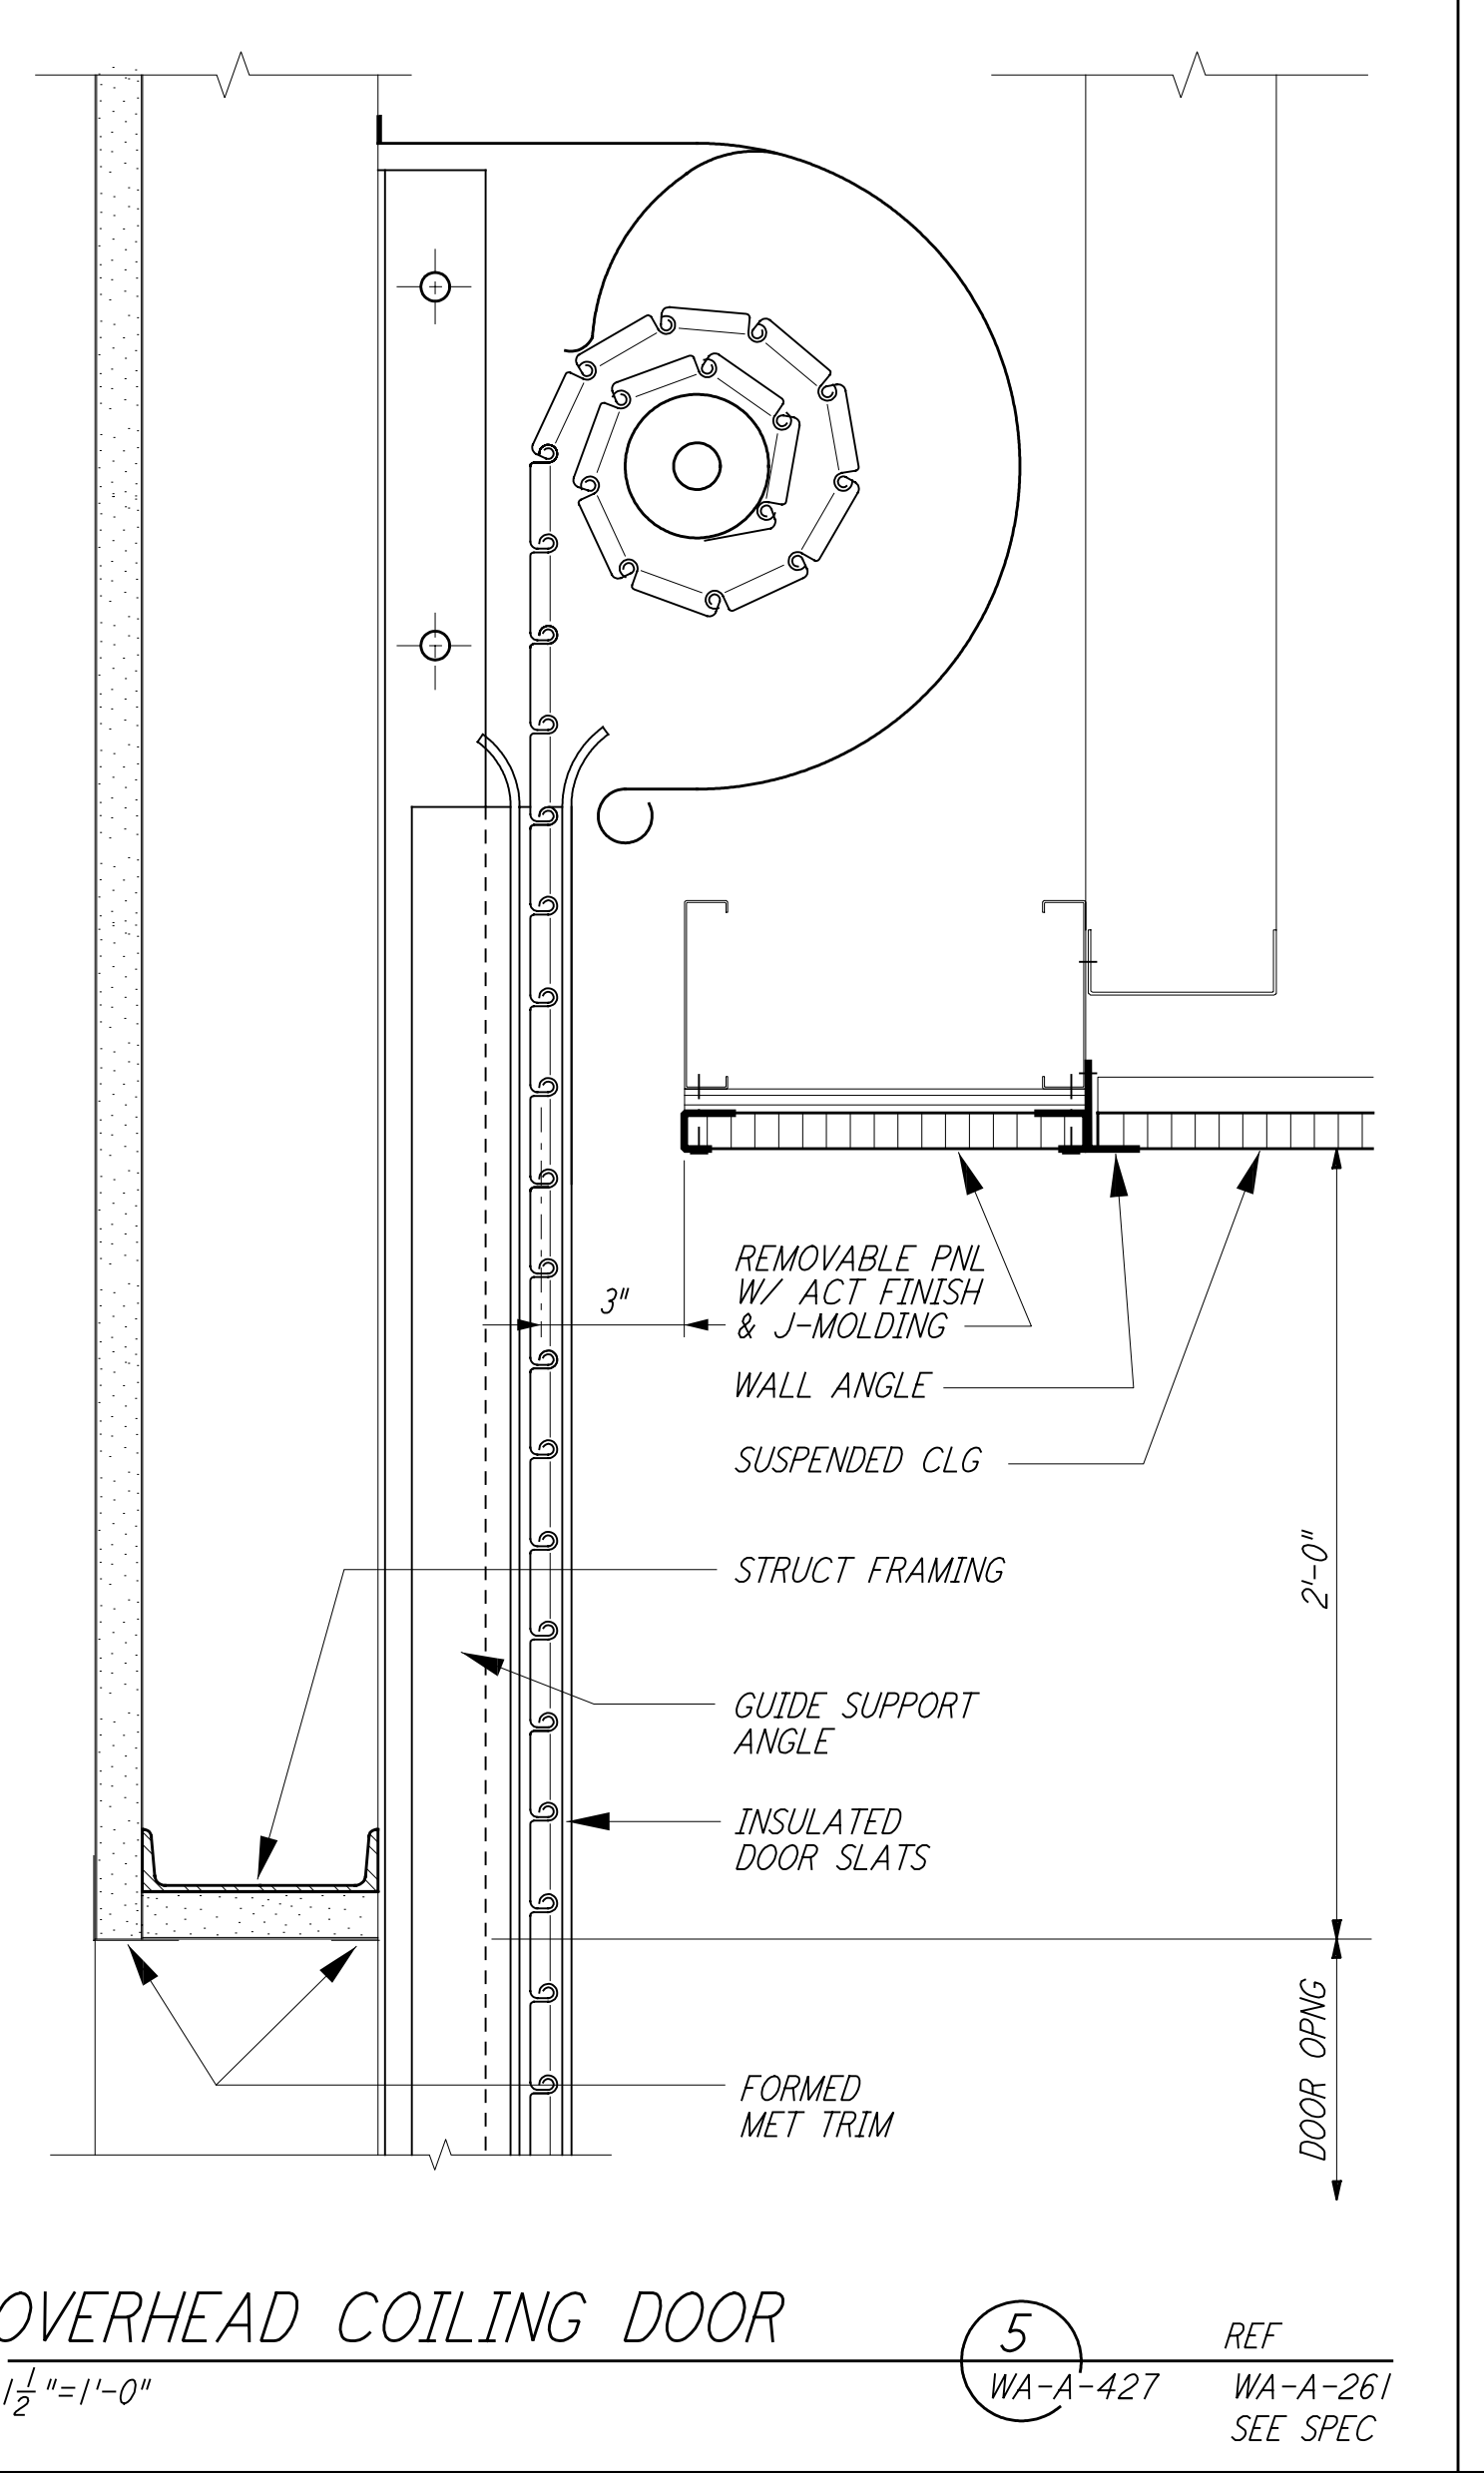


OVERHEAD COILING DOOR
 1/2" = 1'-0"
 REF WA-A-427 WA-A-261 SEE SPEC

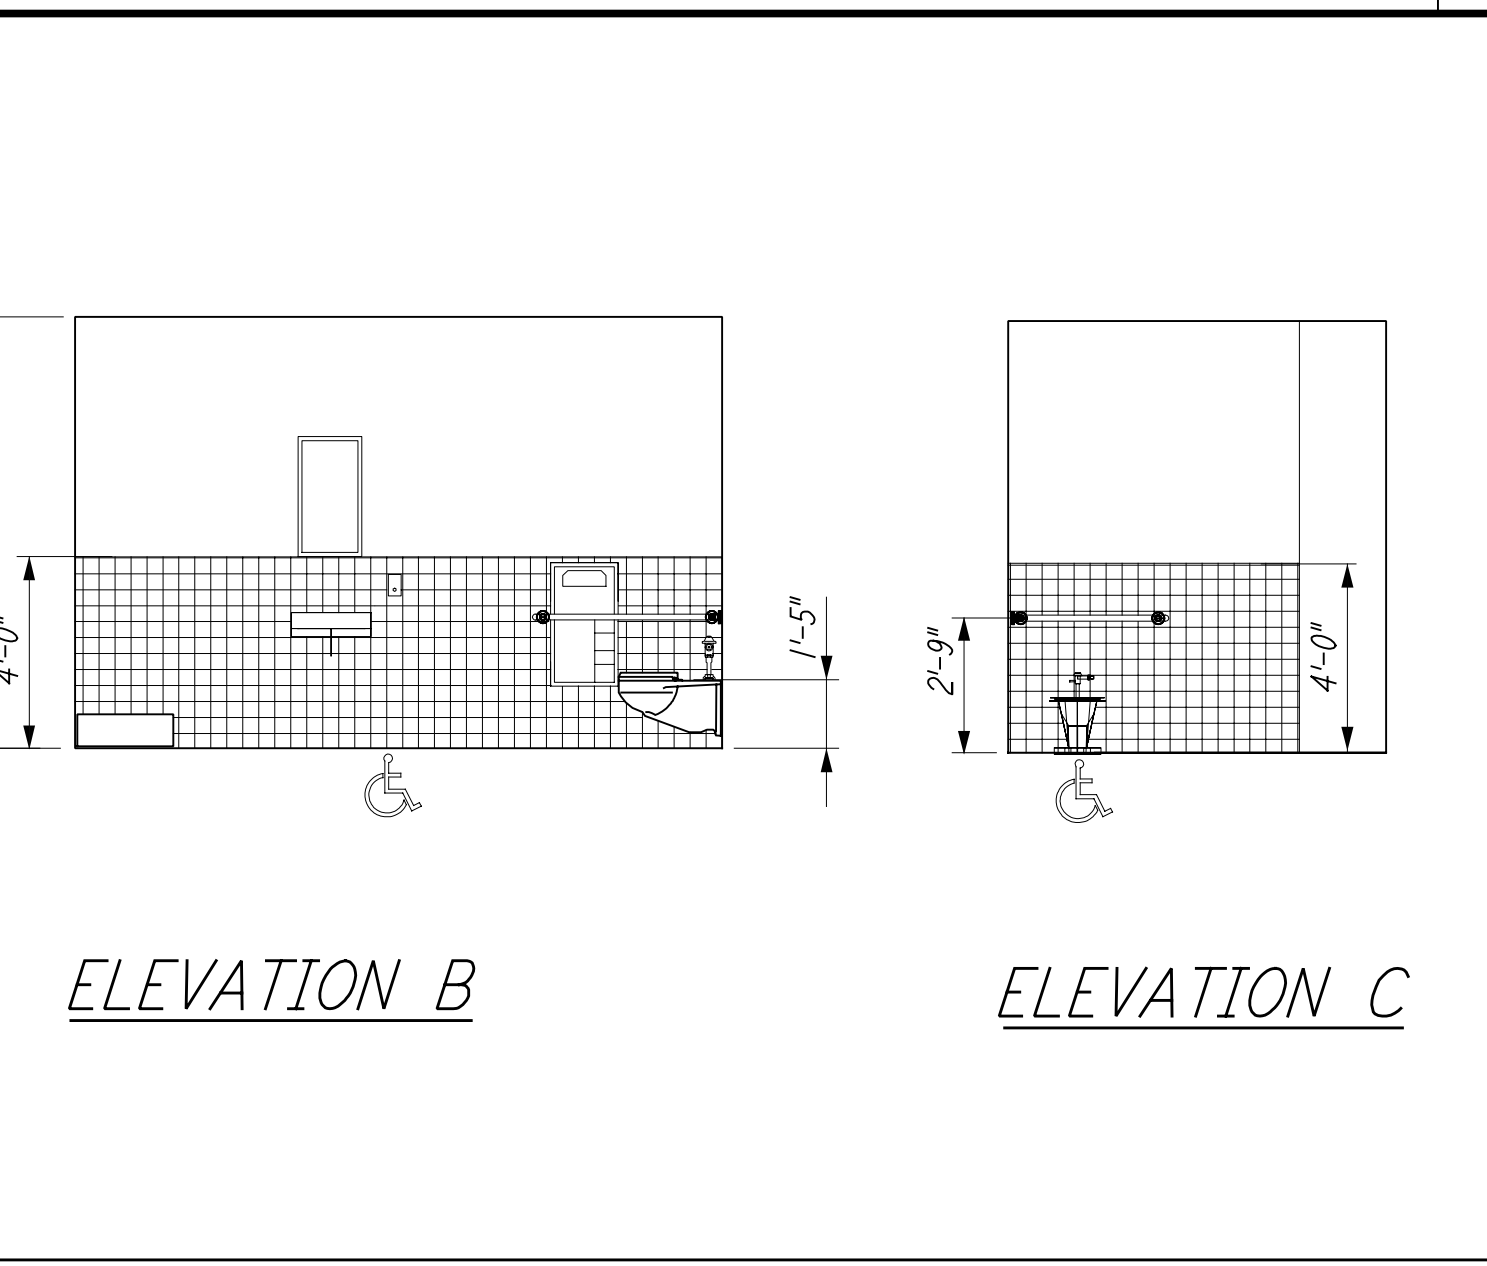


ELEVATION B **ELEVATION C**

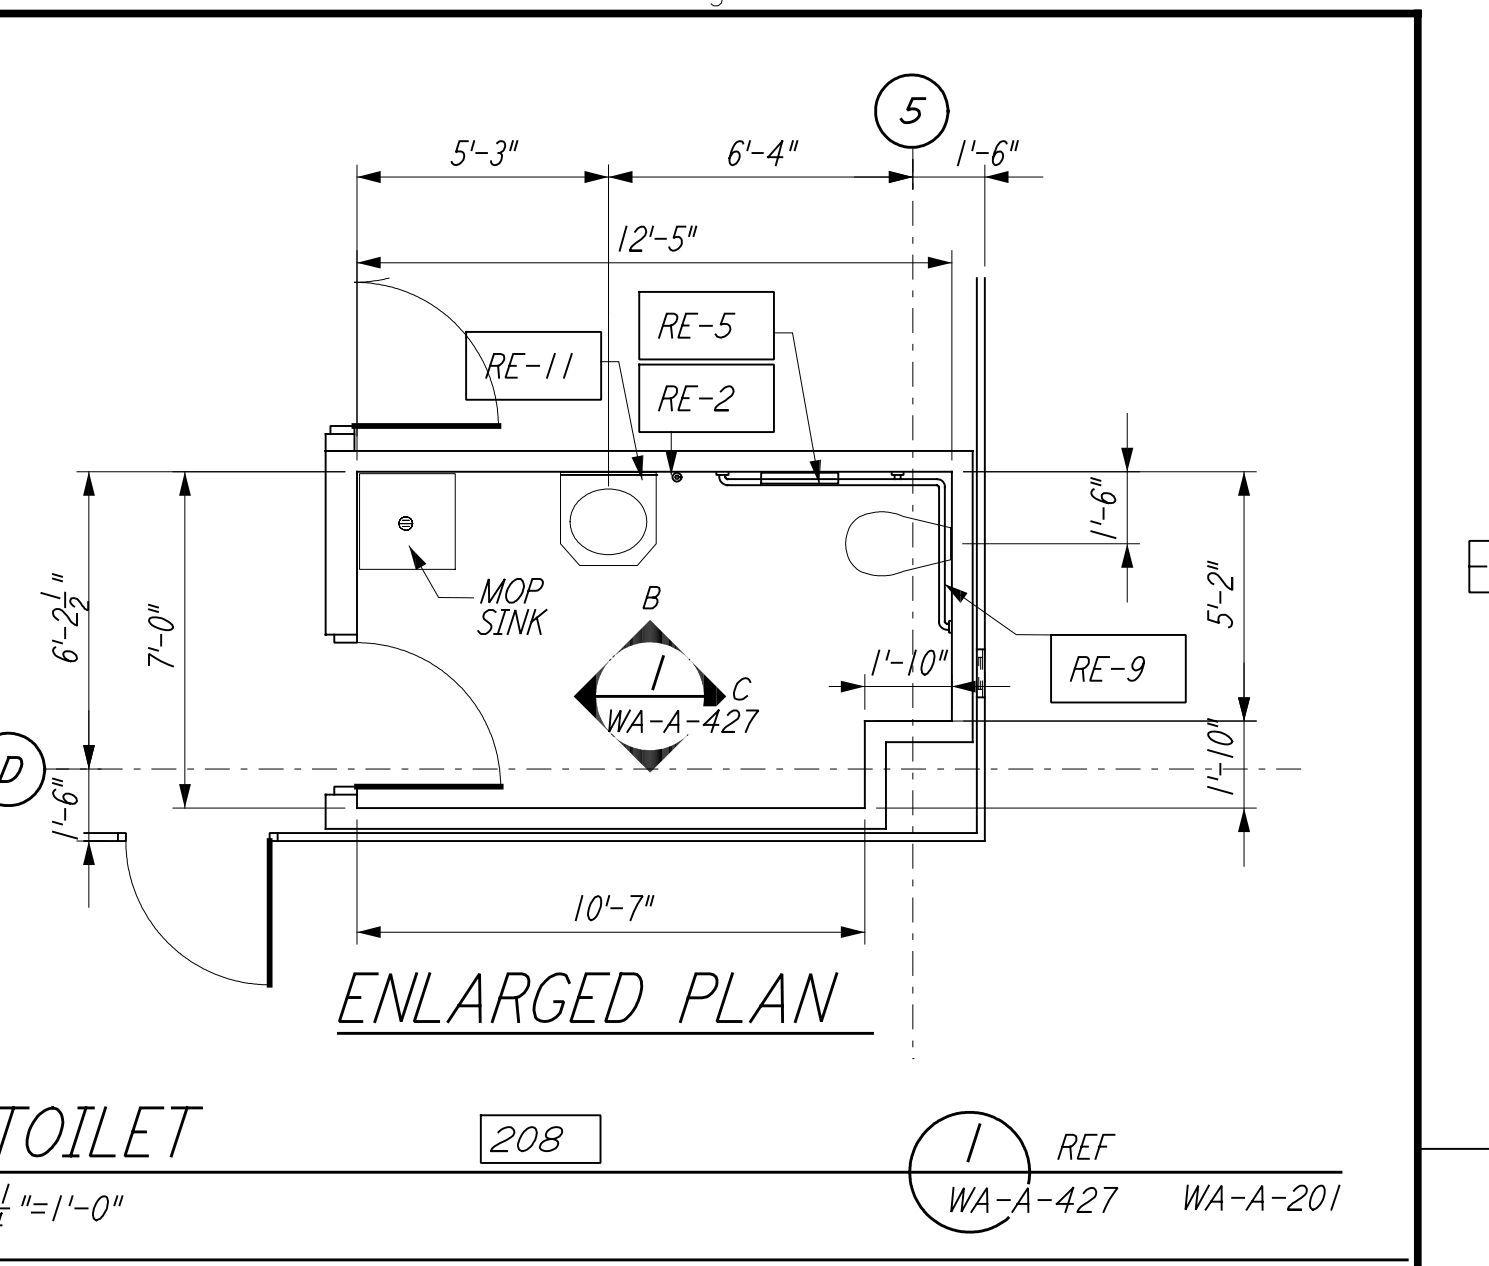


TOILET
 1/4" = 1'-0"
 REF WA-A-427 WA-A-201

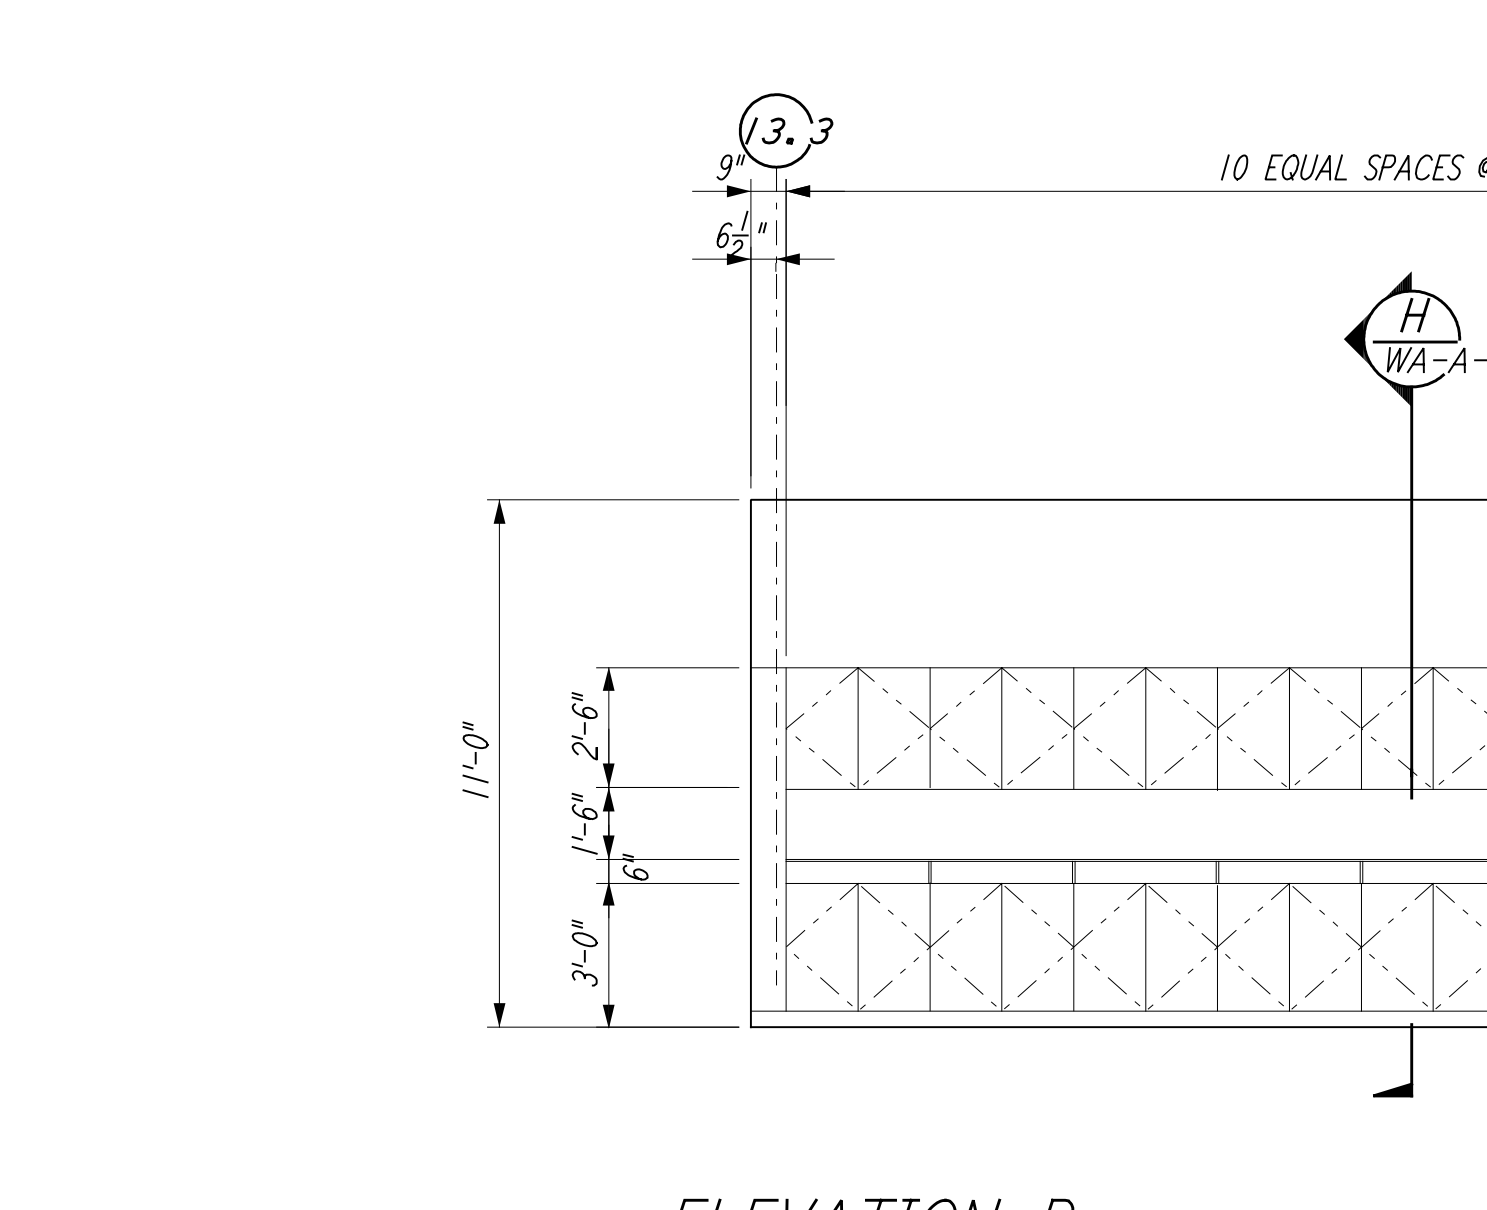


ELEVATION D

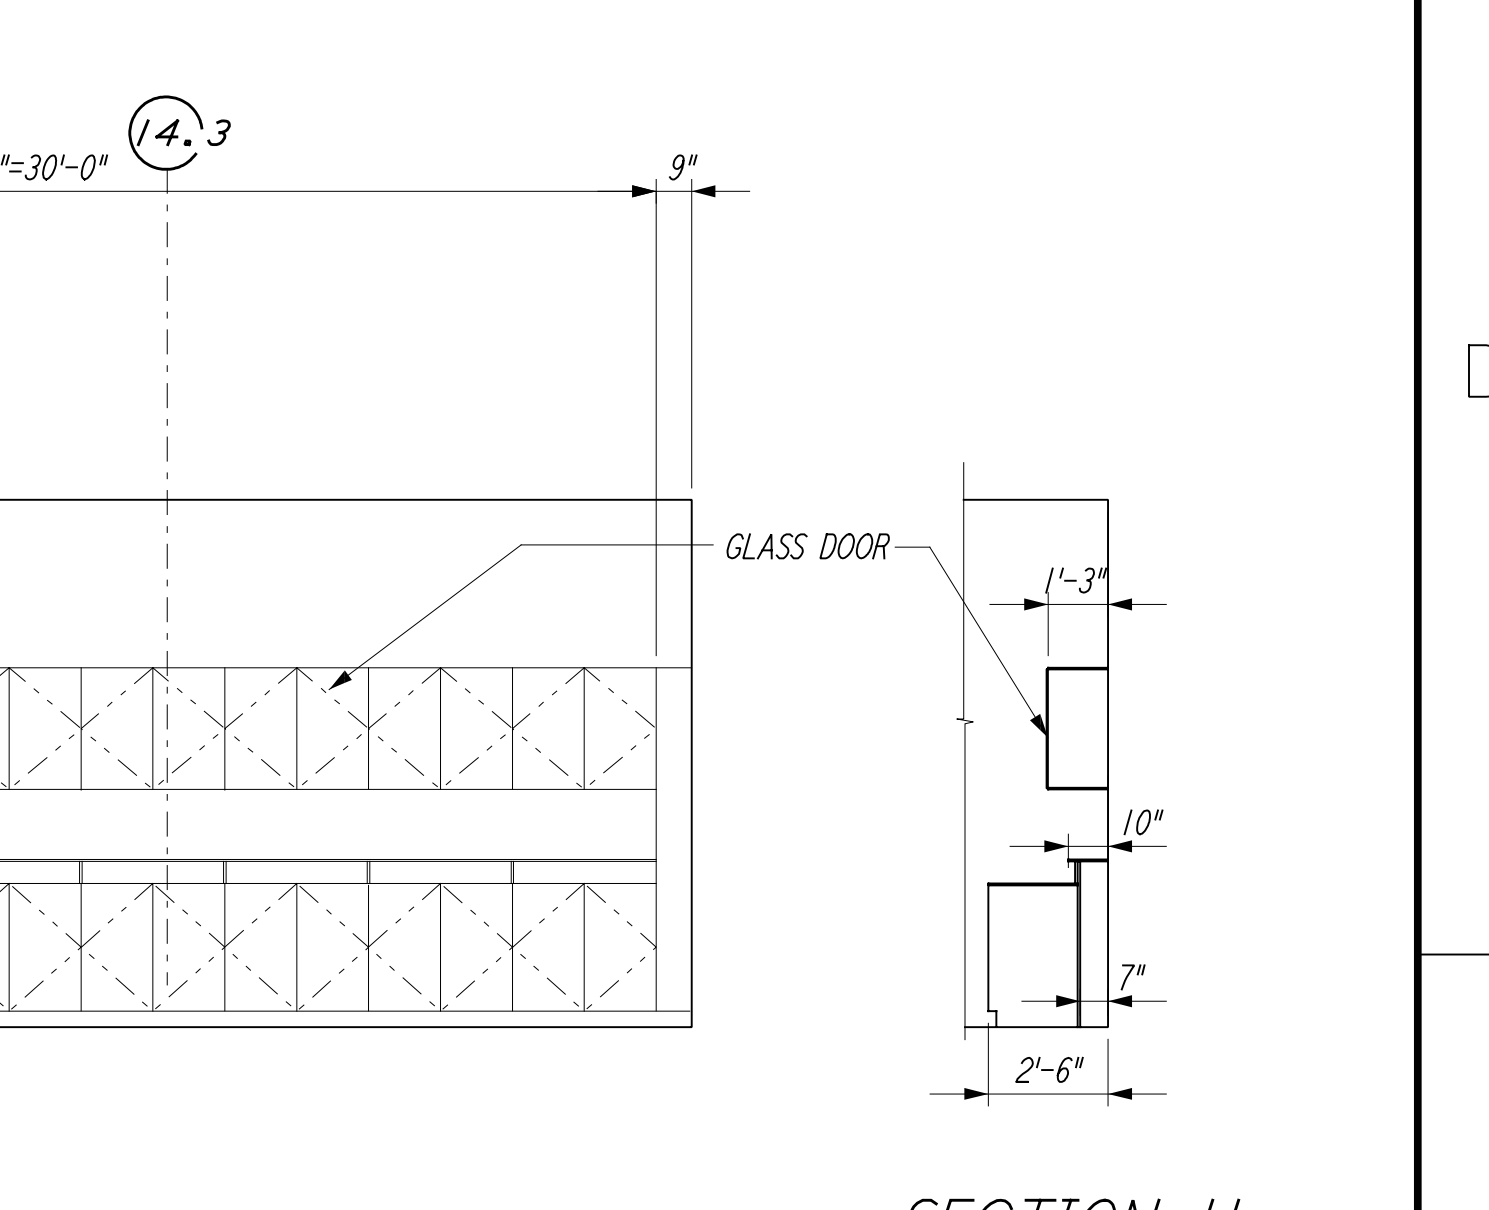


SECTION H

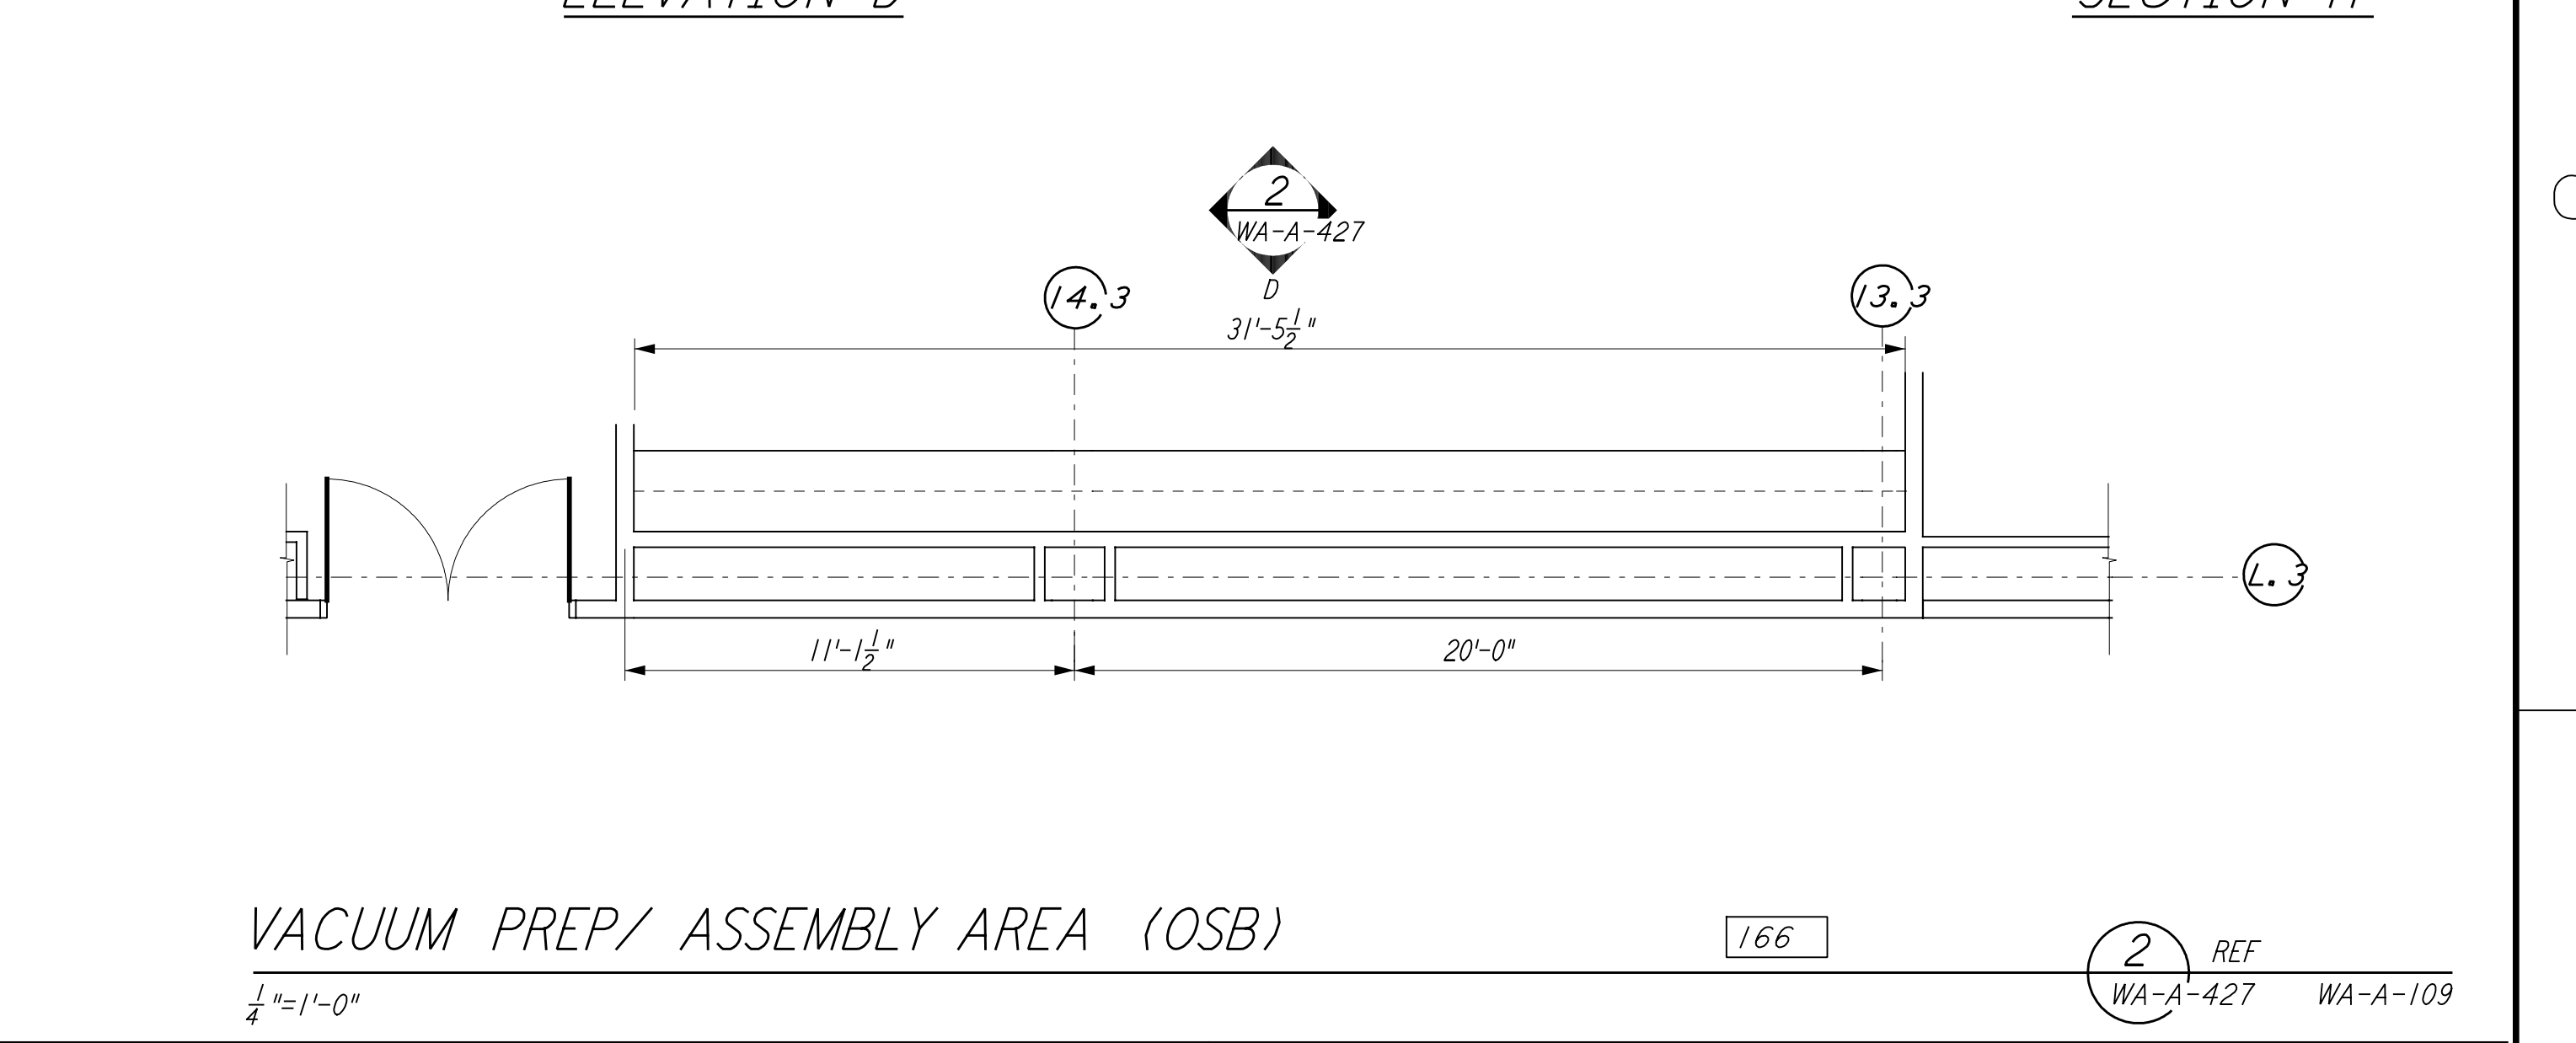

 
VACUUM PREP/ ASSEMBLY AREA (OSB)
 1/4" = 1'-0"
 REF WA-A-427 WA-A-109




CEILING EDGE @ SKYLIGHT
 1/2" = 1'-0"
 REF WA-A-425 WA-A-552

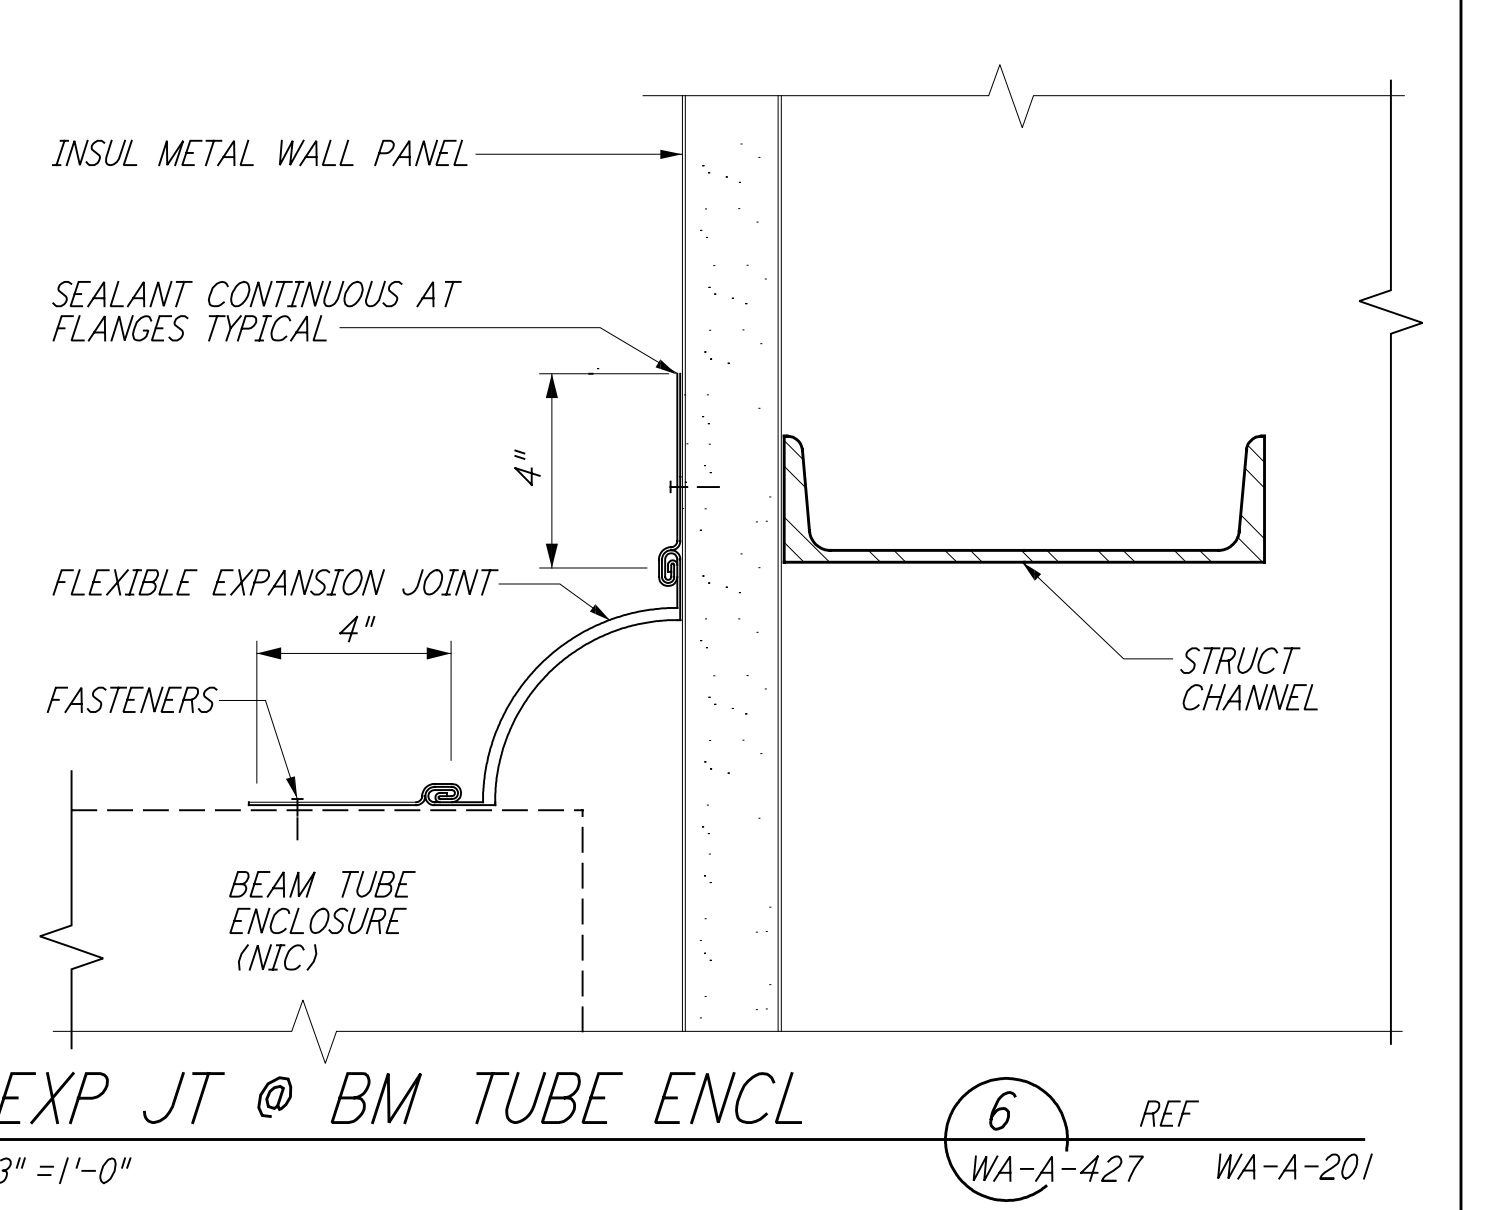

EXP JT @ BM TUBE ENCL
 3" = 1'-0"
 REF WA-A-427 WA-A-201

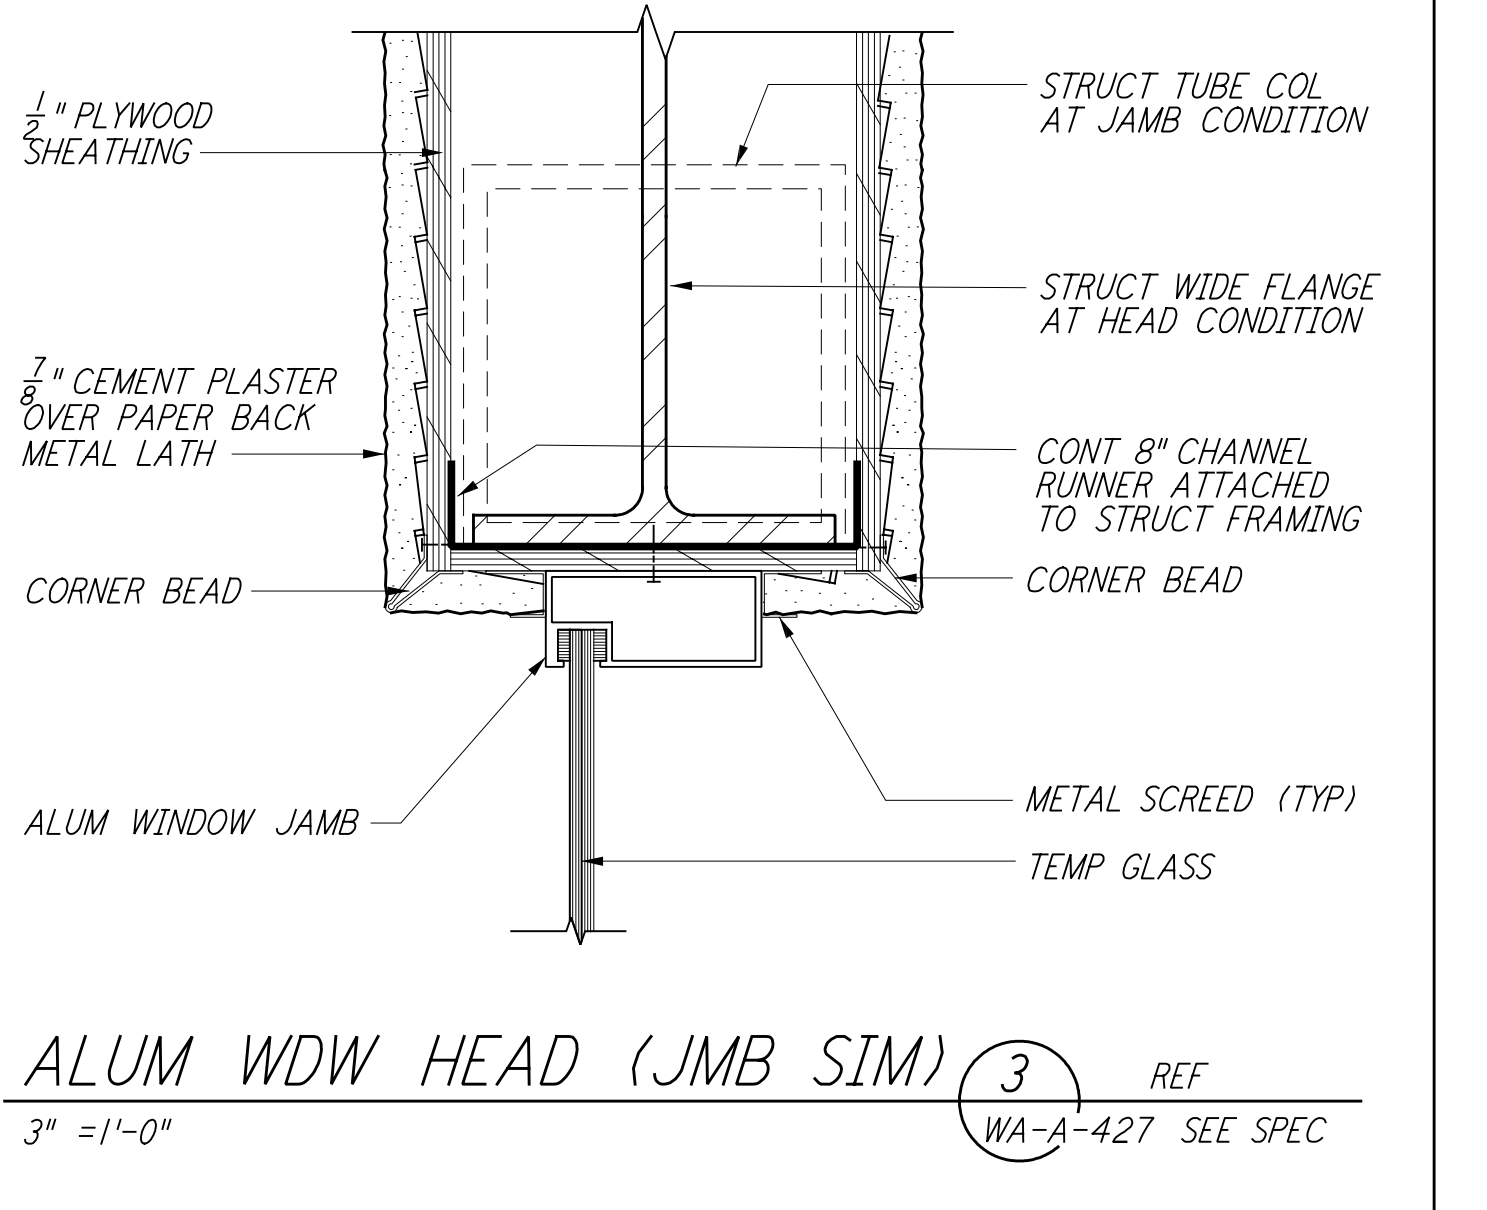

ALUM WDW HEAD (JMB SIM)
 3" = 1'-0"
 REF WA-A-427 SEE SPEC

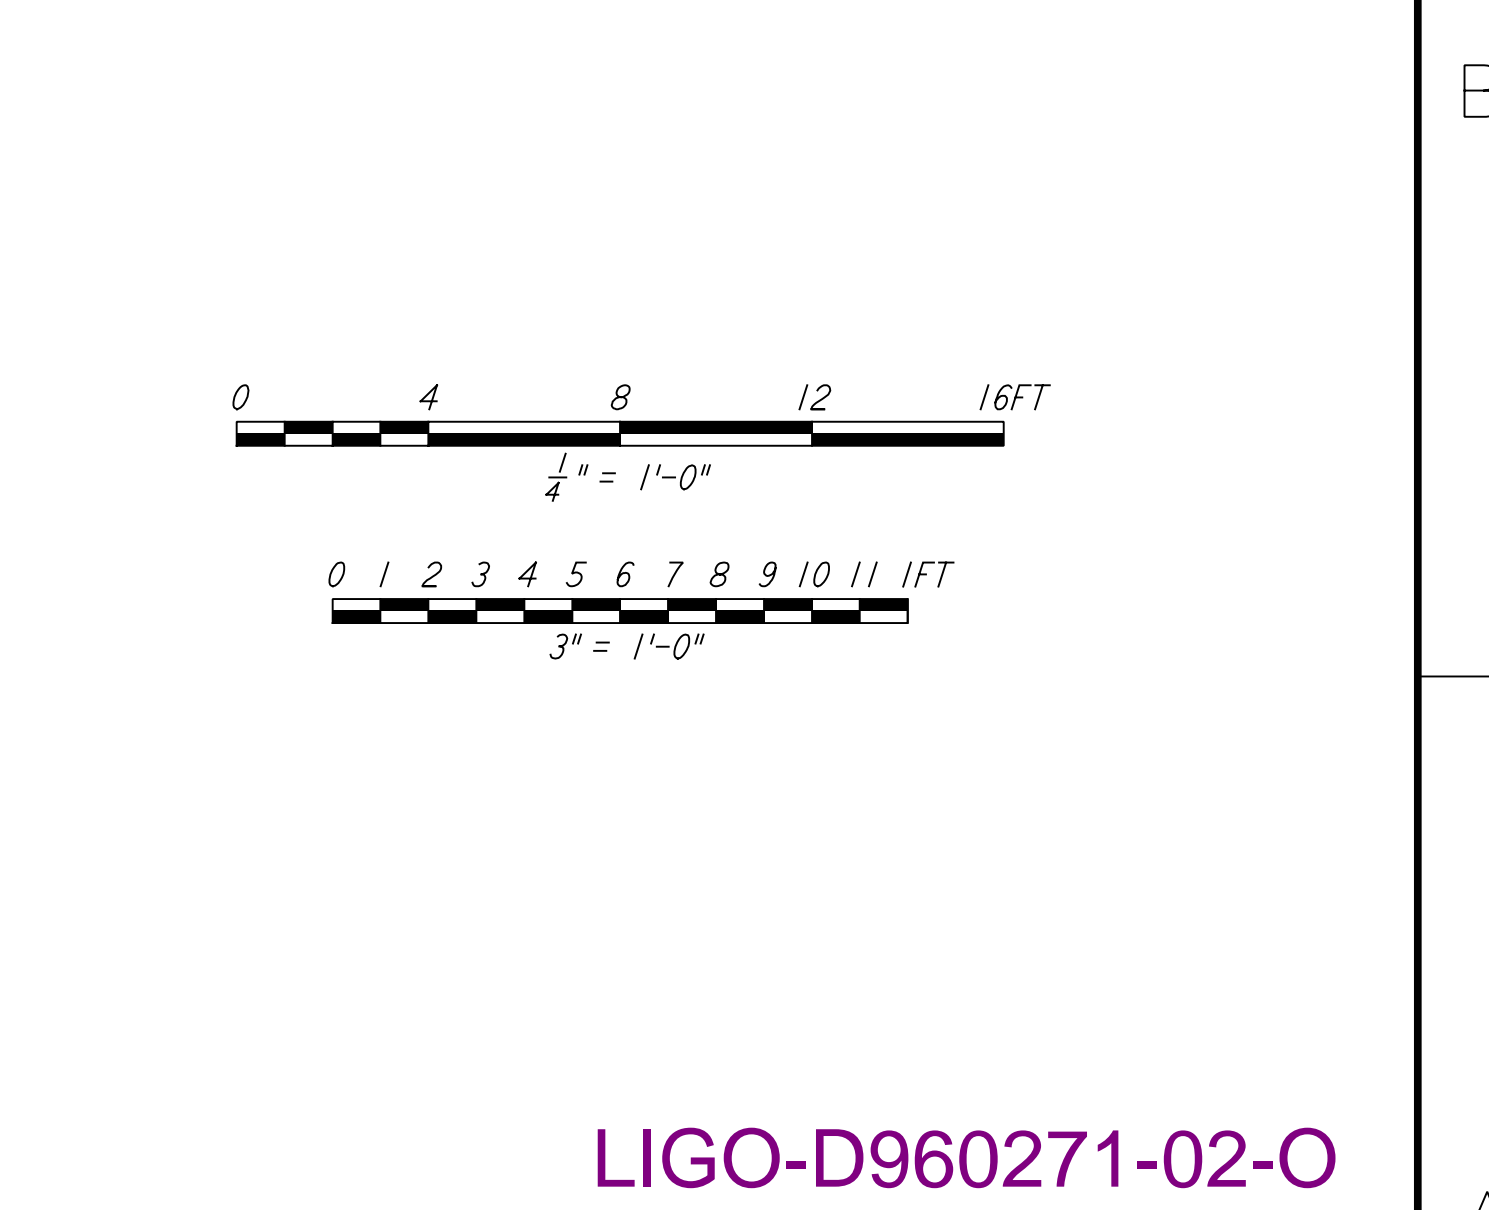

NO.	DATE	BY	CHKD	ENGR	PROJ	DESCRIPTION
1	2-28-97	CKT	TB	AK	TDM	ISSUED FOR AS-BUILT OSB REVISION
2	5-15-98	CKT				ISSUED FOR CONSTRUCTION

NO.	DATE	BY	CHKD	ENGR	PROJ	DESCRIPTION
1	2-28-97	CKT	TB	AK	TDM	ISSUED FOR AS-BUILT OSB REVISION
2	5-15-98	CKT				ISSUED FOR CONSTRUCTION

AS-BUILT DRAWINGS

NO.	DATE	BY	CHKD	ENGR	PROJ	DESCRIPTION
1	2-28-97	CKT	TB	AK	TDM	ISSUED FOR AS-BUILT OSB REVISION
2	5-15-98	CKT				ISSUED FOR CONSTRUCTION

PARSONS
 100 WEST WALNUT STREET
 PASADENA, CALIFORNIA

LIGO
 CALIFORNIA INSTITUTE OF TECHNOLOGY
 MASSACHUSETTS INSTITUTE OF TECHNOLOGY

LIGO-D960271-02-0

LASER INTERFEROMETER
 GRAVITATIONAL-WAVE OBSERVATORY
 SITE NO. 1 - HANFORD, WASHINGTON

SCALE: 1/4" = 1'-0"
 SHEET NUMBER: **WA-A-427**

AS NOTED PPI50969 8094