



This document and the design it covers are the property of PARSONS. They are loaned only with the borrower's expressed written agreement that they will not be reproduced, copied, loaned, exhibited, or used in any other way, except by written consent from PARSONS to the borrower.

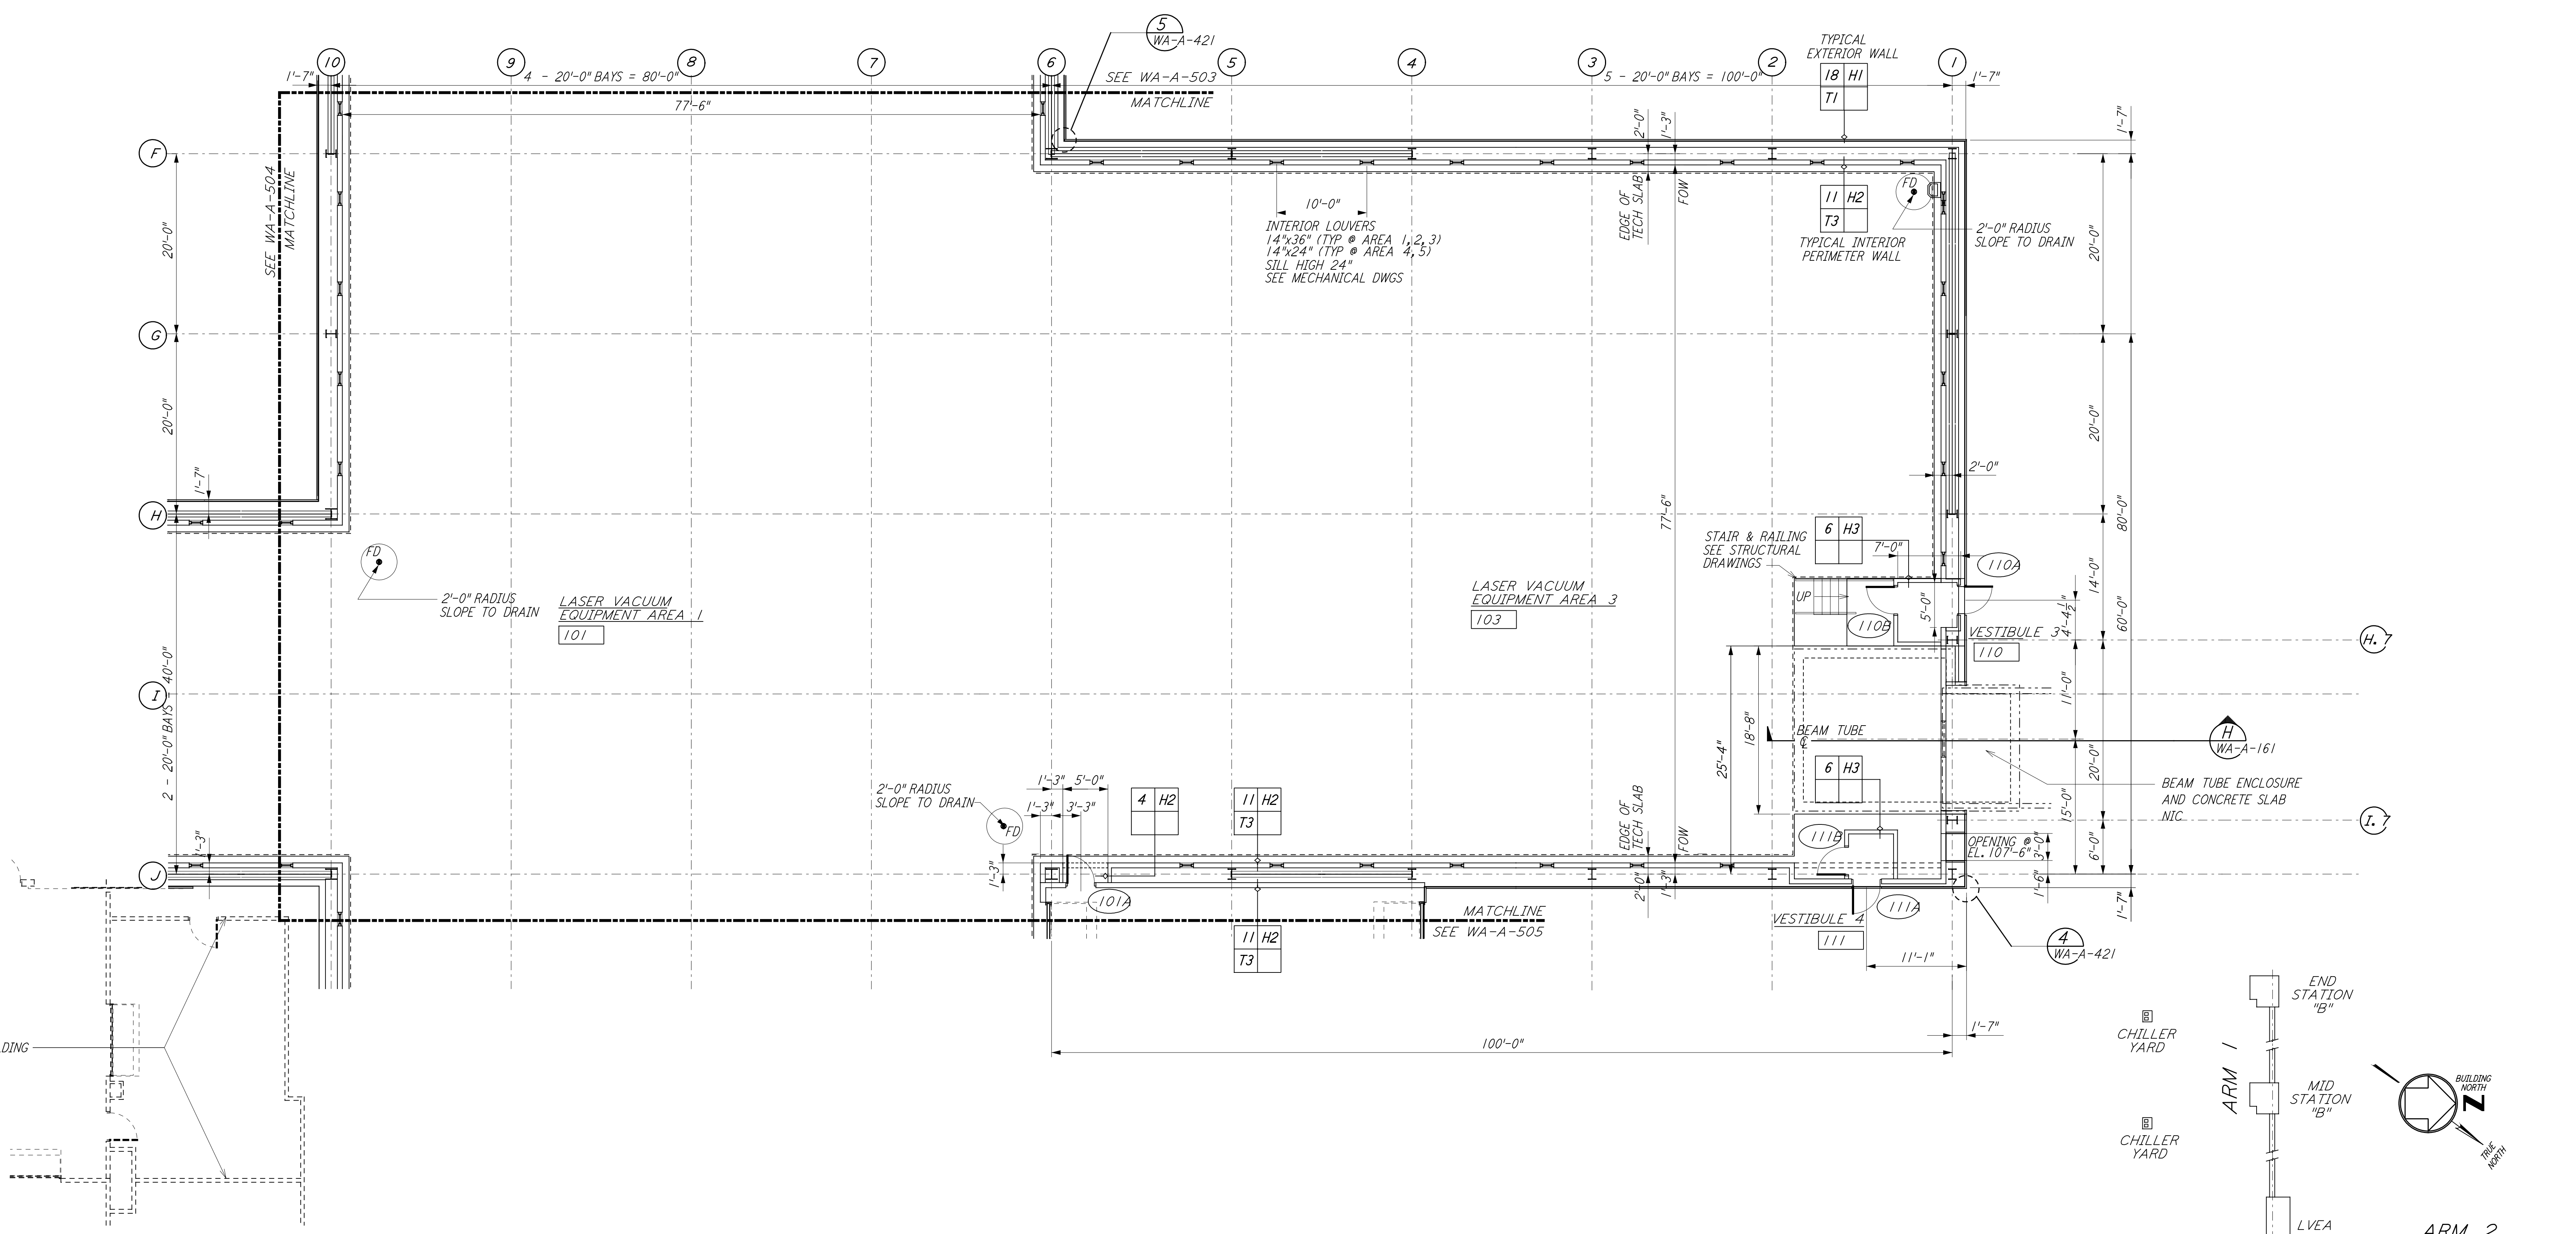

LINE OF OPERATIONAL SUPPORT BUILDING
 SEE SHEET WA-A-109

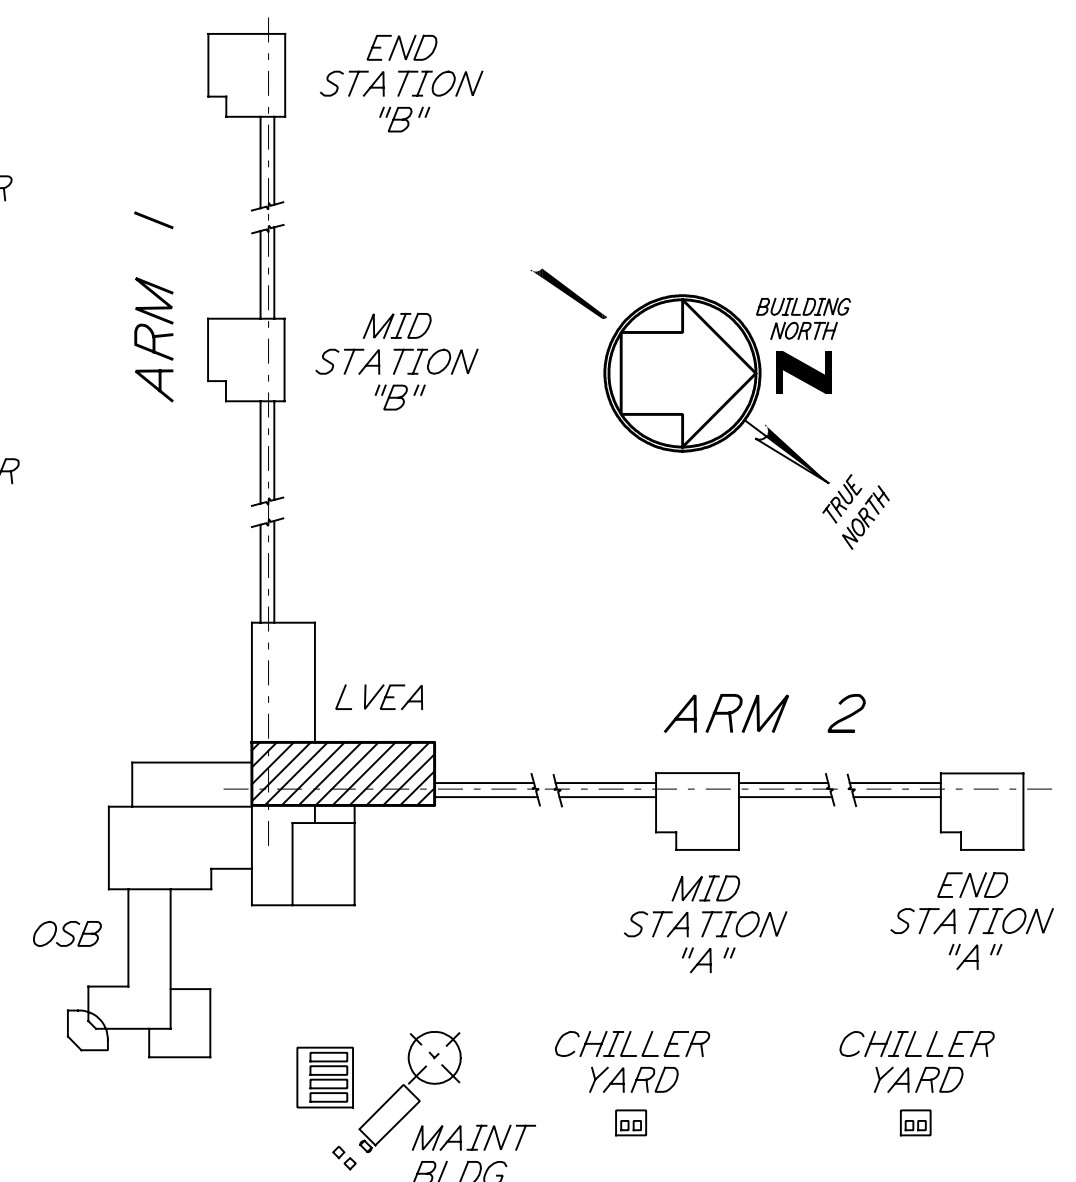

0 8 16 24 32 FT
 1/8" = 1'-0"
 DATUM POINT EL +100.00 = 531.11' (LVEA)
 DATUM POINT EL +100.00 = 531.11' (OSB)

KEY PLAN

| NO. | DATE | BY | CHKD | ENGR | PROJ | DESCRIPTION |
|-----|---------|-----|------|------|------|---------------------|
| 1 | 5-15-98 | CKT | | | | ISSUED FOR AS-BUILT |

| | |
|--------------------------|----------------|
| ISSUED FOR CONSTRUCTION | |
| DRAWN | CKT/DS 5-12-96 |
| CHECKED | TB 5-26-96 |
| ENGINEER | bkk 7-12-96 |
| PROJ | MDW 7-12-96 |
| AS-BUILT DRAWINGS | |



**LASER INTERFEROMETER
 GRAVITATIONAL-WAVE OBSERVATORY
 SITE NO. 1 - HANFORD, WASHINGTON**

| | | | | | |
|--------------|--|-----------|----------|----------------|---------------|
| TITLE | ARCHITECTURAL CORNER STATION LVEA PARTIAL FLOOR PLAN SHEET 1 | SCALE | AS NOTED | PROJECT NUMBER | PP150969 8094 |
| SHEET NUMBER | WA-A-502 | REVISIONS | | | |