
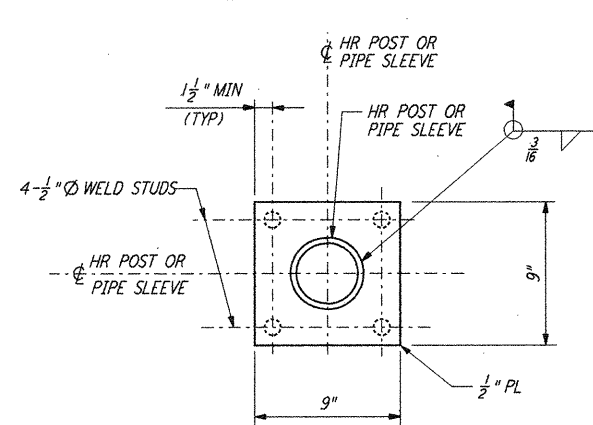
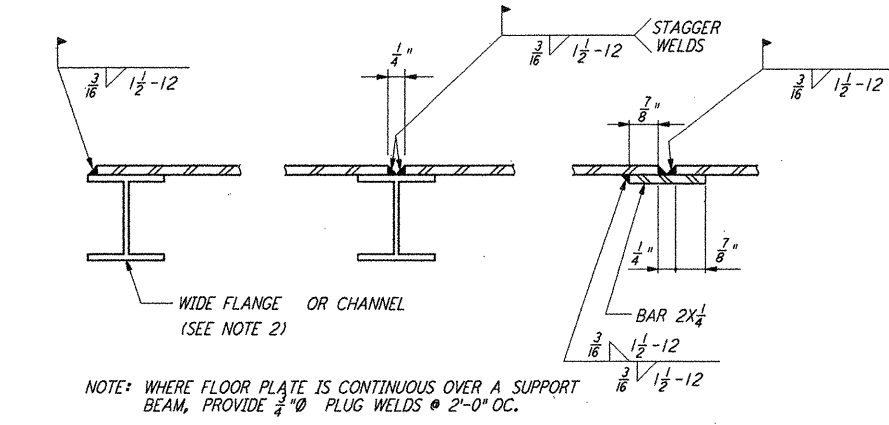
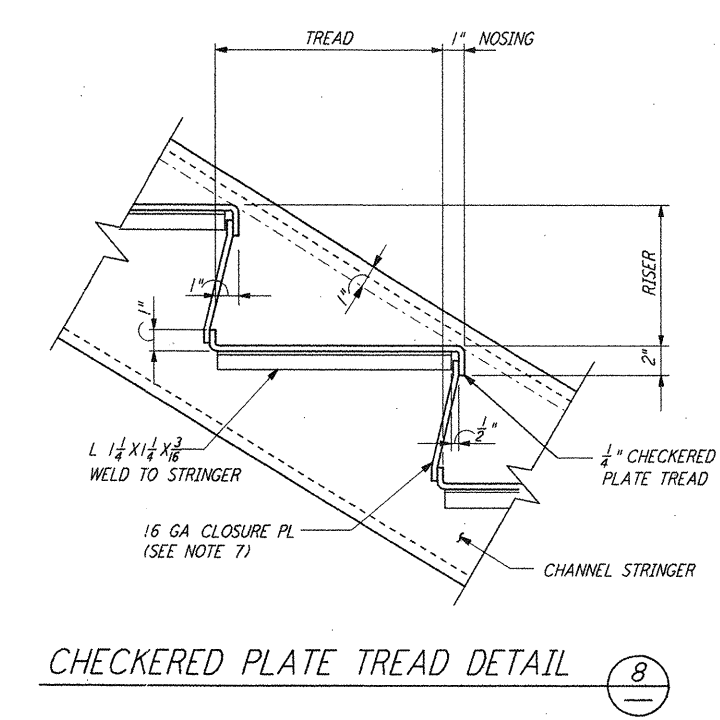
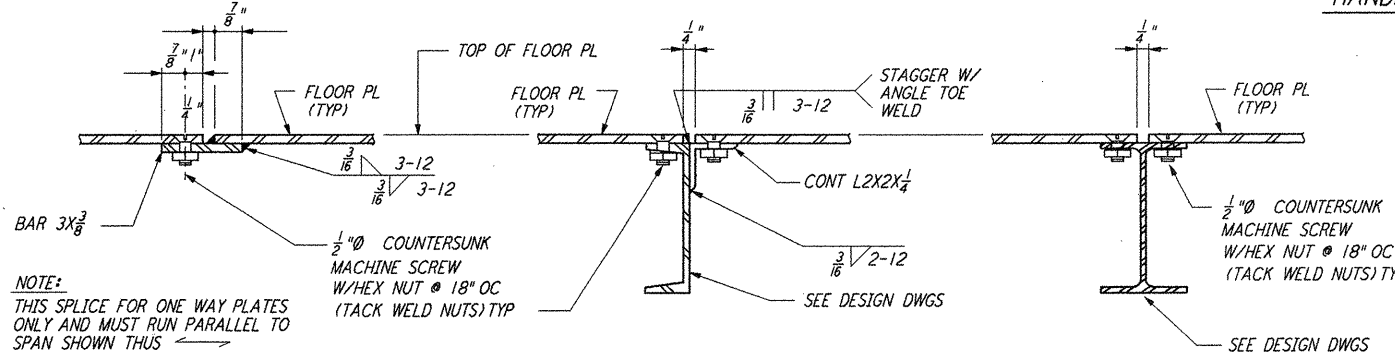
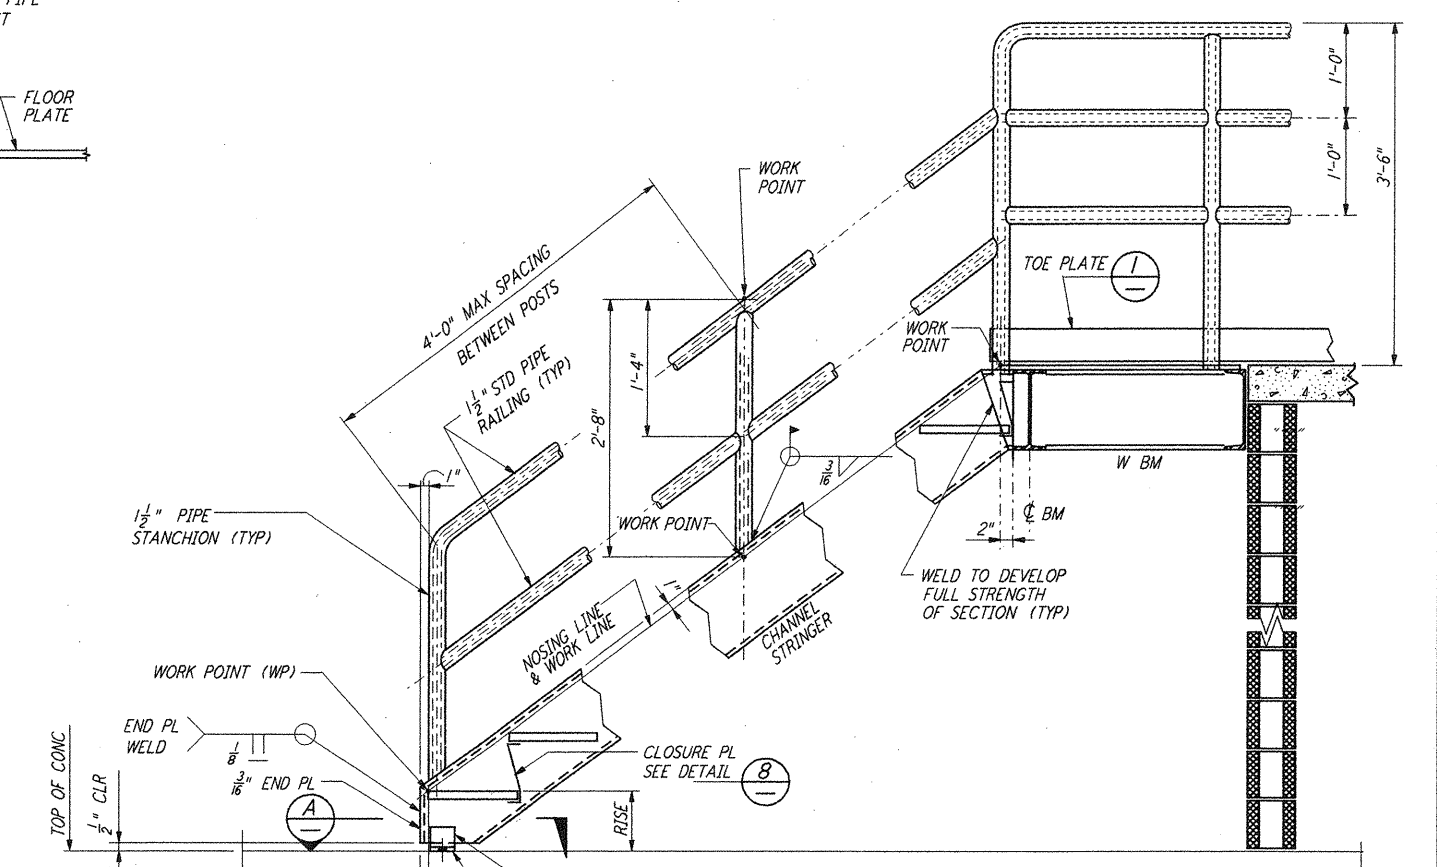
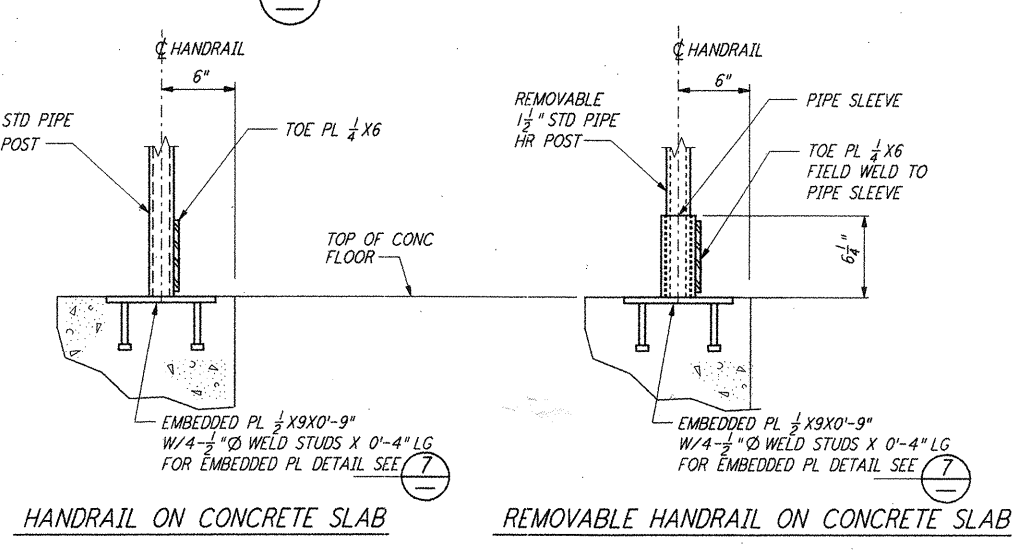
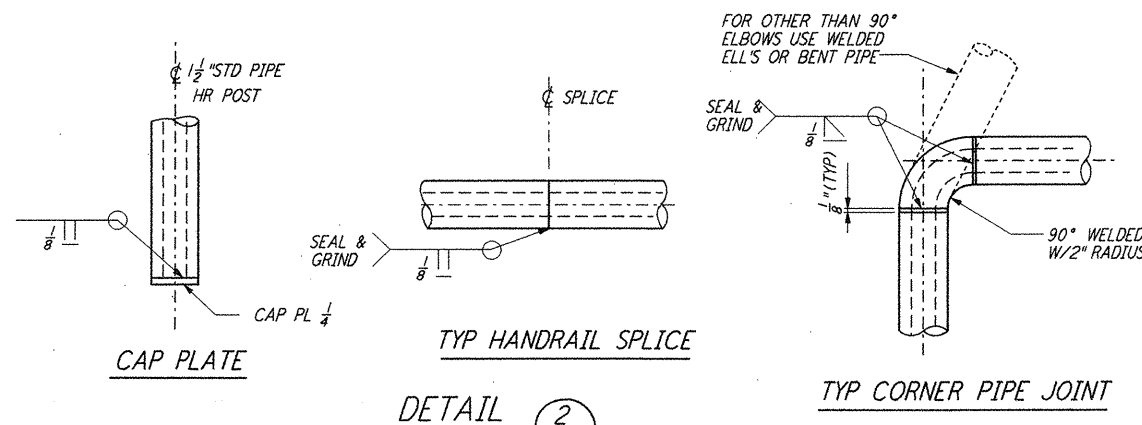


- NOTES:**
- FOR GENERAL NOTES, ABBREVIATIONS AND LEGEND SEE DRAWING WA-S-001.
 - SEE DESIGN DRAWINGS FOR STRUCTURAL MEMBER SIZE AND DIMENSIONS.
 - ALL EXPOSED SHARP EDGES AND CORNERS SHALL BE GROUND SMOOTH.
 - GALVANIZED MEMBER TO BE FIELD WELDED SHALL BE LEFT UNGALVANIZED A DISTANCE OF ONE INCH FROM AREA OF WELDING. THESE AREAS SHALL BE PAINTED WITH GALVANIZE COATING AFTER WELDING.
 - SHOP-WELDED HANDRAIL SECTIONS SHALL NOT EXCEED 20'-0" IN LENGTH.
 - ALL MISCELLANEOUS STEEL SHOWN ON THIS DRAWING SHALL BE GALVANIZED UNLESS OTHERWISE NOTED ON DESIGN DRAWINGS.
 - PROVIDE CLOSURE PL BETWEEN STAIR TREADS.

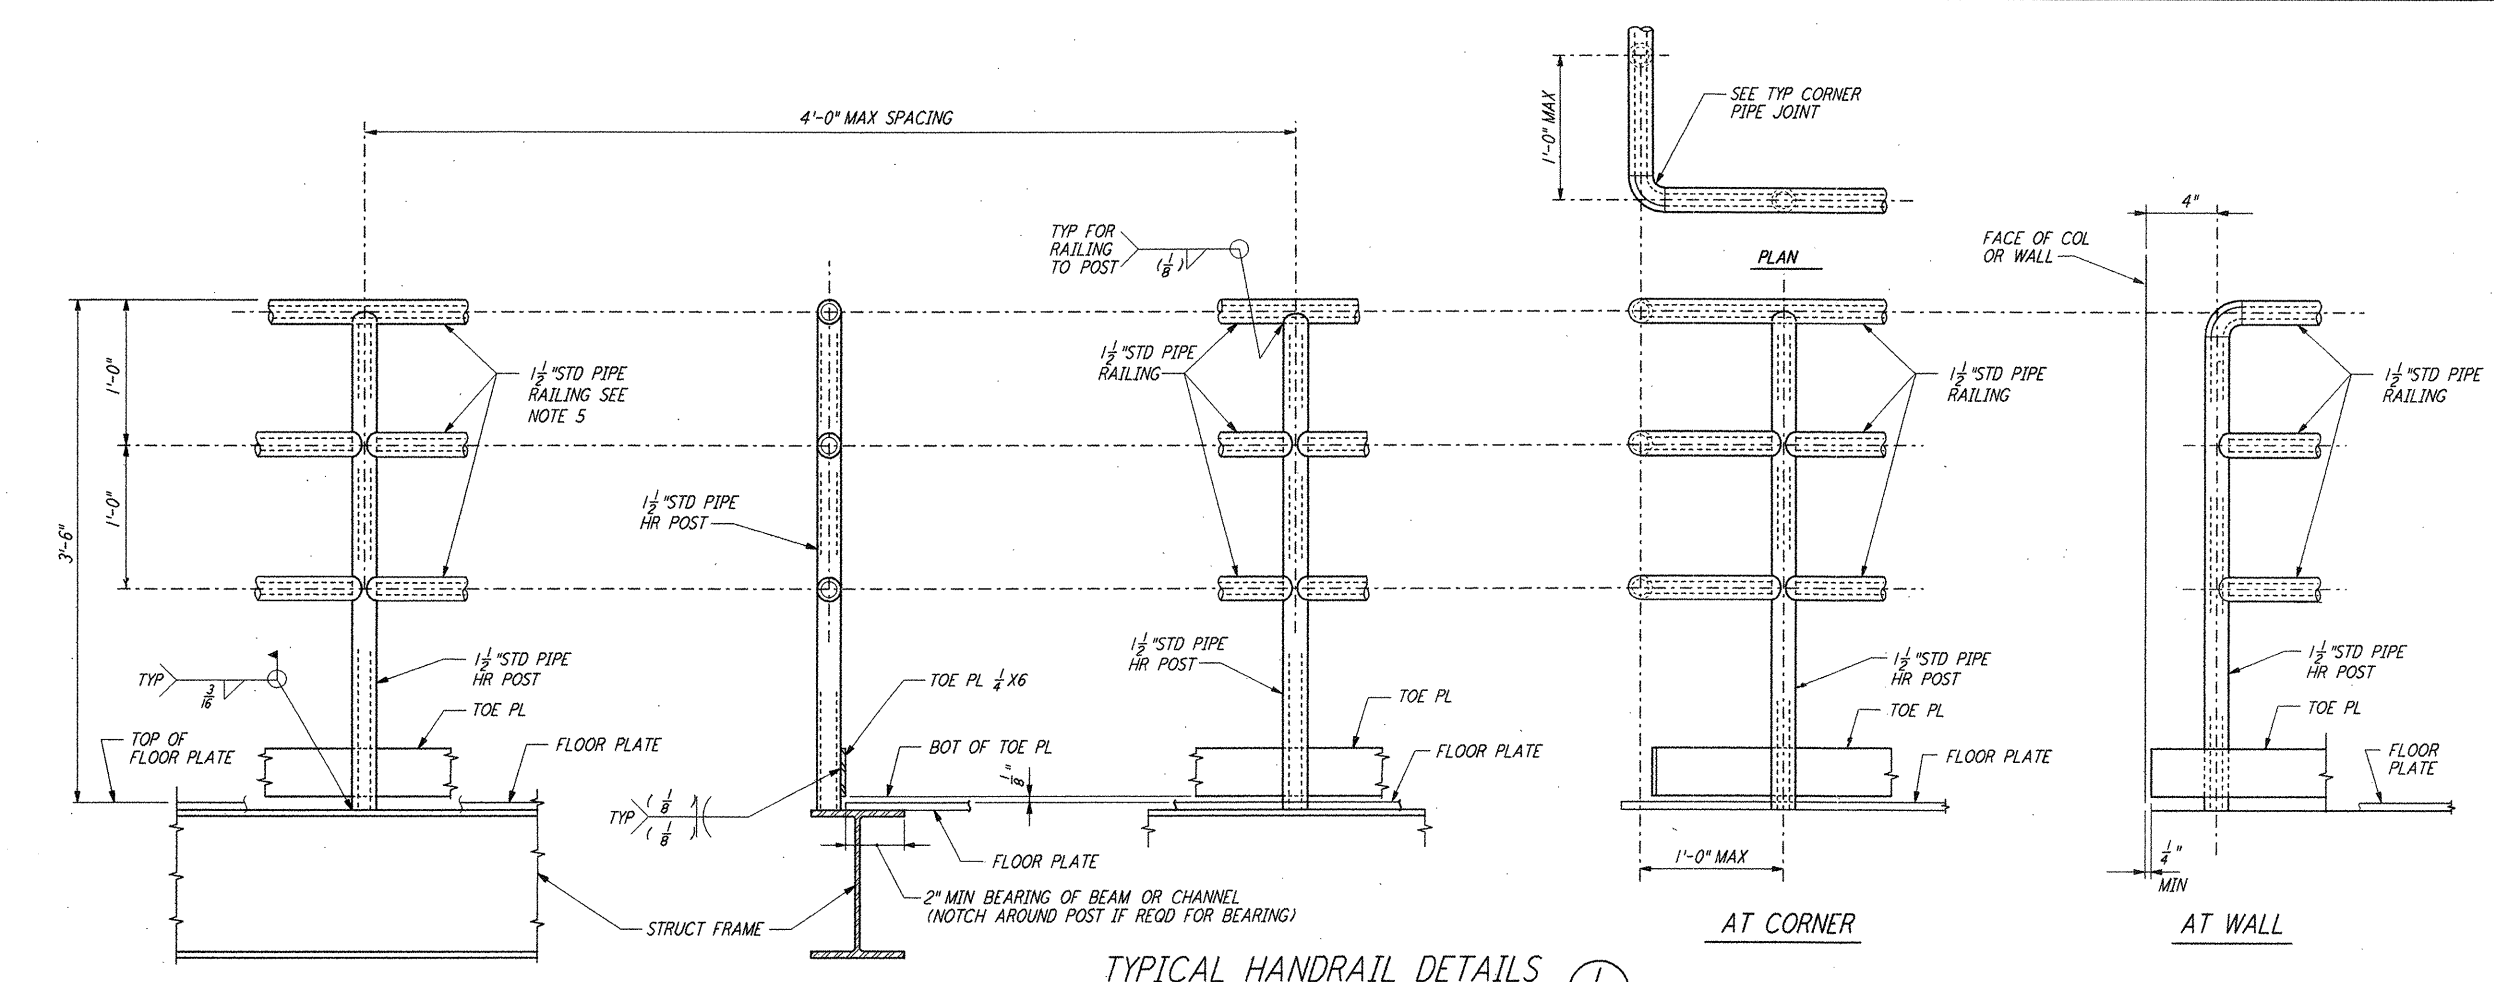

This document and the design it covers are the property of PARSONS. They are loaned only with the borrower's expressed written agreement that they will not be reproduced, copied, loaned, exhibited, or used in any other way, except by written consent from PARSONS to the borrower.

REFERENCES		REVISIONS		ISSUED FOR CONSTRUCTION	
DRAWING NO.	DESCRIPTION	NO.	DATE	BY	DESCRIPTION
		1	6-15-98	CKT	ISSUED FOR AS-BUILT
				ENGR	
				PROJ	
				AS-BUILT DRAWINGS	
				DRAWN MCS 6-24-96	
				CHECKED DDM 7-2-96	
				ENGINEER BP 6-28-96	
				PROJ DDM 7-9-96	

PARSONS

100 WEST WALNUT STREET
PASADENA, CALIFORNIA

LIGO

CALIFORNIA INSTITUTE OF TECHNOLOGY
MASSACHUSETTS INSTITUTE OF TECHNOLOGY

LIGO-D960294-01-O

LASER INTERFEROMETER
GRAVITATIONAL-WAVE OBSERVATORY
SITE NO. 1 - HANFORD, WASHINGTON

TITLE	SCALE	CONTRACT NUMBER	PROJECT NUMBER
STRUCTURAL STANDARD	NONE	PP150969	8094
STAIR & HANDRAIL DETAILS			

WA-S-009

Jun 06 15:47:14 1998 C:\PLOT\DU\CS-V58B2.DOC 52805 41V58B2.vst8094.r