



This document and the design it covers are the property of PARSONS. They are loaned only with the borrower's expressed written agreement that they will not be reproduced, copied, loaned, exhibited, or used in any other way, except by written consent from PARSONS to the borrower.

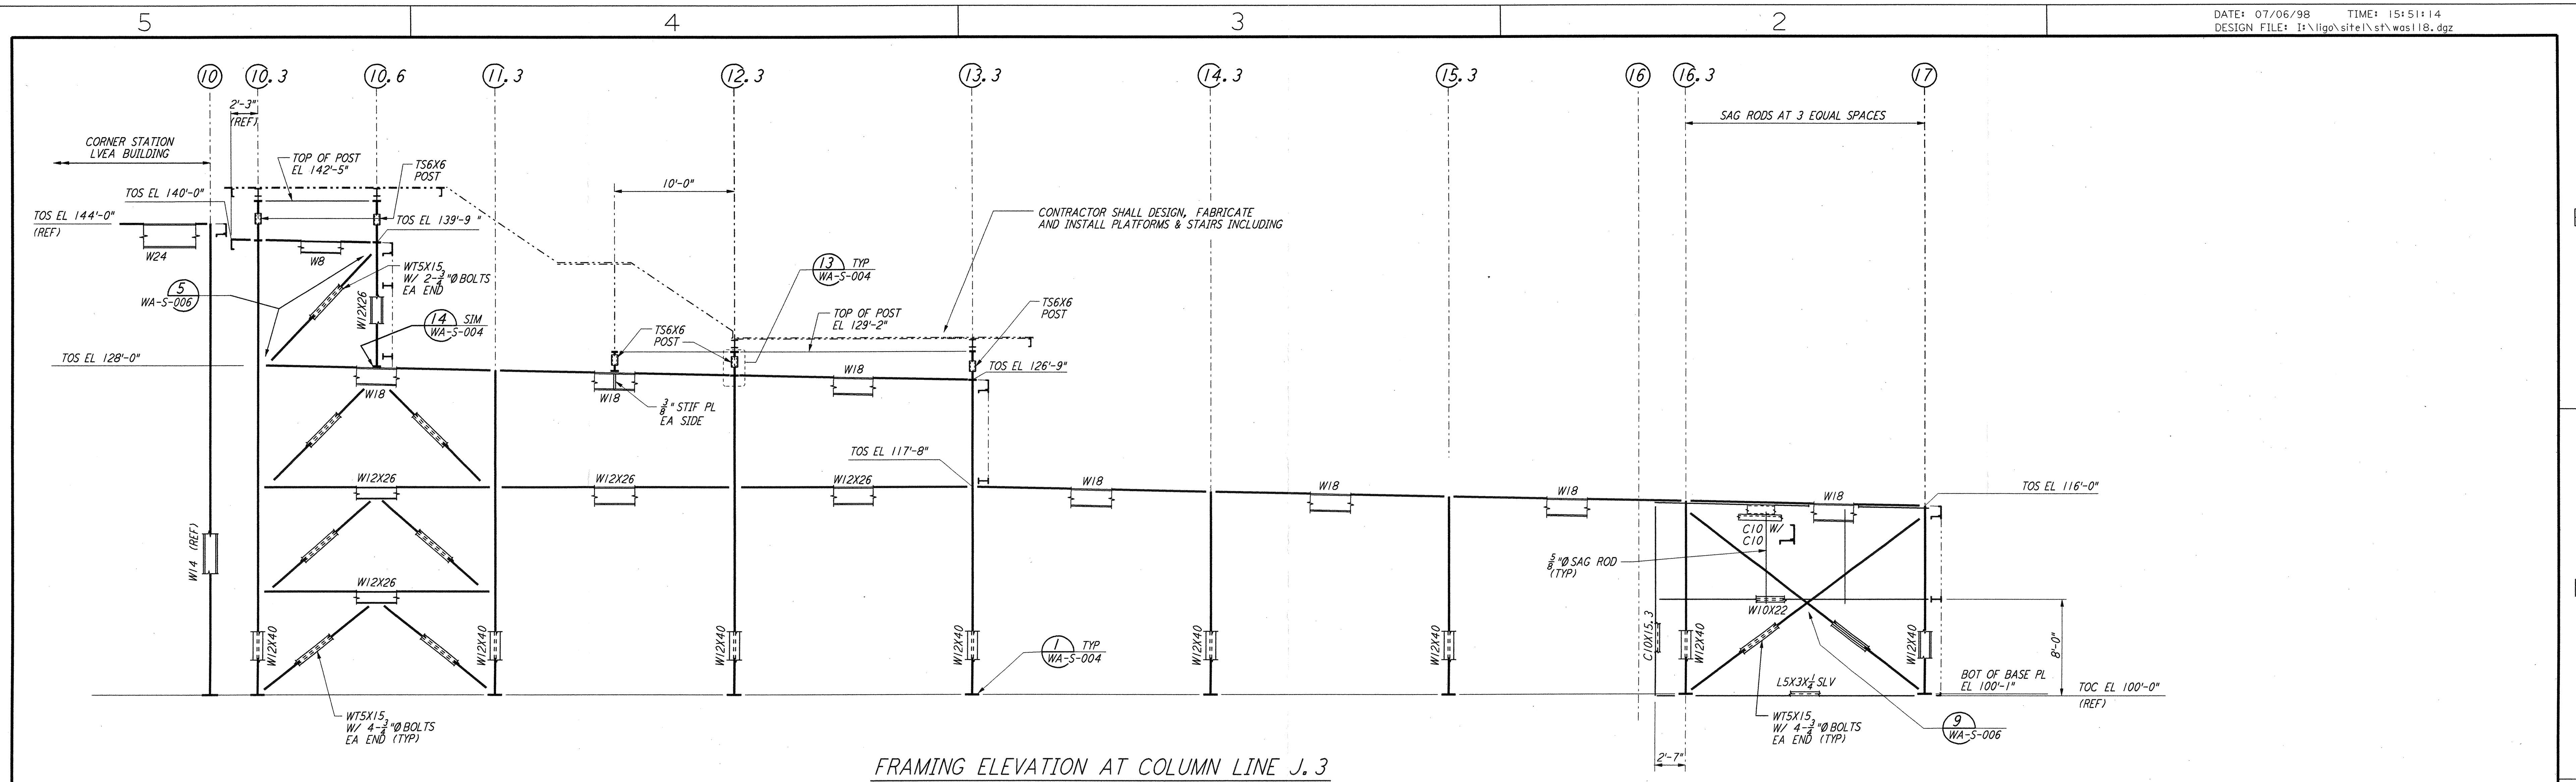


FRAMING ELEVATION AT COLUMN LINE J. 3
 $\frac{3}{8}'' = 1'-0''$

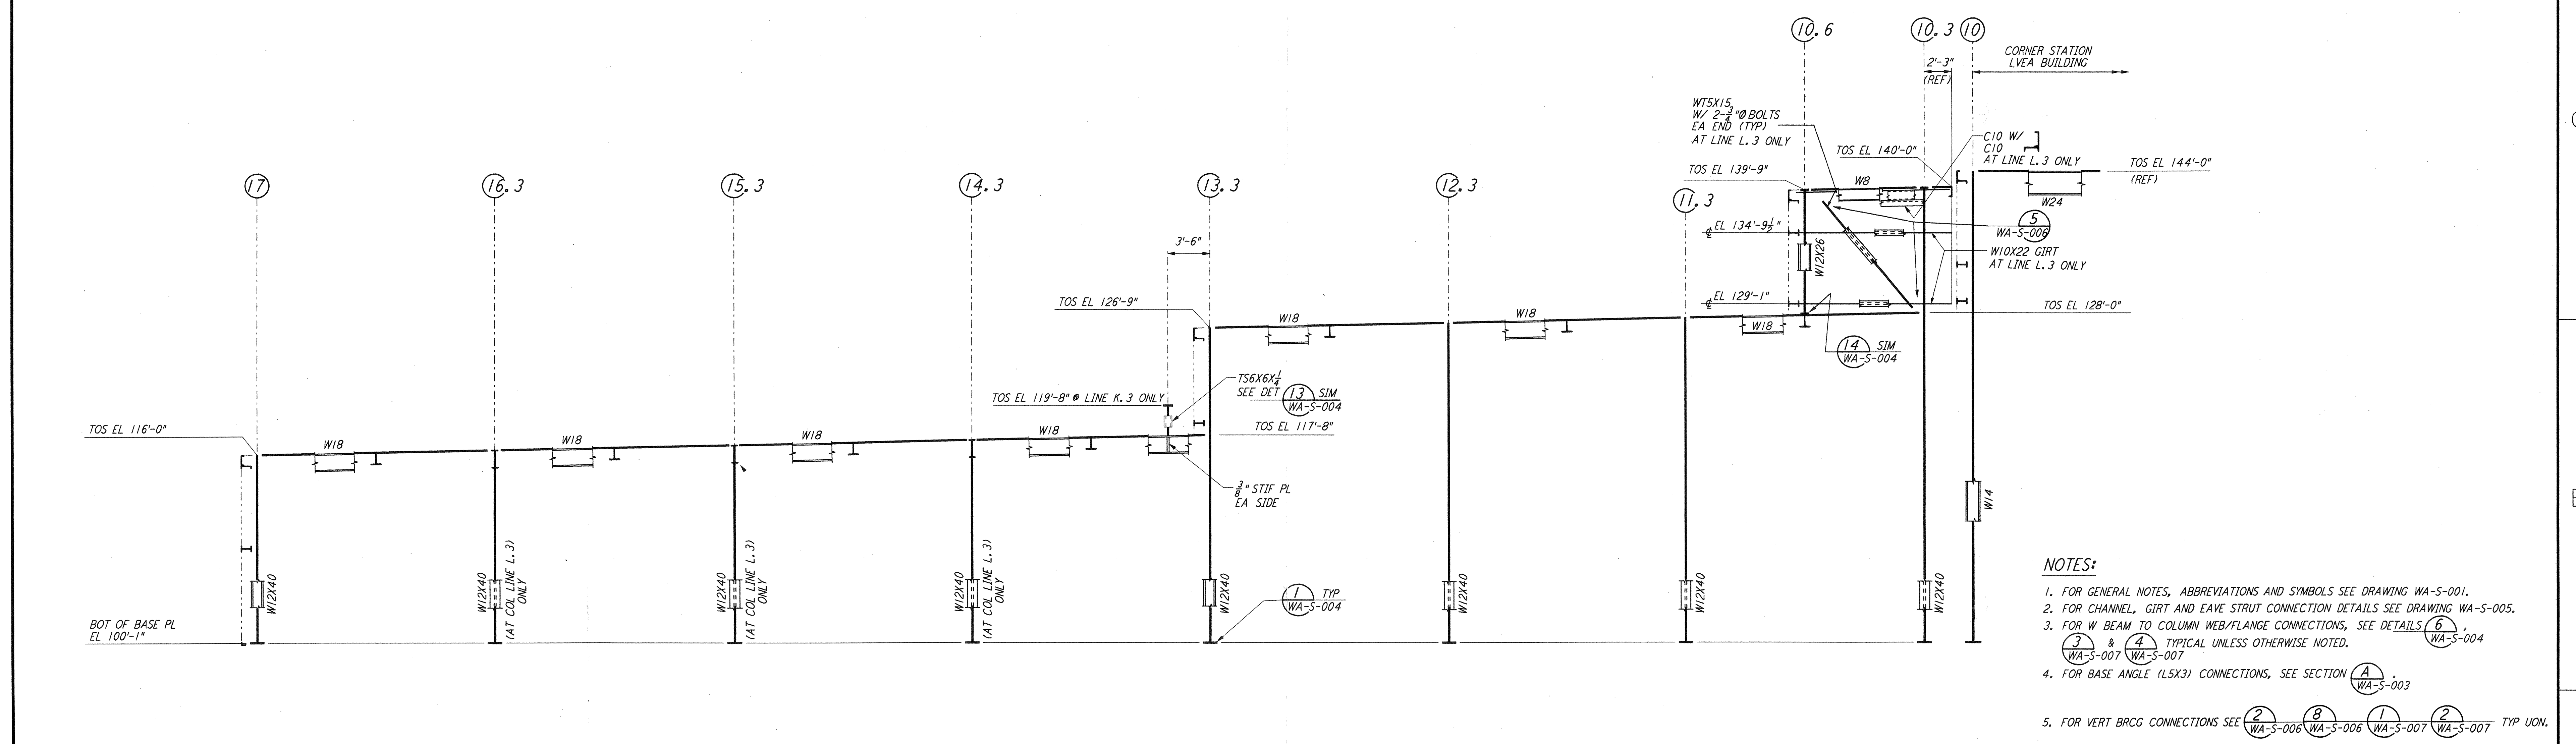

FRAMING ELEVATION AT COLUMN LINE K. 3 & L. 3
 $\frac{3}{8}'' = 1'-0''$

- NOTES:**
- FOR GENERAL NOTES, ABBREVIATIONS AND SYMBOLS SEE DRAWING WA-S-001.
 - FOR CHANNEL, GIRT AND EAVE STRUT CONNECTION DETAILS SEE DRAWING WA-S-005.
 - FOR W BEAM TO COLUMN WEB/FLANGE CONNECTIONS, SEE DETAILS (6), (3) & (4) TYPICAL UNLESS OTHERWISE NOTED. WA-S-004
 - FOR BASE ANGLE (L5X3) CONNECTIONS, SEE SECTION (A) WA-S-003
 - FOR VERT BRGC CONNECTIONS SEE (2) WA-S-006, (8) WA-S-006, (1) WA-S-007, (2) WA-S-007 TYP UON.

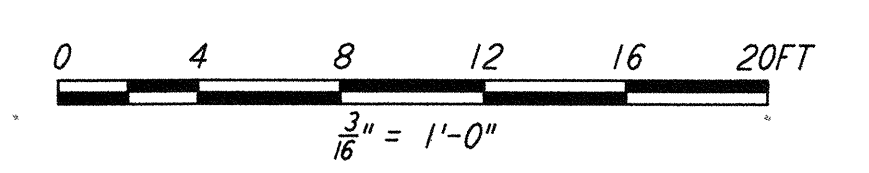

<p>ISSUED FOR CONSTRUCTION</p> <table border="1" style="width: 100%; border-collapse: collapse;"> <tr><td>DRAWN</td><td>MCS</td><td>6-24-96</td></tr> <tr><td>CHECKED</td><td>DDM</td><td>7-2-96</td></tr> <tr><td>ENGINEER</td><td>BP</td><td>6-28-96</td></tr> <tr><td>PROJ</td><td>MDW</td><td>7-9-96</td></tr> </table>	DRAWN	MCS	6-24-96	CHECKED	DDM	7-2-96	ENGINEER	BP	6-28-96	PROJ	MDW	7-9-96	<p>AS-BUILT DRAWINGS</p>	<p>100 WEST WALNUT STREET PASADENA, CALIFORNIA</p>	<p>CALIFORNIA INSTITUTE OF TECHNOLOGY MASSACHUSETTS INSTITUTE OF TECHNOLOGY</p>	<p>LASER INTERFEROMETER GRAVITATIONAL-WAVE OBSERVATORY SITE NO. 1 - HANFORD, WASHINGTON</p> <table border="1" style="width: 100%; border-collapse: collapse;"> <tr> <td style="width: 50%;"> CONTRACT NUMBER AS NOTED PPI150969 </td> <td style="width: 50%;"> PROJECT NUMBER 8094 </td> </tr> <tr> <td colspan="2" style="text-align: center;"> SHEET NUMBER WA-S-118 </td> </tr> </table>	CONTRACT NUMBER AS NOTED PPI150969	PROJECT NUMBER 8094	SHEET NUMBER WA-S-118	
DRAWN	MCS	6-24-96																		
CHECKED	DDM	7-2-96																		
ENGINEER	BP	6-28-96																		
PROJ	MDW	7-9-96																		
CONTRACT NUMBER AS NOTED PPI150969	PROJECT NUMBER 8094																			
SHEET NUMBER WA-S-118																				
<p>REVISIONS</p> <table border="1" style="width: 100%; border-collapse: collapse;"> <thead> <tr> <th>NO.</th> <th>DATE</th> <th>BY</th> <th>CHKD</th> <th>ENGR</th> <th>PROJ</th> <th>DESCRIPTION</th> </tr> </thead> <tbody> <tr> <td>1</td> <td>6-15-98</td> <td>CKT</td> <td>WJ</td> <td>WJ</td> <td>MDW</td> <td>ISSUED FOR AS-BUILT</td> </tr> </tbody> </table>					NO.	DATE	BY	CHKD	ENGR	PROJ	DESCRIPTION	1	6-15-98	CKT	WJ	WJ	MDW	ISSUED FOR AS-BUILT		
NO.	DATE	BY	CHKD	ENGR	PROJ	DESCRIPTION														
1	6-15-98	CKT	WJ	WJ	MDW	ISSUED FOR AS-BUILT														
DRAWING NO.	DESCRIPTION																			

Non Jul 06 15:56:52 1998 C:\PLOT\OUE\53-VGBB2.DCF 52085 K:\V3BB2\atlib.prf LIGOWAF.BDR