



This document and the design it covers are the property of PARSONS. They are loaned only with the borrower's expressed written agreement that they will not be reproduced, copied, loaned, exhibited, or used in any other way, except by written consent from PARSONS to the borrower.

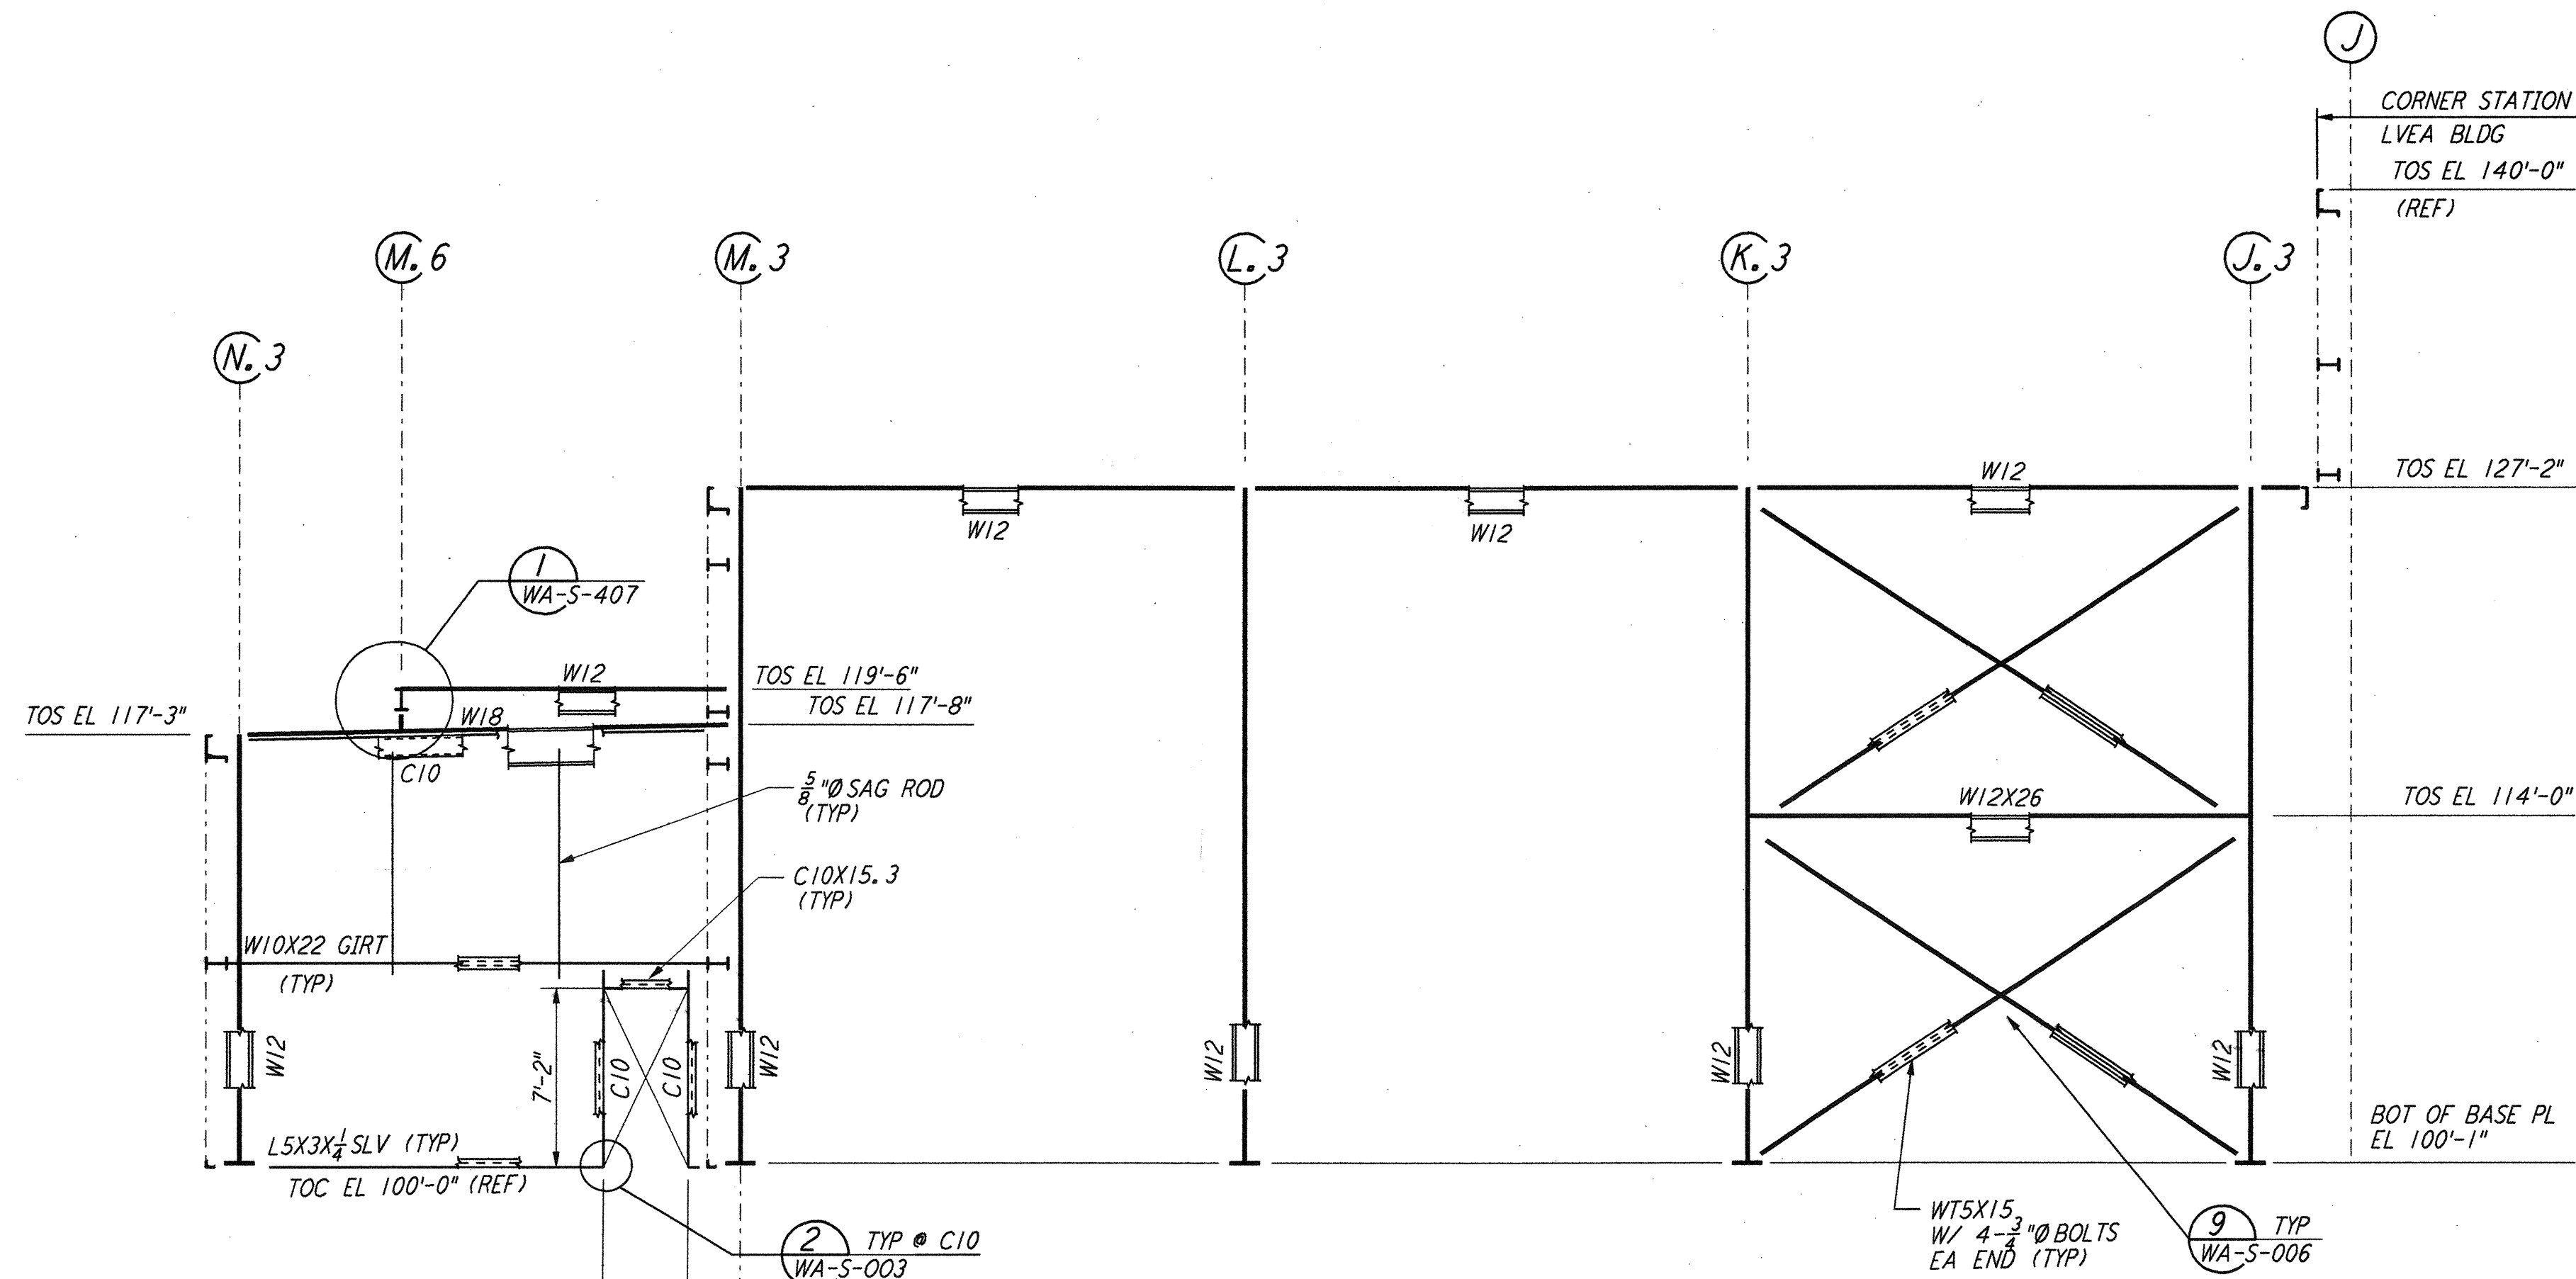


FRAMING ELEVATION AT COLUMN LINE 12.3

3/8\"/>

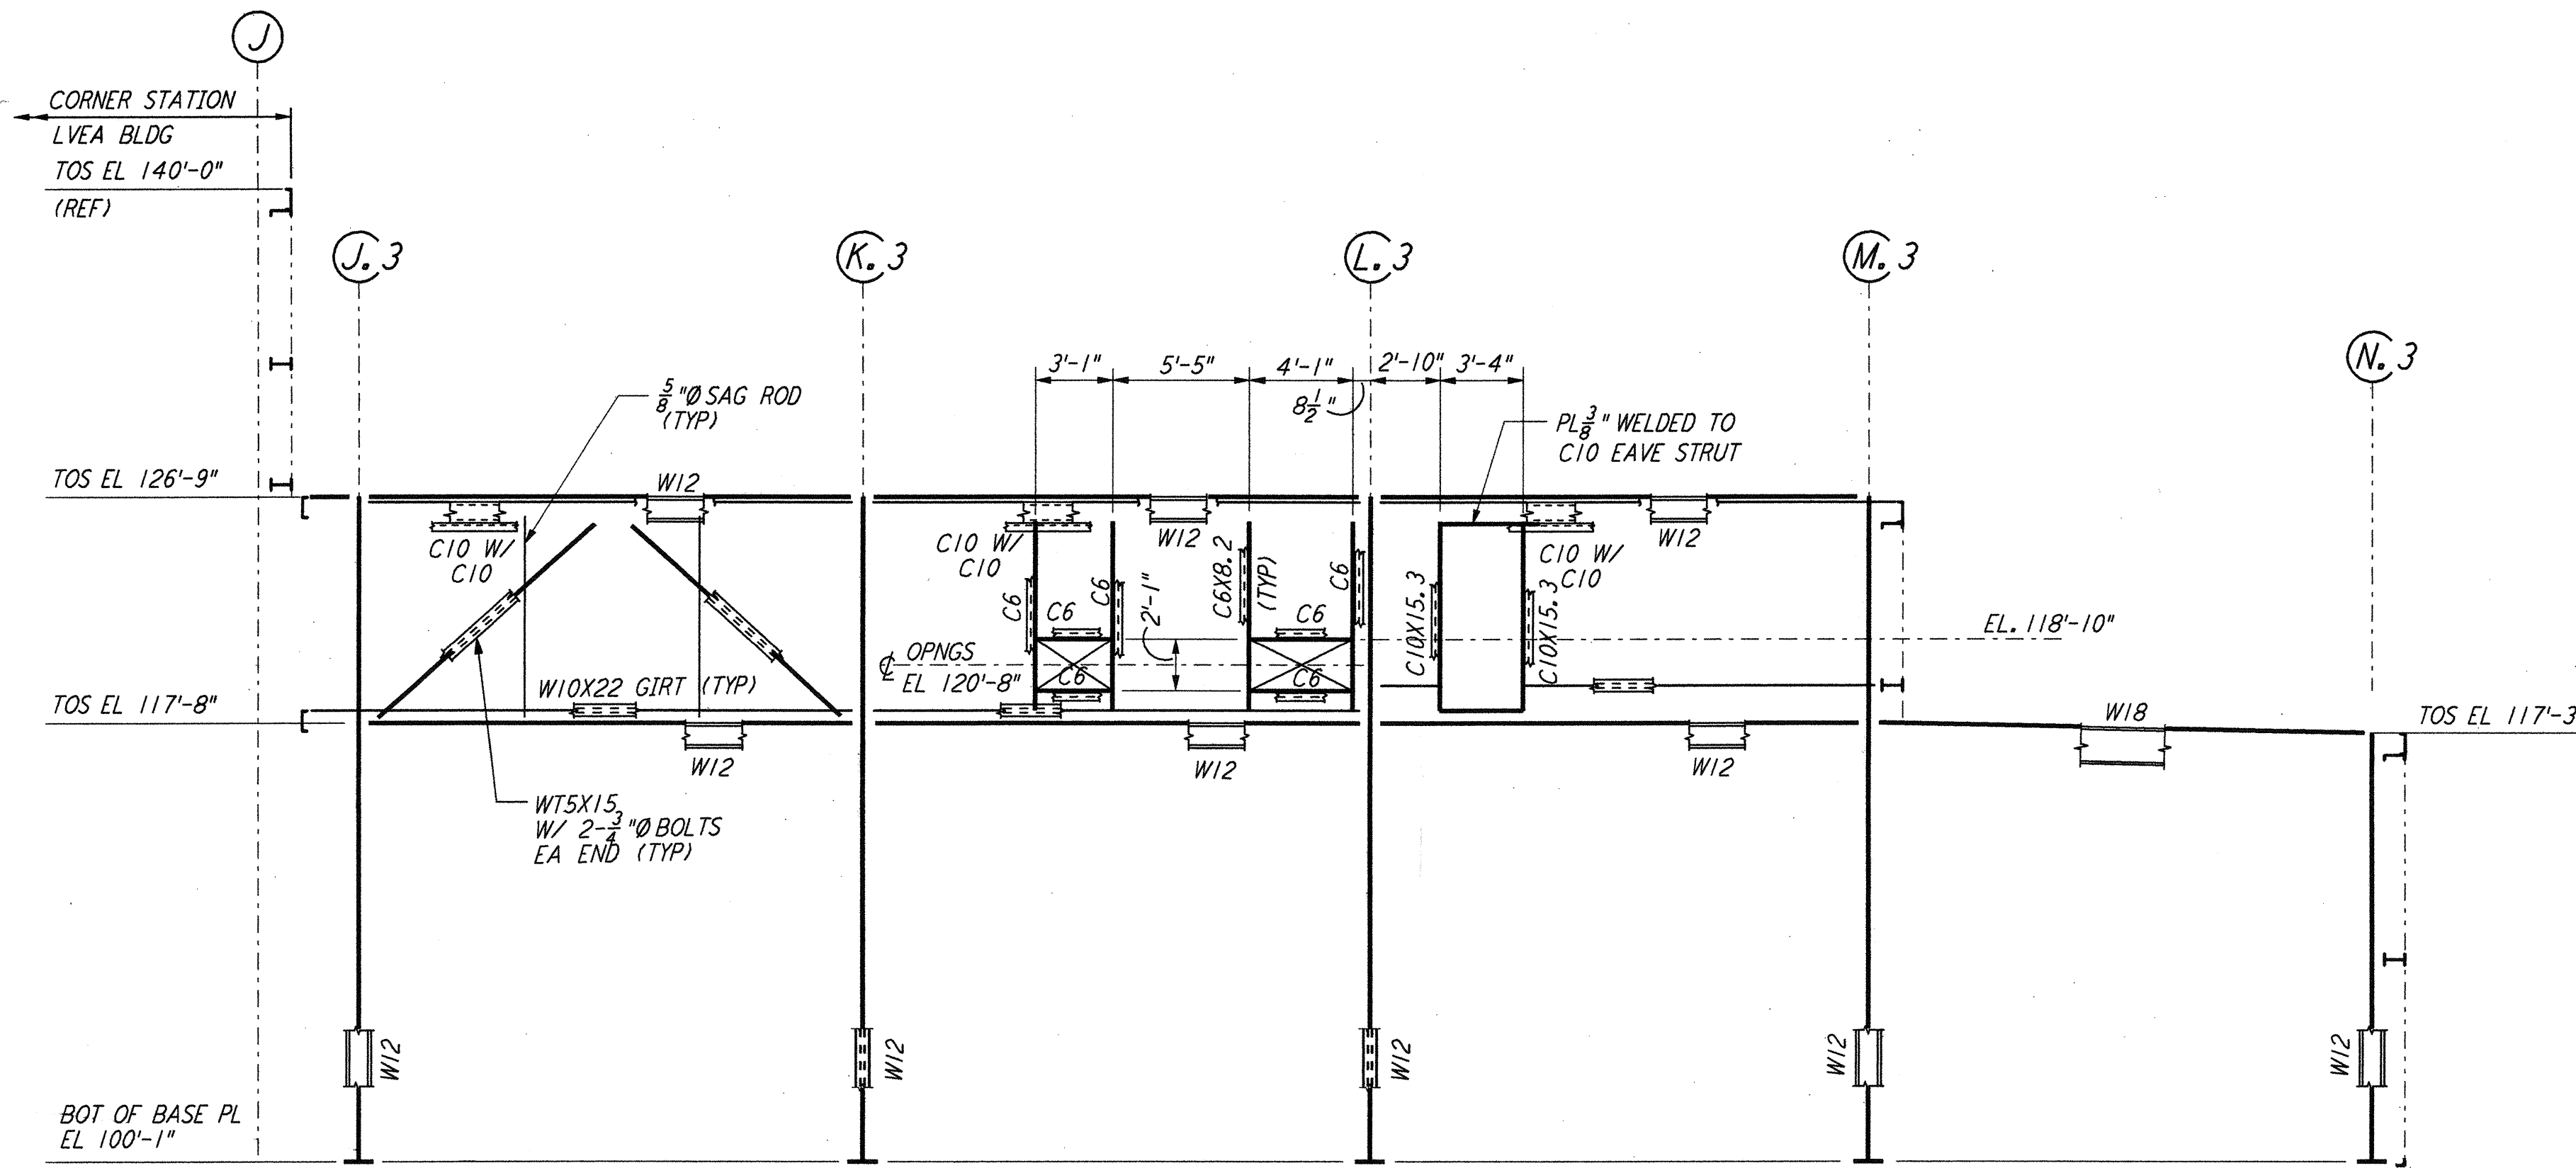


FRAMING ELEVATION AT COLUMN LINE 13.3

3/8\"/>

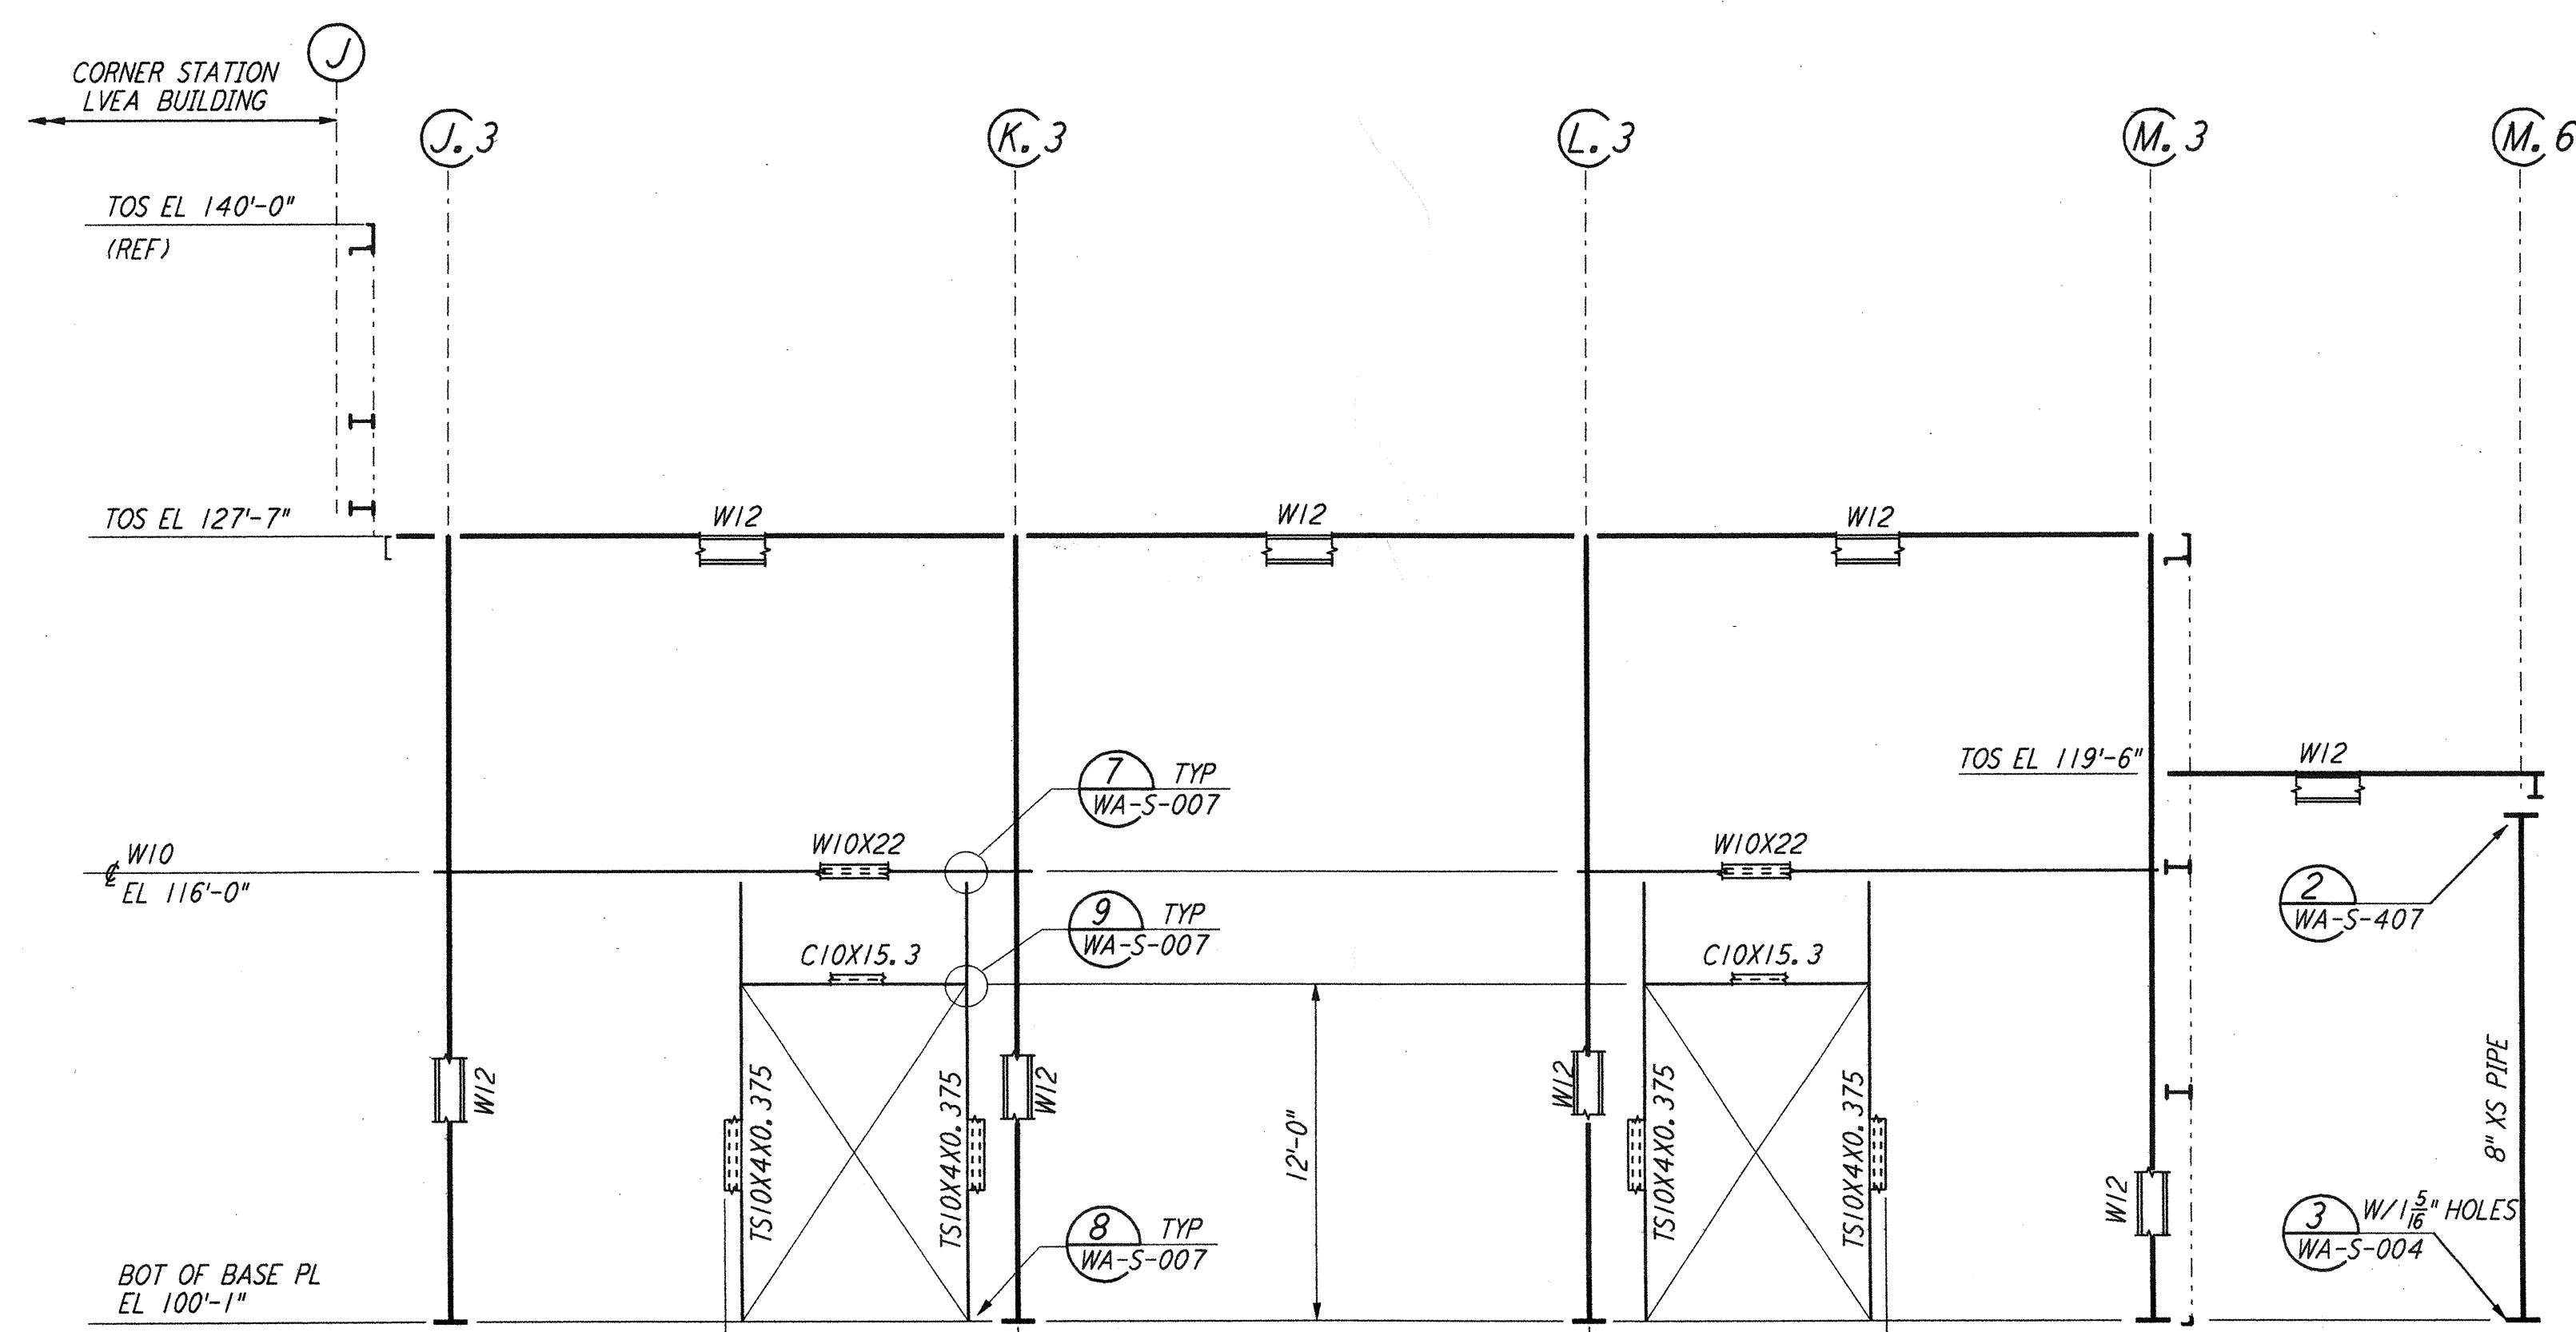


FRAMING ELEVATION AT COLUMN LINE 11.3

3/8\"/>

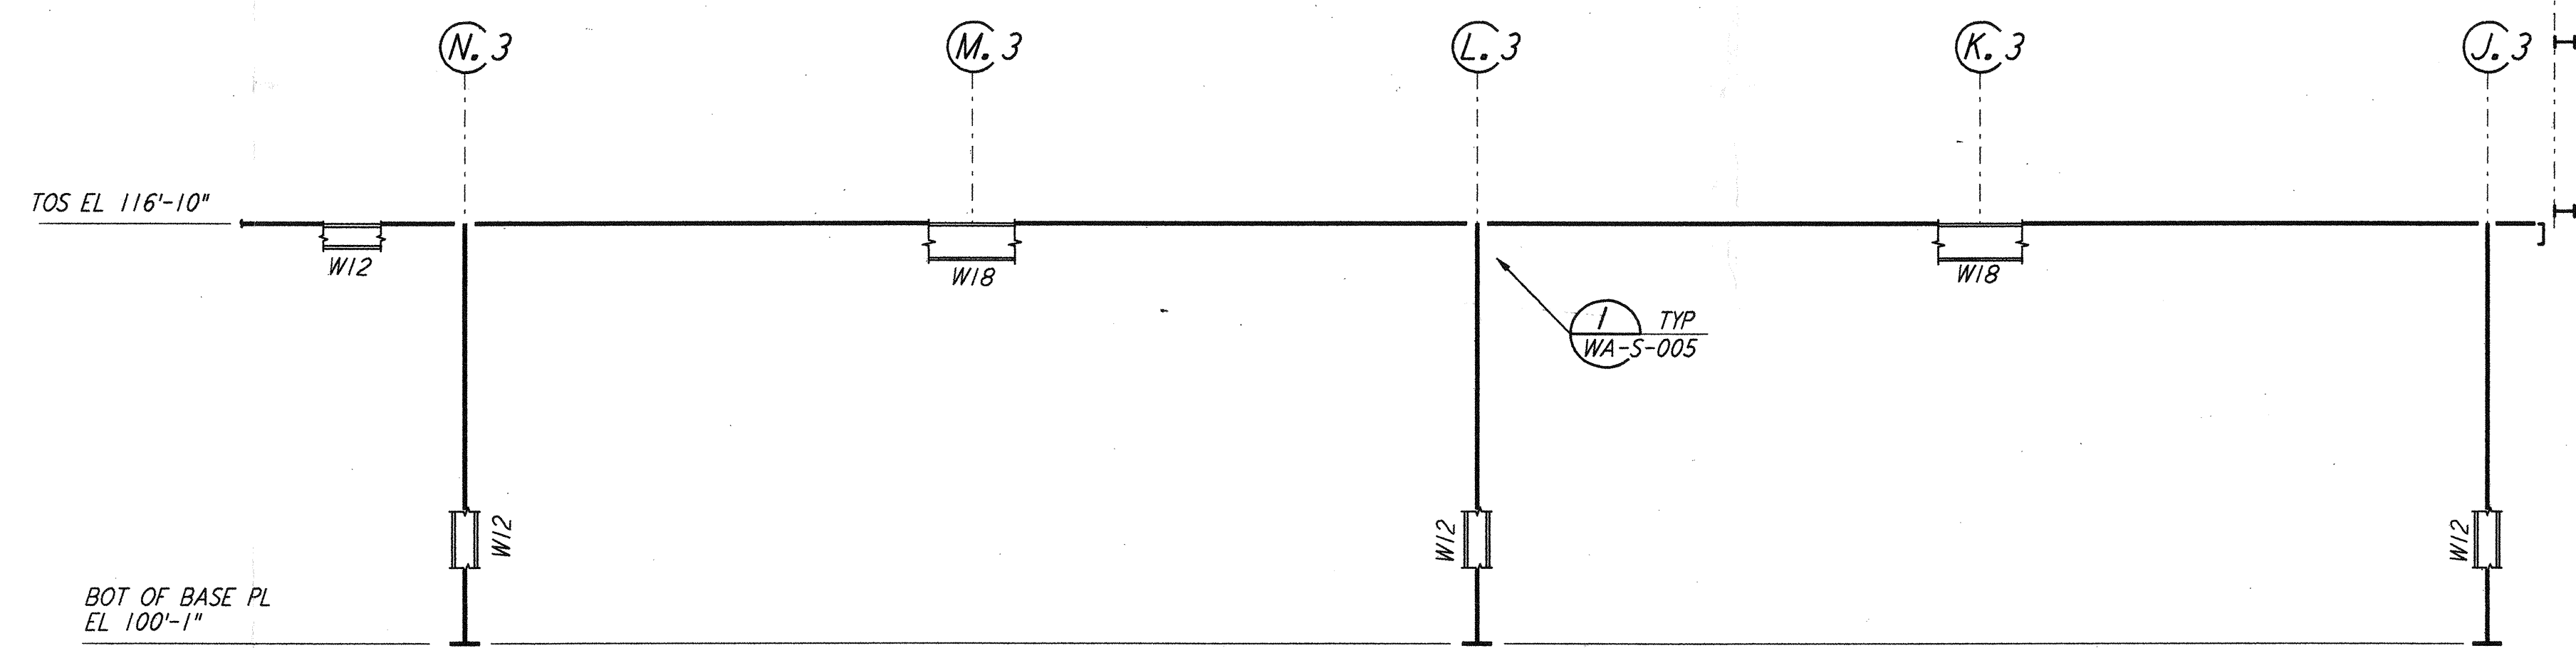

FRAMING ELEVATION AT COLUMN LINE 15.3

3/8\"/>

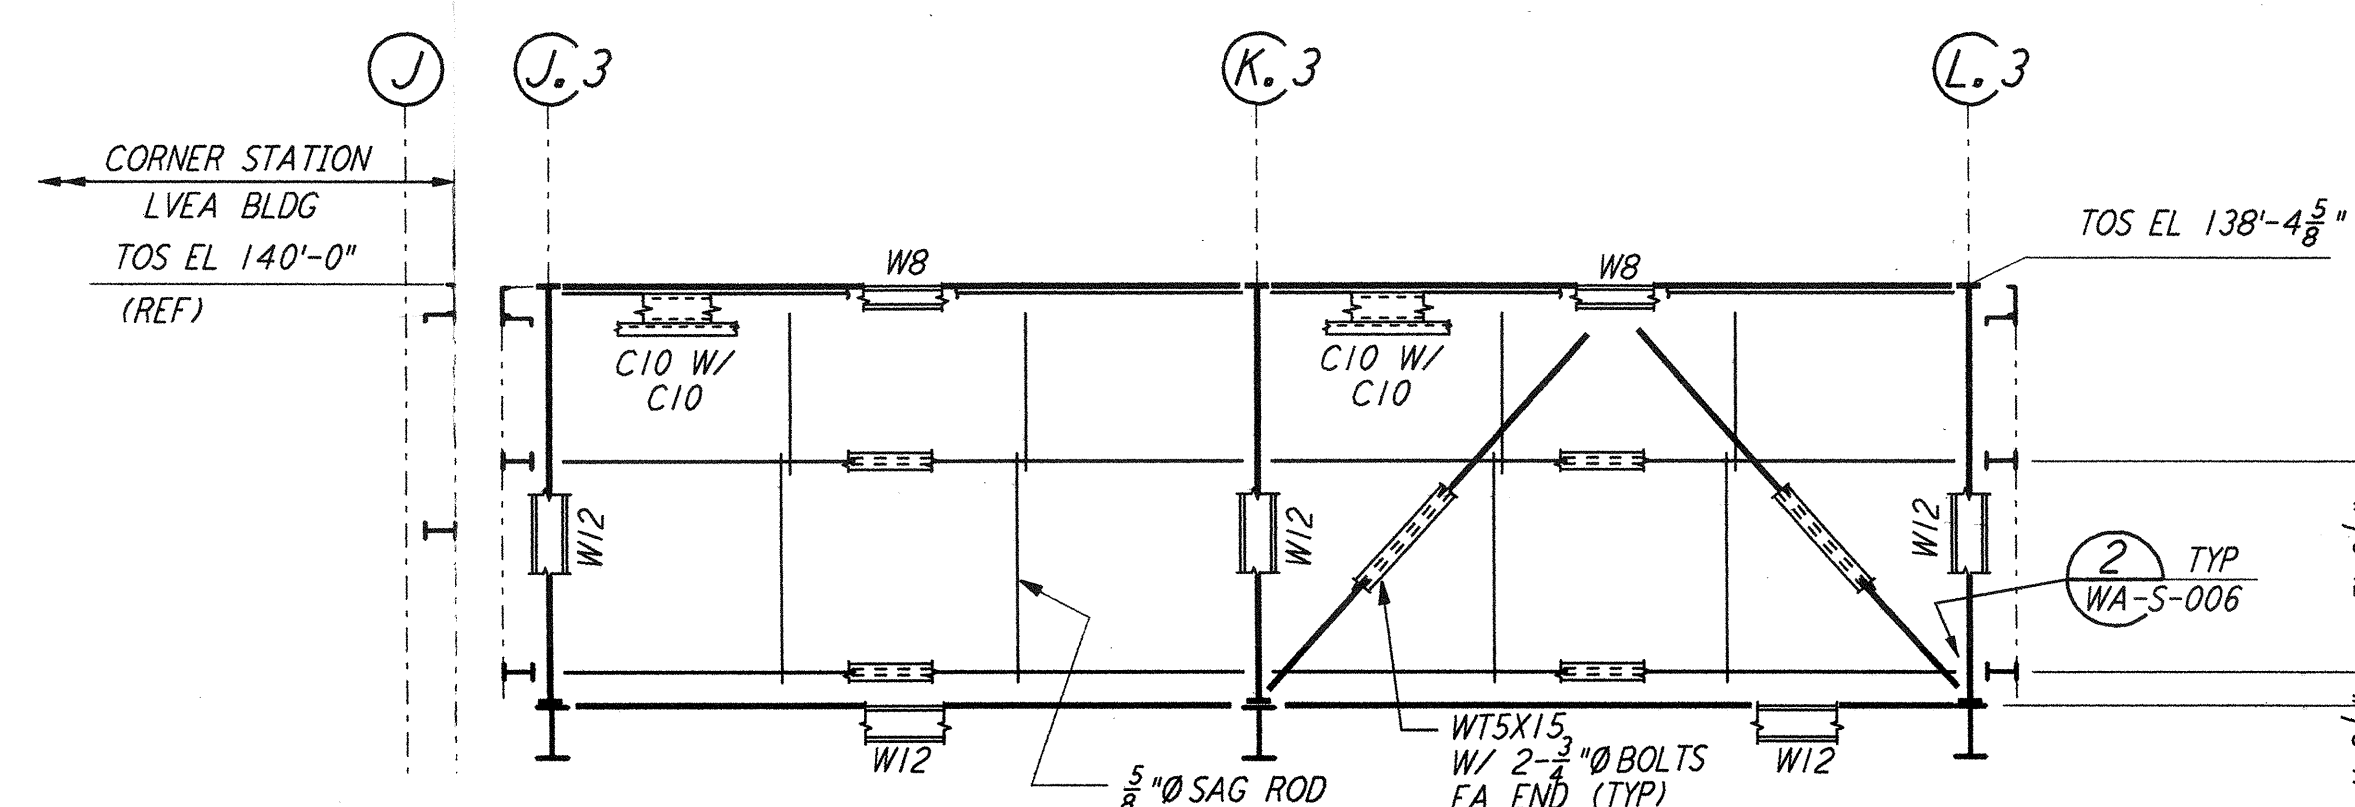


FRAMING ELEVATION AT COLUMN LINE 10.6

3/8\"/>

NOTES:

- FOR GENERAL NOTES, ABBREVIATIONS AND SYMBOLS SEE DRAWING WA-S-001.
- FOR CHANNEL, GIRT AND EAVE STRUT CONNECTION DETAILS SEE DRAWING WA-S-005.
- FOR W BEAM TO COLUMN WEB/FLANGE CONNECTIONS, SEE DETAILS (6) WA-S-004 & (4) TYPICAL UNLESS OTHERWISE NOTED.
- FOR BASE ANGLE (L5X3) CONNECTIONS, SEE SECTION (A) WA-S-003.
- FOR VERT BRGG CONNECTIONS SEE (2) WA-S-006 (8) WA-S-006 (1) WA-S-007 (2) WA-S-007 TYP UNO.

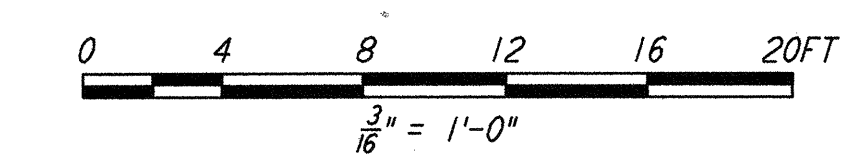

LIGO-D960301-01-O

| NO. | DATE    | BY  | CHKD | ENGR | PROJ | DESCRIPTION         |
|-----|---------|-----|------|------|------|---------------------|
| 1   | 6-15-98 | CKT | BP   | BP   | FX   | ISSUED FOR AS-BUILT |

| ISSUED FOR CONSTRUCTION |
|-------------------------|
| DRAWN MCS 6-24-96       |
| CHECKED DDM 7-2-96      |
| ENGINEER BP 6-28-96     |
| PROJ MDW 7-9-96         |

AS-BUILT DRAWINGS



100 WEST WALNUT STREET  
PASADENA, CALIFORNIA



CALIFORNIA INSTITUTE OF TECHNOLOGY  
MASSACHUSETTS INSTITUTE OF TECHNOLOGY

| LASER INTERFEROMETER<br>GRAVITATIONAL-WAVE OBSERVATORY<br>SITE NO. 1 - HANFORD, WASHINGTON |   |
|--|---|
| STRUCTURAL<br>CORNER STATION<br>OSB FRAMING ELEVATIONS<br>SHEET 4                          | SCALE AS NOTED<br>CONTRACT NUMBER PPI50969<br>PROJECT NUMBER 8094 |
| SHEET NUMBER WA-S-121  |   |