

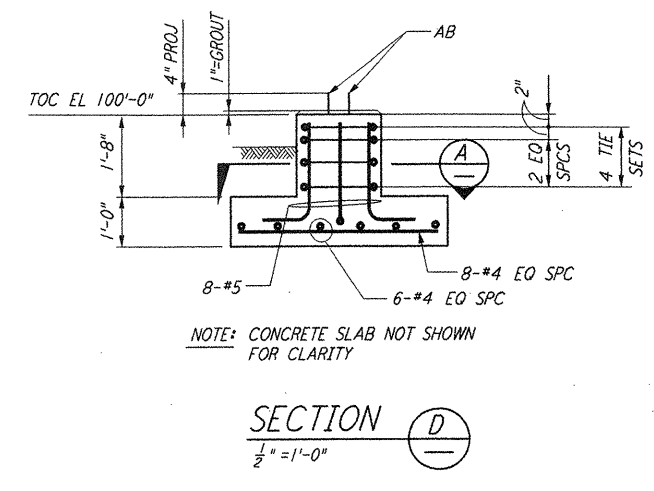
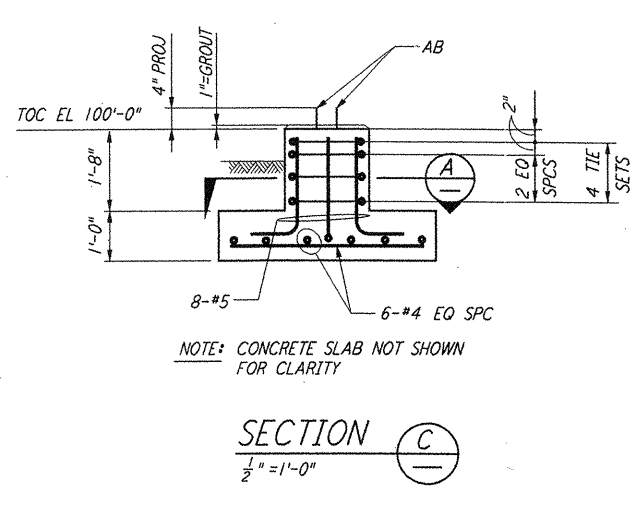
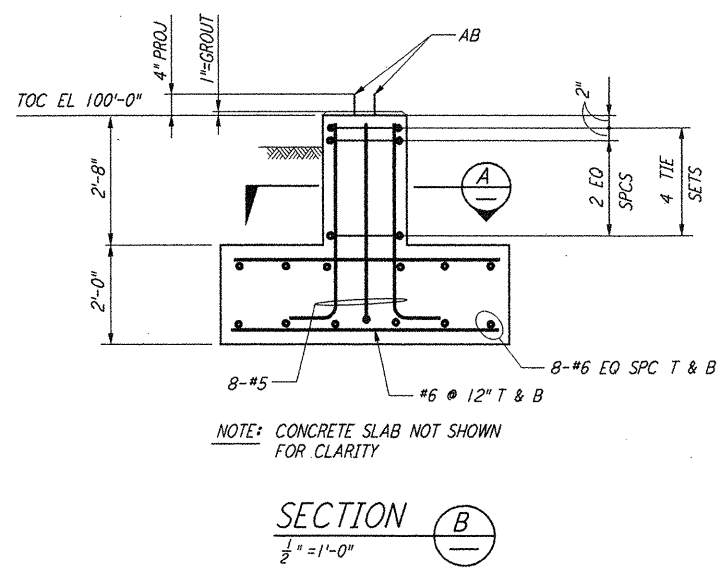


FOR FLOOR SLOPES SEE ARCHITECTURAL DWGS
FOUNDATION PLAN
 1/4" = 1'-0"

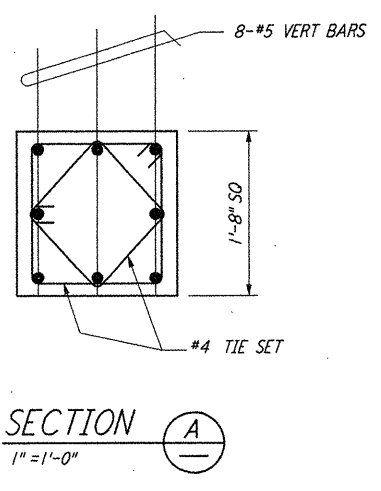

- NOTES:**
- FOR STRUCTURAL GENERAL NOTES, ABBREVIATIONS AND LEGEND SEE DWG. WA-S-001.
 - CONTRACTOR TO ADJUST LOCATION AND SIZE OF EQUIPMENT PADS TO SUIT VENDOR EQUIPMENT.

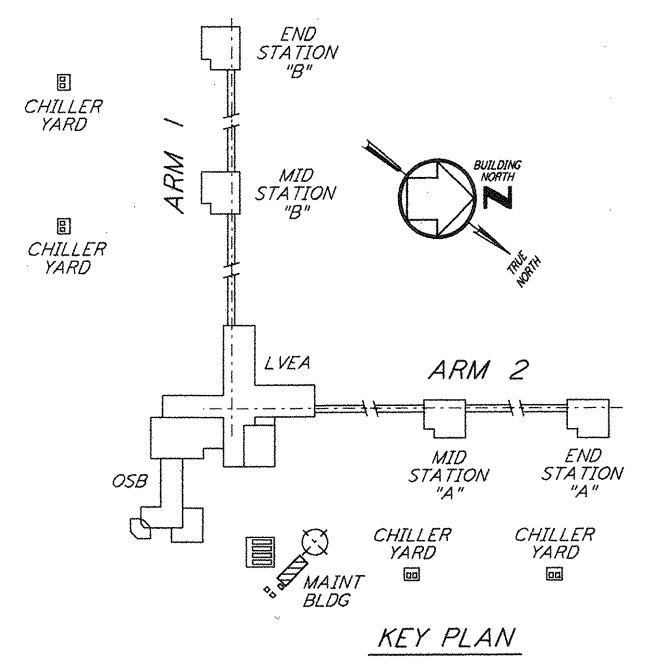

NO.	DATE	BY	CHKD	ENGR	PROJ	DESCRIPTION
1	6-15-98	CKT	BP	BP	BP	ISSUED FOR AS-BUILT

ISSUED FOR CONSTRUCTION	
DRAWN	PK 6-24-96
CHECKED	DDM 7-2-96
ENGINEER	BP 6-18-96
PROJ	MDW 7-9-96

AS-BUILT DRAWINGS

PARSONS
 100 WEST WALNUT STREET
 PASADENA, CALIFORNIA

LIGO
 CALIFORNIA INSTITUTE OF TECHNOLOGY
 MASSACHUSETTS INSTITUTE OF TECHNOLOGY

LIGO-D960306-01-0
 LASER INTERFEROMETER
 GRAVITATIONAL-WAVE OBSERVATORY
 SITE NO. 1 - HANFORD, WASHINGTON

TITLE	SCALE	CONTRACT NUMBER	PROJECT NUMBER
STRUCTURAL MAINTENANCE BUILDING FDN PLAN & SECTIONS	AS NOTED	PP150969	8094
SHEET NUMBER		REVISIONS	
WA-S-126			

This document and the design it covers are the property of PARSONS. They are loaned only with the borrower's expressed written agreement that they will not be reproduced, copied, loaned, exhibited, or used in any other way, except by written consent from PARSONS to the borrower.

This document and the design it covers are the property of PARSONS. They are loaned only with the borrower's expressed written agreement that they will not be reproduced, copied, loaned, exhibited, or used in any other way, except by written consent from PARSONS to the borrower.

Mon Jul 06 16:49:27 1998 C:\PLOT\VALUE\S3-V8822.DWG 52885 K:\V8822\126.plt LIGOWAF.BDR