


ARM I (SOUTHWEST ARM)
 MID STATION "B" FOUNDATION PLAN
 $\frac{1}{8}'' = 1'-0''$
 DATUM POINT EL 100'-0" = EL 532.22'



FOR FLOOR SLOPES SEE ARCHITECTURAL DWGS.

- EQUIPMENT FOUNDATION NOTES:**
1. CONCRETE FOR EQUIPMENT FOUNDATION SHALL BE PLACED IN MULTIPLE LIFTS OF ONE (1) FOOT OR MORE WITH A FINAL LIFT OF SIX (6) INCHES.
 2. FIBERMESH FIBERS (MANUFACTURED BY FIBERMESH, CHATTANOOGA, TENNESSEE OR EQUAL) SHALL BE MIXED WITH CONCRETE FOR THE FINAL LIFT OF SIX (6) INCHES FOR THE EQUIPMENT FOUNDATION.
 3. CONCRETE SURFACE SHALL BE CLEANED, RAKED AND ROUGHENED TO DEVELOPE BOND BETWEEN CONCRETE LAYERS.
 4. TOP REINFORCEMENT OF EQUIPMENT FOUNDATION SHALL HAVE $\frac{1}{2}''$ CLEAR COVER. CONTRACTOR SHALL TAKE ALL THE NECESSARY PRECAUTIONS TO MAINTAIN UNIFORM COVER.
 5. CONTRACTOR SHALL HAVE SPARE PUMPS TO ENSURE UNINTERRUPTED PLACEMENT OF CONCRETE.
 6. EQUIPMENT FOUNDATION SHALL BE CURED BY MEMBRANE CURING METHOD AS PER SPECIFICATIONS.

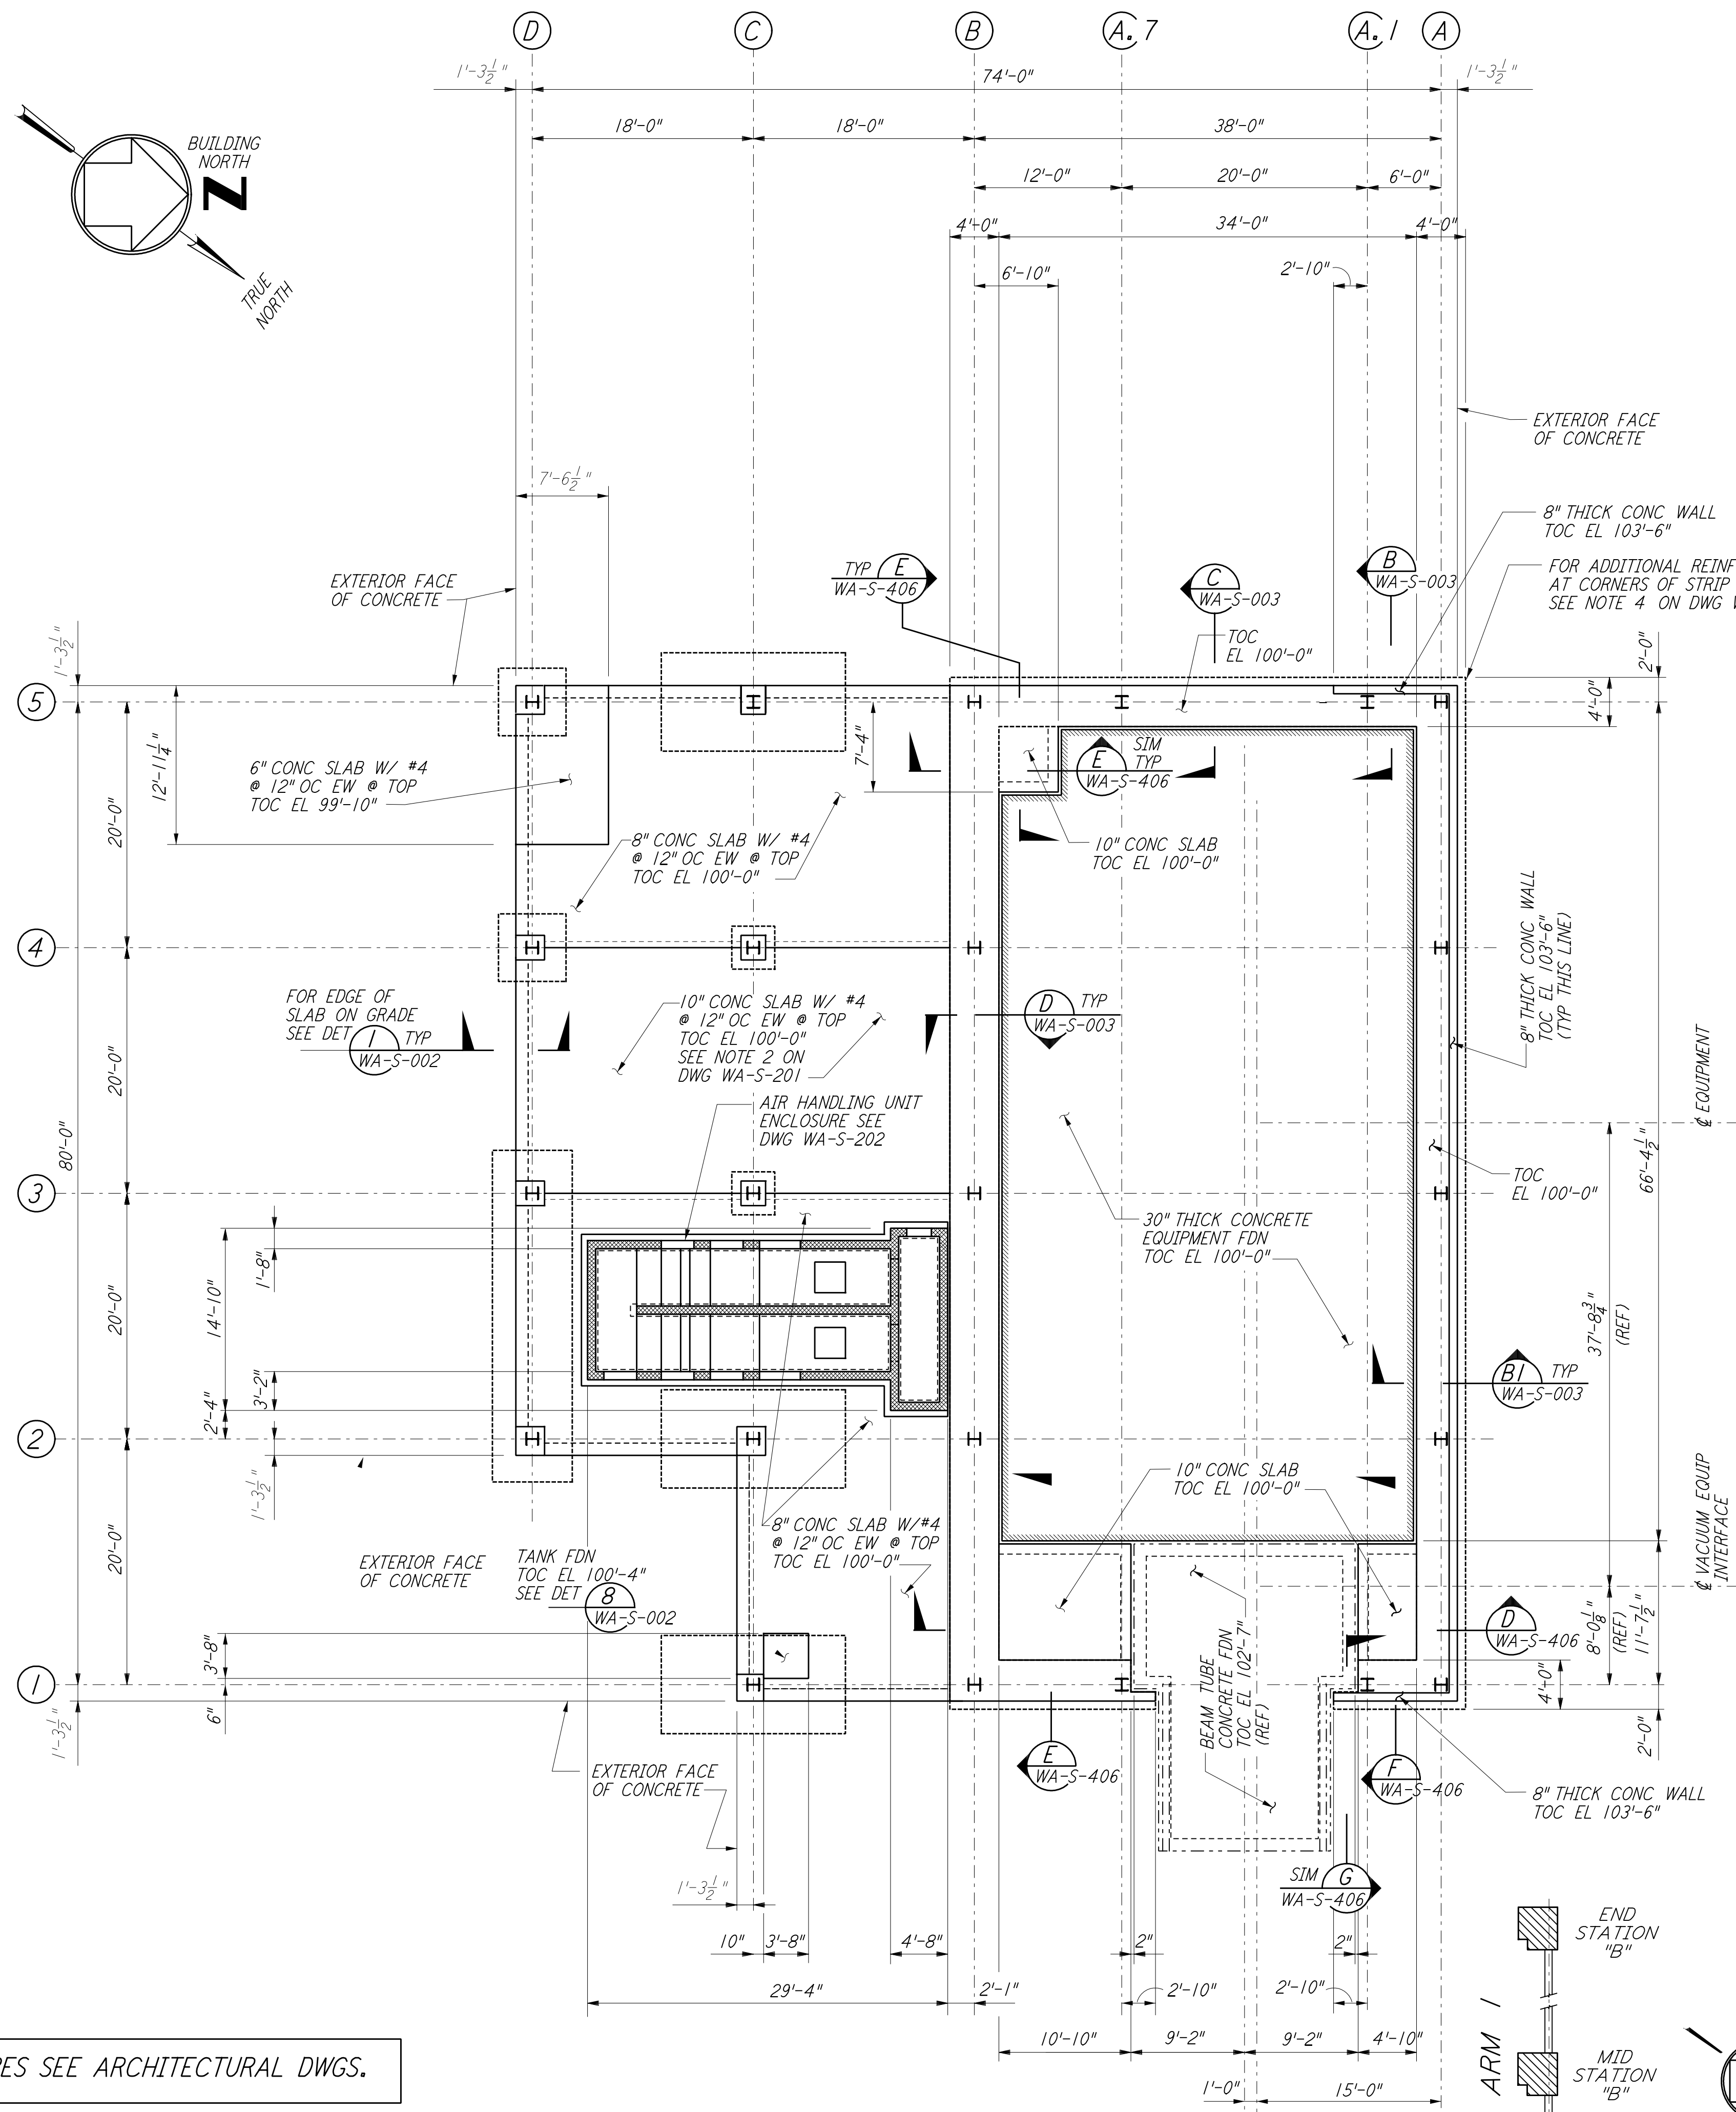

ARM I (SOUTHWEST ARM)
 END STATION "B" FOUNDATION PLAN
 $\frac{1}{8}'' = 1'-0''$
 DATUM POINT EL 100'-0" = EL 535.26'

- NOTES:**
1. FOR FOUNDATION SCHEDULE AND DETAILS, SEE DRAWING WA-S-401.

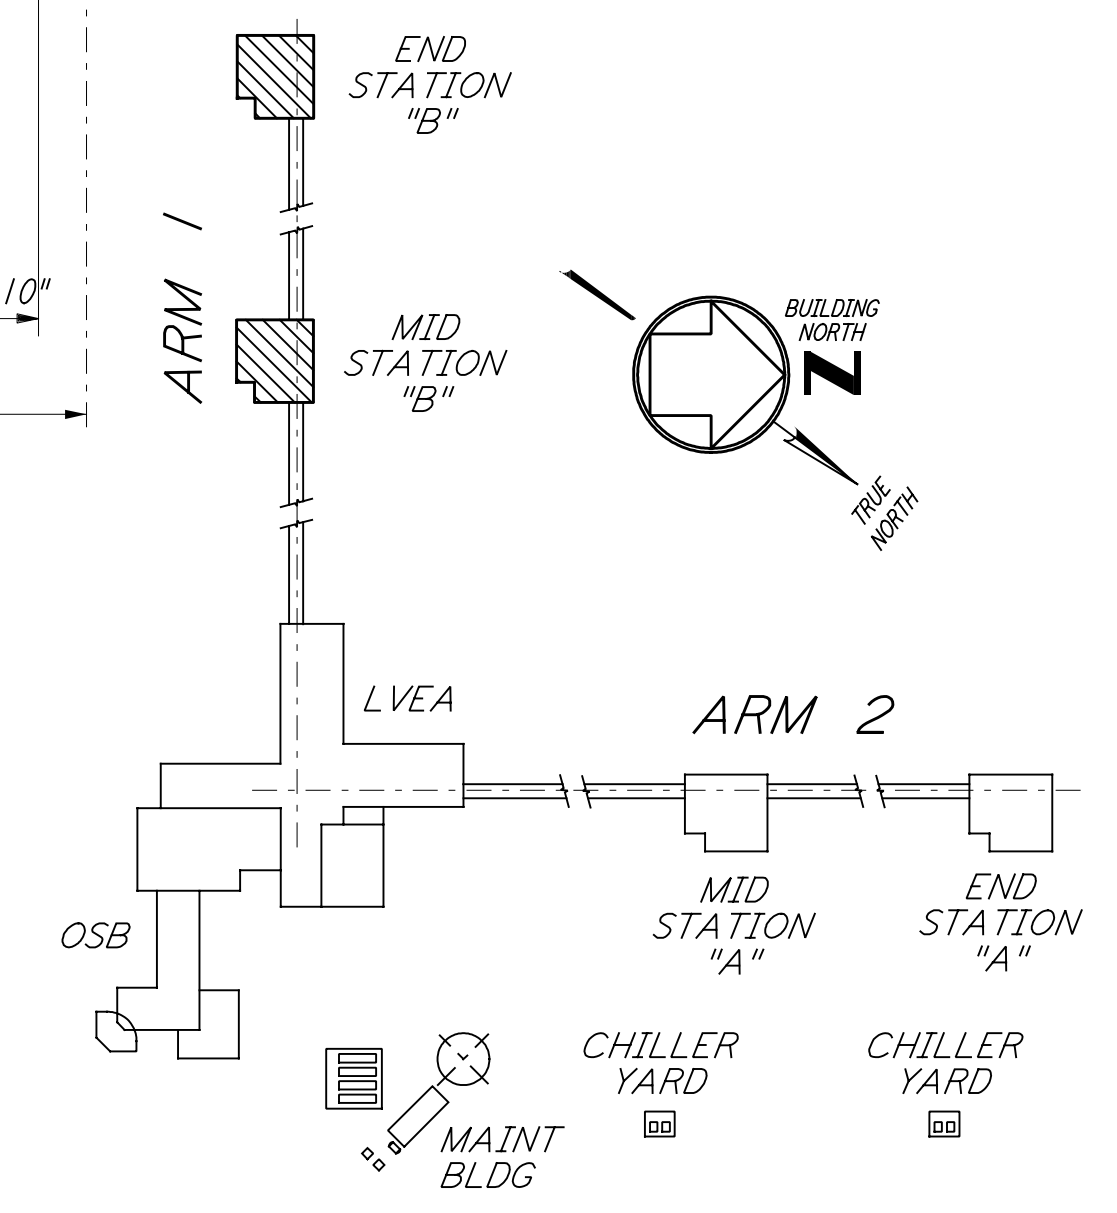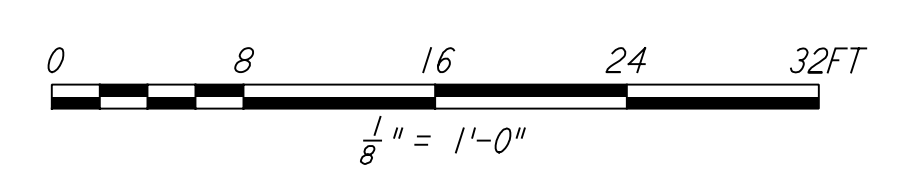

LIGO-D960314-01-0 KEY PLAN

LASER INTERFEROMETER
 GRAVITATIONAL-WAVE OBSERVATORY
 SITE NO. 1 - HANFORD, WASHINGTON

TITLE	STRUCTURAL MID STATION "B" & END STATION "B" FOUNDATION PLANS	SCALE	AS NOTED	PROJECT NUMBER	8094
SHEET NUMBER	WA-S-208	DATE	PP150969	REVISIONS	

This document and the design it covers are the property of PARSONS. They are loaned only with the borrower's expressed written agreement that they will not be reproduced, copied, loaned, exhibited, or used in any other way, except by written consent from PARSONS to the borrower.

REV	NO.	DATE	BY	CHKD	ENGR	PROJ	DESCRIPTION
1	6-15-98	CKT					ISSUED FOR AS-BUILT

ISSUED FOR CONSTRUCTION	DRAWN	MCS	6-24-96
CHECKED	DDM	7-2-96	
ENGINEER	BP	6-28-96	
PROJ	MOW	7-9-96	

AS-BUILT DRAWINGS

PARSONS

100 WEST WALNUT STREET
 PASADENA, CALIFORNIA

LIGO

CALIFORNIA INSTITUTE OF TECHNOLOGY
 MASSACHUSETTS INSTITUTE OF TECHNOLOGY