
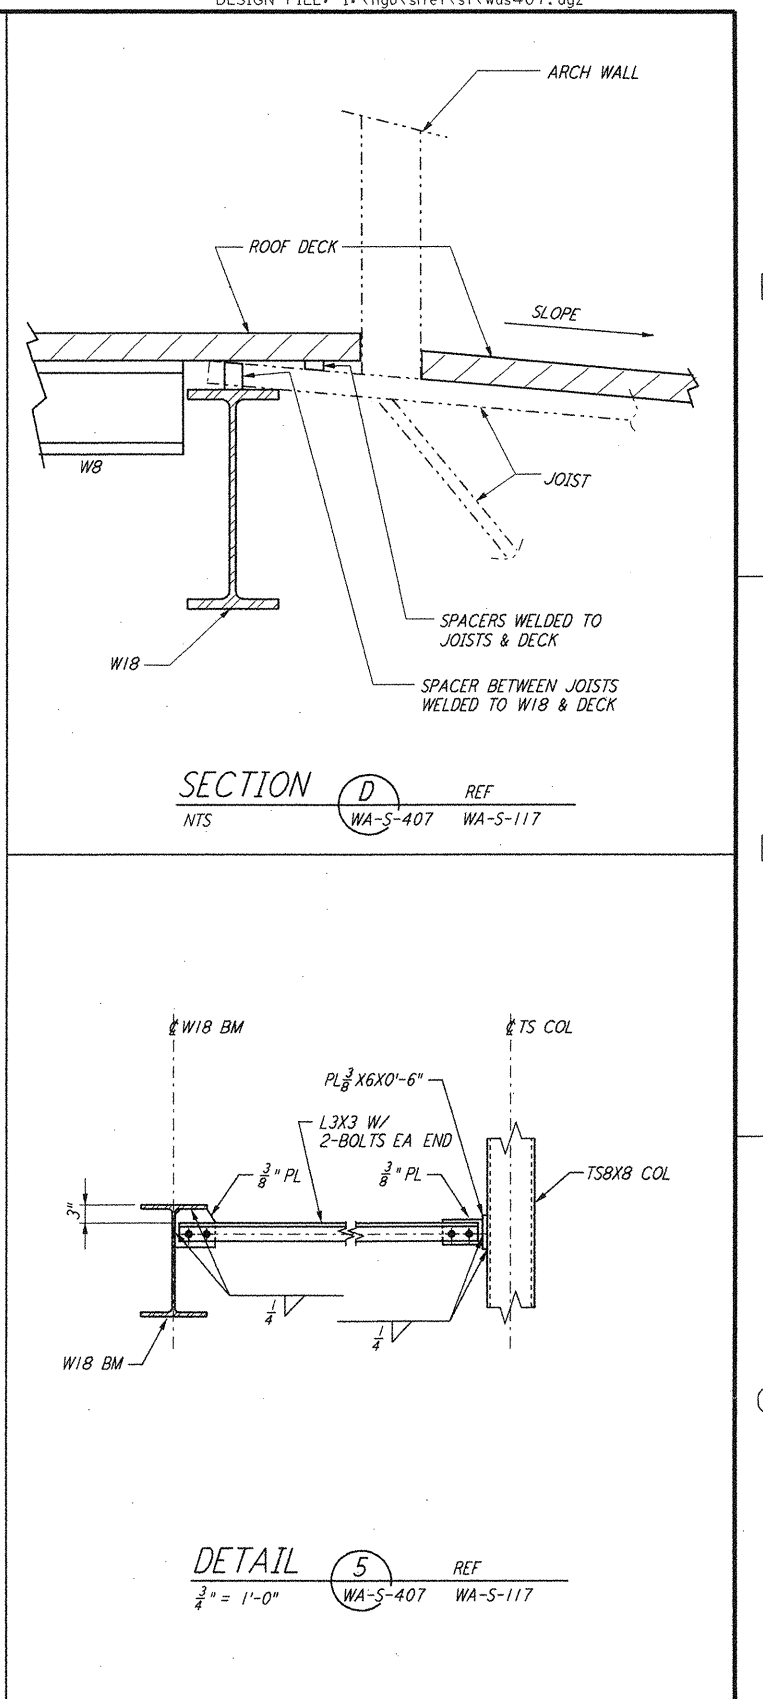
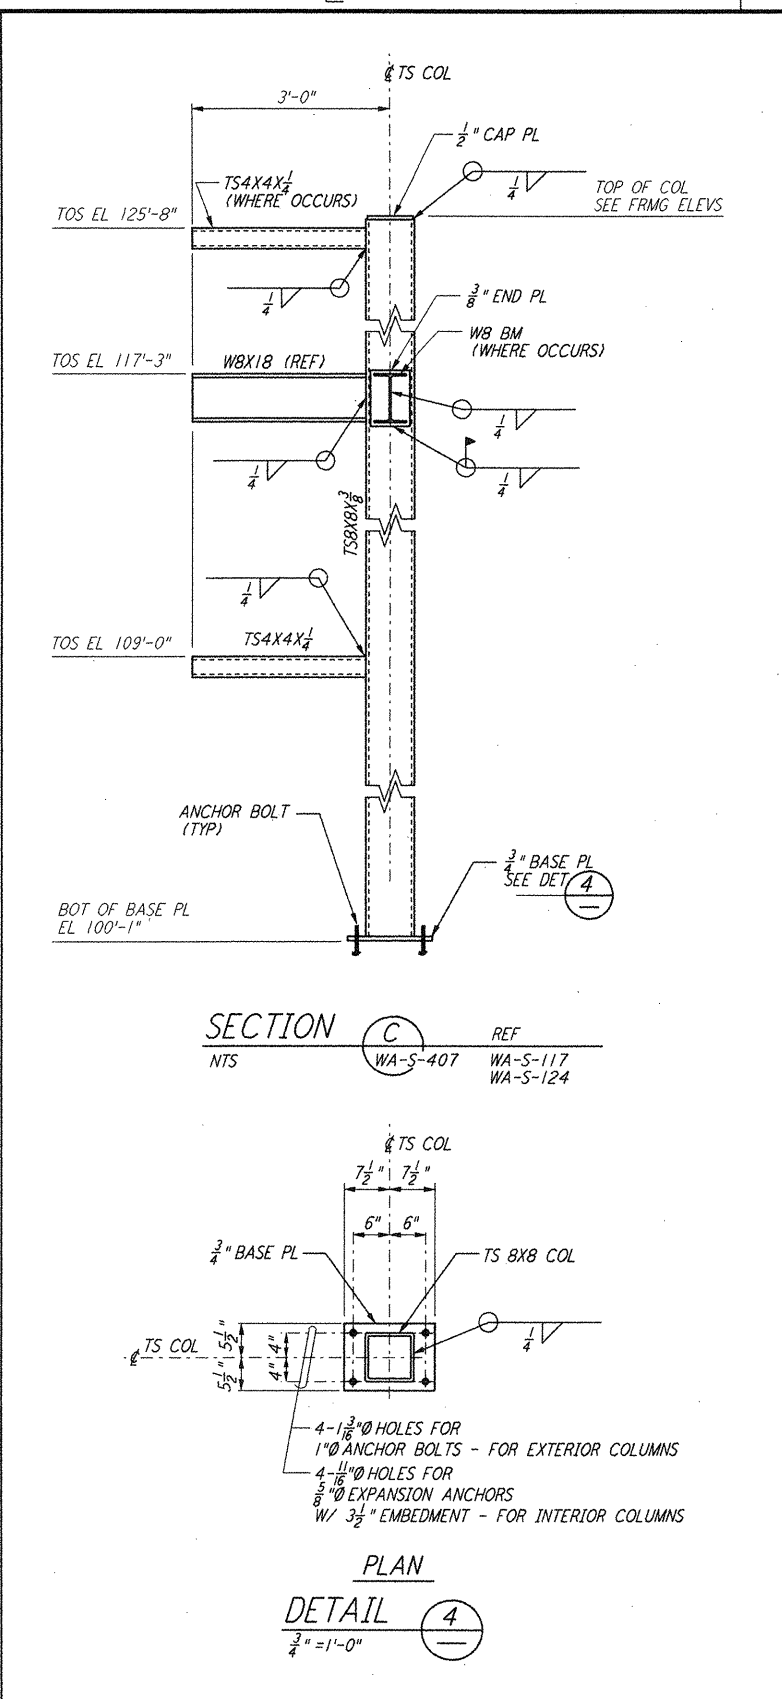
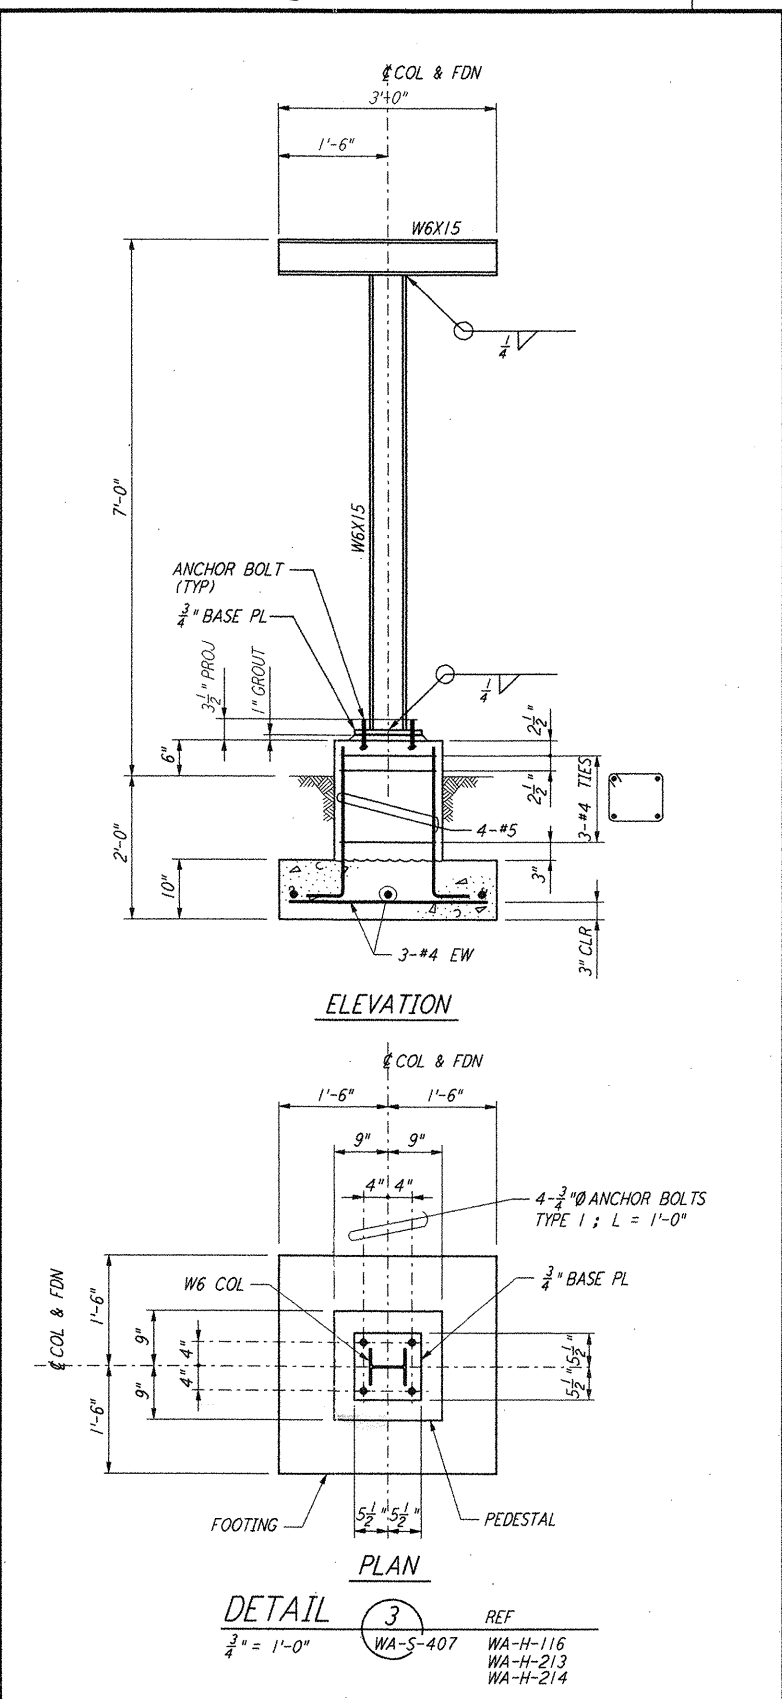
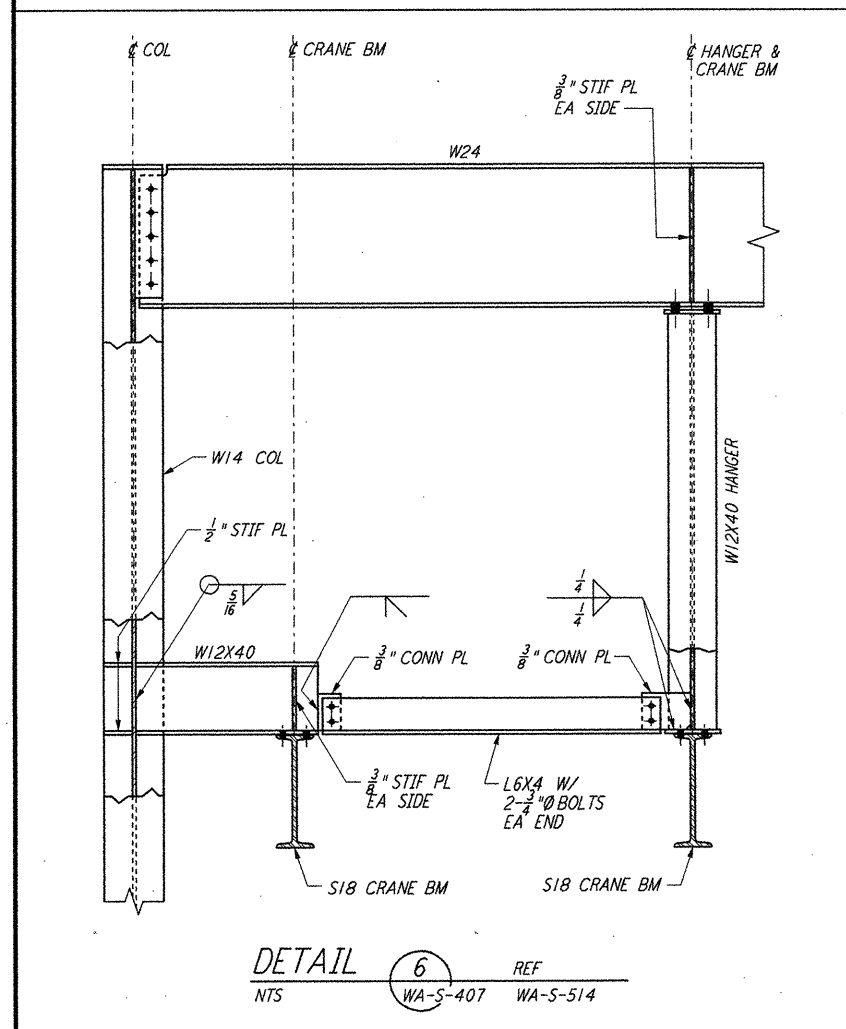
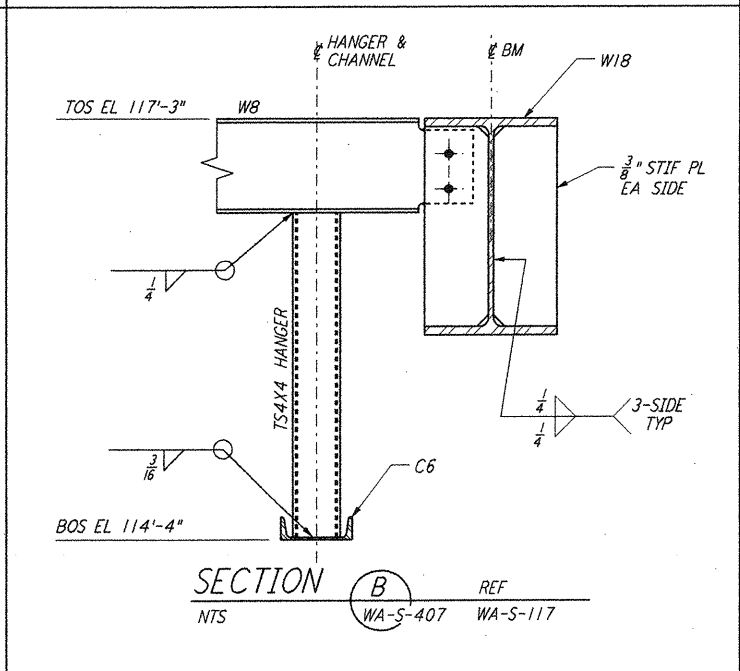
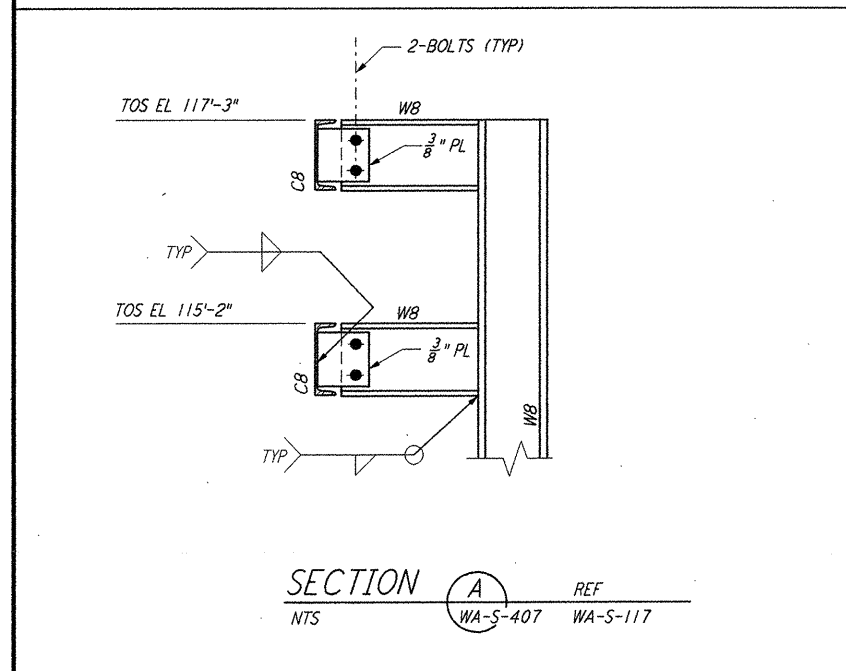
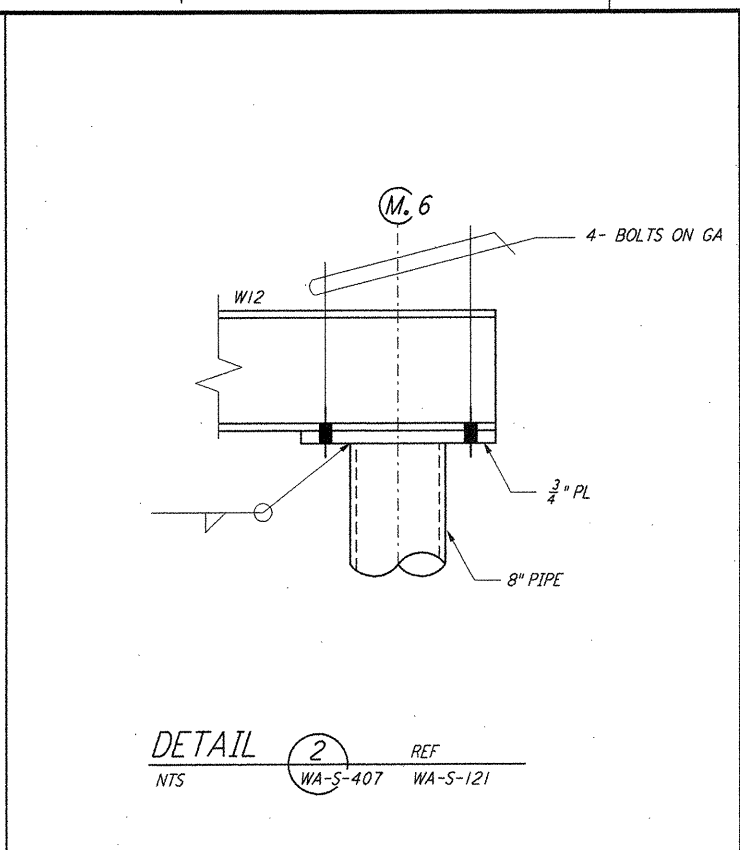


This document and the design it covers are the property of PARSONS. They are loaned only with the borrower's expressed written agreement that they will not be reproduced, copied, loaned, exhibited, or used in any other way, except by written consent from PARSONS to the borrower.

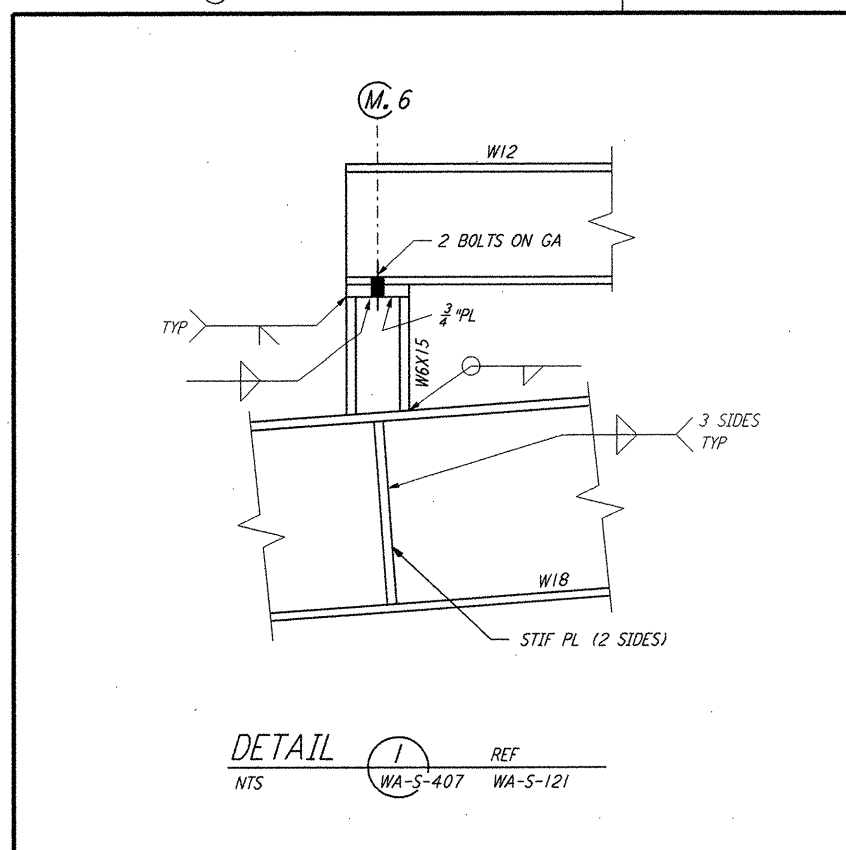

NO.	DATE	BY	CHKD	ENGR	PROJ	DESCRIPTION
1	6-15-98	CKT	MDW	MDW	PP	ISSUED FOR AS-BUILT

ISSUED FOR CONSTRUCTION			
DRAWN	MCS	6-24-98	
CHECKED	DDM	7-2-98	
ENGINEER	BP	6-28-98	
PROJ	MDW	7-9-98	

**AS-BUILT DRAWINGS**

100 WEST WALNUT STREET  
 PASADENA, CALIFORNIA

**PARSONS**

**LIGO**  
 CALIFORNIA INSTITUTE OF TECHNOLOGY  
 MASSACHUSETTS INSTITUTE OF TECHNOLOGY

**LIGO-D960321-01-O**

LASER INTERFEROMETER  
 GRAVITATIONAL-WAVE OBSERVATORY  
 SITE NO. 1 - HANFORD, WASHINGTON

TITLE	SCALE	CONTRACT NUMBER	PROJECT NUMBER
STRUCTURAL STEEL SECTIONS & DETAILS	AS NOTED	PP150969	8094
SHEET NUMBER		REVISIONS	
<b>WA-S-407</b>			

5 JUL 06 16:30:38 1998 C:\PLT\GDS\S3\98B2\DF 52885 R\Y98B2\407.dgz