




This document and the design it covers are the property of PARSONS. They are loaned only with the borrower's expressed written agreement that they will not be reproduced, copied, loaned, exhibited, or used in any other way, except by written consent from PARSONS to the borrower.

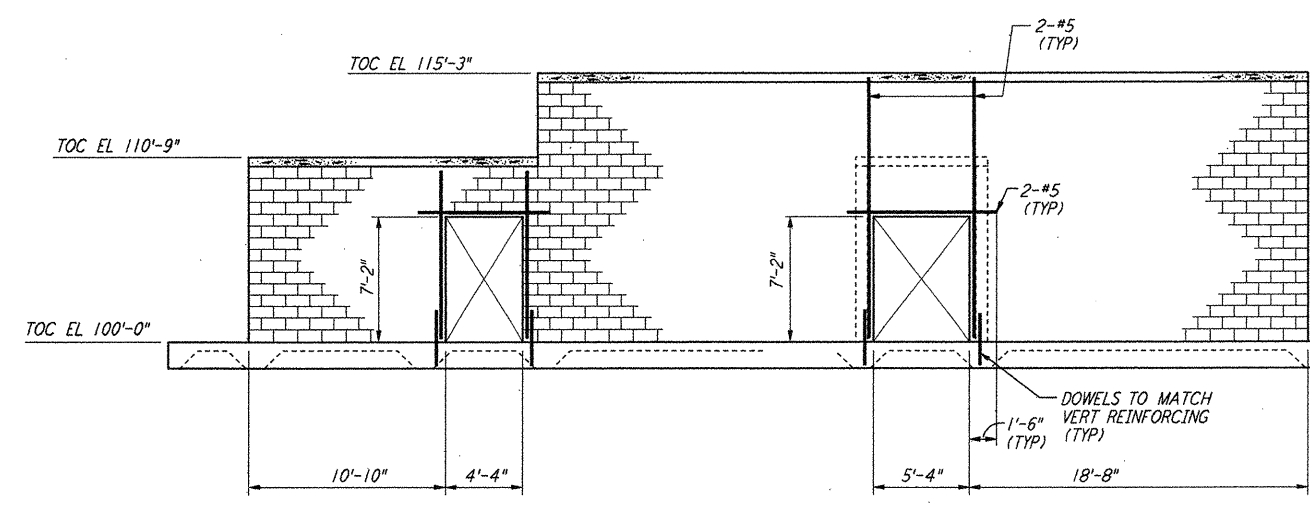


**ELEVATION A** REF  
 $\frac{3}{8}'' = 1'-0''$   
 WA-S-503 WA-S-502

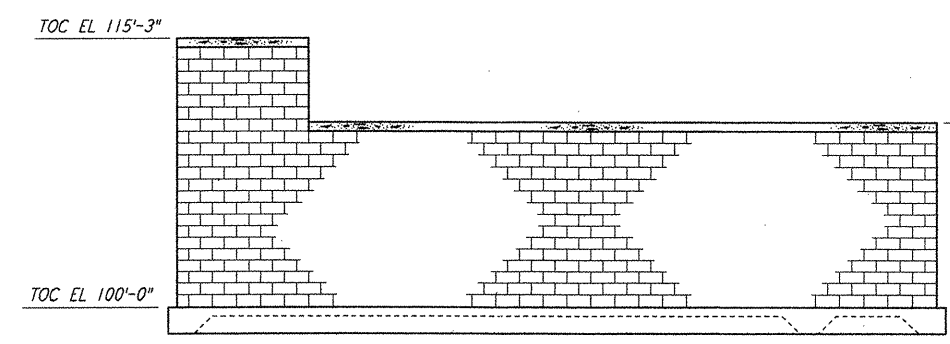


**ELEVATION B** REF  
 $\frac{3}{8}'' = 1'-0''$   
 WA-S-503 WA-S-502

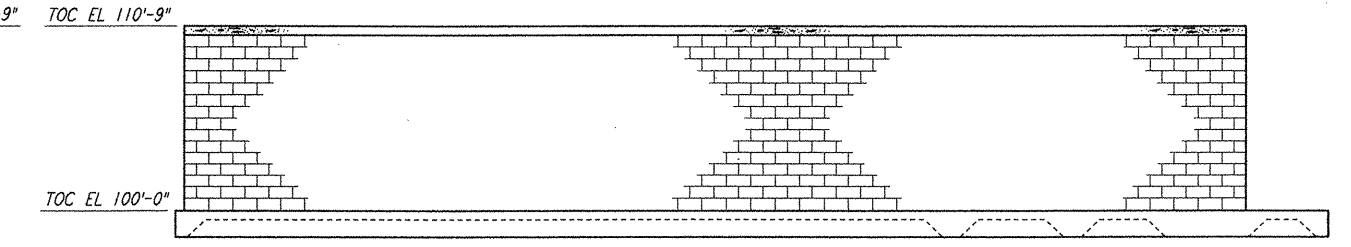


**ELEVATION C** REF  
 $\frac{3}{8}'' = 1'-0''$   
 WA-S-503 WA-S-502

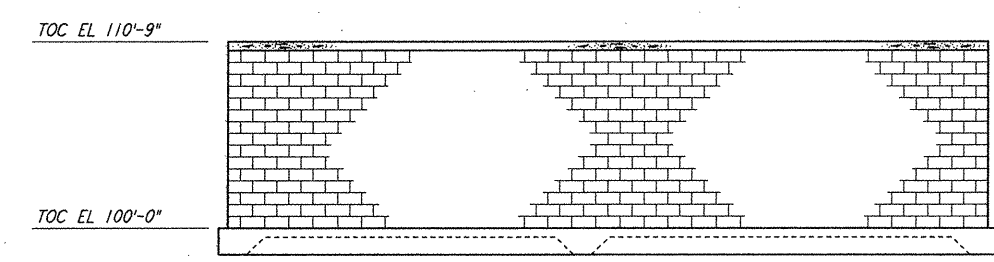


**ELEVATION D** REF  
 $\frac{3}{8}'' = 1'-0''$   
 WA-S-503 WA-S-502

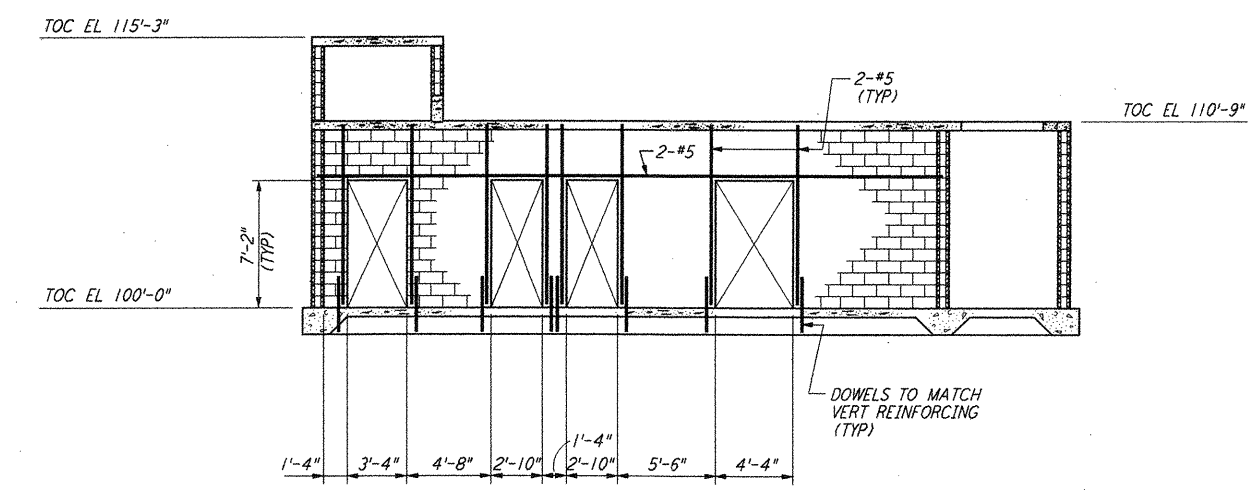


**SECTION E** REF  
 $\frac{3}{8}'' = 1'-0''$   
 WA-S-503 WA-S-502

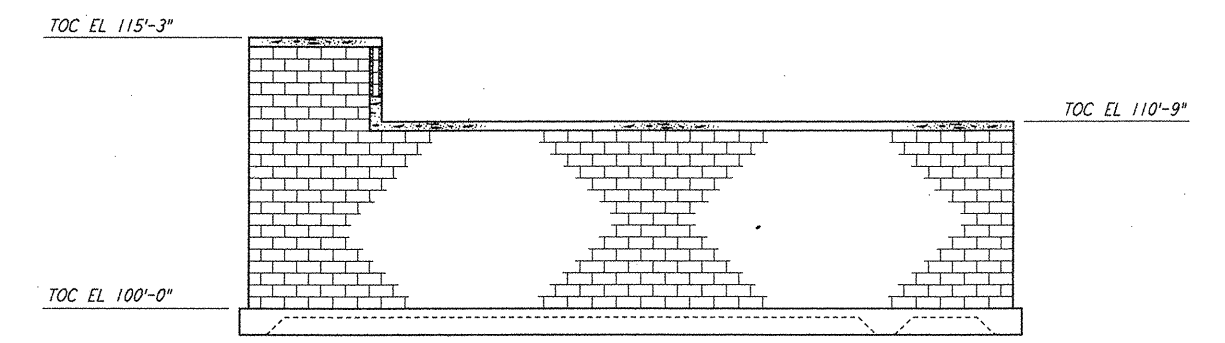


**SECTION F** REF  
 $\frac{3}{8}'' = 1'-0''$   
 WA-S-503 WA-S-502

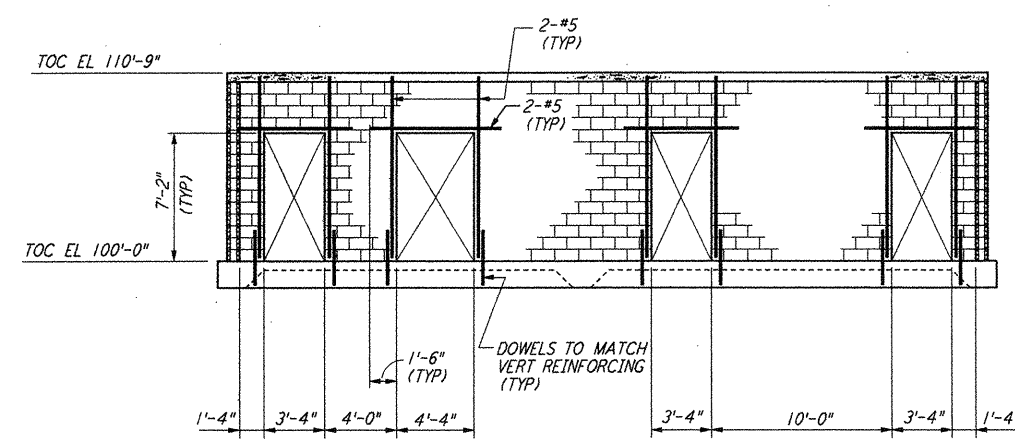


**SECTION G** REF  
 $\frac{3}{8}'' = 1'-0''$   
 WA-S-503 WA-S-502

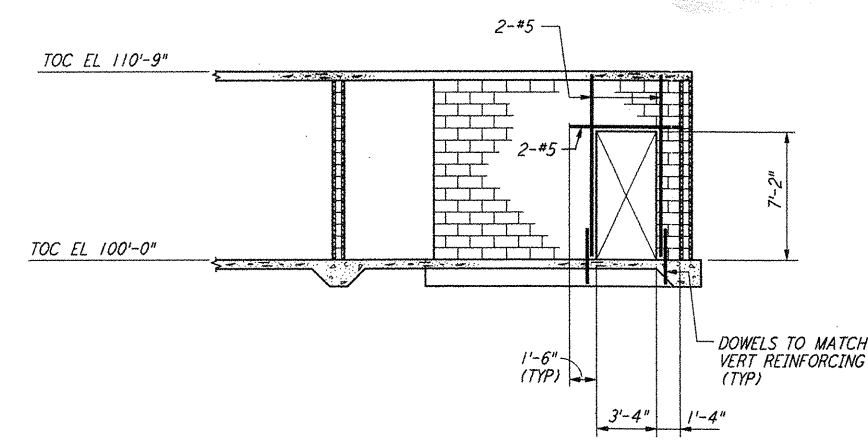


**SECTION H** REF  
 $\frac{3}{8}'' = 1'-0''$   
 WA-S-503 WA-S-502

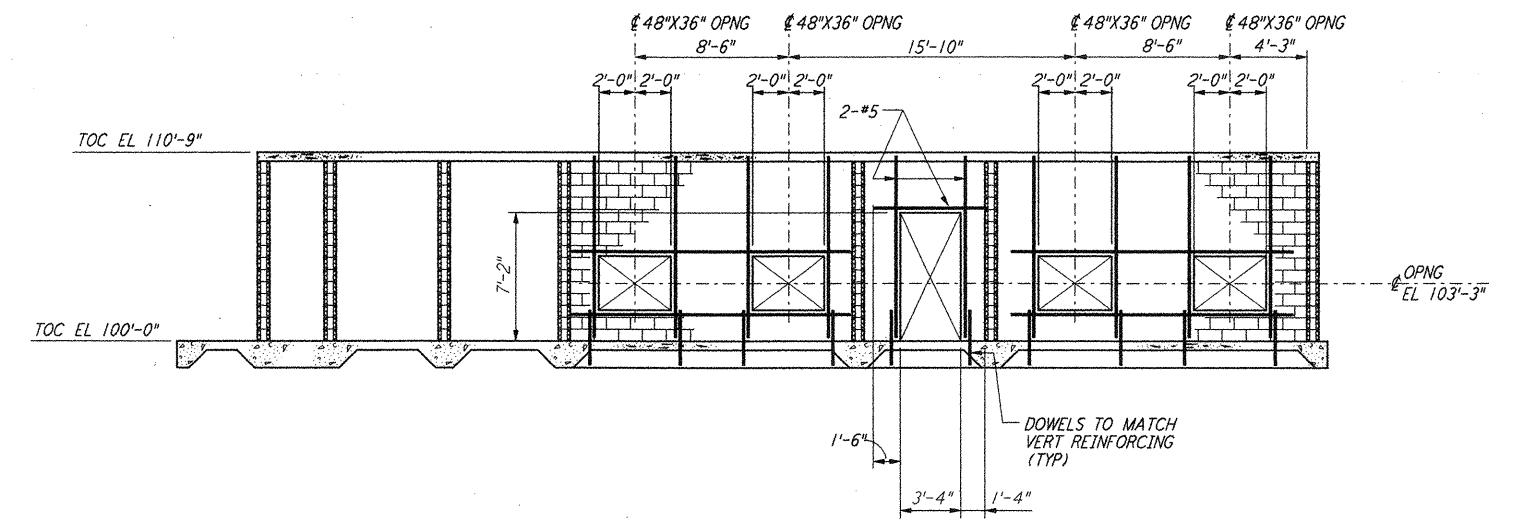

**SECTION J** REF  
 $\frac{3}{8}'' = 1'-0''$   
 WA-S-503 WA-S-502

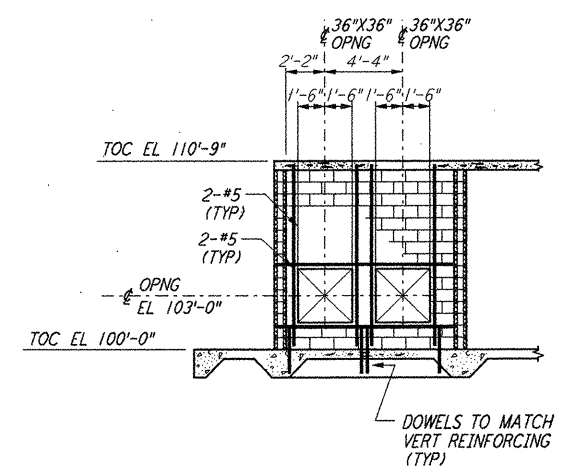


**SECTION K** REF  
 $\frac{3}{8}'' = 1'-0''$   
 WA-S-503 WA-S-502

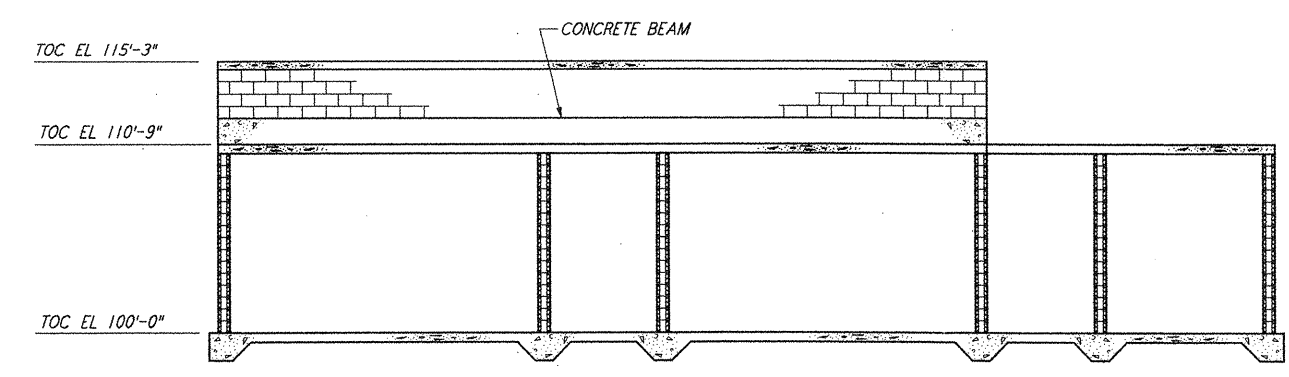

**SECTION L** REF  
 $\frac{3}{8}'' = 1'-0''$   
 WA-S-503 WA-S-502

**NOTES:**  
 1. FOR GENERAL NOTES, ABBREVIATIONS & SYMBOLS SEE DRAWING WA-S-001.

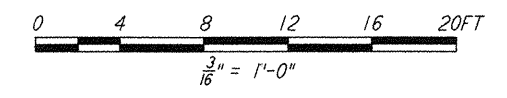

NO.	DATE	BY	CHKD	ENGR	PROJ	DESCRIPTION
1	6-15-98	CTK	BP	MDW	MDW	ISSUED FOR AS-BUILT

ISSUED FOR CONSTRUCTION			
DRAWN	MCS	6-24-96	
CHECKED	DDM	7-2-96	
ENGINEER	BP	6-28-96	
PROJ	MDW	7-9-96	

**AS-BUILT DRAWINGS**

**PARSONS**  
 100 WEST WALNUT STREET  
 PASADENA, CALIFORNIA

**LIGO**  
 CALIFORNIA INSTITUTE OF TECHNOLOGY  
 MASSACHUSETTS INSTITUTE OF TECHNOLOGY

**LIGO-D960324-01-0**  
 LASER INTERFEROMETER  
 GRAVITATIONAL-WAVE OBSERVATORY  
 SITE NO. 1 - HANFORD, WASHINGTON

TITLE: **STRUCTURAL CORNER STATION AIR HANDLING UNIT ENCLOSURE ELEVS & SECTS**

SCALE: AS NOTED  
 CONTRACT NUMBER: PPI50969  
 PROJECT NUMBER: 8094

SHEET NUMBER: **WA-S-503**