



**NOTES:**  
 1. FOR LEGEND, ABBREVIATIONS AND GENERAL NOTES SEE SHEETS WA-H-001 AND WA-H-002.  
 2. SEE INPUT/OUTPUT SUMMARY SHEETS, SHEETS WA-H-141 AND WA-H-142 FOR ALARMS AND EQUIPMENT CONTROL.

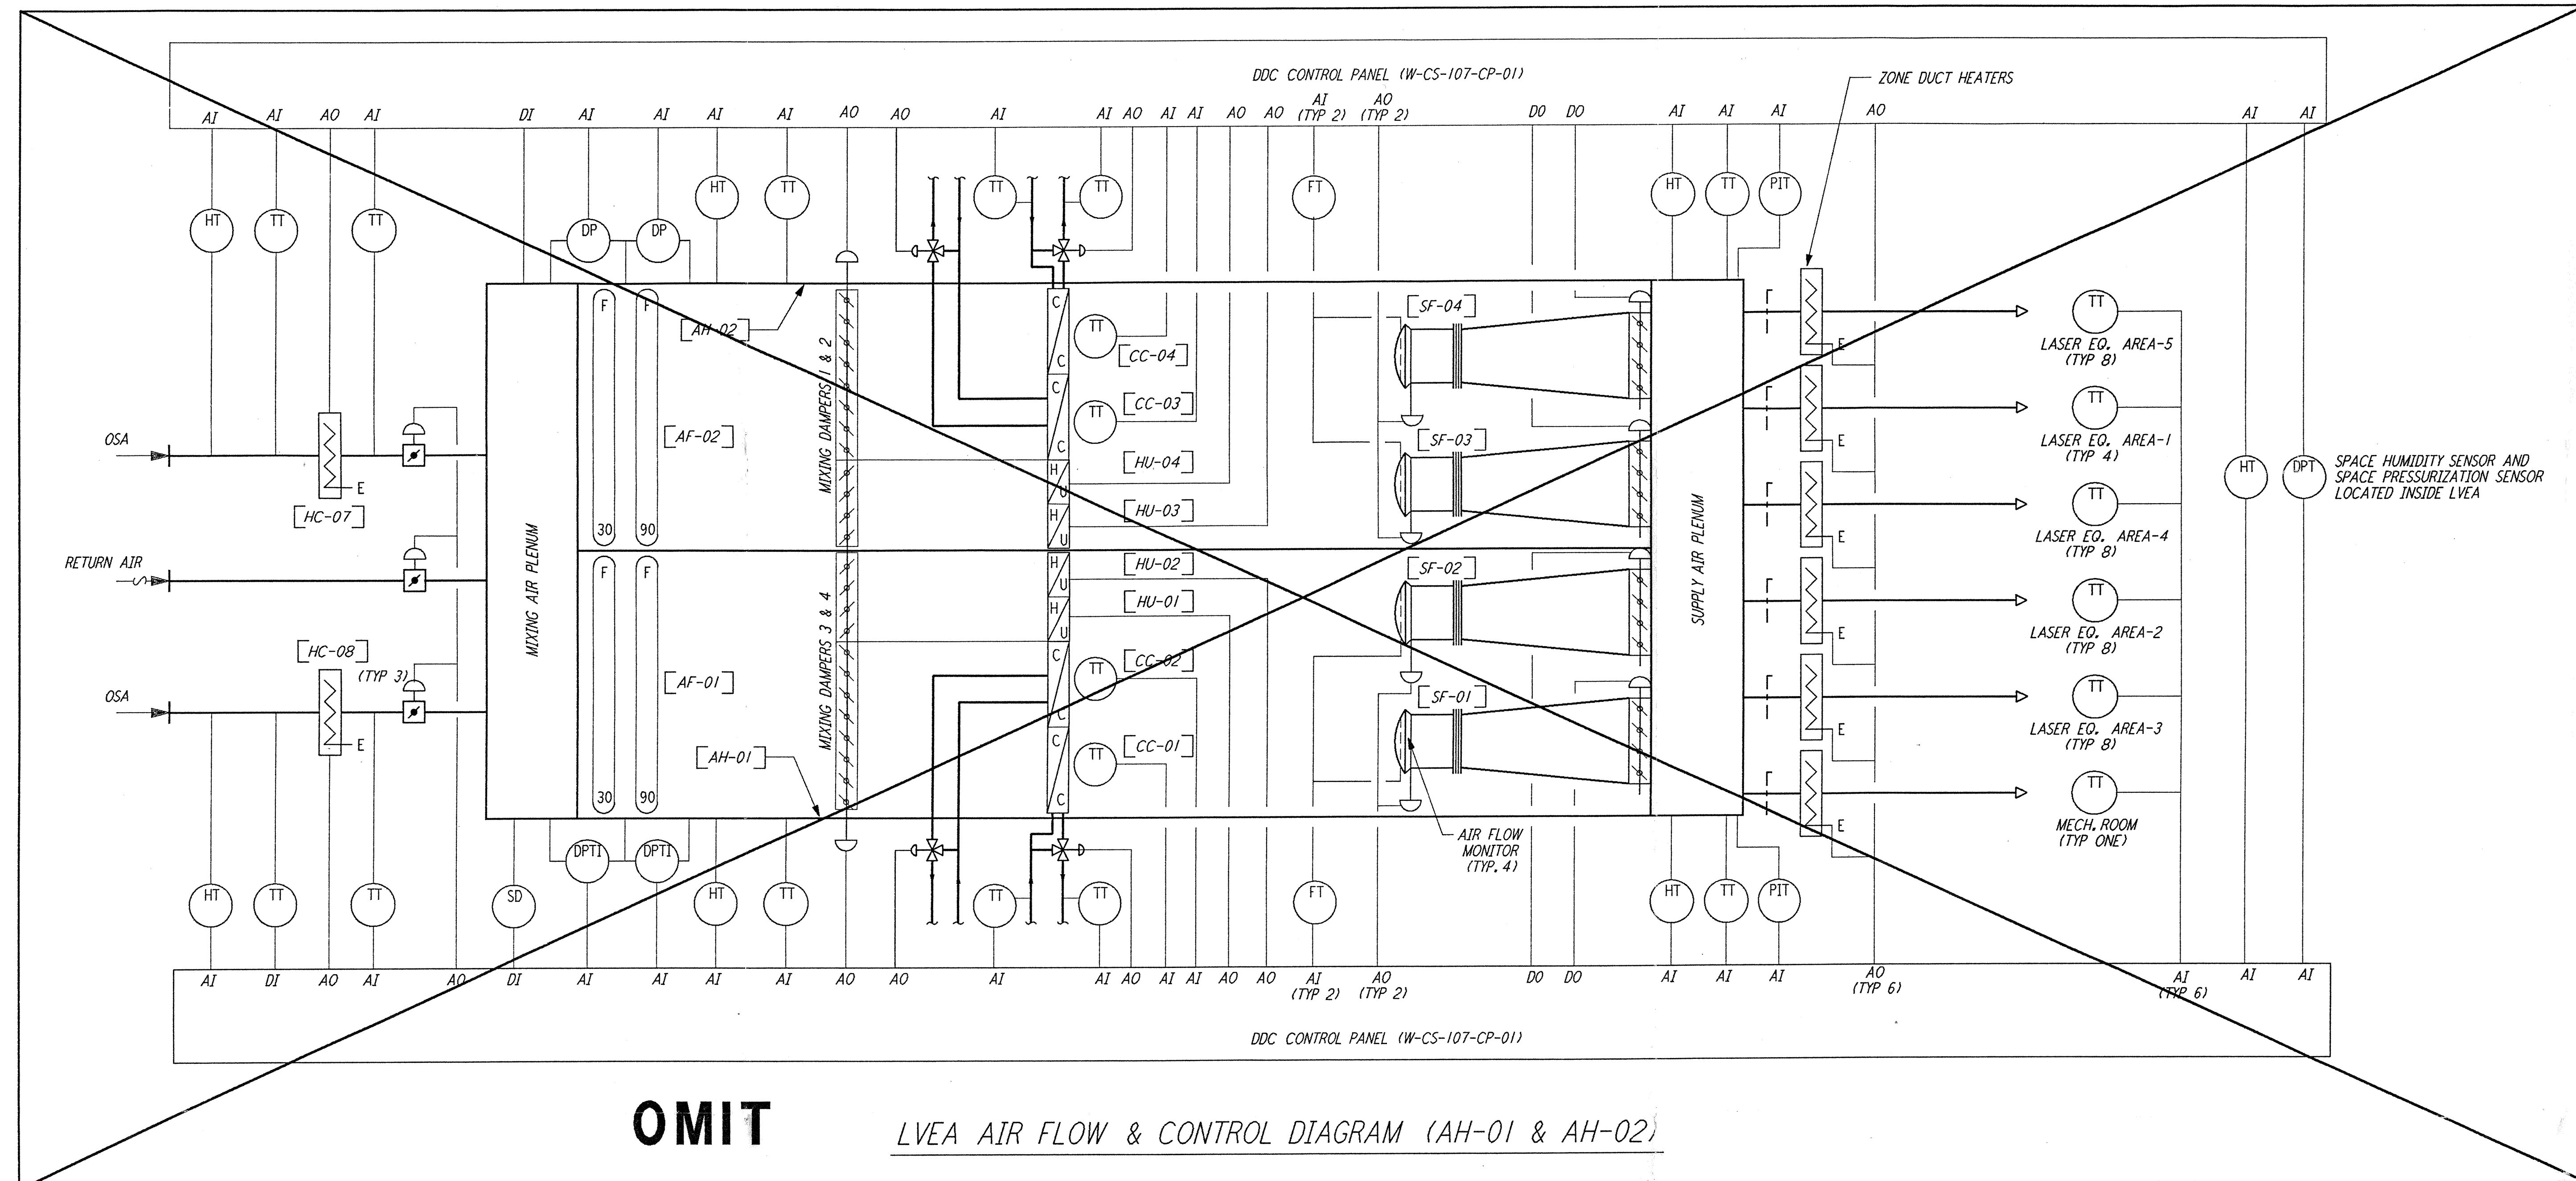

**OMIT** LVEA AIR FLOW & CONTROL DIAGRAM (AH-01 & AH-02)

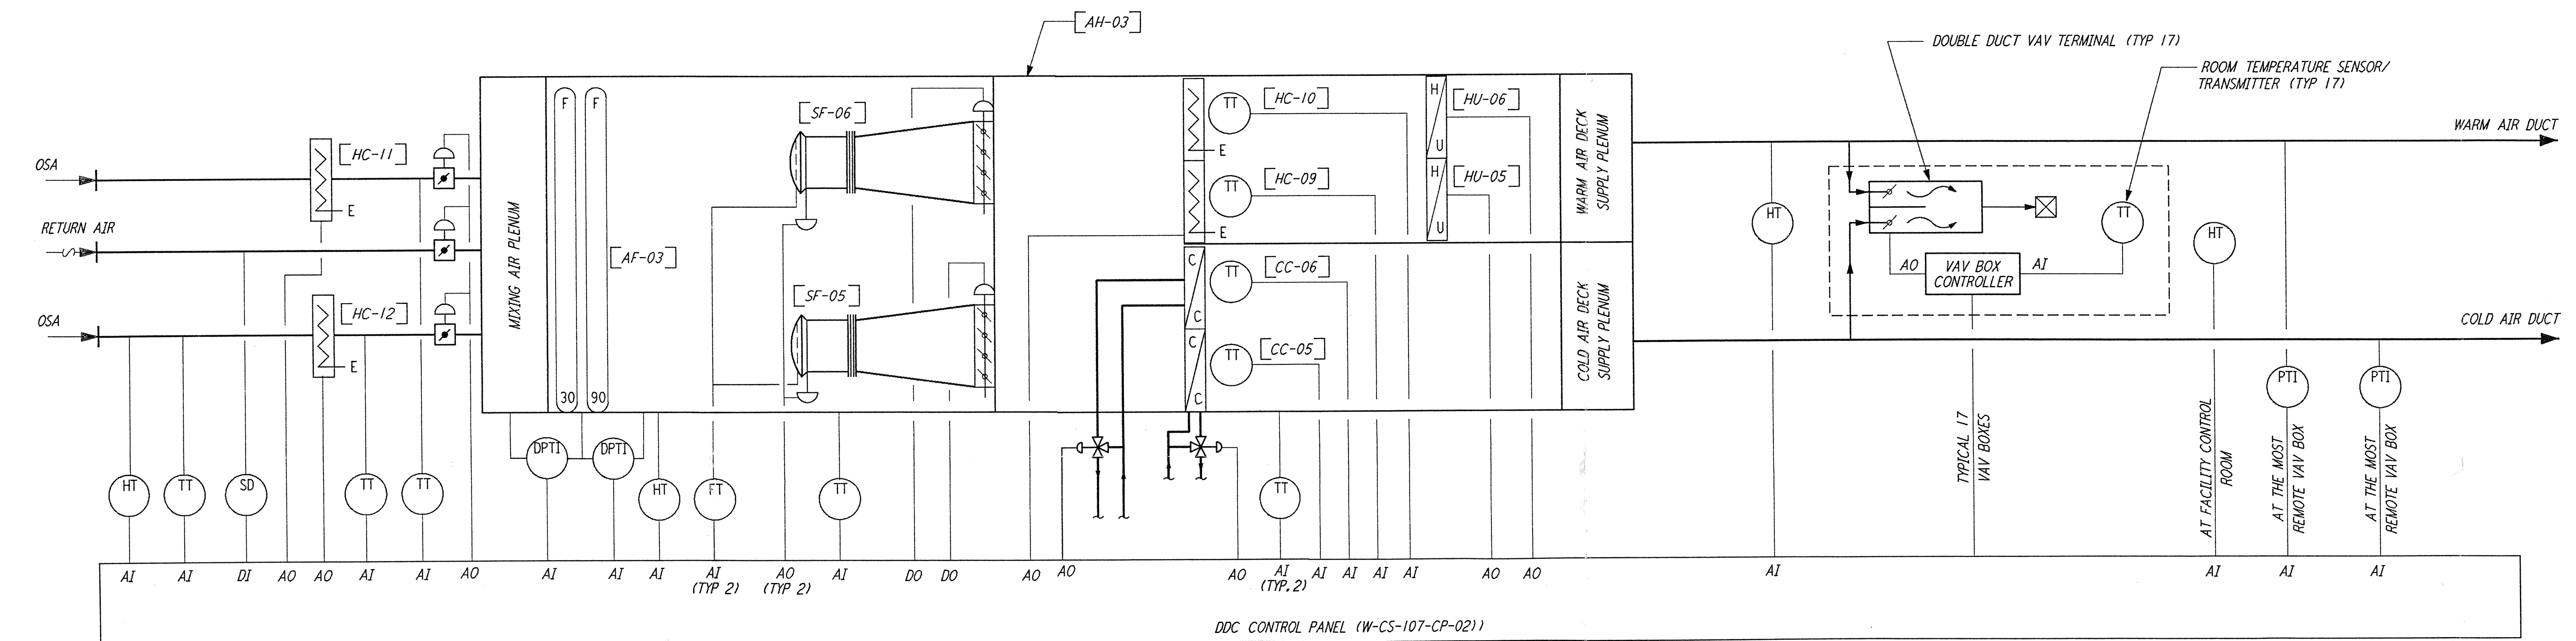

OSB AIR FLOW & CONTROL DAIGRAM (AH-03)

not be reproduced, copied, loaned, exhibited, or used in any other way, except by written consent from PARSONS to the borrower.

This document and the design it covers are the property of PARSONS. They are loaned only with the borrower's expressed written agreement that they will

NO.	DATE	BY	CHKD	ENGR	PROJ.	DESCRIPTION
B	4-19-96	CLP	ME	AA		FINAL DESIGN REVIEW & BID
A	10-31-95	CLP	ME	AA	TDM	PRELIMINARY DESIGN REVIEW

DRAWN	CLP
CHECKED	
ENGINEER	
PROJ	

**PARSONS**  
 100 WEST WALNUT STREET  
 PASADENA, CALIFORNIA

**LIGO**  
 CALIFORNIA INSTITUTE OF TECHNOLOGY  
 MASSACHUSETTS INSTITUTE OF TECHNOLOGY

LASER INTERFEROMETER  
 GRAVITATIONAL-WAVE OBSERVATORY  
 SITE NO. 1 - HANFORD, WASHINGTON

TITLE	SCALE	CONTRACT NUMBER	PROJECT NUMBER
HVAC CORNER STATION AIR FLOW DIAGRAMS SHEET 1	NONE	PP150969	8094
SHEET NUMBER		REVISIONS	
WA-H-122		B	