



NOTES:


1. FOR LEGEND, ABBREVIATIONS AND GENERAL NOTES SEE SHEET WA-H-001 AND WA-H-002.
2. SEE INPUT/OUTPUT SUMMARY SHEETS, SHEETS WA-H-141 AND WA-H-142 FOR ALARMS AND EQUIPMENT CONTROL.

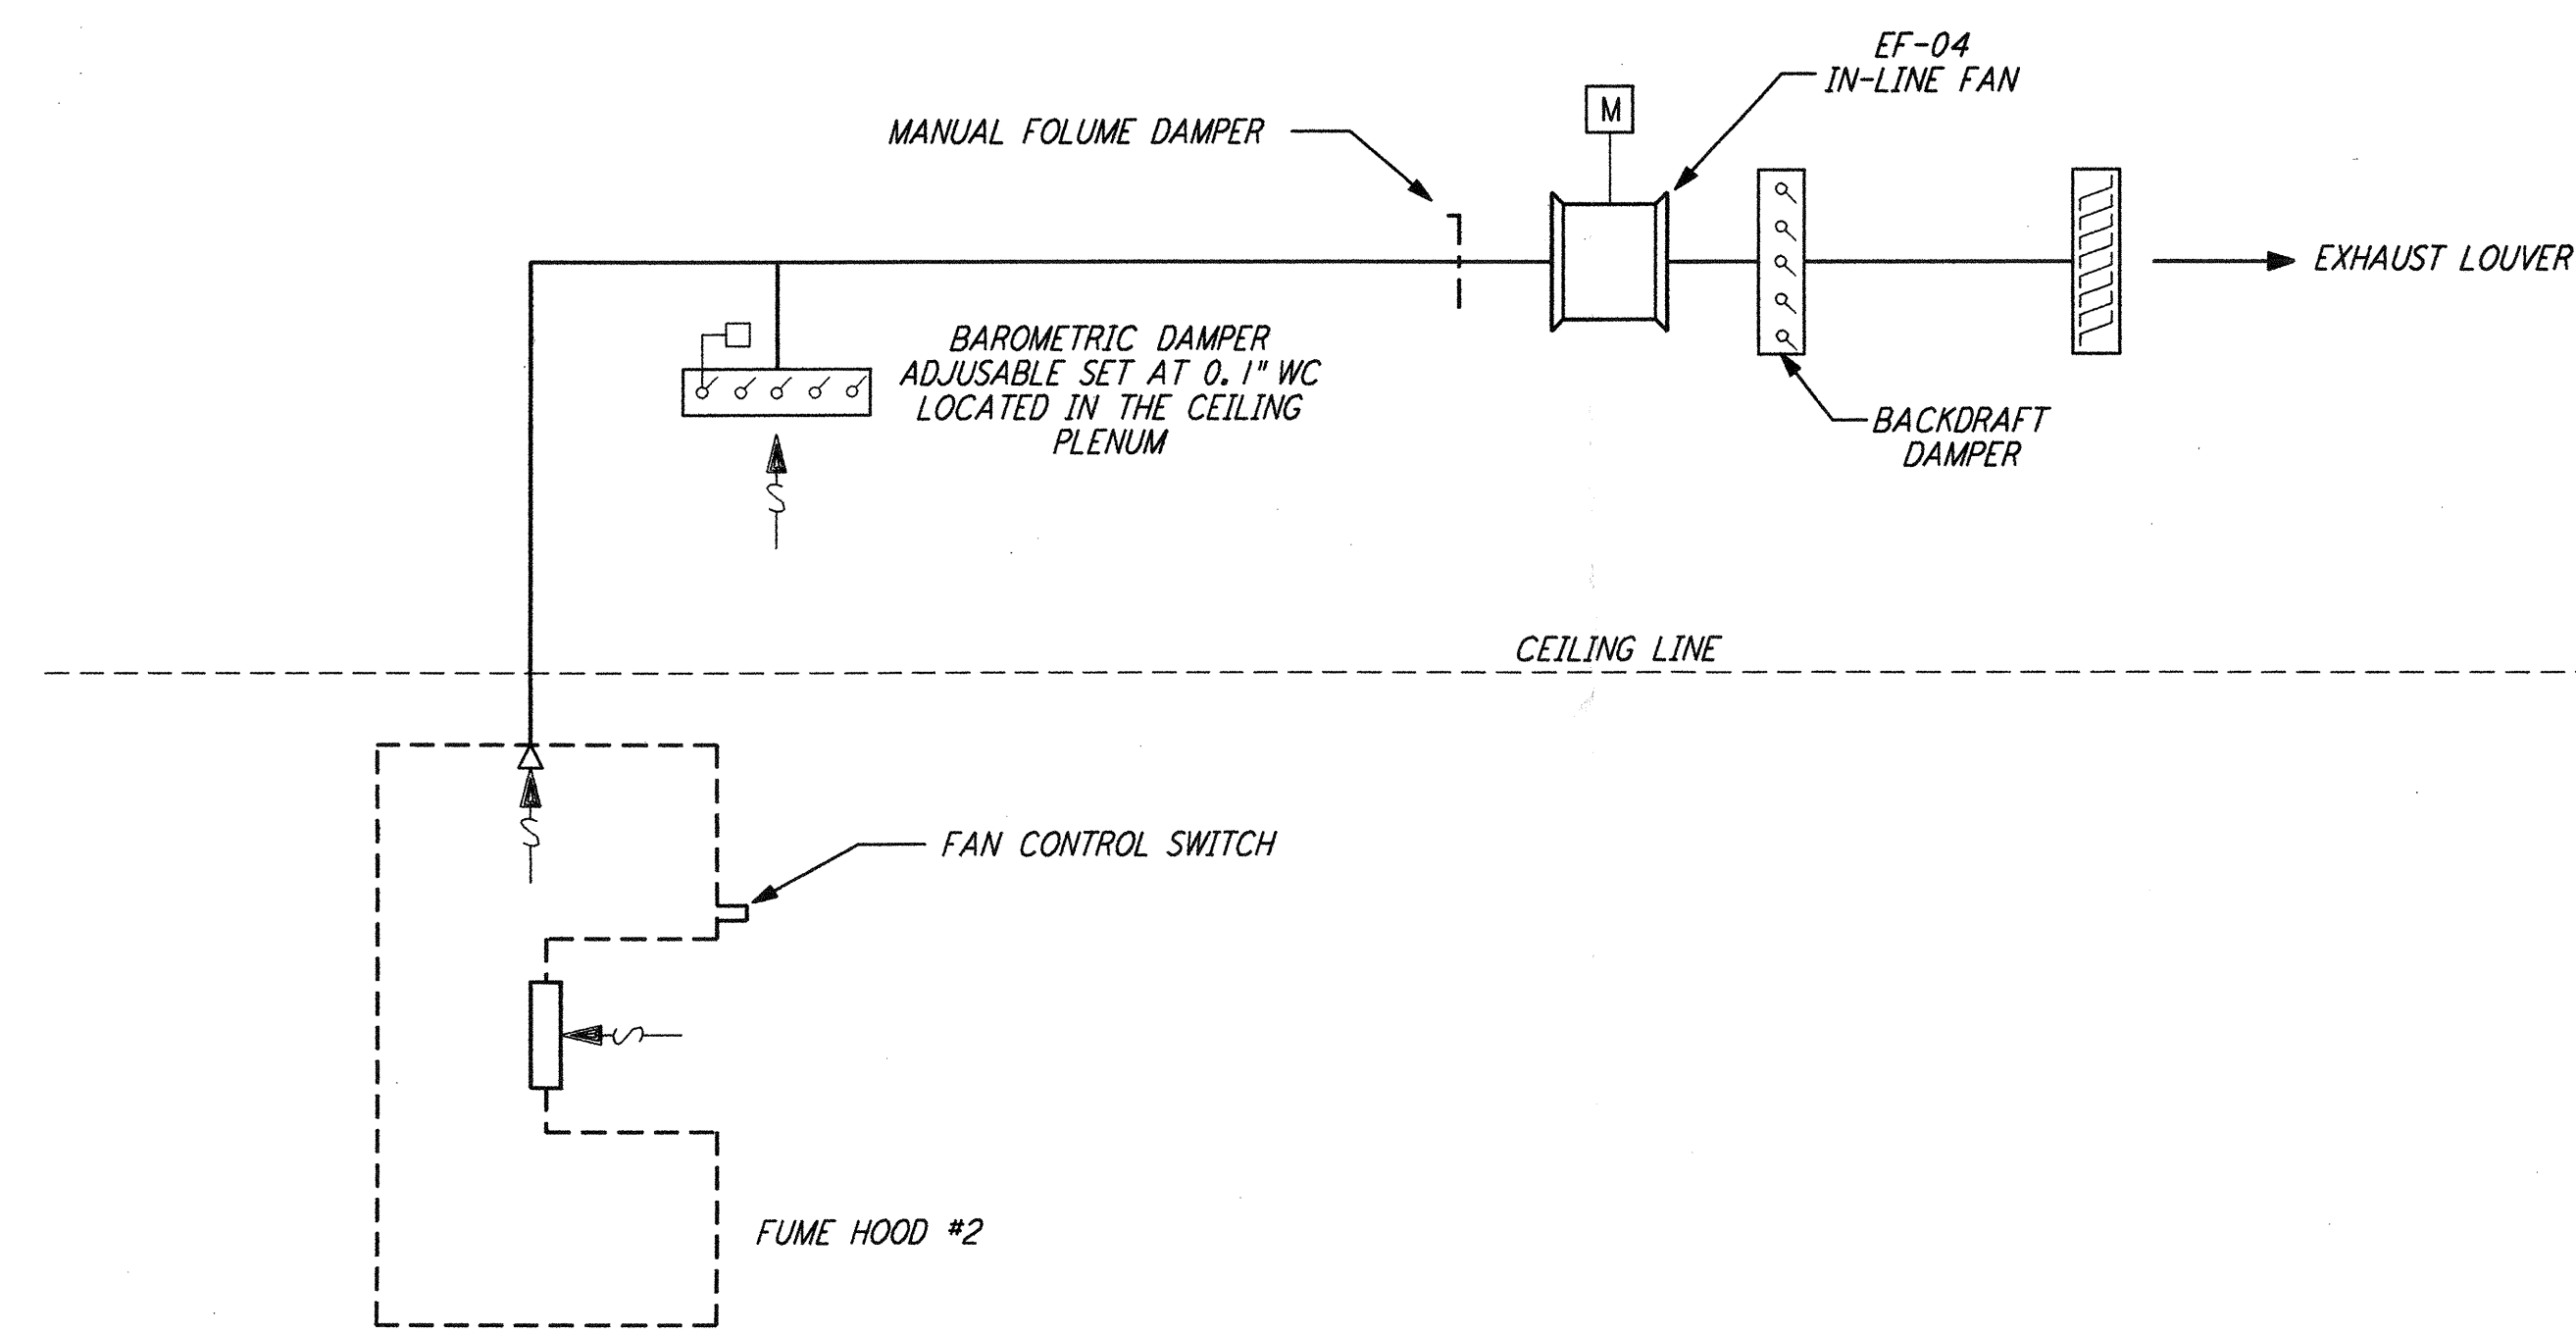

VACUUM PREPARATION FUME HOOD CONTROL DIAGRAM

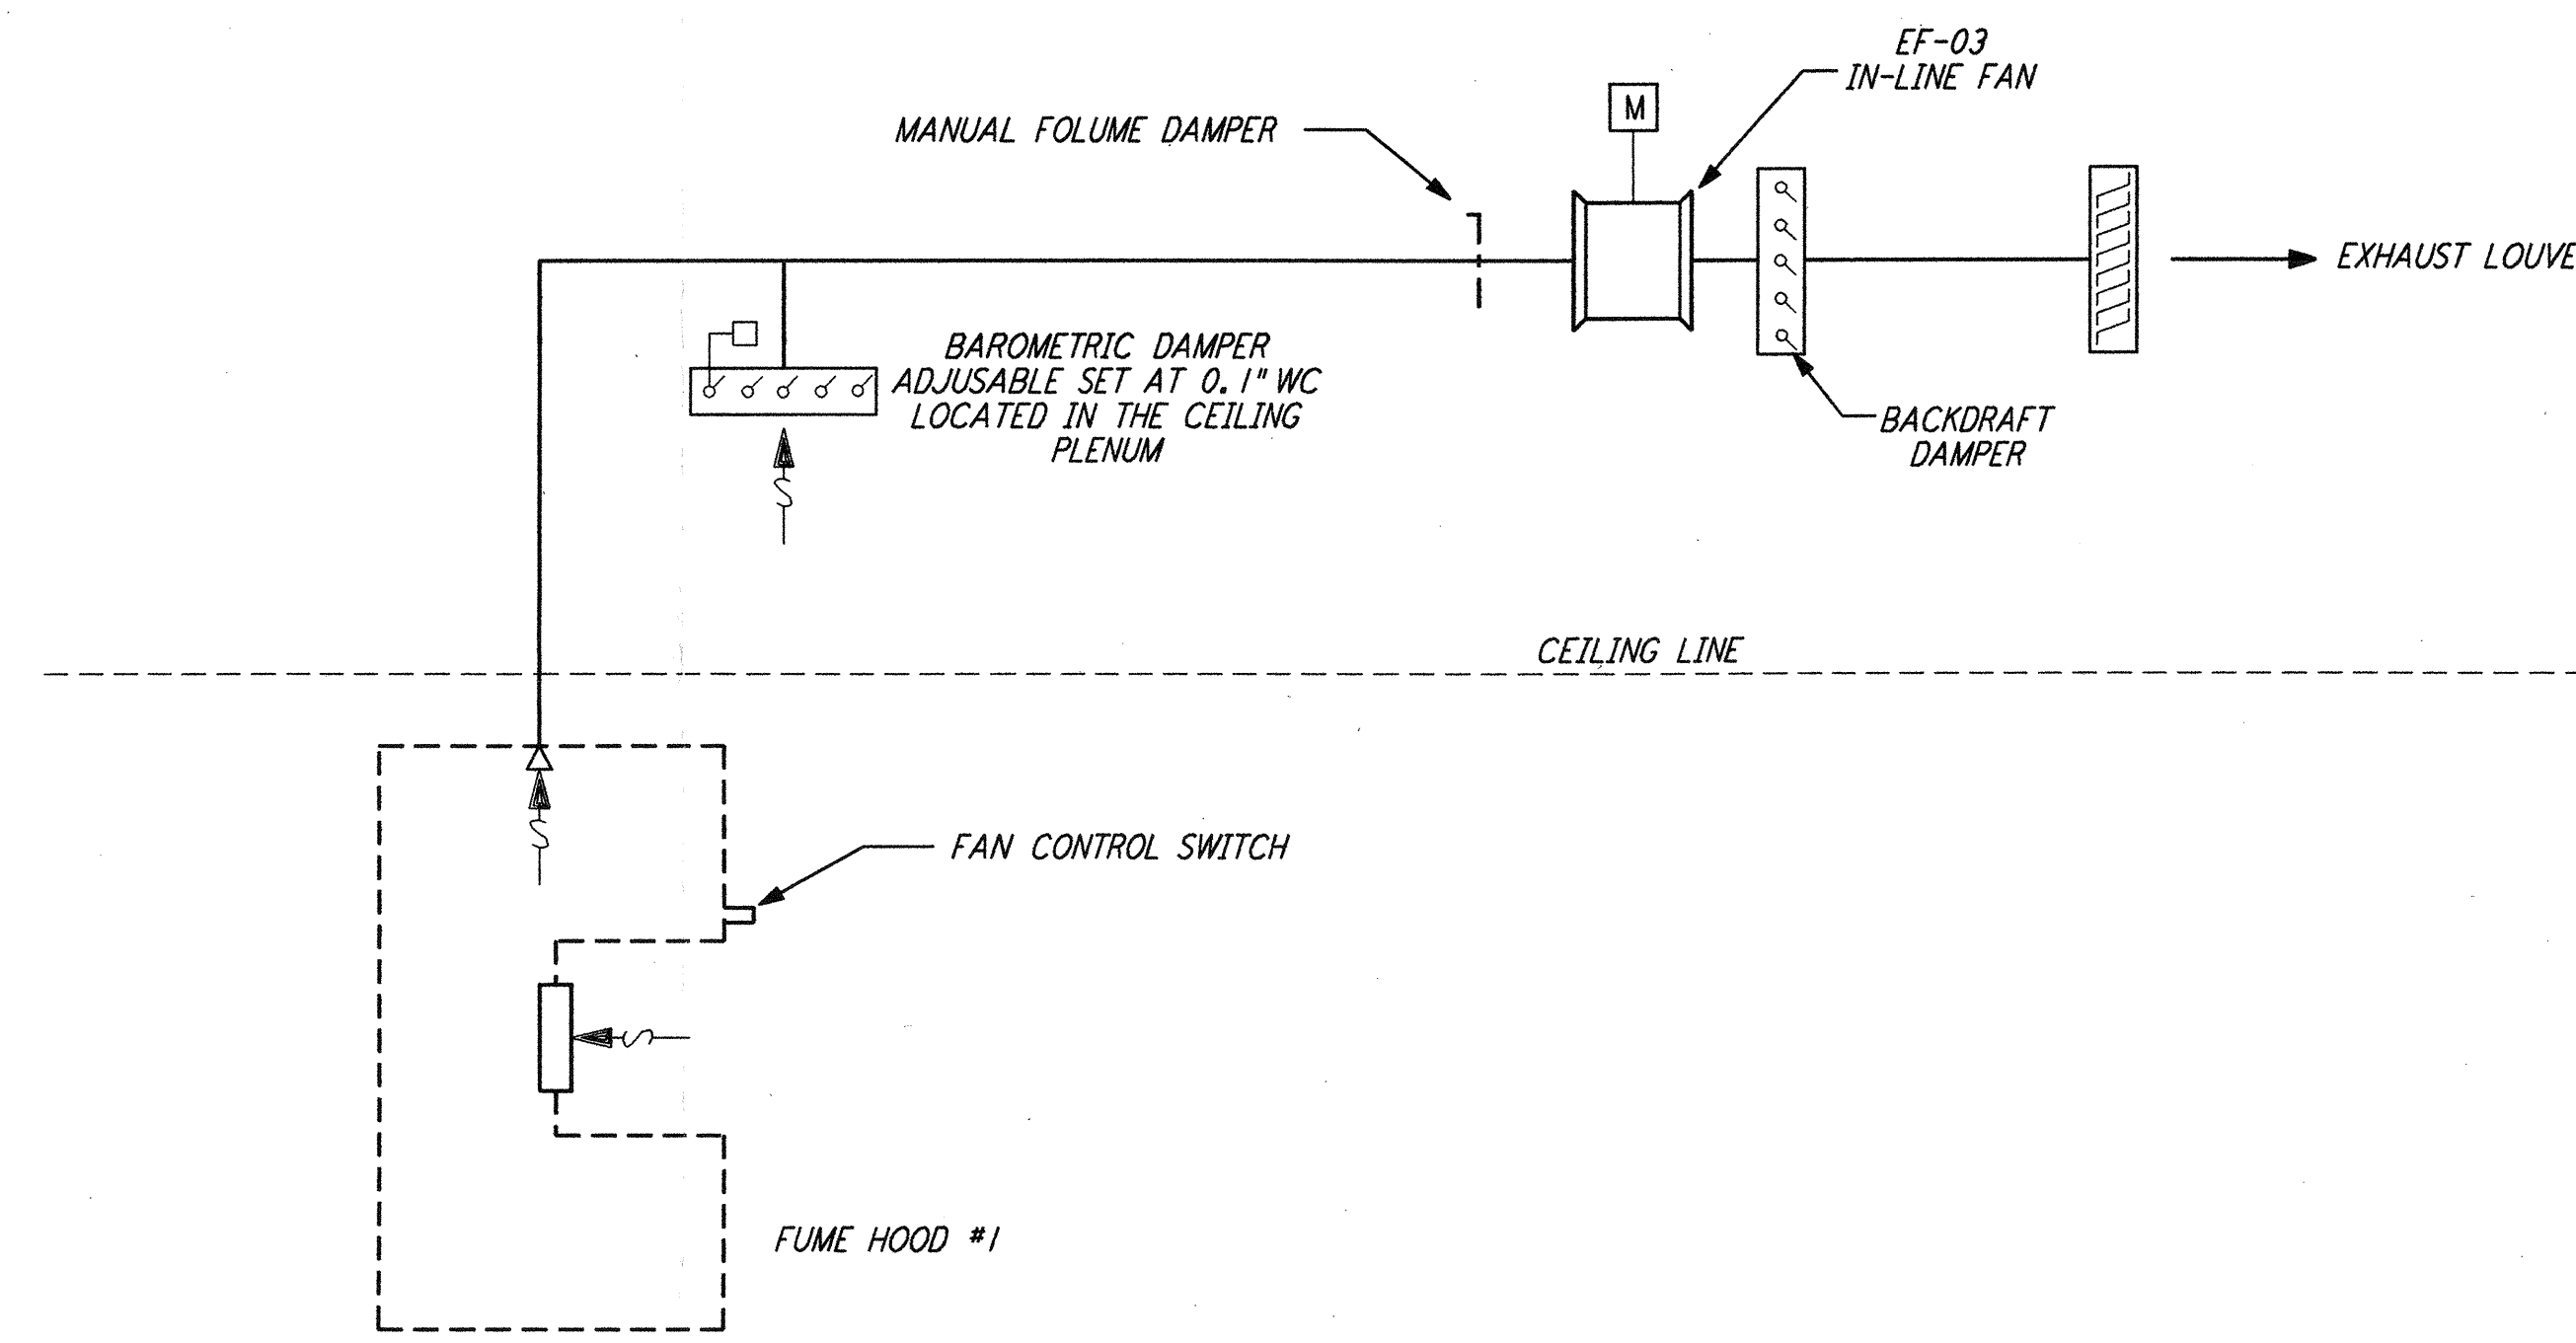

OPTICS LAB FUME HOOD CONTROL DIAGRAM

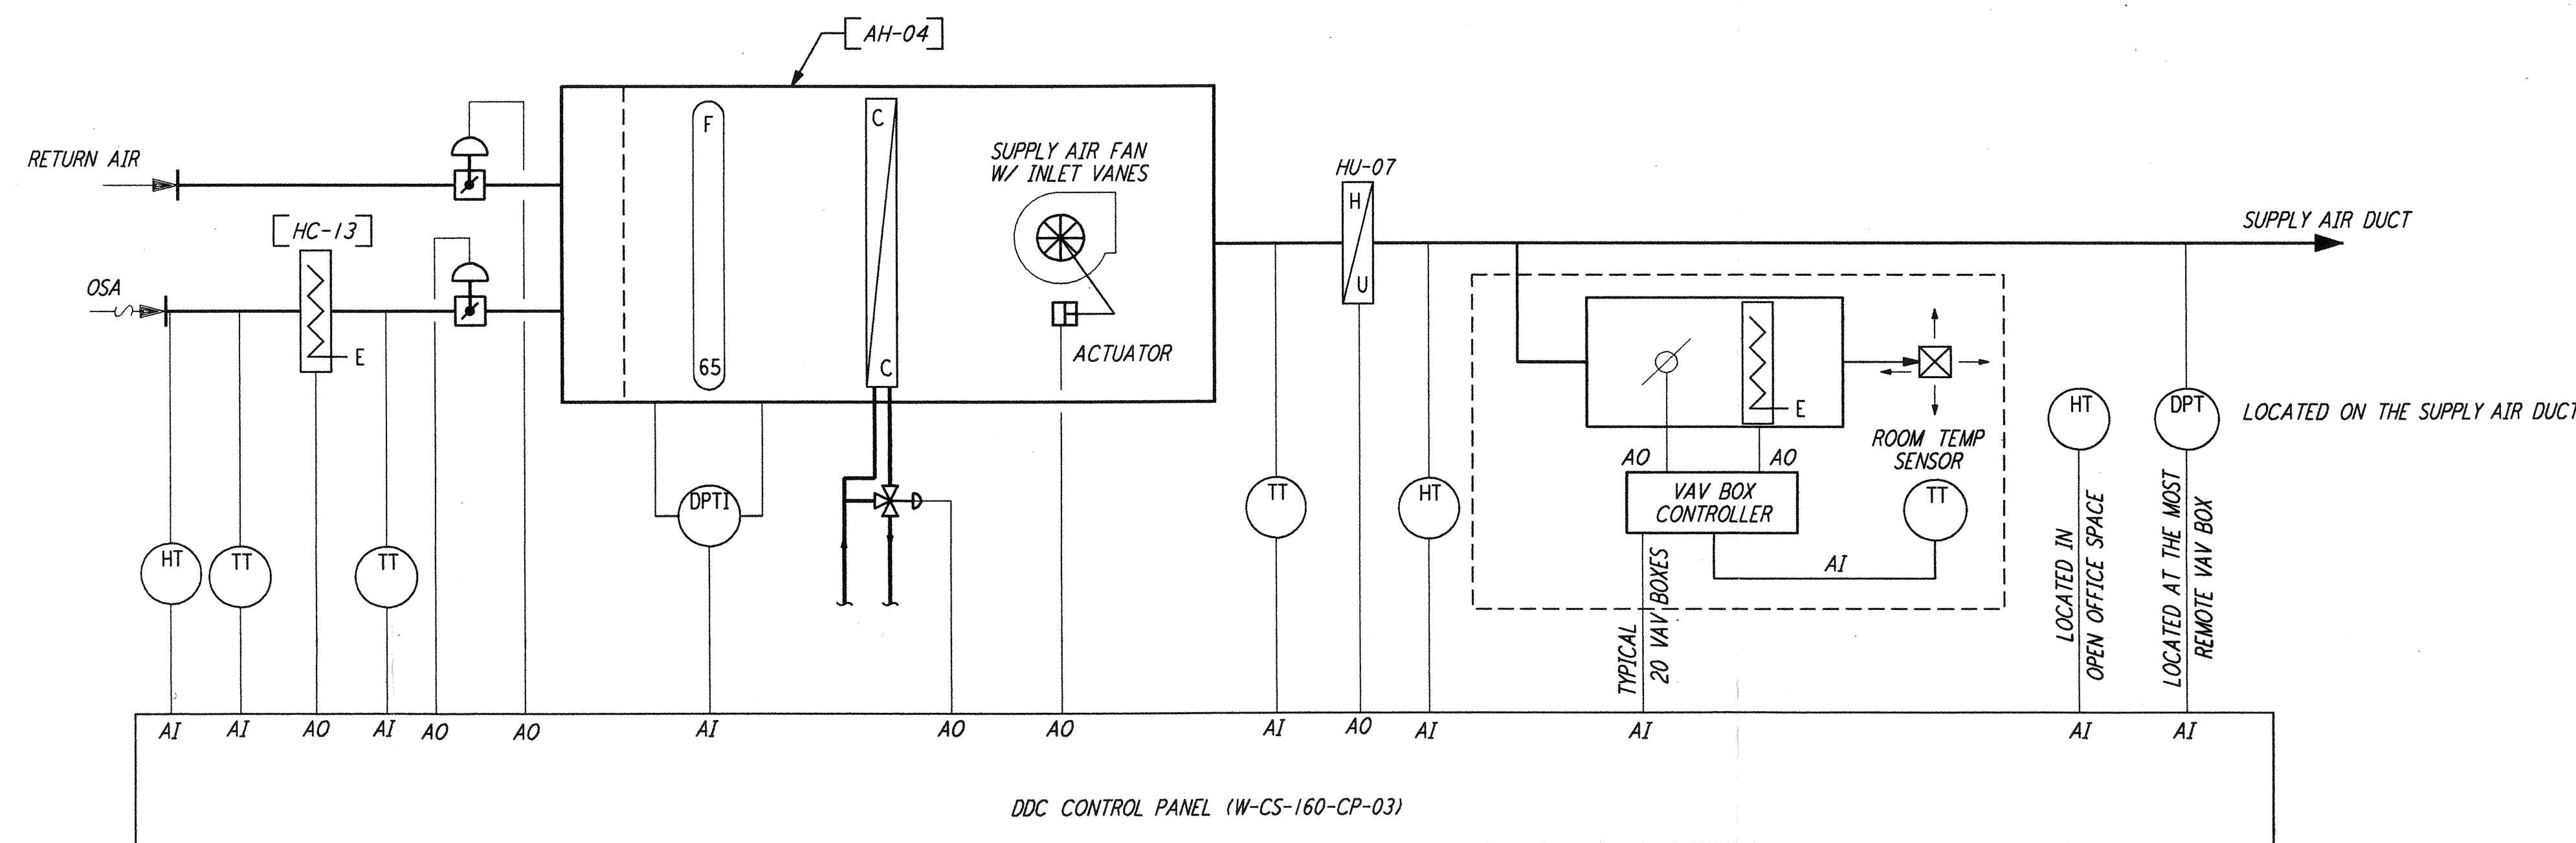

OSB AIR FLOW & CONTROL DIAGRAM
(OFFICES AREA)

not be reproduced, copied, loaned, exhibited, or used in any other way, except by written consent from PARSONS to the borrower.

This document and the design it covers are the property of PARSONS. They are loaned only with the borrower's expressed written agreement that they will

| NO. | DATE | BY | CHKD | ENGR | PROJ | DESCRIPTION |
|-----|---------|----|------|------|------|---------------------|
| 1 | 5-15-98 | CP | AA | AA | | ISSUED FOR AS-BUILT |

| | | |
|-------------------------|-----|---------|
| ISSUED FOR CONSTRUCTION | | |
| DRAWN | CLP | 6-24-96 |
| CHECKED | ME | 7/31/96 |
| ENGINEER | AA | 7/13/96 |
| PROJ | MDW | 7/18/96 |

AS-BUILT DRAWINGS

100 WEST WALNUT STREET
PASADENA, CALIFORNIA

CALIFORNIA INSTITUTE OF TECHNOLOGY
MASSACHUSETTS INSTITUTE OF TECHNOLOGY

LIGO-D960356-01-0

LASER INTERFEROMETER
GRAVITATIONAL-WAVE OBSERVATORY
SITE NO. 1 - HANFORD, WASHINGTON

| | | | |
|---|-------|-----------------|----------------|
| TITLE | SCALE | CONTRACT NUMBER | PROJECT NUMBER |
| HVAC CORNER STATION AIR FLOW DIAGRAMS SHEET 2 | NONE | PP150969 | 8094 |
| SHEET NUMBER | | REVISIONS | |
| WA-H-123 | | | |