




- NOTES:**
1. FOR LEGEND, ABBREVIATIONS AND GENERAL NOTES SEE SHEET WA-H-001 AND WA-H-002.
 2. SEE INPUT/OUTPUT SUMMARY SHEETS, SHEETS WA-H-141 AND WA-H-142 FOR ALARMS AND EQUIPMENT CONTROL.

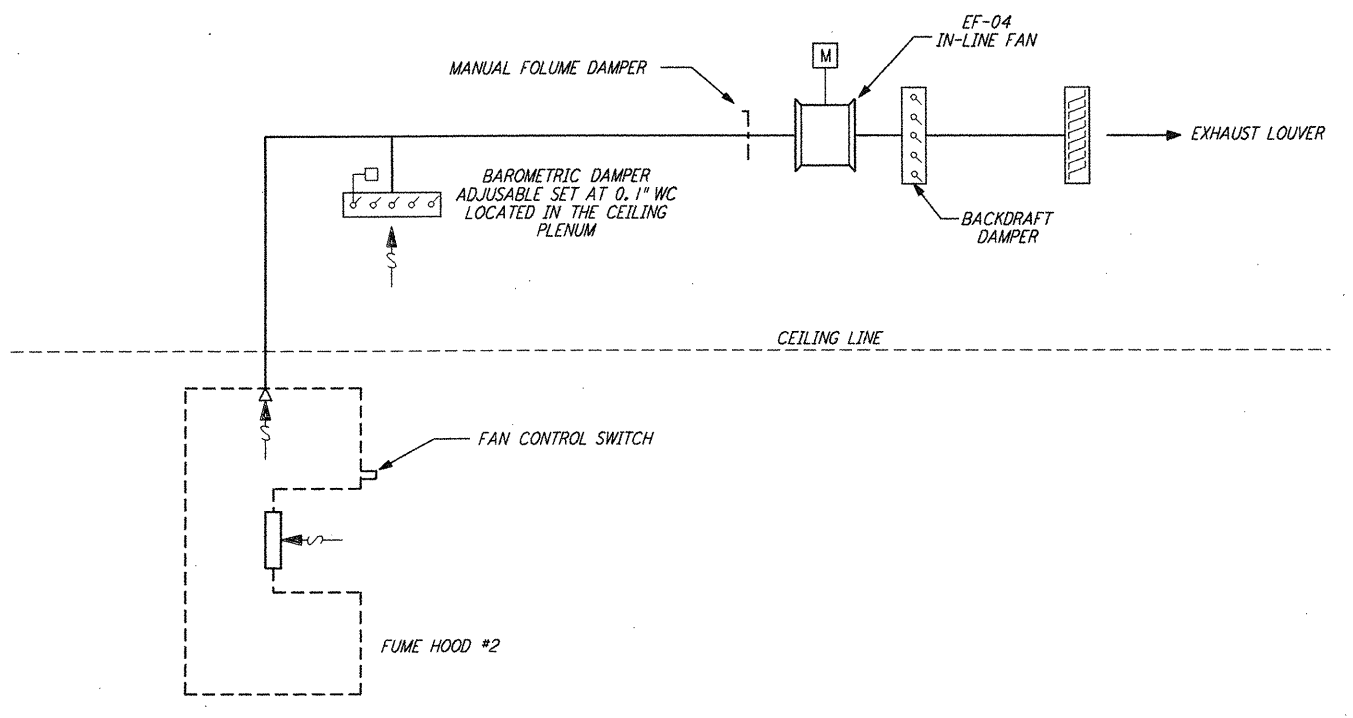

VACUUM PREPARATION FUME HOOD CONTROL DIAGRAM

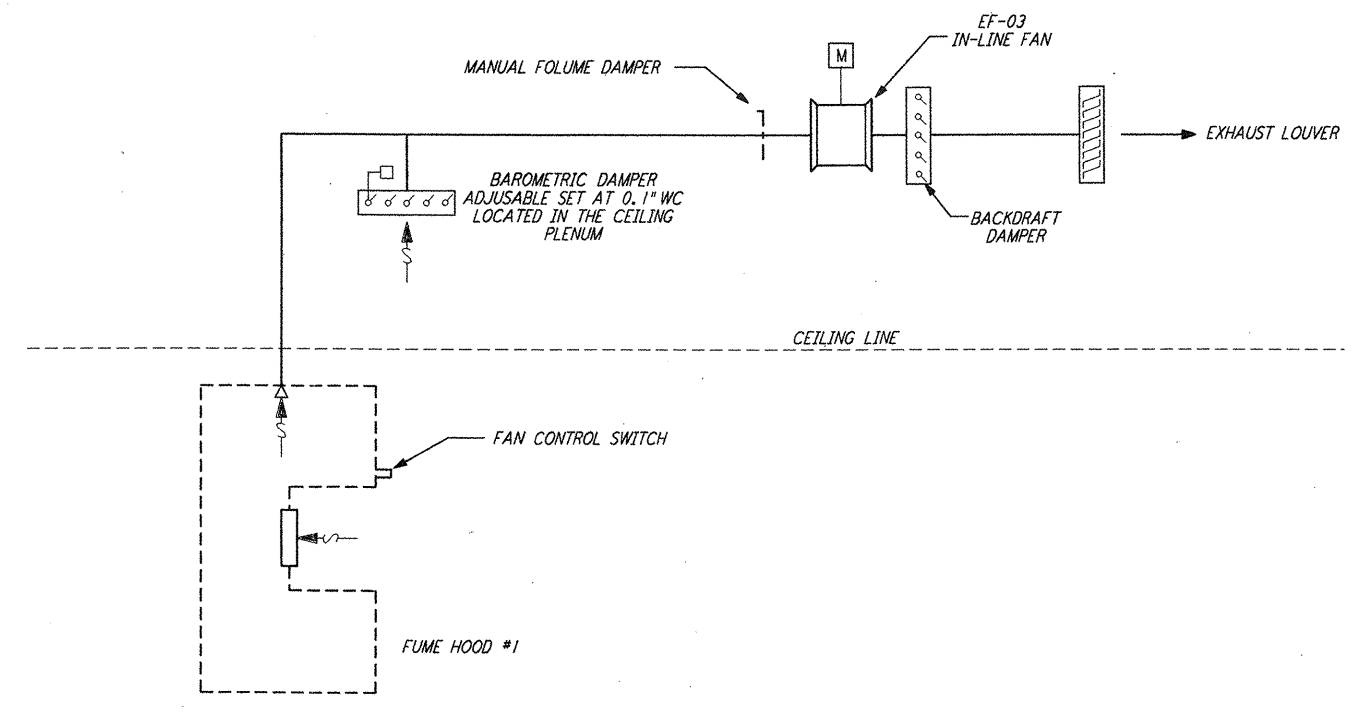

OPTICS LAB FUME HOOD CONTROL DIAGRAM

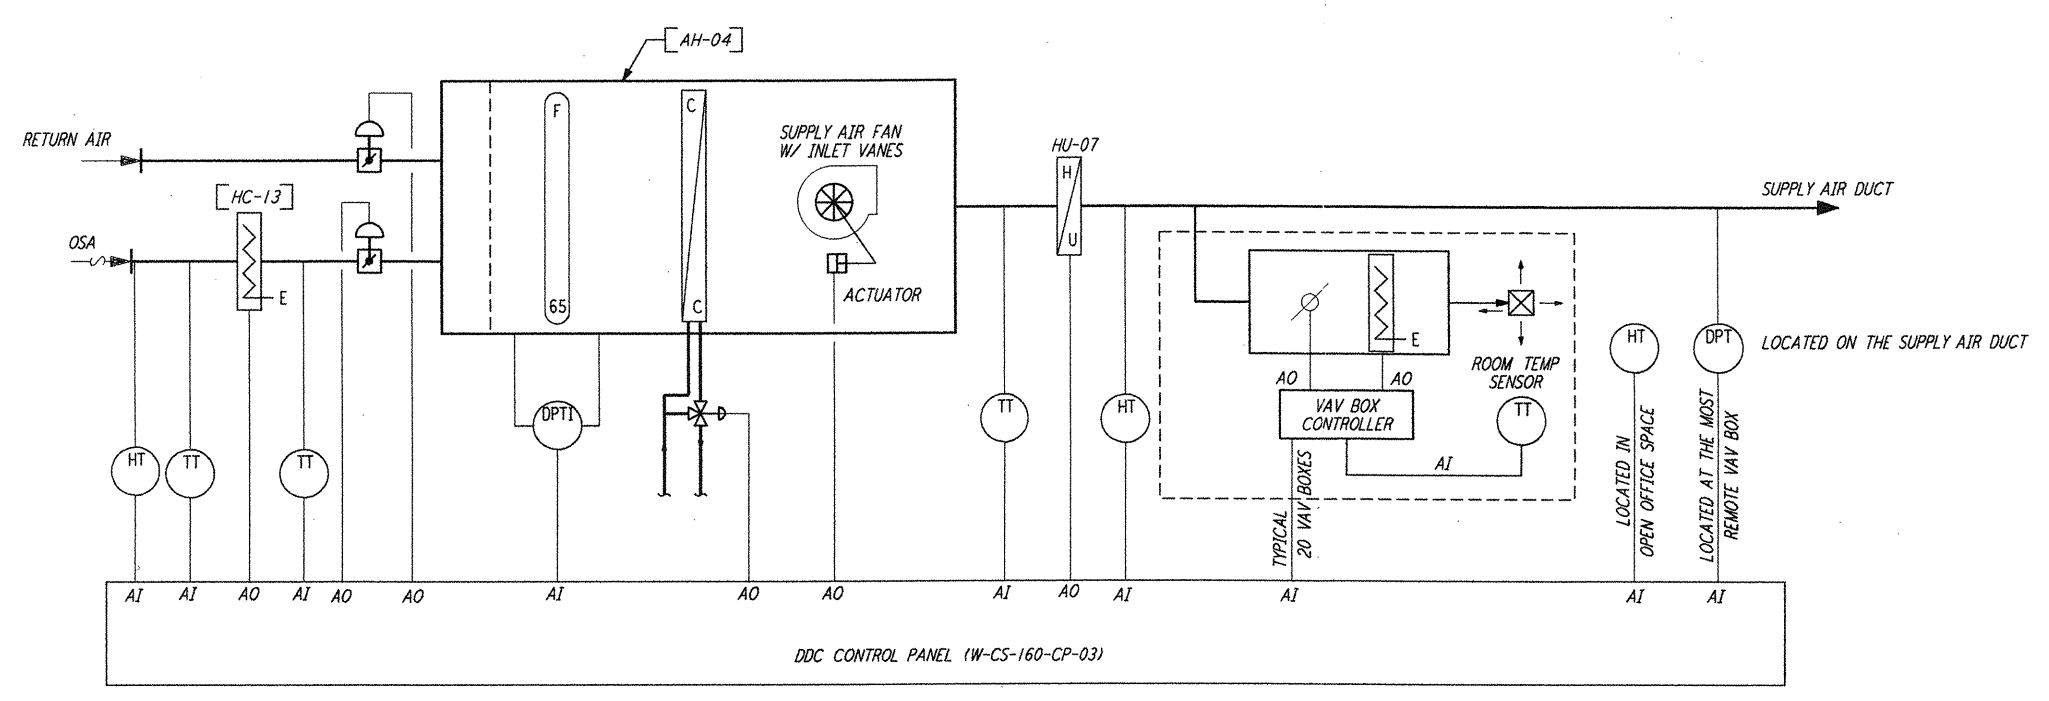

OSB AIR FLOW & CONTROL DIAGRAM
(OFFICES AREA)

This document and the design it covers are the property of PARSONS. They are loaned only with the borrower's expressed written agreement that they will not be reproduced, copied, loaned, exhibited, or used in any other way, except by written consent from PARSONS to the borrower.

This document and the design it covers are the property of PARSONS. They are loaned only with the borrower's expressed written agreement that they will not be reproduced, copied, loaned, exhibited, or used in any other way, except by written consent from PARSONS to the borrower.

NO.	DATE	BY	CHKD	ENGR	PRJG	DESCRIPTION
1	5-15-98	CP	AA	AA	AA	ISSUED FOR AS-BUILT

ISSUED FOR CONSTRUCTION			
DRAWN	CLP	6-24-96	
CHECKED	ME	7/31/96	
ENGINEER	AA	7/13/96	
PROJ	MDW	7/18/96	

AS-BUILT DRAWINGS

PARSONS
 100 WEST WALNUT STREET
 PASADENA, CALIFORNIA

LIGO
 CALIFORNIA INSTITUTE OF TECHNOLOGY
 MASSACHUSETTS INSTITUTE OF TECHNOLOGY

LIGO-D960356-01-0

LASER INTERFEROMETER
 GRAVITATIONAL-WAVE OBSERVATORY
 SITE NO. 1 - HANFORD, WASHINGTON

TITLE	SCALE	CONTRACT NUMBER	PROJECT NUMBER
HVAC CORNER STATION AIR FLOW DIAGRAMS SHEET 2	NONE	PP150969	8094
SHEET NUMBER		REVISIONS	
WA-H-123			