



- NOTES:**
- FOR LEGEND, ABBREVIATIONS AND GENERAL NOTES SEE SHEETS WA-H-051 AND WA-H-052.
 - FOR PIPING DETAILS OF COOLING COILS, WATER CHILLERS, PUMPS AND CHEMICAL POT FEEDERS SEE SHEETS WA-H-411 AND WA-H-412.

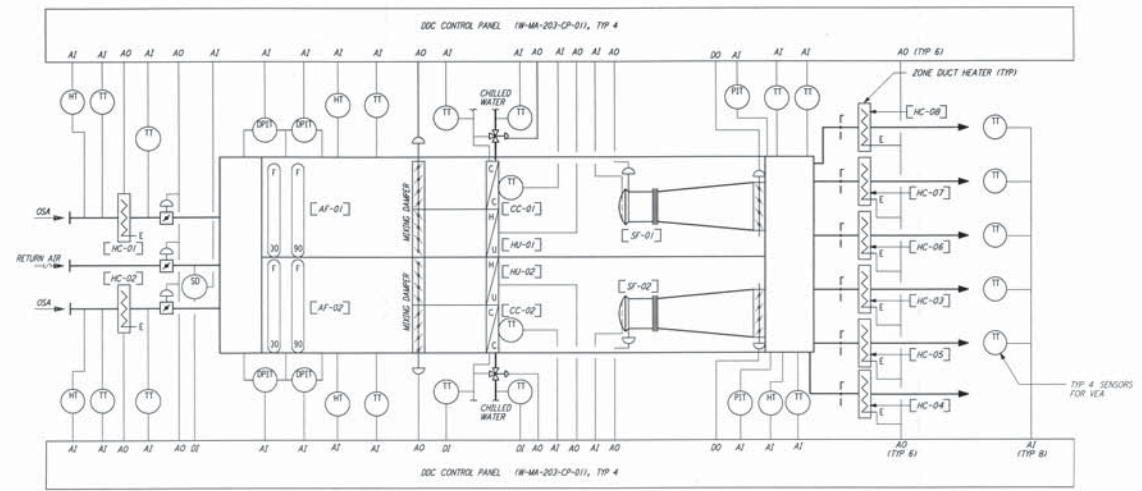

MID STATION A CONTROL DIAGRAM
 (TYP. FOR MID STN-B, END STN-A & END STN-B)

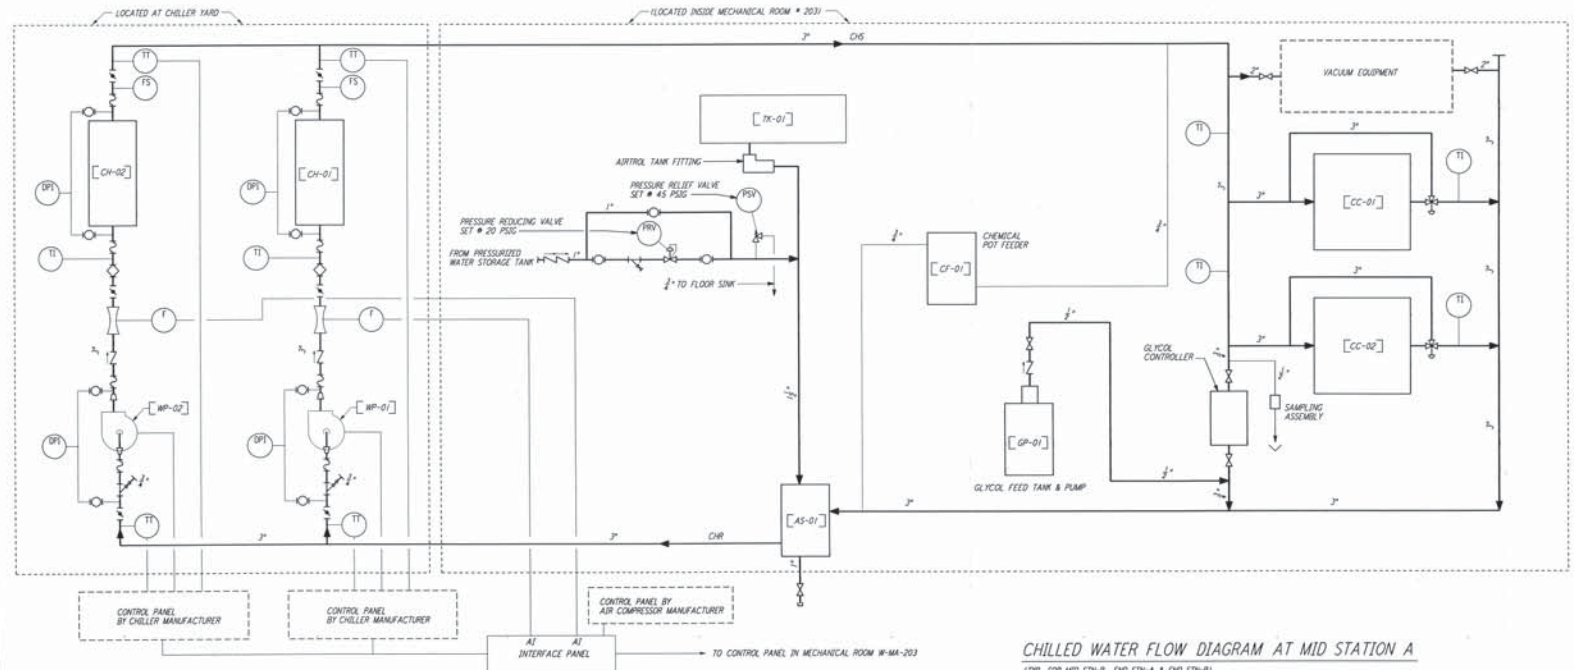

CHILLED WATER FLOW DIAGRAM AT MID STATION A
 (TYP. FOR MID STN-B, END STN-A & END STN-B)

This document and the design it covers are the property of PARSONS. They are loaned to you with the understanding that you will not reproduce, copy, loan, exhibit, or use in any way, except by written consent from PARSONS, the borrower.

NO.	DATE	BY	CHKD	ENGR	PROJ	DESCRIPTION
1	5-15-98	CP	AA	AA	PZ	ISSUED FOR AS-BUILT

ISSUED FOR CONSTRUCTION
 DRAWN: CLP 5-24-98
 CHECKED: ME 7/8/98
 ENGINEER: AA 7/17/98
 PROJ: P/D/L 7/27/98

AS-BUILT DRAWINGS

PARSONS

100 WEST WALNUT STREET
 PASADENA, CALIFORNIA

LIGO

CALIFORNIA INSTITUTE OF TECHNOLOGY
 MASSACHUSETTS INSTITUTE OF TECHNOLOGY

LIGO-D960366-01-O

LASER INTERFEROMETER
 GRAVITATIONAL-WAVE OBSERVATORY
 SITE NO. 1 - HANFORD, WASHINGTON

TITLE	HVAC MID & END STATIONS CHILLED WATER & AIR FLOW DIAGRAMS	NO.	NONE	CONTRACT NO.	PP150969	PROJECT NO.	8094
							WA-H-221