




TYPICAL BASE ELBOW SUPPORT (1) REF  
 NTS BA-H-412

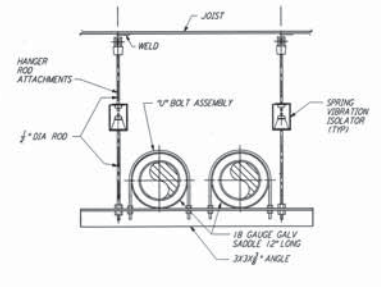

PIPE HANGER - TRAPEZE (2) REF  
 NTS BA-H-412

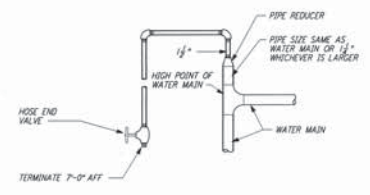

MANUAL AIR VENT (3) REF  
 NTS BA-H-412

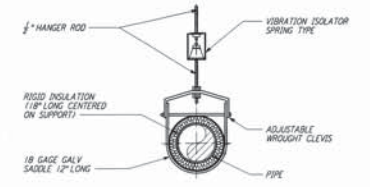

PIPE HANGER - SINGLE PIPE (4) REF  
 NTS BA-H-412

NOTES:  
 1. FOR LEGEND, ABBREVIATIONS AND GENERAL NOTES SEE SHEETS  
 WA-H-001 AND WA-H-002.

This document and the design it covers are the property of PARSONS and may be used only in accordance with the borrower's copyright written agreement that they all not be reproduced, copied, loaned, exhibited, or used in any way except by written consent from PARSONS in the borrower.

| NO. | DATE    | BY | CHKD | ENGR | PRGJ | DESCRIPTION         |
|-----|---------|----|------|------|------|---------------------|
| 1   | 5-15-98 | CP | AA   | AA   |      | ISSUED FOR AS-BUILT |

ISSUED FOR CONSTRUCTION  
 DRAWN: CLP 6-24-98  
 CHECKED: M.E. 7/1/98  
 ENGINEER: A.A. 7/1/98  
 PROJ: ADW 7/1/98

**AS-BUILT DRAWINGS**

**PARSONS**  
 100 WEST WALNUT STREET  
 PASADENA, CALIFORNIA

**LIGO**  
 CALIFORNIA INSTITUTE OF TECHNOLOGY  
 MASSACHUSETTS INSTITUTE OF TECHNOLOGY

**LIGO-D960371-01-0**

LASER INTERFEROMETER  
 GRAVITATIONAL-WAVE OBSERVATORY  
 SITE NO. 1 - HANFORD, WASHINGTON

|              |          |                |      |
|--------------|----------|----------------|------|
| TITLE        | NONE     | PROJECT NUMBER | 8094 |
| SHEET NUMBER | PP150969 | REVISED        |      |

HVAC  
 DETAILS SHEET 2

**WA-H-412**