

**NOTES:**


1. FOR ABBREVIATIONS AND ACRONYMS SEE DWG WA-E-001.
2. FOR SYMBOLS SEE DWG WA-E-002.
3. FOR GENERAL NOTES, SEE DWG. WA-E-101.
4. ALL CIRCUITS SHOWN ON THIS DRAWING ARE FROM PANEL W-CS-144-RP-01 UNLESS OTHERWISE NOTED.
5. CIRCUITS SHOWN FEEDING THESE ITEMS ARE FROM PANEL W-CS-144-LP-01.
6. CIRCUITS SHOWN FEEDING THIS ITEM IS FROM PANEL W-CS-163-RP-01.
7. CIRCUITS SHOWN FEEDING THESE ITEMS ARE FROM PANEL W-CS-163-LP-01.
8. CONDUIT AND WIRE FEEDING RECEPTACLES LOCATED ON PATIO WALLS SHALL ROUTE WITHIN PATIO BLOCK WALLS TO EXTERIOR WALLS OF THE OSB AS REQUIRED.
9. CONDUIT AND WIRE SHALL ROUTE WITHIN FLOOR SLAB TO WALL AS INDICATED.
10. FOR ALL PANEL FEEDER CONDUIT AND WIRE SIZES SEE SINGLE LINE DIAGRAM DWG WA-E-006.
11. HEAT TRACE 163-RP-01 #40.

**REFERENCE DRAWINGS:**

- WA-E-115 LIGHTING AND POWER PANEL SCHEDULES
- WA-E-116 LIGHTING AND POWER PANEL SCHEDULES

**LEGEND:**

- RECEPTACLE, 200V, 30, 50A, 4 POLE GROUNDING
- ROOM 121-308 HUBBLE# 20810 WITH BOX AND COVER

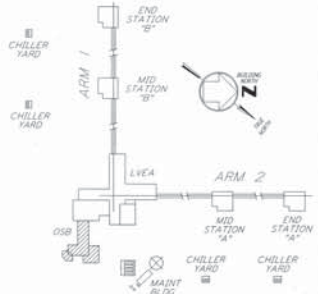

KEY PLAN

LIGO-D960394-02-0

LASER INTERFEROMETER  
 GRAVITATIONAL-WAVE OBSERVATORY  
 SITE NO. 1 - HANFORD, WASHINGTON

TITLE: ELECTRICAL CORNER STATION OSB OFFICE AREA RECEPTACLE & POWER PLAN

AS NOTED PPI50969 8094

**WA-E-105**

**PARSONS**

100 WEST WALNUT STREET  
 PASADENA, CALIFORNIA

**LIGO**

CALIFORNIA INSTITUTE OF TECHNOLOGY  
 MASSACHUSETTS INSTITUTE OF TECHNOLOGY

AS-BUILT DRAWINGS

NO.	DATE	BY	CHKD	ENGR	PROJ	DESCRIPTION
2	6-15-98	J.G.	M.	TDM		ISSUED FOR AS-BUILT GENERAL REVISIONS
1	3-21-97	J.G.	K.R.	K.R.	TDM	

This document and the design it contains are the property of PARSONS. They are loaned only with the borrower's expressed written agreement that they will not be reproduced, copied, loaned, exhibited, or used in any other way except by written consent from PARSONS in the borrower.