

**NOTES:**



1. FOR ABBREVIATIONS AND ACRONYMS SEE DWG WA-E-001.
2. FOR SYMBOLS SEE DWG WA-E-002.
3. FOR GENERAL NOTES, SEE DWG. WA-E-101.
4. ALL CIRCUITS SHOWN ON THIS DRAWING ARE FROM PANEL W-CS-144-RP-01 UNLESS OTHERWISE NOTED.
5. CIRCUITS SHOWN FEEDING THESE ITEMS ARE FROM PANEL W-CS-144-LP-01.
6. CIRCUITS SHOWN FEEDING THIS ITEM IS FROM PANEL W-CS-163-RP-01.
7. CIRCUITS SHOWN FEEDING THESE ITEMS ARE FROM PANEL W-CS-163-LP-01.
8. CONDUIT AND WIRE FEEDING RECEPTACLES LOCATED ON PATIO WALLS SHALL ROUTE WITHIN PATIO BLOCK WALLS TO EXTERIOR WALLS OF THE OSB AS REQUIRED.
9. CONDUIT AND WIRE SHALL ROUTE WITHIN FLOOR SLAB TO WALL AS INDICATED.
10. FOR ALL PANEL FEEDER CONDUIT AND WIRE SIZES SEE SINGLE LINE DIAGRAM DWG WA-E-006.
11. HEAT TRACE 163-RP-01 #40.

**REFERENCE DRAWINGS:**

- WA-E-115 LIGHTING AND POWER PANEL SCHEDULES  
 WA-E-116 LIGHTING AND POWER PANEL SCHEDULES

**LEGEND:**

- ⊕ RECEPTACLE, 208V, 3Ø, 5W, 4 POLE
- ⊖ GROUNDING
- ⊖ NEMA L21-30R HUBBELL #2810 WITH BOX AND COVER

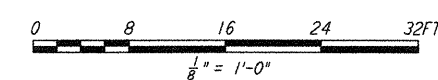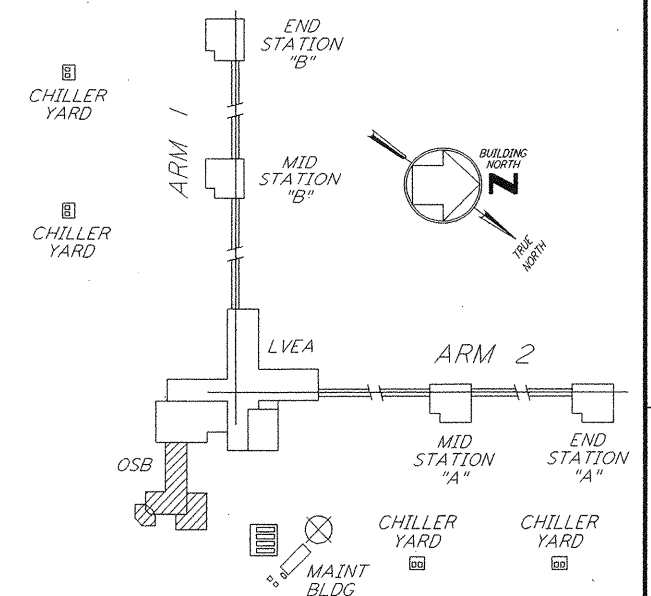

not be reproduced, copied, loaned, exhibited, or used in any other way, except by written consent from PARSONS to the borrower.

This document and the design it covers are the property of PARSONS. They are loaned only with the borrower's expressed written agreement that they will

NO.	DATE	BY	CHKD	ENGR	PROJ	DESCRIPTION
2	6-15-98	J. G.	K. R.	K. R.	TDM	ISSUED FOR AS-BUILT
1	3-21-97	J. G.	K. R.	K. R.	TDM	GENERAL REVISIONS

ISSUED FOR CONSTRUCTION		
DRAWN	M. M.	6-25-96
CHECKED	J. K.	7-3-96
ENGINEER	K. R.	7-3-96
PROJ	M. D. W.	7-8-96

**AS-BUILT DRAWINGS**

**PARSONS**  
 100 WEST WALNUT STREET  
 PASADENA, CALIFORNIA

**LIGO**  
 CALIFORNIA INSTITUTE OF TECHNOLOGY  
 MASSACHUSETTS INSTITUTE OF TECHNOLOGY

**LIGO-D960394-02-0**

LASER INTERFEROMETER  
 GRAVITATIONAL-WAVE OBSERVATORY  
 SITE NO. 1 - HANFORD, WASHINGTON

TITLE	SCALE	CONTRACT NUMBER	PROJECT NUMBER
ELECTRICAL CORNER STATION OSB OFFICE AREA RECEPTACLE & POWER PLAN	AS NOTED	PP150969	8094
SHEET NUMBER		REVISIONS	
<b>WA-E-105</b>			