
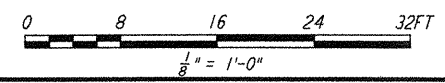
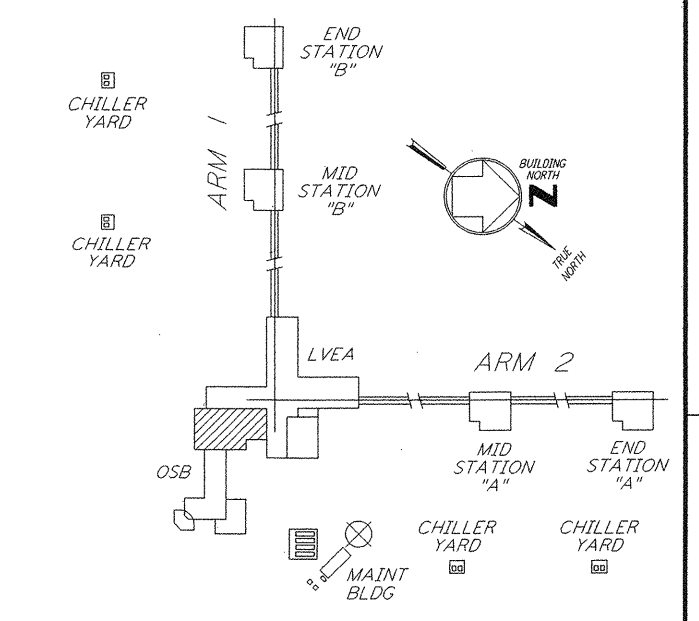
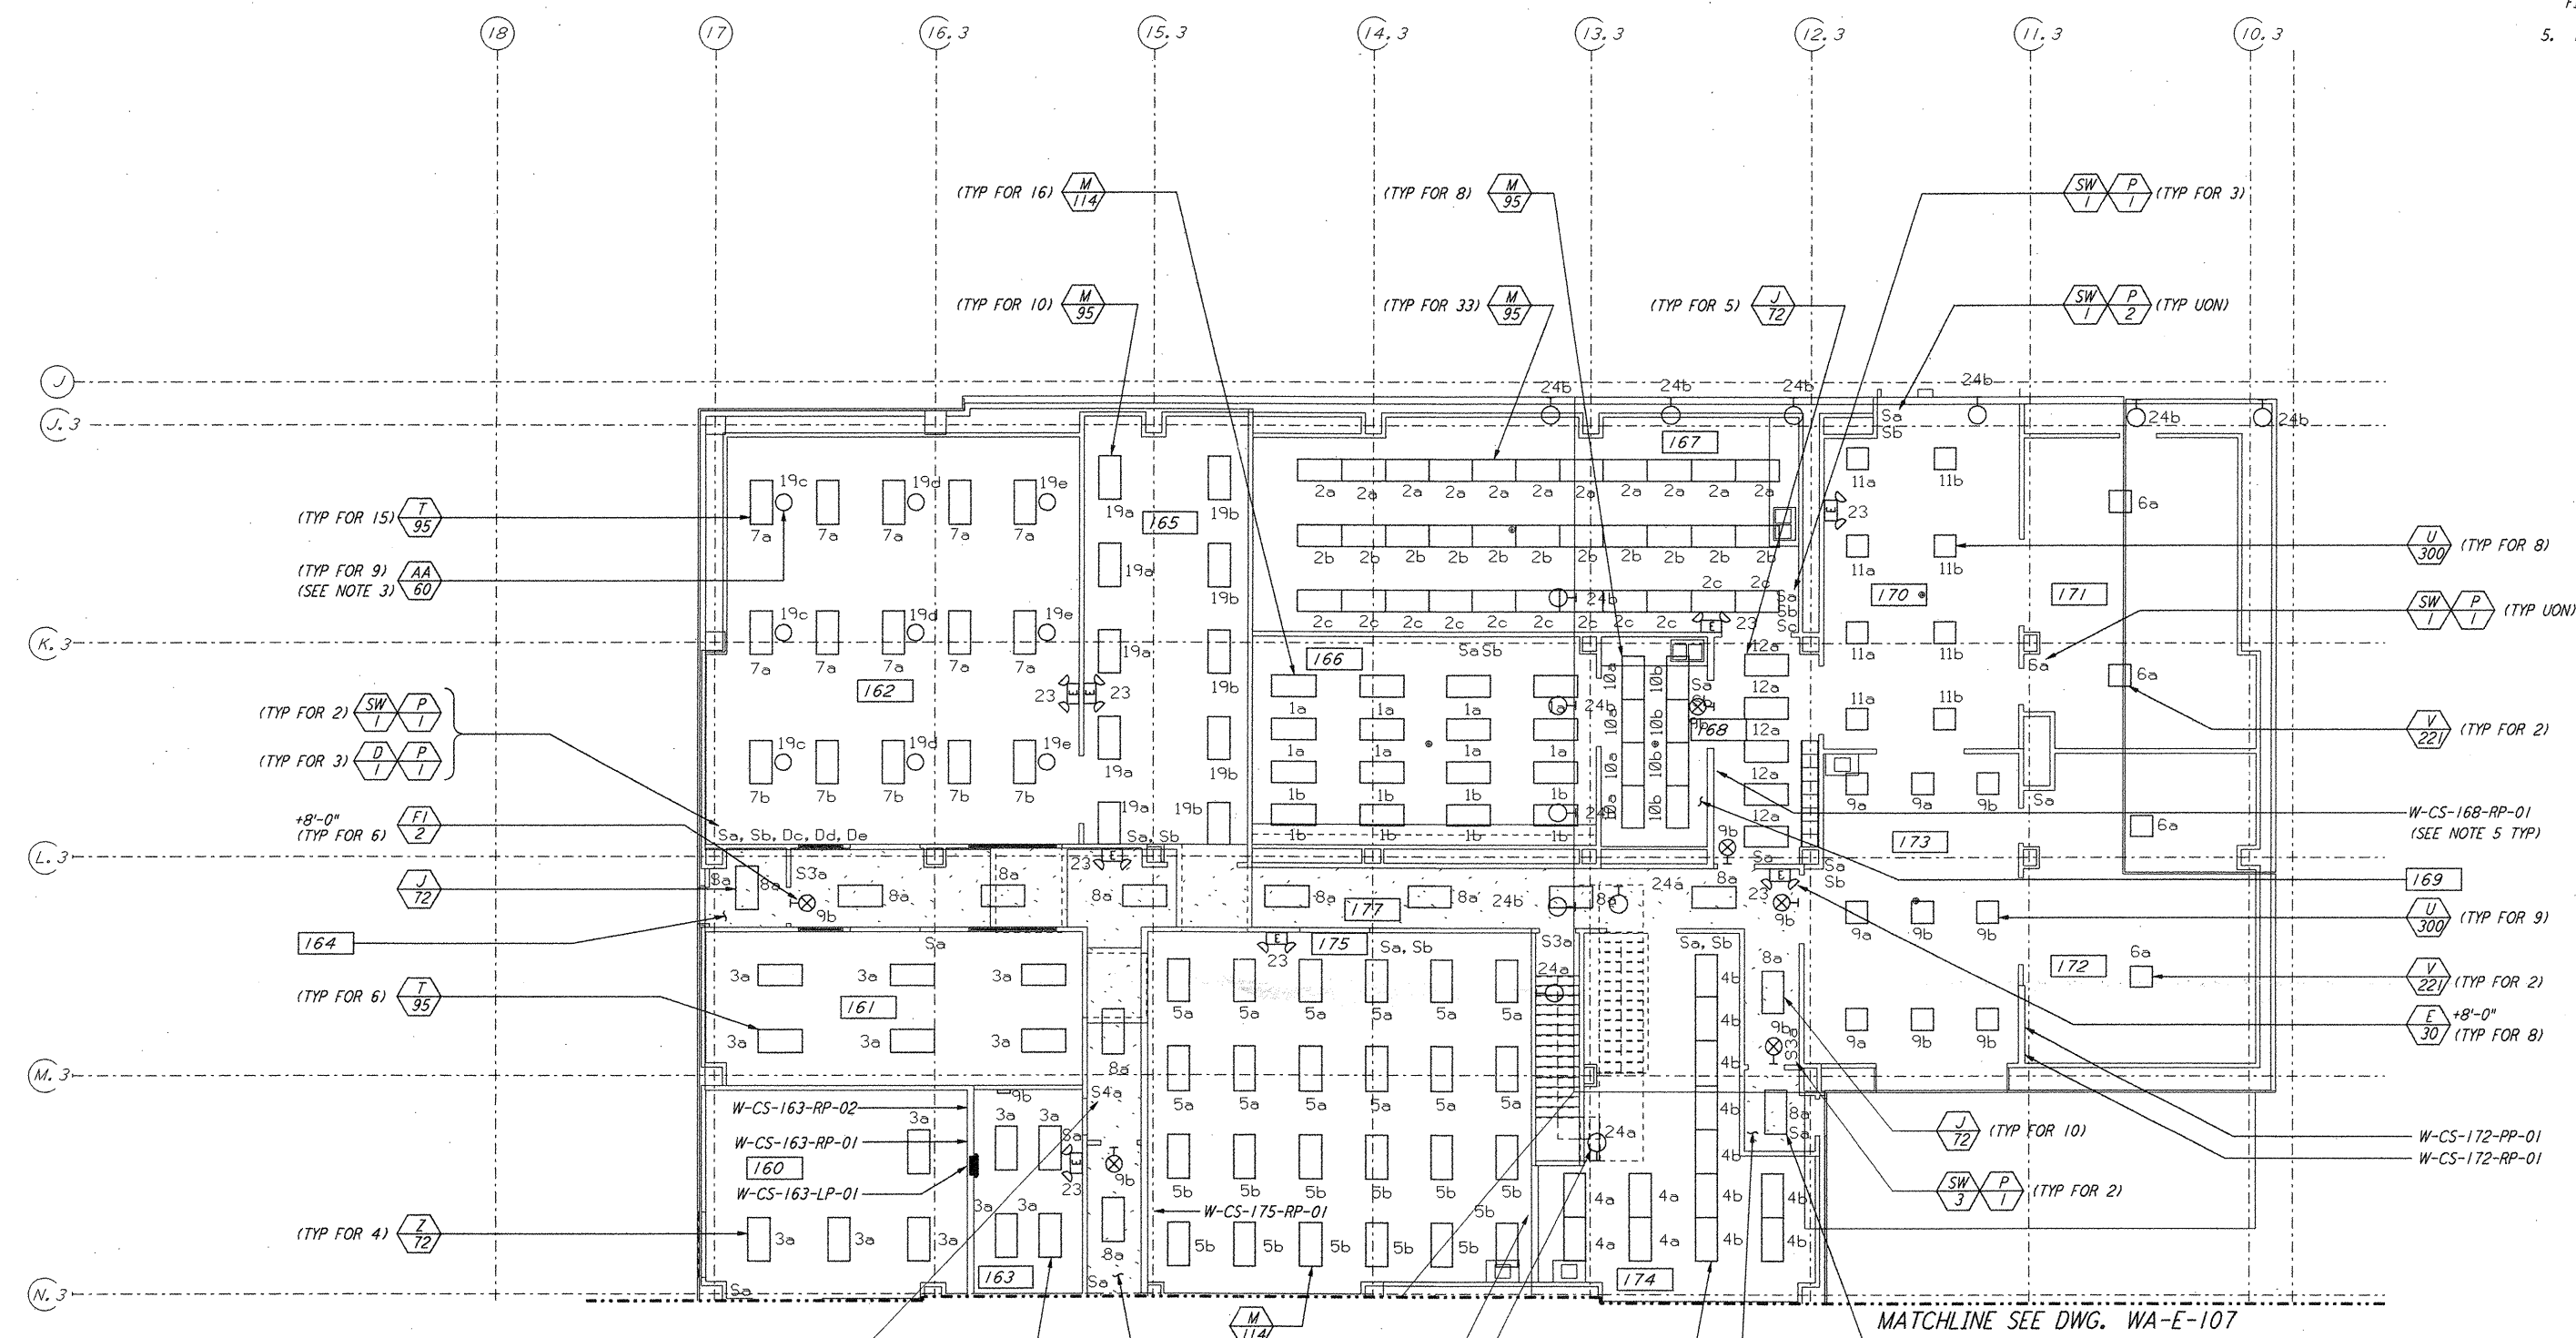


**NOTES:**

1. FOR NOTES AND REFERENCE DRAWINGS SEE DWG. WA-E-107.
2. ALL CIRCUITS SHOWN ON THIS DRAWING ARE FROM PANEL W-CS-163-LP-01 UNLESS NOTED OTHERWISE.
3. CIRCUIT SHOWN FEEDING THESE LIGHTING FIXTURES IS FROM W-CS-163-RP-01.
4. CIRCUIT SHOWN FEEDING THESE LIGHTING FIXTURES IS FROM W-CS-168-RP-01.
5. FOR ALL PANEL FEEDER CONDUIT AND WIRE SIZES SEE SINGLE LINE DIAGRAM DWG WA-E-502.

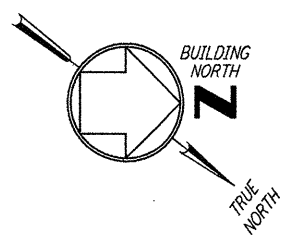

KEY PLAN  
**LIGO-D960397-02-0**

This document and the design it covers are the property of PARSONS. They are loaned only with the borrower's expressed written agreement that they will not be reproduced, copied, loaned, exhibited, or used in any other way, except by written consent from PARSONS to the borrower.

NO.	DATE	BY	CHKD	ENGR	PROJ	DESCRIPTION
2	6-15-98	J. G.	W	PZ		ISSUED FOR AS-BUILT GENERAL REVISIONS
1	3-21-97	J. G.	K. R.	K. R.	TDM	ISSUED FOR CONSTRUCTION

ISSUED FOR CONSTRUCTION	DRAWN	M. M.	6-25-96
CHECKED	J. K.	7-3-96	
ENGINEER	K. R.	7-3-96	
PROJ	M. D. W.	7-8-96	

**AS-BUILT DRAWINGS**

**PARSONS**  
 100 WEST WALNUT STREET  
 PASADENA, CALIFORNIA

**LIGO**  
 CALIFORNIA INSTITUTE OF TECHNOLOGY  
 MASSACHUSETTS INSTITUTE OF TECHNOLOGY

LASER INTERFEROMETER GRAVITATIONAL-WAVE OBSERVATORY SITE NO. 1 - HANFORD, WASHINGTON		
TITLE	SCALE	CONTRACT NUMBER
ELECTRICAL CORNER STATION OSB LAB AREA LIGHTING PLAN	AS NOTED	PPI50969
	PROJECT NUMBER	8094
<b>WA-E-108</b>		