
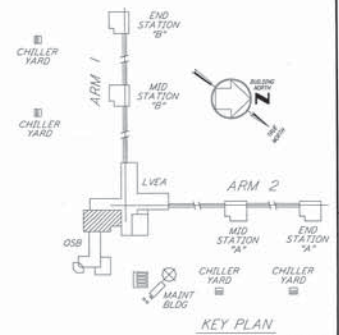
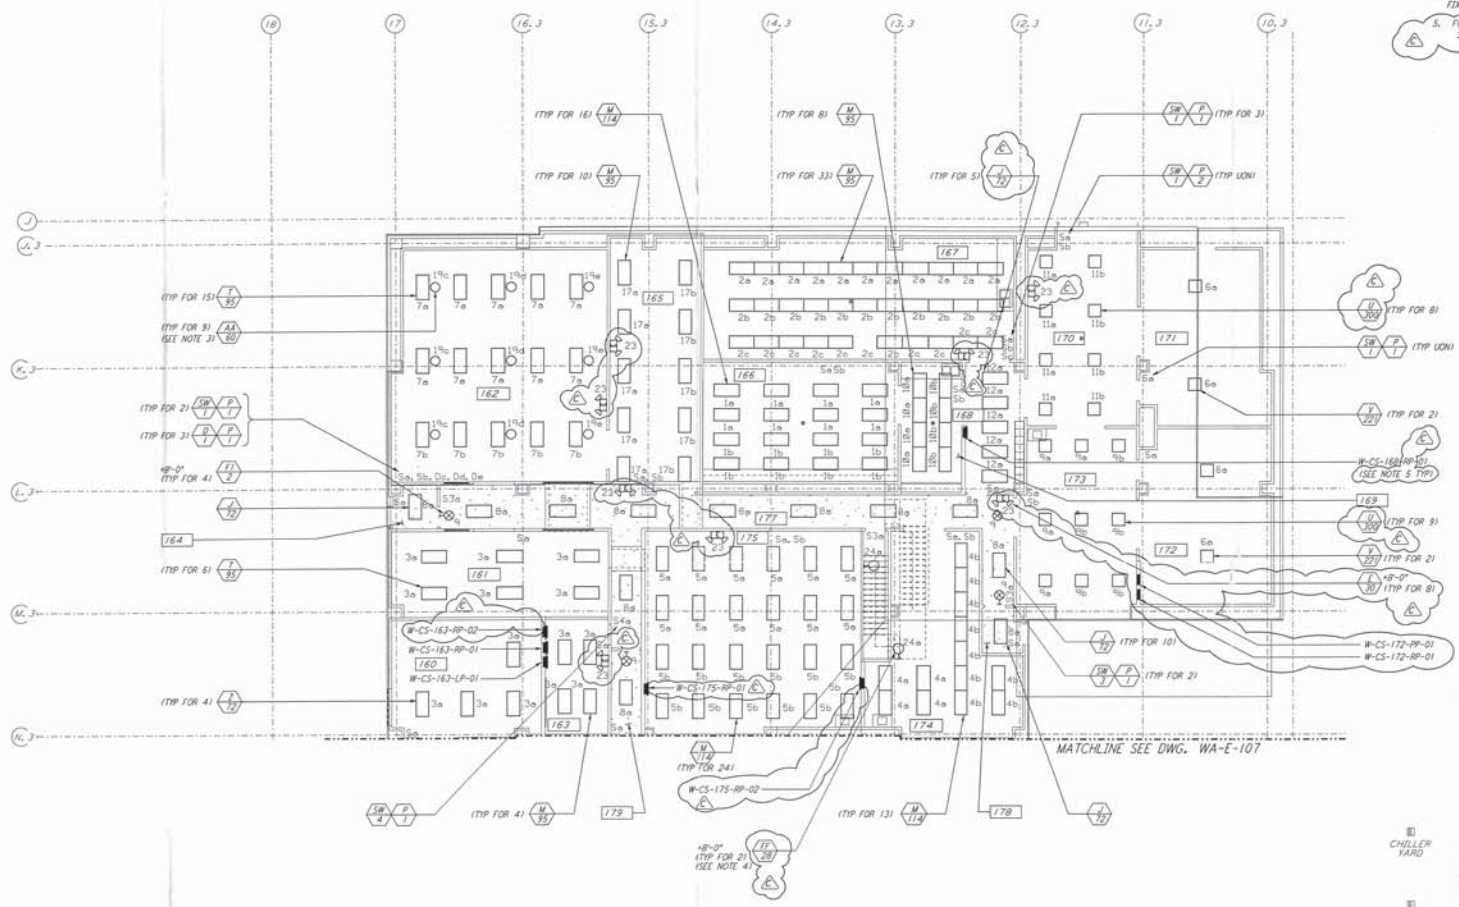


NOTES:

1. FOR NOTES AND REFERENCE DRAWINGS SEE DWG. WA-E-107.
2. ALL CIRCUITS SHOWN ON THIS DRAWING ARE FROM PANEL W-CS-163-LP-01 UNLESS NOTED OTHERWISE.
3. CIRCUIT SHOWN FEEDING THESE LIGHTING FIXTURES IS FROM W-CS-163-RP-01.
4. CIRCUIT SHOWN FEEDING THESE LIGHTING FIXTURES IS FROM W-CS-168-RP-01.
5. FOR ALL PANEL FEEDER CONDUIT AND WIRE SIZES SEE SINGLE LINE DIAGRAM DWG WA-E-107.

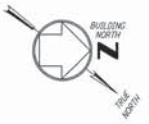

This document and the design it contains are the property of PARSONS. They are to be used only in connection with the borrower's expressed written agreement that they will not be reproduced, copied, loaned, exhibited, or used in any way without the prior written consent of PARSONS.

NO.	DATE	BY	CHKD	ENGR	PRGJ	DESCRIPTION
C	5-22-16	SP	SP			BIO ADDENDUM #2
B	4-19-16					TDM FINAL DESIGN REVIEW & BID
A	10-21-15					TDM PRELIMINARY DESIGN REVIEW

DRAWN	J. G.
CHECKED	
ENGINEER	
PROJ	

PARSONS
 100 WEST WALNUT STREET
 PASADENA, CALIFORNIA

LIGO
 CALIFORNIA INSTITUTE OF TECHNOLOGY
 MASSACHUSETTS INSTITUTE OF TECHNOLOGY

LASER INTERFEROMETER
 GRAVITATIONAL-WAVE OBSERVATORY
 SITE NO. 1 - HANFORD, WASHINGTON

ELECTRICAL
 CORNER STATION
 OSB LAB AREA
 LIGHTING PLAN

AS NOTED PPI50969 8094
WA-E-108