


NOTE:
 1. FOR SPECIFICATIONS SEE SPECIFICATION SECTION 16742 TELEPHONE AND DATA CABLE.

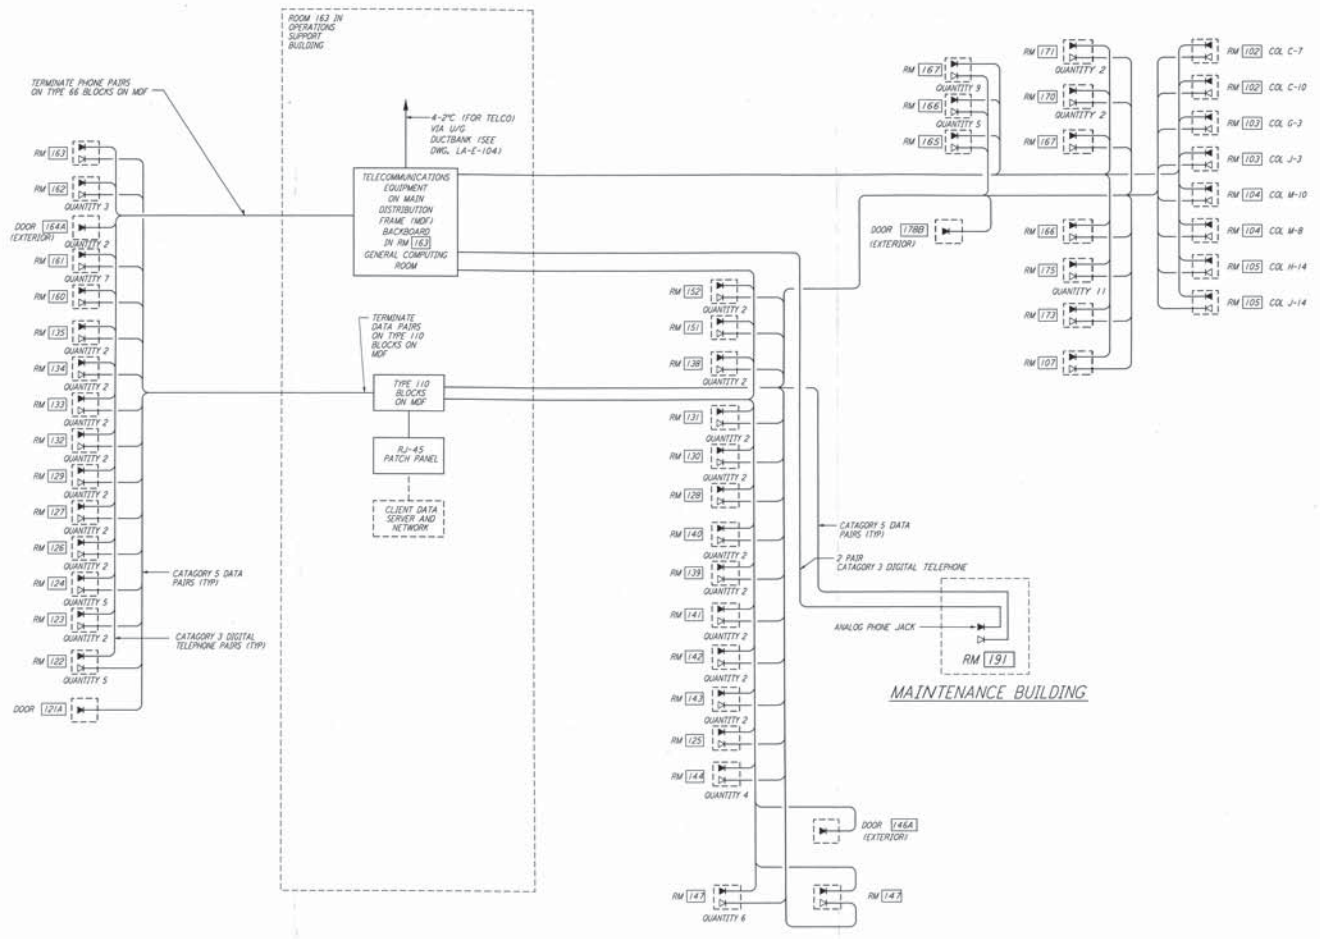

TELEPHONE, FACILITY DATA RISER DIAGRAM

This document and the design it covers are the property of PARSONS and may not be reproduced, stored, or used in any form or by any means, except as written consent from PARSONS is given in the agreement that they all have entered into with the client.

NO.	DATE	BY	CHKD	ENGR	PROJ	DESCRIPTION
2	6-15-98	J.G.	W	J.P.	ISSUED FOR AS-BUILT	
1	3-27-97	J.G.	K.R.	K.R.	GENERAL REVISIONS	

ISSUED FOR CONSTRUCTION
 DRAWN M.M. 6-29-98
 CHECKED J.K. 7-3-98
 ENGINEER K.R. 7-3-98
 PROJ. M.D.W. 7-9-98

AS-BUILT DRAWINGS

PARSONS

100 WEST WALNUT STREET
 PASADENA, CALIFORNIA

LIGO

CALIFORNIA INSTITUTE OF TECHNOLOGY
 MASSACHUSETTS INSTITUTE OF TECHNOLOGY

LIGO-D960398-02-0

LASER INTERFEROMETER
 GRAVITATIONAL-WAVE OBSERVATORY
 SITE NO. 1 - HANFORD, WASHINGTON

ELECTRICAL CORNER STATION COMMUNICATIONS RISER DIAGRAM

NONE PPI50969 8094

WA-E-109