
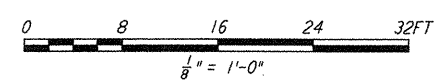


- NOTES:**
- FOR PLAN SYMBOLS SEE DWG WA-E-002
  - WIRING FOR FIRE DETECTION SHALL BE CLASS "A"; FOR FIRE ALARM DEVICES SHALL BE CLASS "B".
  - DUCT MOUNTED SMOKE DETECTORS SHALL BE PROVIDED WITH AN AUXILIARY RELAY CONTACT (N.C.) FOR EQUIPMENT SHUT-DOWN.
  - NOT USED.
  - COORDINATE AHJ LOCATIONS AND DUCT MOUNTED SMOKE DETECTORS.
  - TELEPHONE AND DATA RECEPTACLES SHOWN IN MIDDLE OF ROOMS SHALL BE PROVIDED WITH IMBEDDED 3/4" CONDUIT TO NEAREST PERMANENT WALL, WITH RISER TO ABOVE CEILING CAVITY.
  - DATA AND PHONE LINES SHALL BE HOMERUN FROM WALL AND FLOOR RECEPTACLES TO BACKBOARD IN ROOM 163.
  - ROOMS IN CEILING CAVITY SHALL BE ORDERLY.

- LEGEND**
- DATA RACK
  - VOICE RACK

not be reproduced, copied, loaned, exhibited, or used in any other way, except by written consent from PARSONS to the borrower.

This document and the design it covers are the property of PARSONS. They are loaned only with the borrower's expressed written agreement that they will

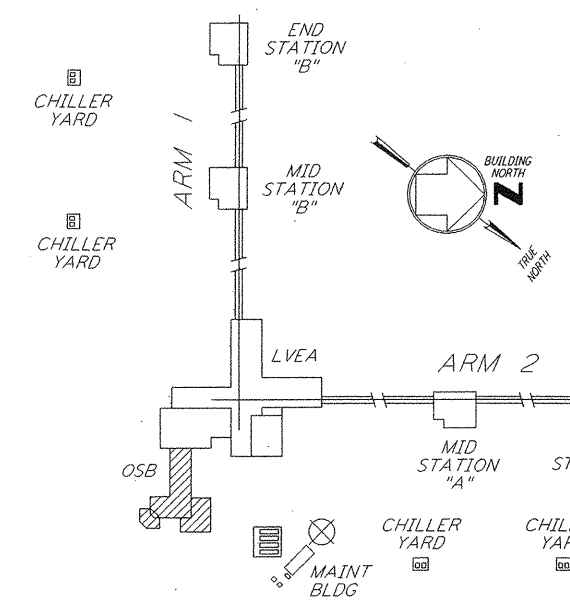

NO.	DATE	BY	CHKD	ENGR	PROJ	DESCRIPTION
2	6-15-98	J.G.	K.R.	K.R.	TDM	ISSUED FOR AS-BUILT
1	3-21-97	J.G.	K.R.	K.R.	TDM	GENERAL REVISIONS

ISSUED FOR CONSTRUCTION		
DRAWN	M. M.	6-25-96
CHECKED	J. K.	7-3-96
ENGINEER	K. R.	7-3-96
PROJ	M. D. W.	7-8-96

**AS-BUILT DRAWINGS**

**PARSONS**  
 100 WEST WALNUT STREET  
 PASADENA, CALIFORNIA

**LIGO**  
 CALIFORNIA INSTITUTE OF TECHNOLOGY  
 MASSACHUSETTS INSTITUTE OF TECHNOLOGY

**LIGO-D960399-02-O**

LASER INTERFEROMETER  
 GRAVITATIONAL-WAVE OBSERVATORY  
 SITE NO. 1 - HANFORD, WASHINGTON

TITLE	SCALE	CONTRACT NUMBER	PROJECT NUMBER
ELECTRICAL CORNER STATION OSB OFFICE AREA FIRE DET & SECURITY PLAN	AS NOTED	PP150969	8094
SHEET NUMBER		REVISIONS	
<b>WA-E-110</b>			