


NOTES:

- COMMUNICATIONS CONDUIT SHALL STUB UP INSIDE THE ACCESS FLOOR CAVITY TO AN ELEVATION THAT WILL PREVENT FLOODING OF CAVITY IF OUTDOOR UNDERGROUND CONDUIT RUNS ARE FILLED WITH WATER.
- PULL ROPE SHALL BE PROVIDED BETWEEN PULL BOXES AND STUB-UPS FOR EACH CONDUIT.
- DUCT BANK SHALL SLOPE DOWN AWAY FROM BUILDING AS SHOWN ON PLAN.
- CIRCUITS SHOW FEEDING THESE ITEMS ARE FROM PANEL W-CS-163-RP-01.
- CIRCUITS SHOW FEEDING THESE ITEMS ARE FROM PANEL W-CS-168-RP-01.

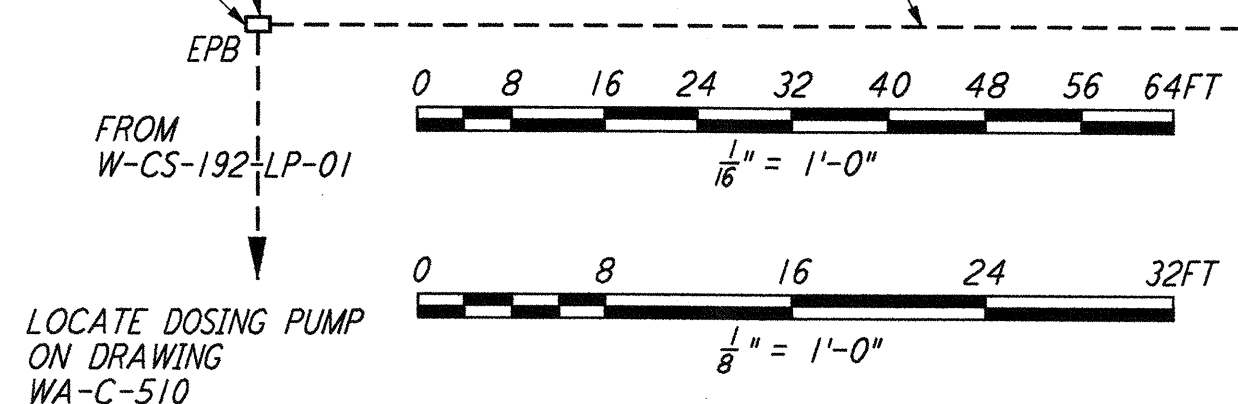

This document and the design it covers are the property of PARSONS. They are loaned only with the borrower's expressed written agreement that they will not be reproduced, copied, loaned, exhibited, or used in any other way, except by written consent from PARSONS to the borrower.

NO.	DATE	BY	CHKD	ENGR	PROJ	DESCRIPTION
2	6-15-98	J. G.				ISSUED FOR AS-BUILT GENERAL REVISIONS
1	3-21-97	J. G.	K. R.	K. R.	TDM	

ISSUED FOR CONSTRUCTION
 DRAWN M. M. 6-25-96
 CHECKED J. K. 7-3-96
 ENGINEER K. R. 7-3-96
 PROJ M. D. W. 7-8-96

AS-BUILT DRAWINGS

100 WEST WALNUT STREET
 PASADENA, CALIFORNIA

CALIFORNIA INSTITUTE OF TECHNOLOGY
 MASSACHUSETTS INSTITUTE OF TECHNOLOGY

LIGO-D960436-02-O

LASER INTERFEROMETER
 GRAVITATIONAL-WAVE OBSERVATORY
 SITE NO. 1 - HANFORD, WASHINGTON

ELECTRICAL CORNER STATION 3RD INTERFEROMETER PWR & LTG PARKING & OBSERVATION PLAN

SCALE: AS NOTED
 CONTRACT NUMBER: PPI 50969
 PROJECT NUMBER: 8094

WA-E-507

No. 09 1305845 1998 C:\PLOT\JOB\ES\Y3862.DCF 52885 K:\V3862\es507.dwg