


This document and the design it covers are the property of PARSONS. They are loaned only with the borrower's expressed written agreement that they will not be reproduced, copied, loaned, exhibited, or used in any other way, except by written consent from PARSONS to the borrower.


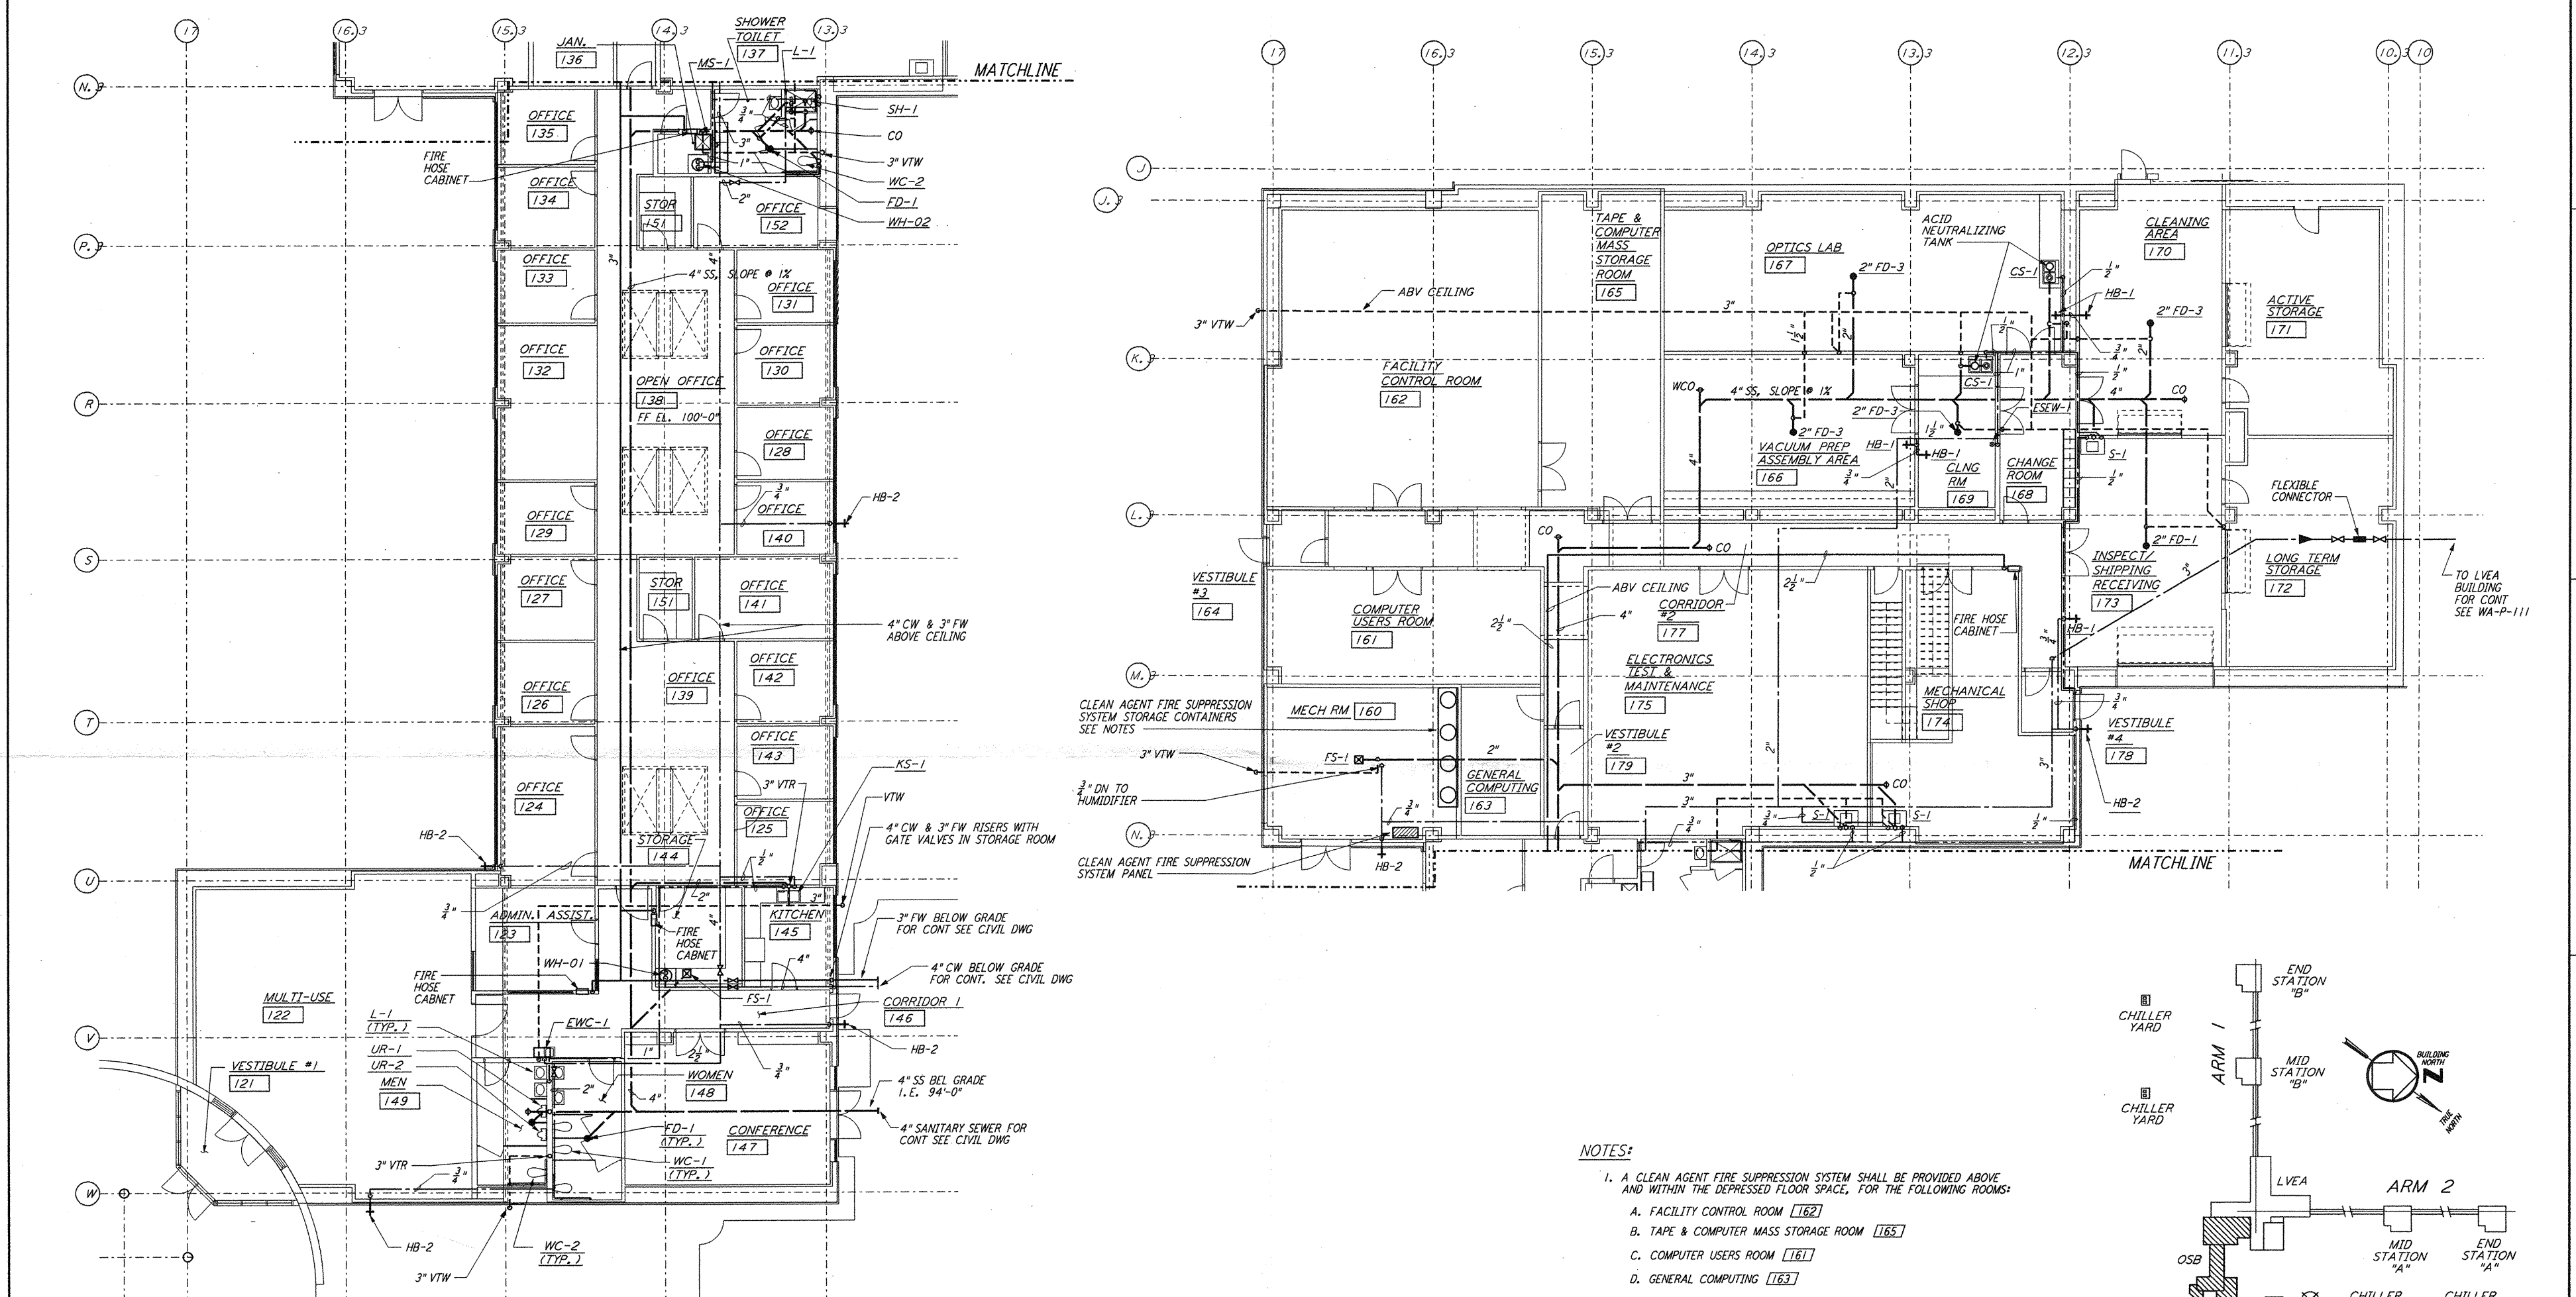


CLEAN AGENT FIRE SUPPRESSION SYSTEM STORAGE CONTAINERS SEE NOTES

3" DN TO HUMIDIFIER

CLEAN AGENT FIRE SUPPRESSION SYSTEM PANEL

- NOTES:**
- A CLEAN AGENT FIRE SUPPRESSION SYSTEM SHALL BE PROVIDED ABOVE AND WITHIN THE DEPRESSED FLOOR SPACE, FOR THE FOLLOWING ROOMS:
 - A. FACILITY CONTROL ROOM [162]
 - B. TAPE & COMPUTER MASS STORAGE ROOM [165]
 - C. COMPUTER USERS ROOM [161]
 - D. GENERAL COMPUTING [163]
 - REFER TO THE PERFORMANCE TYPE SPECIFICATIONS FOR REQUIREMENTS AND DESIGN CRITERIA.

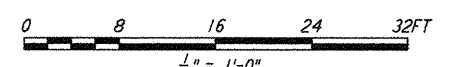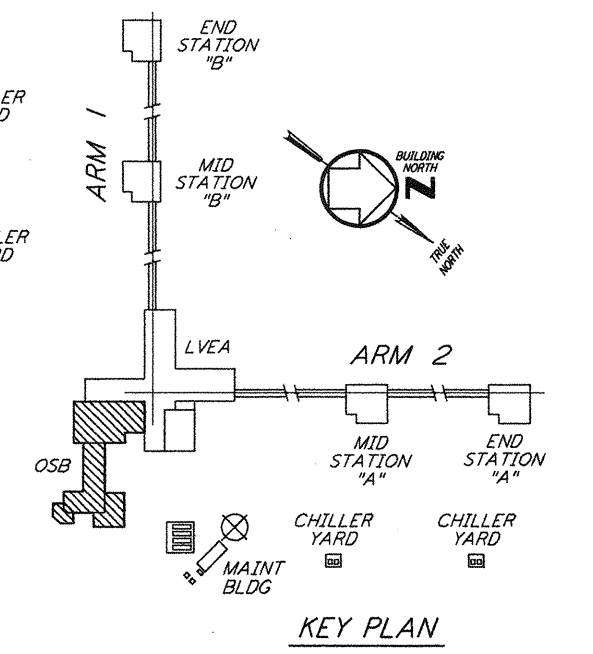

LIGO-D960441-02-O

NO.	DATE	BY	CHKD	ENGR	PROJ	DESCRIPTION
2	5-15-98	CP	AA	AA	MDU	ISSUED FOR AS-BUILT
1	3-20-97	WNK	AA	AA	TDM	REVISED PLUMBING PIPING LAYOUT

ISSUED FOR CONSTRUCTION	DATE	6-24-98
DRAWN	DG	7/1/96
CHECKED	WJR	7/1/96
ENGINEER	MNJ	7/1/96
PROJ	MDU	7/1/96

AS-BUILT DRAWINGS

PARSONS

100 WEST WALNUT STREET
PASADENA, CALIFORNIA

LIGO

CALIFORNIA INSTITUTE OF TECHNOLOGY
MASSACHUSETTS INSTITUTE OF TECHNOLOGY

LASER INTERFEROMETER
GRAVITATIONAL-WAVE OBSERVATORY
SITE NO. 1 - HANFORD, WASHINGTON

TITLE: **PLUMBING CORNER STATION OSB FLOOR PLAN**

AS NOTED PPI50969 8094

WA-P-112