



not be reproduced, copied, loaned, exhibited, or used in any other way, except by written consent from PARSONS to the borrower.

This document and the design it covers are the property of PARSONS. They are loaned only with the borrower's expressed written agreement that they will

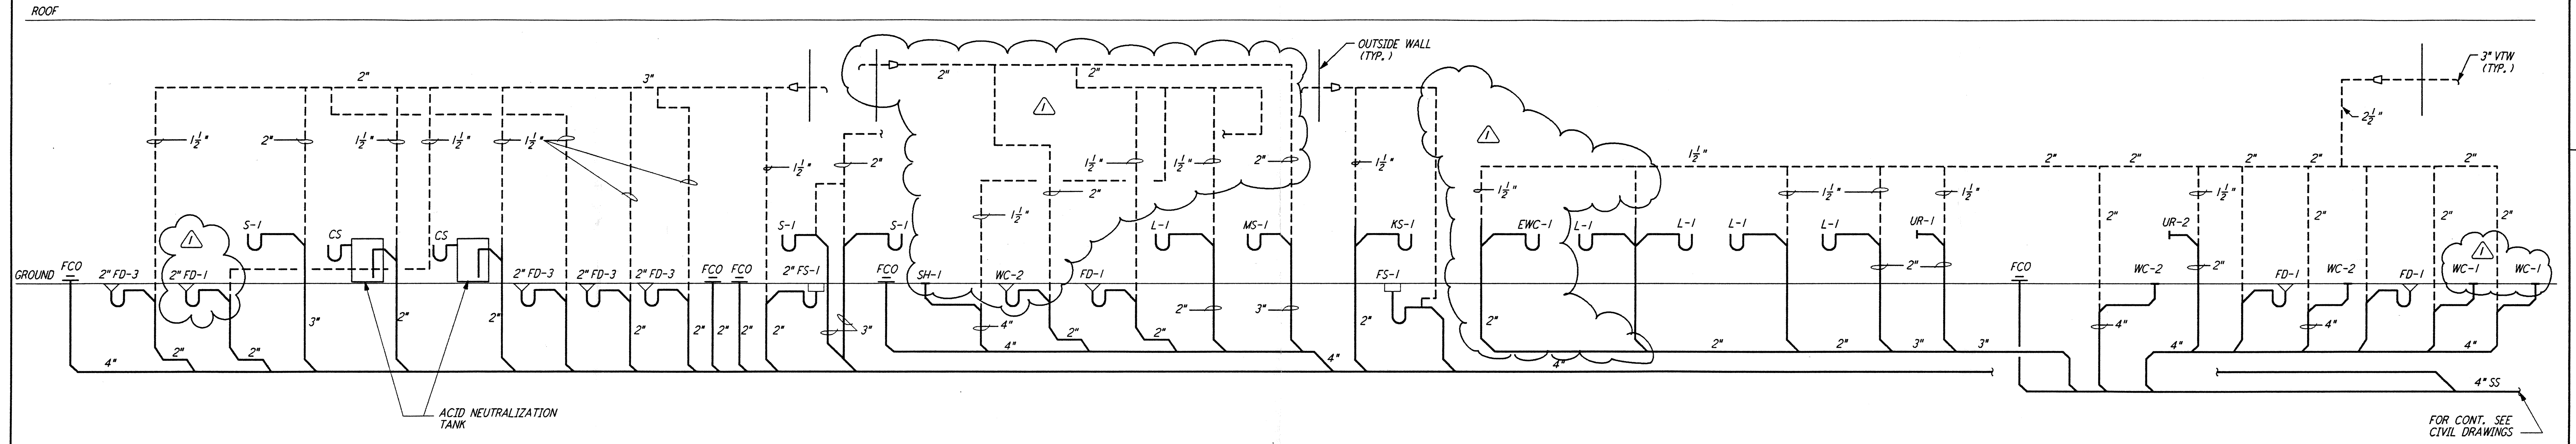

WASTE AND VENT RISER DIAGRAM

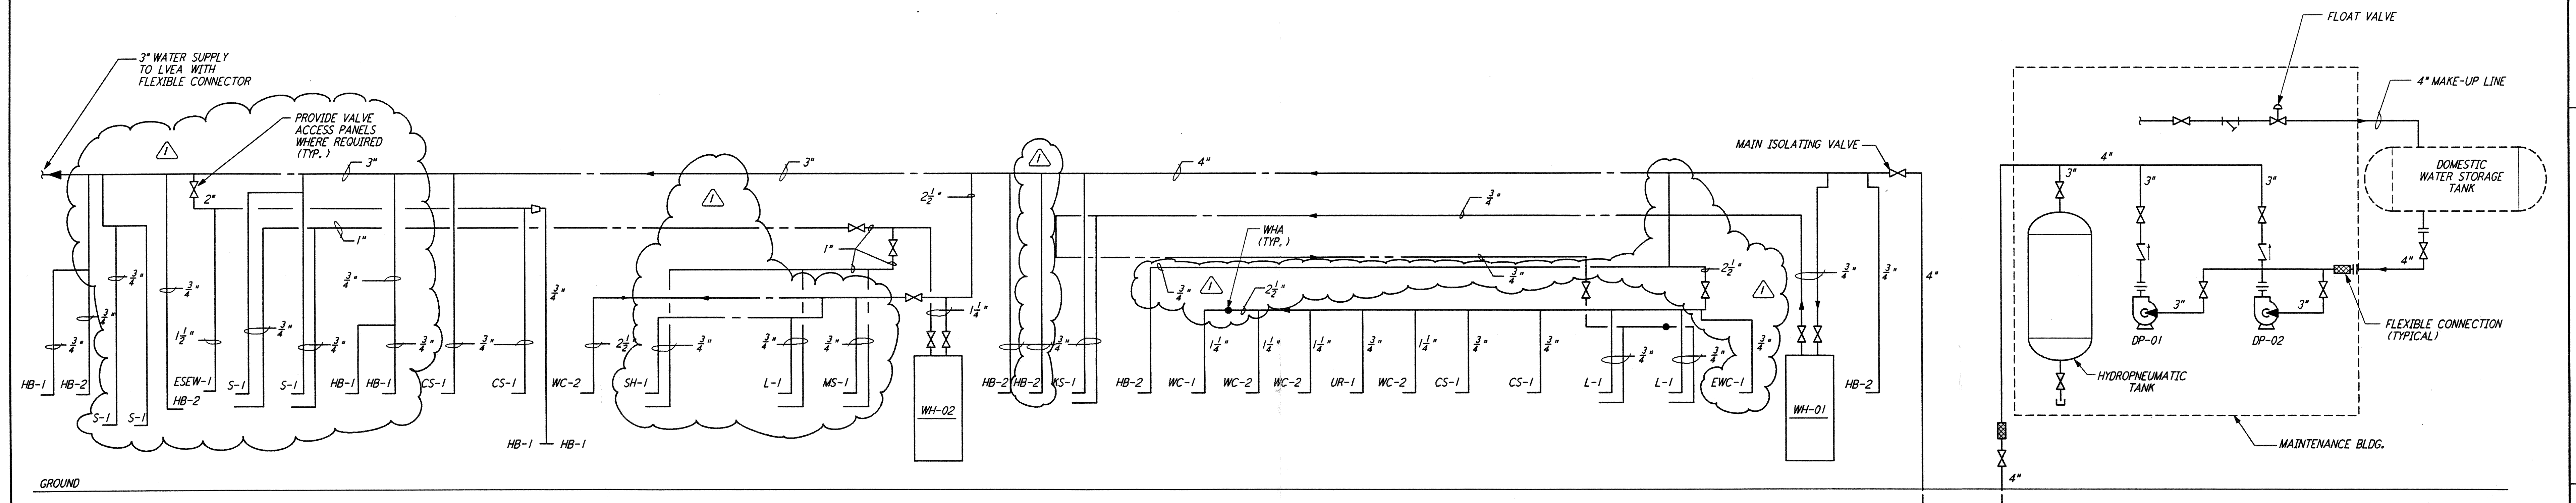


HOT AND COLD WATER RISER DIAGRAM

LIGO-D960443-01-0

NO.	DATE	BY	CHKD	ENGR	PROJ	DESCRIPTION
1	3-20-97	WNK	AA	AA	TDM	REVISED RISER DIAGRAMS

ISSUED FOR CONSTRUCTION
 DRAWN DG 6-24-96
 CHECKED WR 7-9-96
 ENGINEER MN 7-9-96
 PROJ MDW 7-9-96

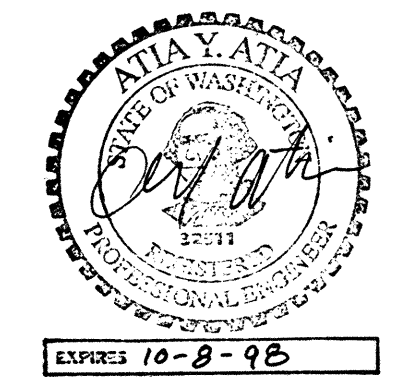

PARSONS
 100 WEST WALNUT STREET
 PASADENA, CALIFORNIA

LIGO
 CALIFORNIA INSTITUTE OF TECHNOLOGY
 MASSACHUSETTS INSTITUTE OF TECHNOLOGY

TITLE PLUMBING CORNER STATION RISER DIAGRAM			SCALE NONE	CONTRACT NUMBER PPI50969	PROJECT NUMBER 8094
SHEET NUMBER WA-P-131			REVISIONS		