




NOTES:
 1. SET THE LOW LEVEL ALARM OF THE WATER STORAGE TANK (WT-01) AT 200 GALLONS. SET THE MAXIMUM WATER LEVEL AT 900 GALLONS.

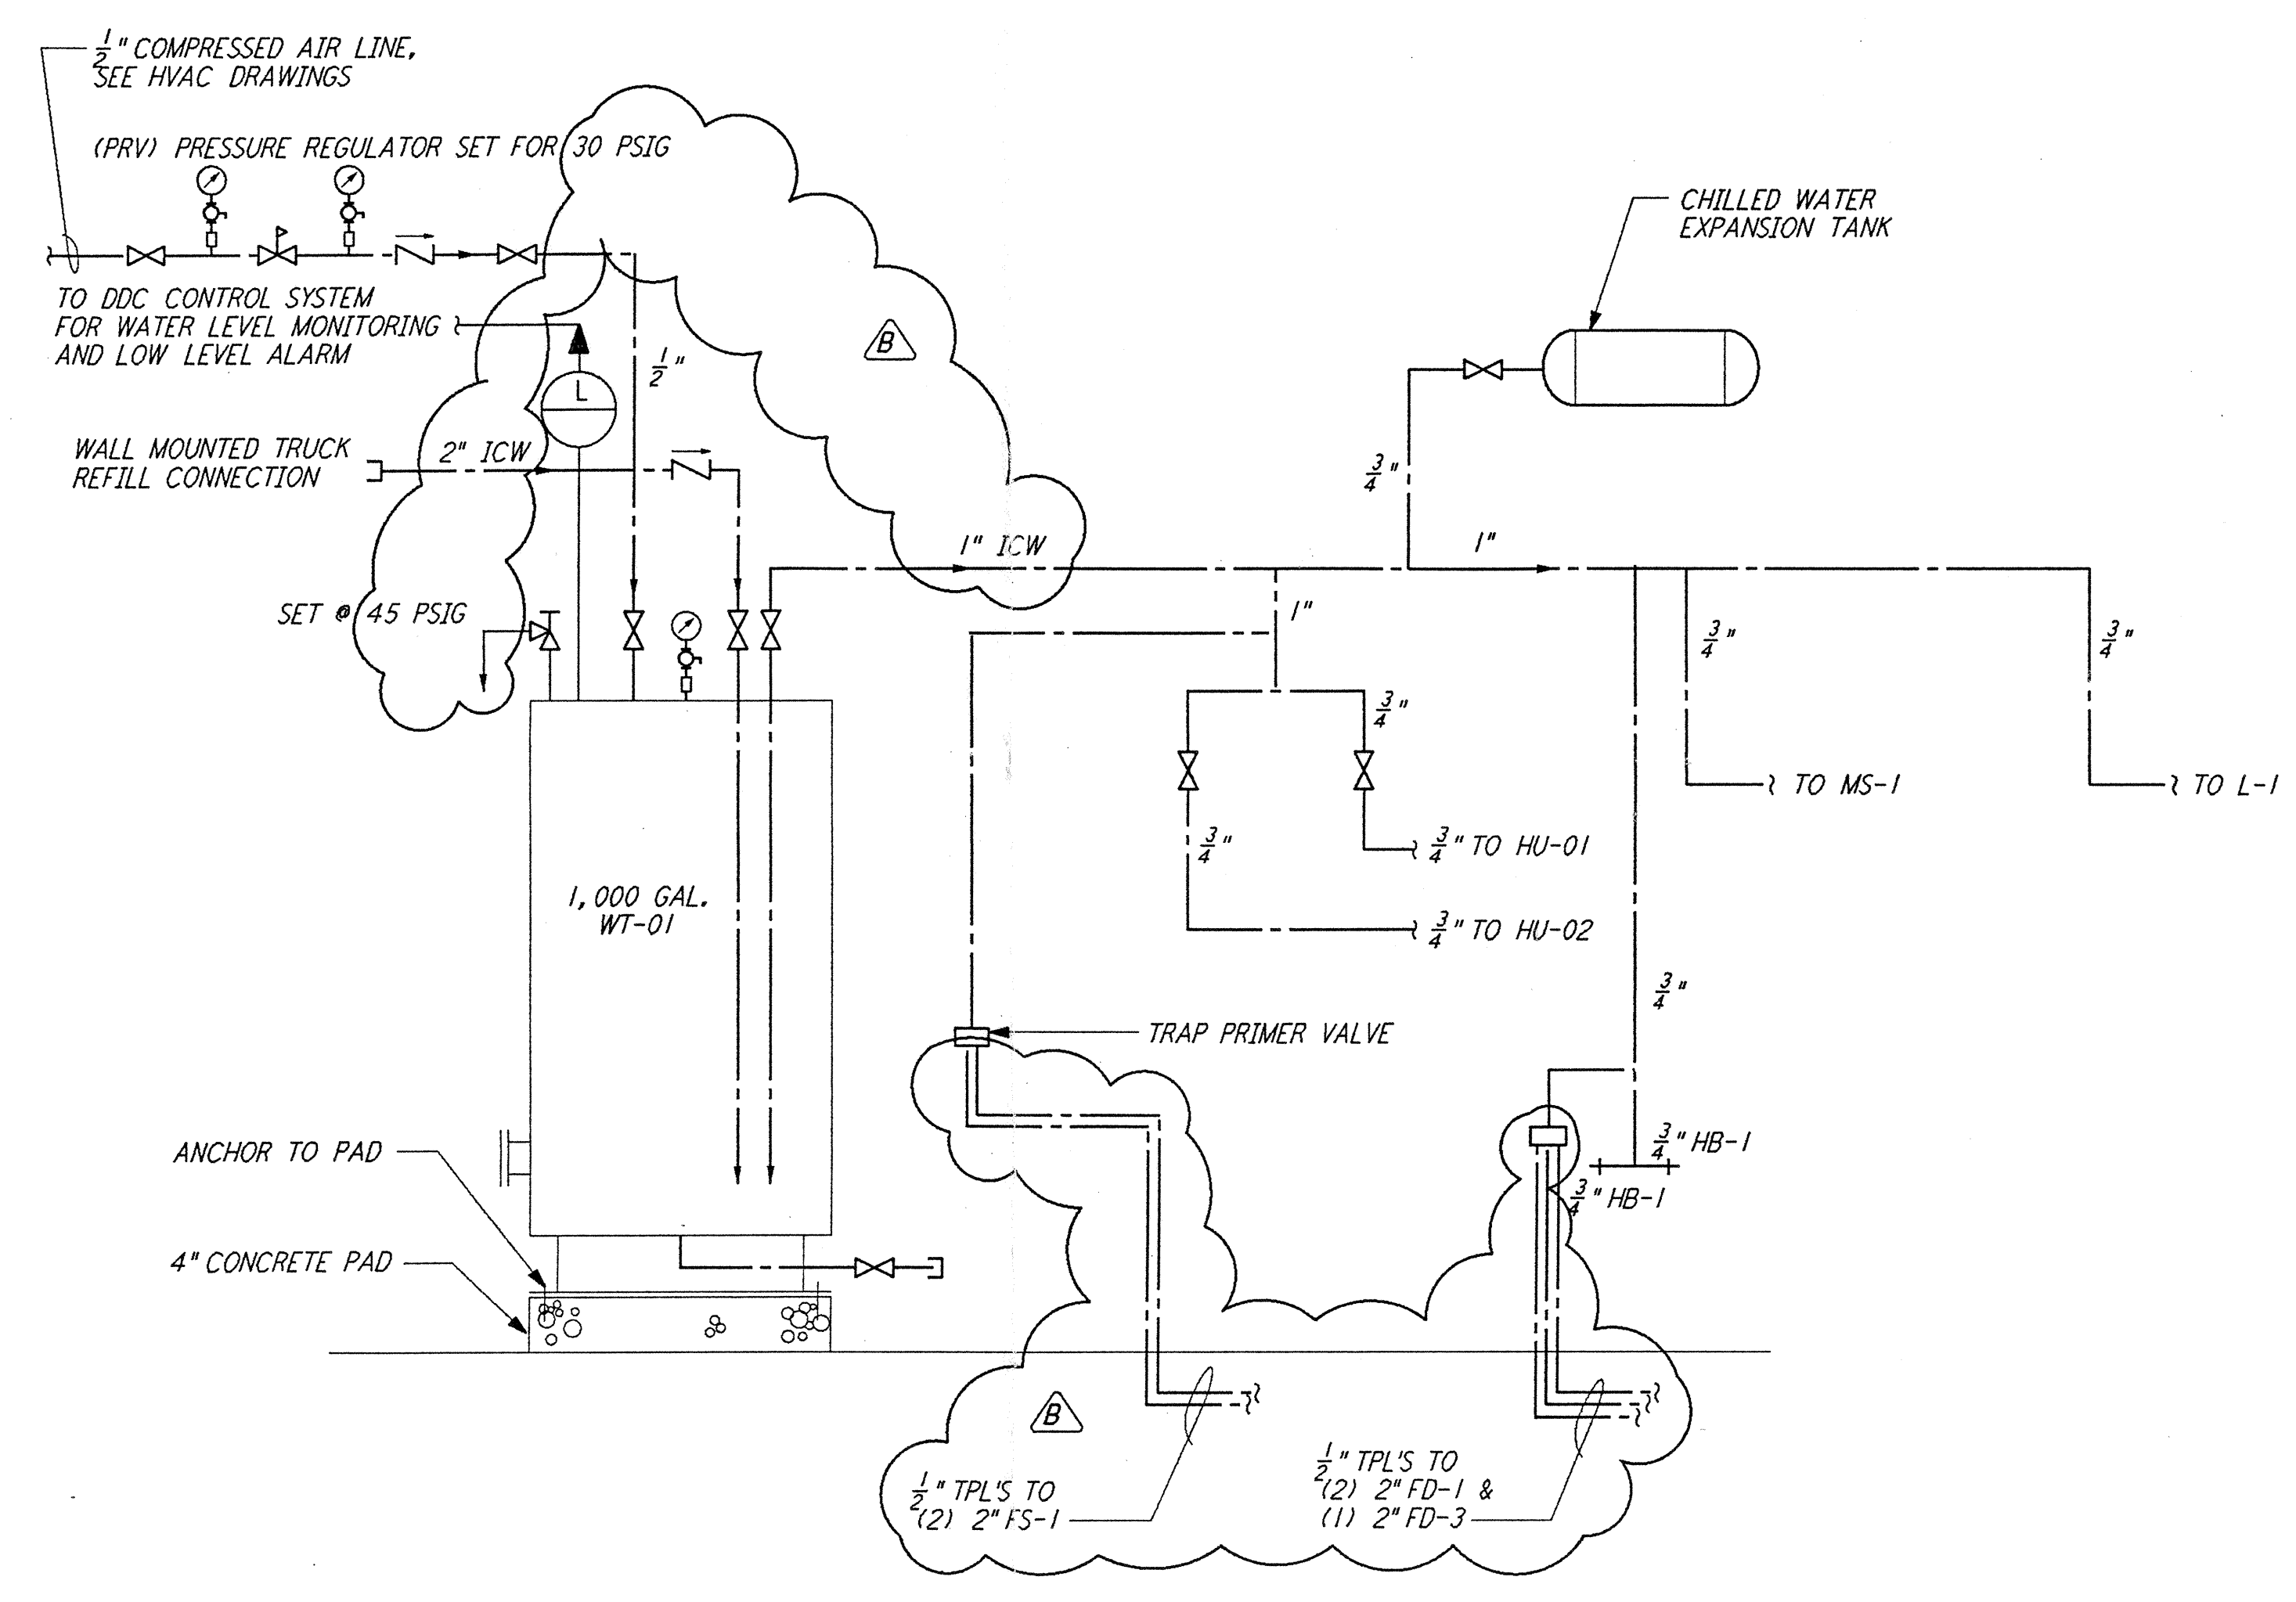

DOMESTIC WATER SUPPLY SYSTEM
 (TYP FOR 4 STATIONS)

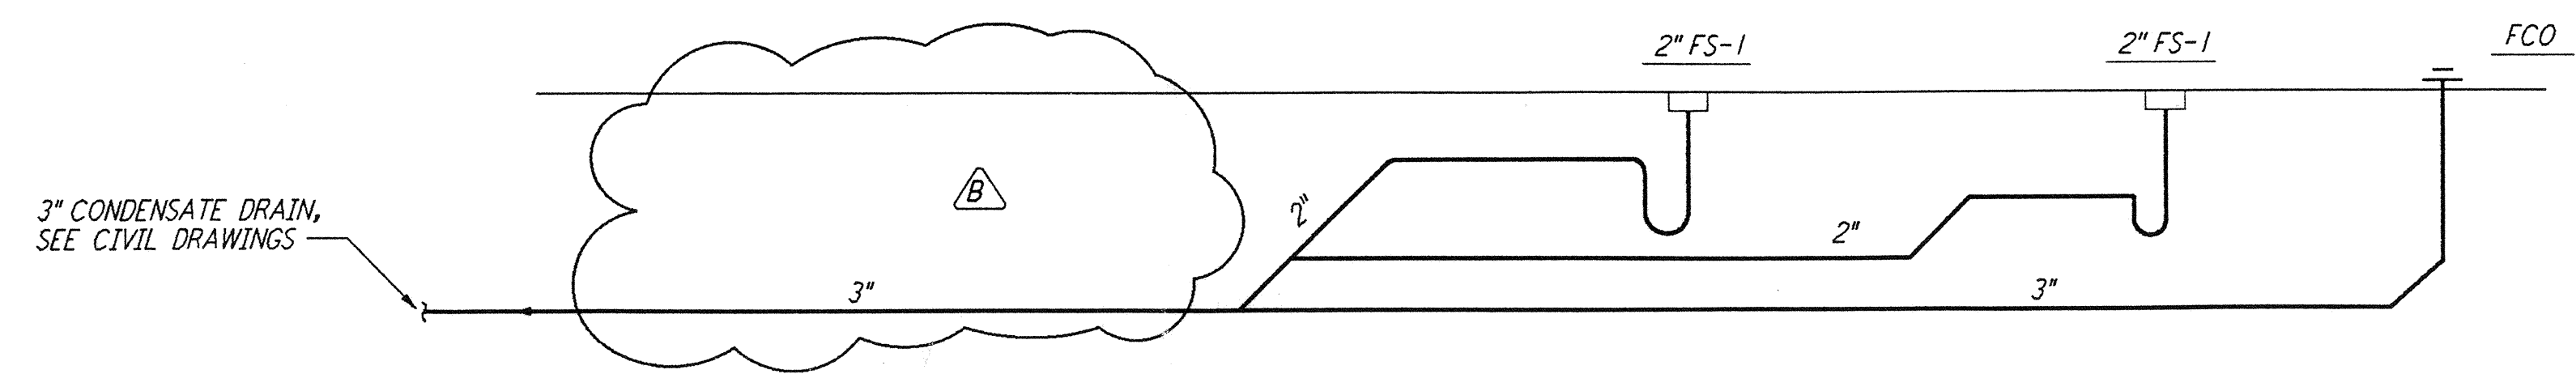

SANITARY SEWER PIPING SCHEMATIC FOR MECH ROOM 203
 (TYP FOR 4 STATIONS)

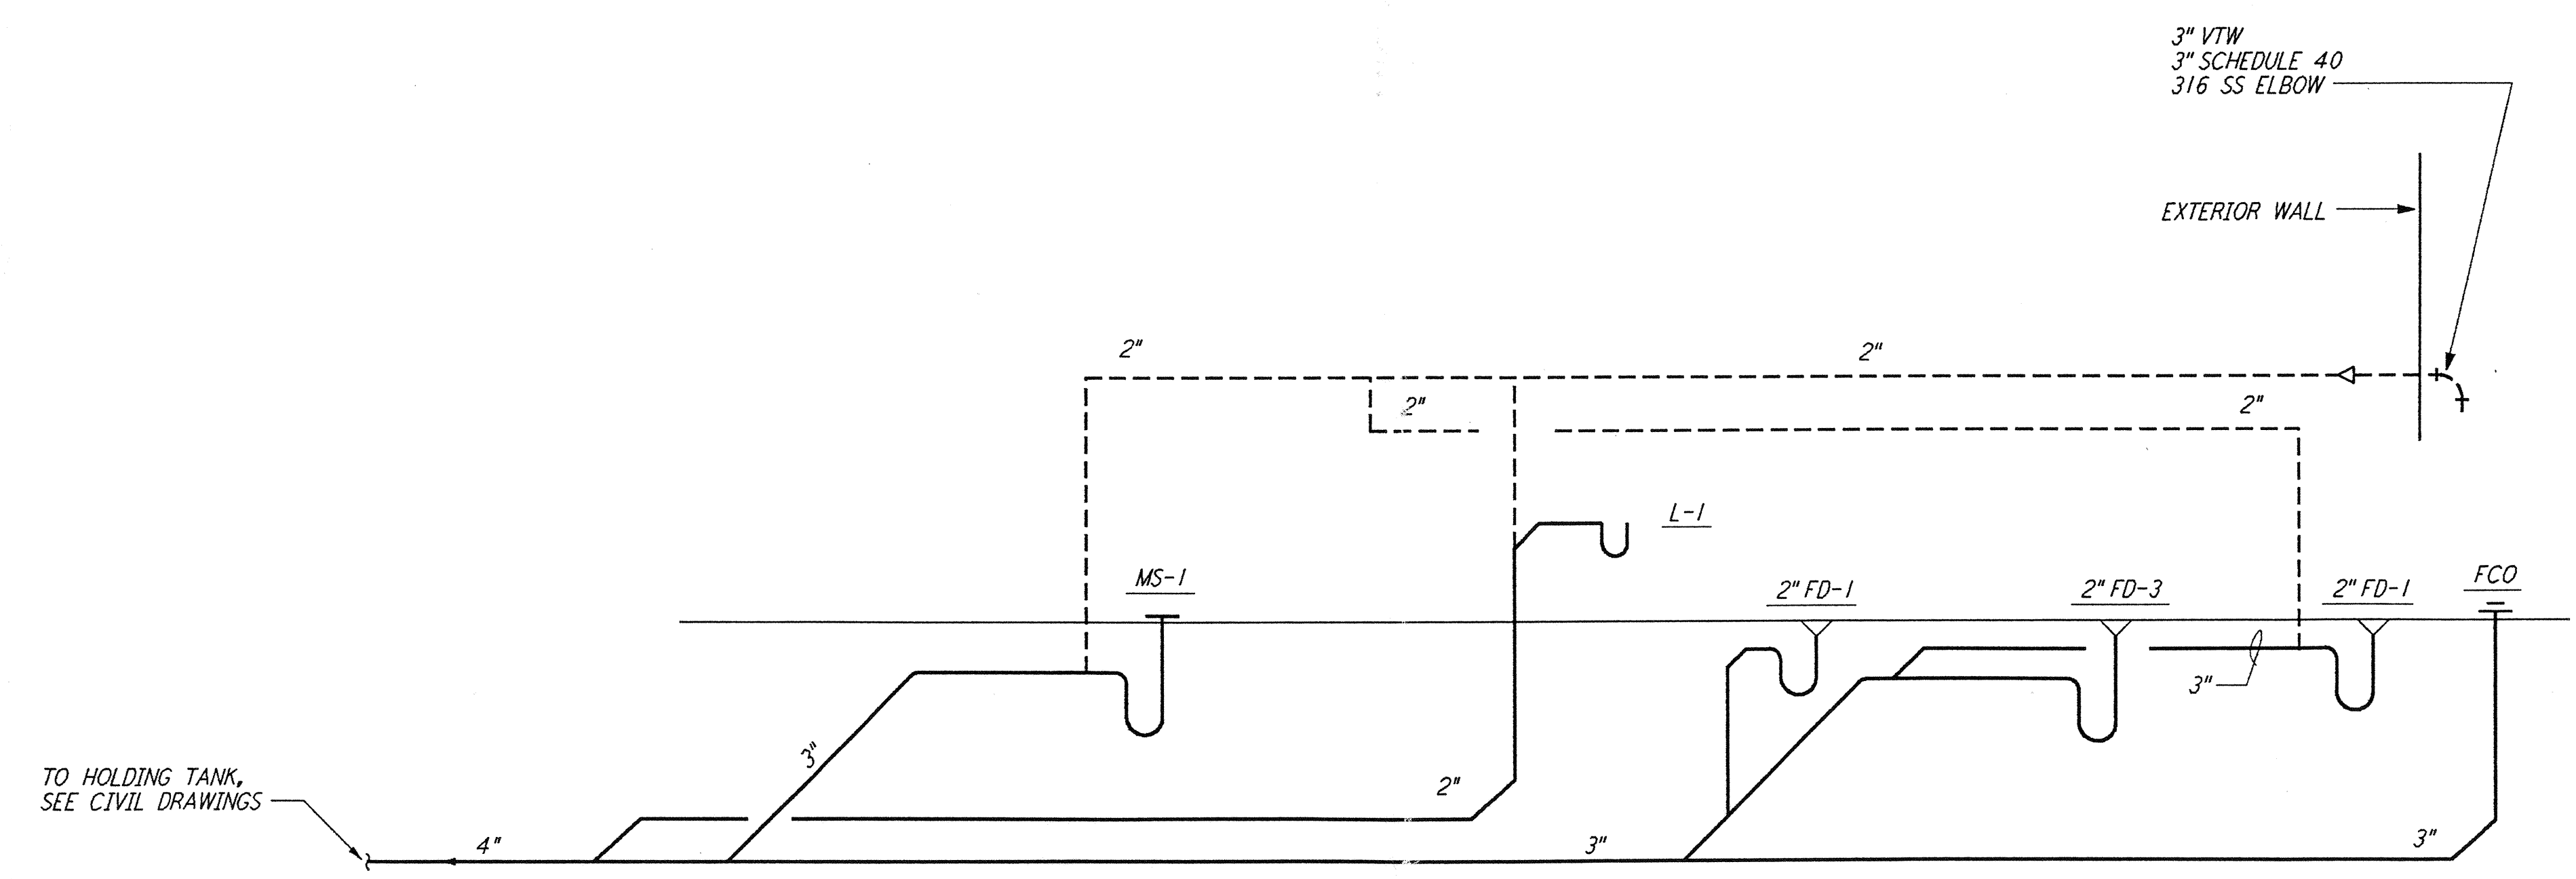

SANITARY SEWER PIPING SCHEMATIC FOR RESTROOM & CLEANING AREA
 (TYP FOR 4 STATIONS)

not be reproduced, copied, loaned, exhibited, or used in any other way, except by written consent from PARSONS to the borrower.

This document and the design it covers are the property of PARSONS. They are loaned only with the borrower's expressed written agreement that they will

NO.	DATE	BY	CHKD	ENGR	PROJ	DESCRIPTION
B	5-22-96	CLP	WR	MN	TDM	BID ADDENDUM #2
A	4-19-96	DG	MP	MN	TDM	FINAL DESIGN REVIEW & BID

DRAWN	DG
CHECKED	
ENGINEER	
PROJ	

PARSONS
 100 WEST WALNUT STREET
 PASADENA, CALIFORNIA

LIGO
 CALIFORNIA INSTITUTE OF TECHNOLOGY
 MASSACHUSETTS INSTITUTE OF TECHNOLOGY

LASER INTERFEROMETER
 GRAVITATIONAL-WAVE OBSERVATORY
 SITE NO. 1 - HANFORD, WASHINGTON

TITLE	SCALE	CONTRACT NUMBER	PROJECT NUMBER
PLUMBING MID & END STATIONS RISER DIAGRAM & SCHEMATICS	NONE	PPI50969	8094
SHEET NUMBER		REVISIONS	
WA-P-212		B	

LIGO-D960445-B-0