



not be reproduced, copied, loaned, exhibited, or used in any other way, except by written consent from PARSONS to the borrower.

This document and the design it covers are the property of PARSONS. They are loaned only with the borrower's expressed written agreement that they will

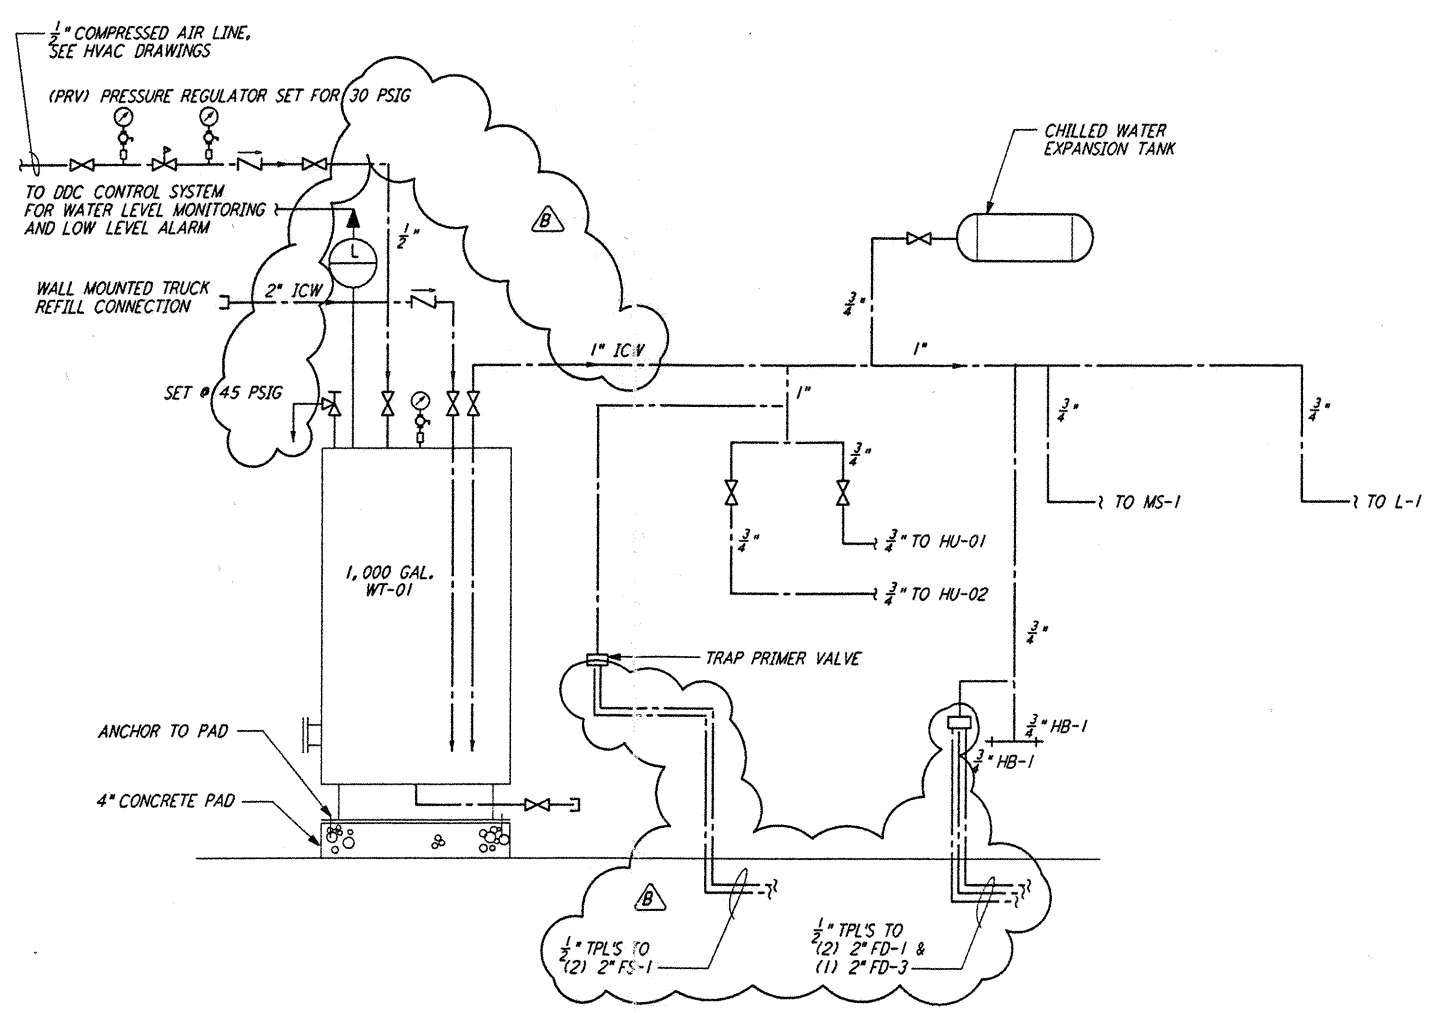


**DOMESTIC WATER SUPPLY SYSTEM**  
(TYP FOR 4 STATIONS)

**NOTES:**  
 1. SET THE LOW LEVEL ALARM OF THE WATER STORAGE TANK (WT-01) AT 200 GALLONS. SET THE MAXIMUM WATER LEVEL AT 900 GALLONS.

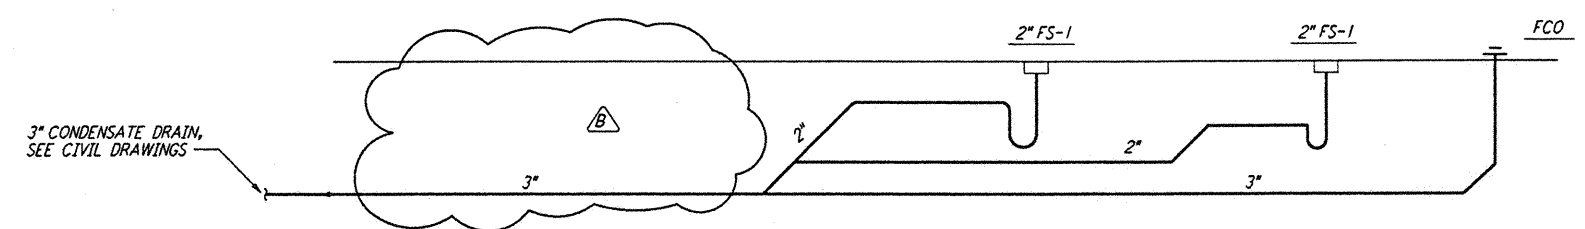

**SANITARY SEWER PIPING SCHEMATIC FOR MECH ROOM 203**  
(TYP FOR 4 STATIONS)

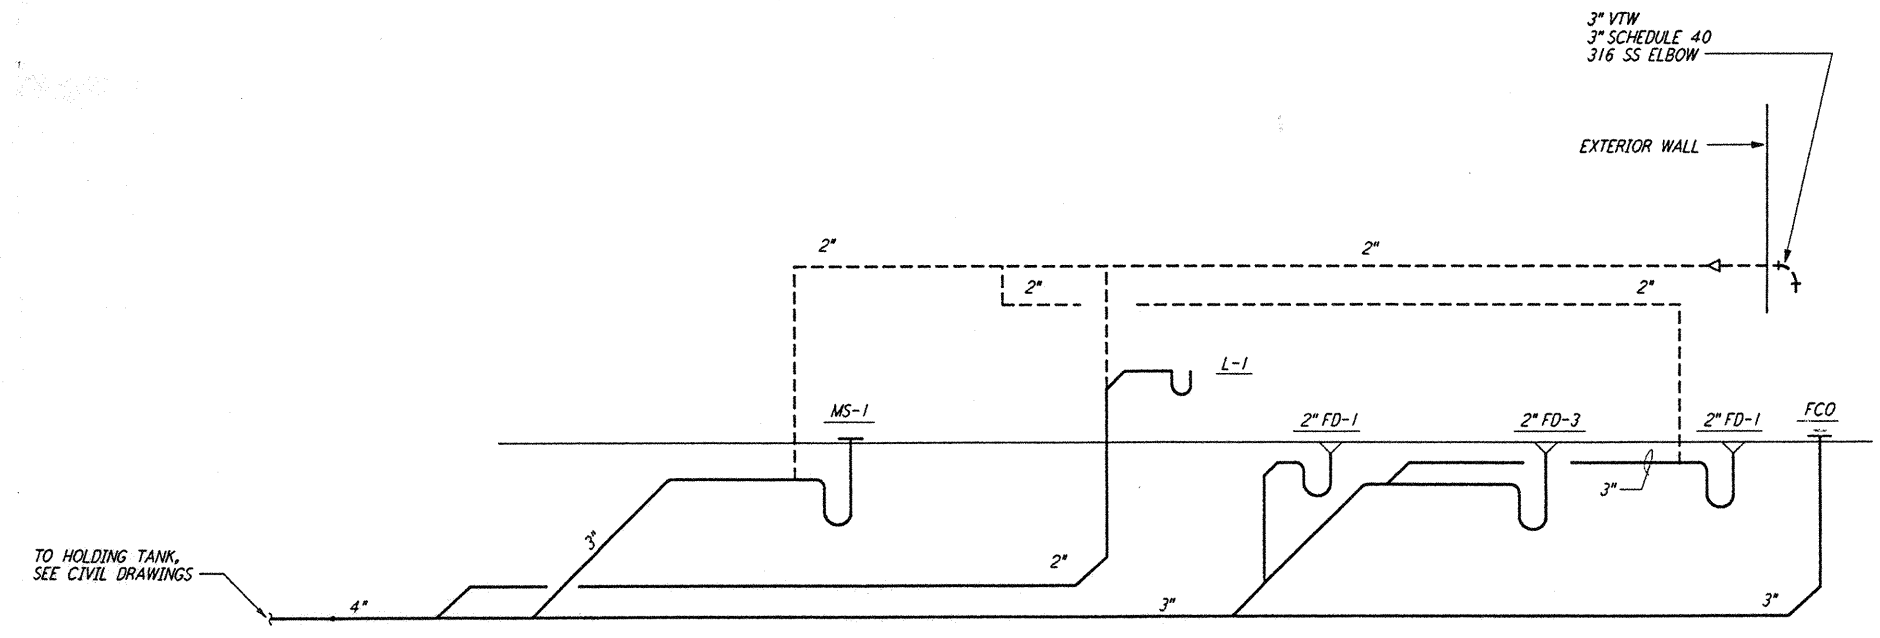

**SANITARY SEWER PIPING SCHEMATIC FOR RESTROOM & CLEANING AREA**  
(TYP FOR 4 STATIONS)

NO.	DATE	BY	CHKD	ENGR	PROJ	DESCRIPTION
B	5-22-96	CLP	WR	MN	TDM	BID ADDENDUM #2
A	4-19-96	DG	MP	MN	TDM	FINAL DESIGN REVIEW & BID

DRAWN	DC
CHECKED	
ENGINEER	
PROJ	

**PARSONS**  
 100 WEST WALNUT STREET  
 PASADENA, CALIFORNIA

**LIGO**  
 CALIFORNIA INSTITUTE OF TECHNOLOGY  
 MASSACHUSETTS INSTITUTE OF TECHNOLOGY

**LIGO-D960445-B-01**  
 LASER INTERFEROMETER  
 GRAVITATIONAL-WAVE OBSERVATORY  
 SITE NO. 1 - HANFORD, WASHINGTON

TITLE	PLUMBING MID & END STATIONS RISER DIAGRAM & SCHEMATICS
SCALE	NONE
CONTRACT NUMBER	PPI50969
PROJECT NUMBER	8094
SHEET NUMBER	<b>WA-P-212</b>