



**NOTE:**


- 1. CAP ALL PIPING STUB-UPS 12" ABOVE FINISHED FLOOR.
- 2. - - - - - INDICATES WORK TO BE DONE BY OTHERS.

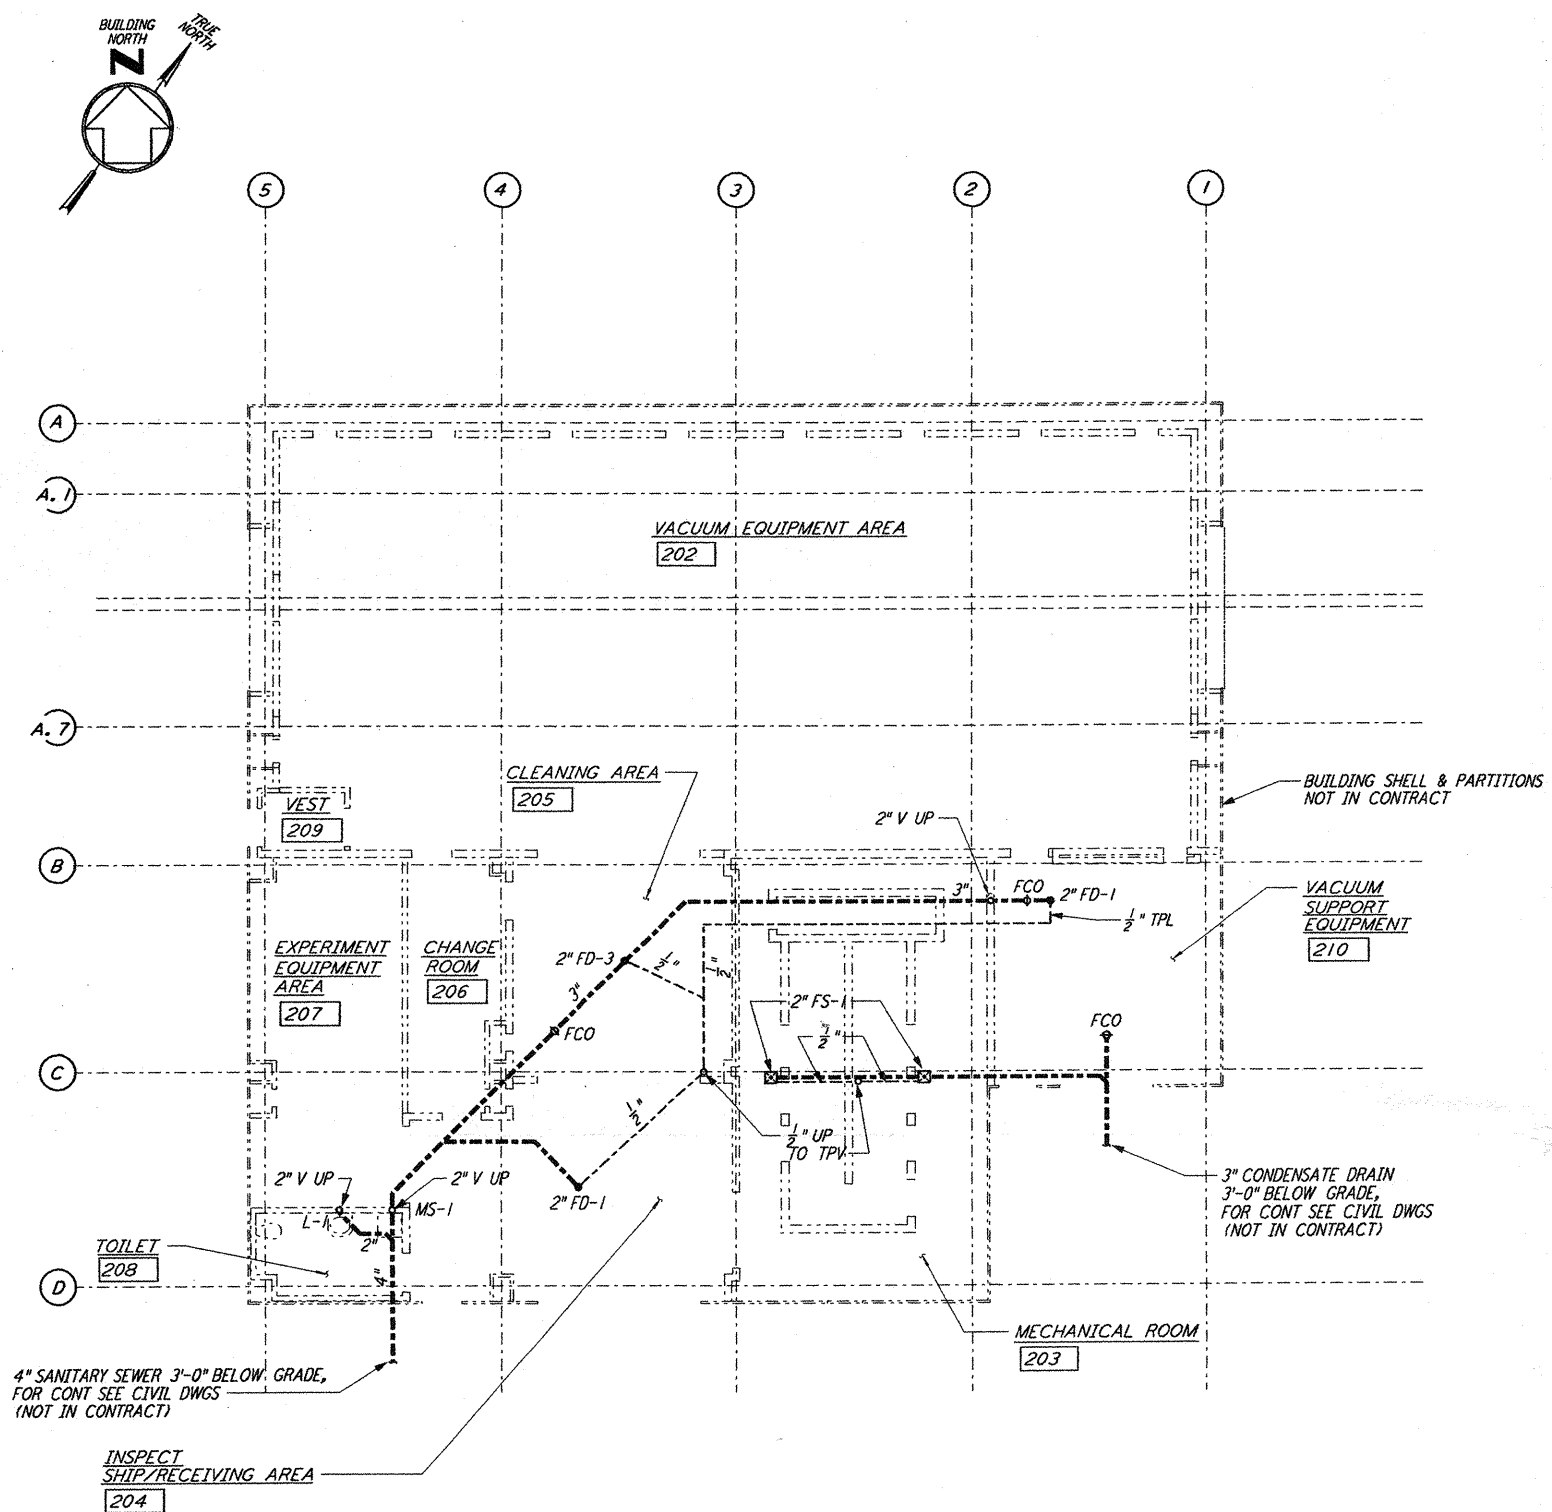

**MID & END STATION "B" UNDERGROUND PLAN**  
1/8" = 1'-0"

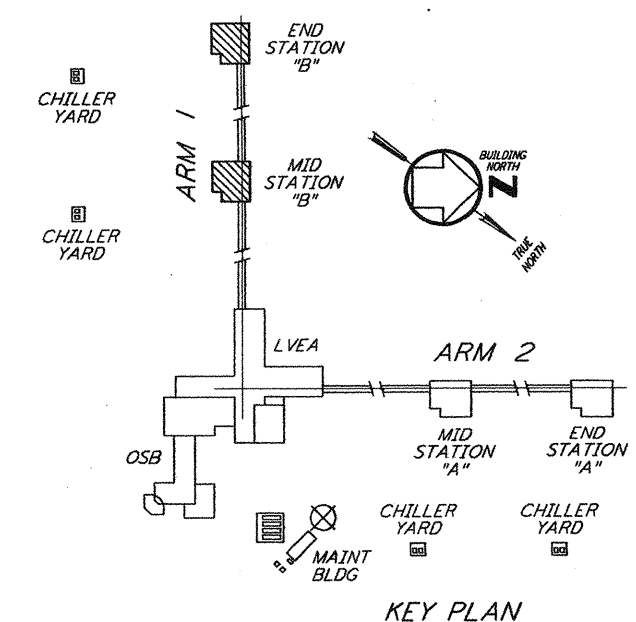

LIGO-D960747-00-0

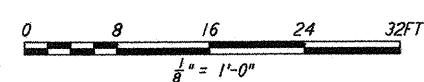

This document and the design it covers are the property of PARSONS. They are loaned only within the borrower's expressed written agreement that they will not be reproduced, copied, loaned, exhibited, or used in any other way, except by written consent from PARSONS to the borrower.

NO.	DATE	BY	CHKD	ENGR	PROJ	DESCRIPTION
0	1-22-99	MET			MDW	ISSUED FOR AS BUILT
A	4-19-96	CLP				CHANGE ORDER #4

AS-BUILT DRAWINGS
-------------------

**PARSONS**  
100 WEST WALNUT STREET  
PASADENA, CALIFORNIA

**LIGO**  
CALIFORNIA INSTITUTE OF TECHNOLOGY  
MASSACHUSETTS INSTITUTE OF TECHNOLOGY

LASER INTERFEROMETER  
GRAVITATIONAL-WAVE OBSERVATORY  
BTE SITWORK & FABRICATION - HANFORD, WA

TITLE	SCALE	CONTRACT NUMBER	PROJECT NUMBER
PLUMBING MID & END STATIONS "B" UNDERGROUND PLAN	AS NOTED	PP150969	8094
SHEET NUMBER		REVISIONS	
BT-P-601			