




- NOTES:**
1. CAP ALL PIPING STUB-UPS 12" ABOVE FINISHED FLOOR.
 2. - - - - - INDICATES WORK TO BE DONE BY OTHERS.

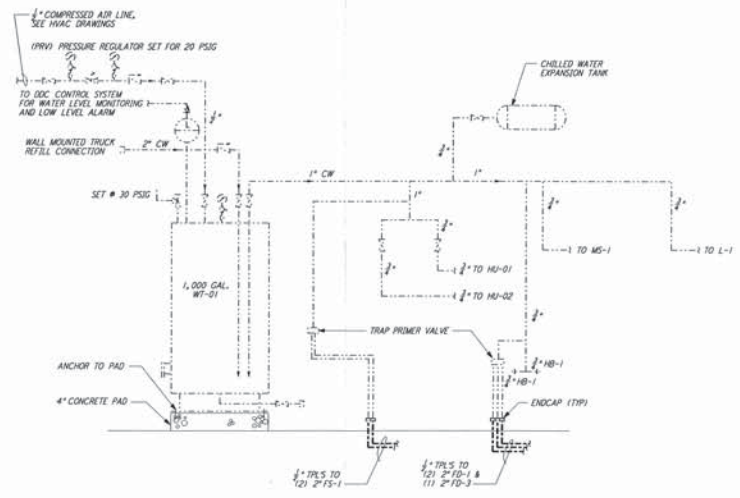

DOMESTIC WATER SUPPLY SYSTEM
 (TYP FOR 2 STATIONS)

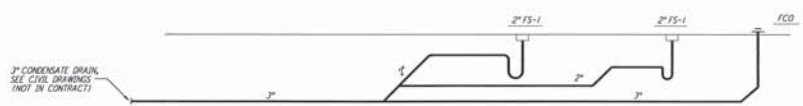

SANITARY SEWER PIPING SCHEMATIC FOR MECH ROOM 203
 (TYP FOR 2 STATIONS)

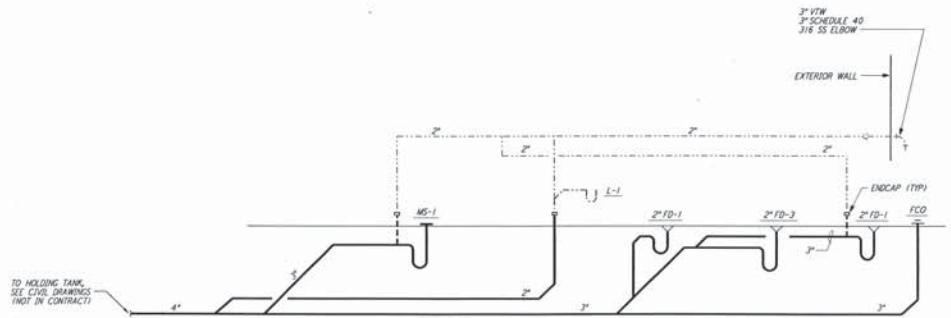

SANITARY SEWER PIPING SCHEMATIC FOR RESTROOM & CLEANING AREA
 (TYP FOR 2 STATIONS)

LIGO-D960748-00-O

REV	DATE	BY	CHKD	ENGR	PROJ	DESCRIPTION
D	1-22-99	MEI	--	--	MDW	ISSUED FOR AS BUILT
A	4-19-96	CLP				CHANGE ORDER #4

AS-BUILT
 DRAWINGS

PARSONS
 100 WEST WALNUT STREET
 PASADENA, CALIFORNIA

LIGO
 CALIFORNIA INSTITUTE OF TECHNOLOGY
 MASSACHUSETTS INSTITUTE OF TECHNOLOGY

LASER INTERFEROMETER
 GRAVITATIONAL-WAVE OBSERVATORY
 BTE SITENWORK & FABRICATION - HANFORD, WA

PLUMBING
 MID & END STATIONS "B"
 RISER DIAGRAM & SCHEMATICS

NONE
 PP150969
 8094

BT-P-602

This document and the design it covers are the property of PARSONS. It is to be used only in connection with the project and site for which it was prepared. It is not to be reproduced, copied, loaned, exhibited, or used in any way without the written consent of PARSONS.