


This document and the design it covers are the property of PARSONS. They are loaned only with the borrower's expressed written agreement that they will not be reproduced, copied, loaned, exhibited, or used in any other way, except by written consent from PARSONS.

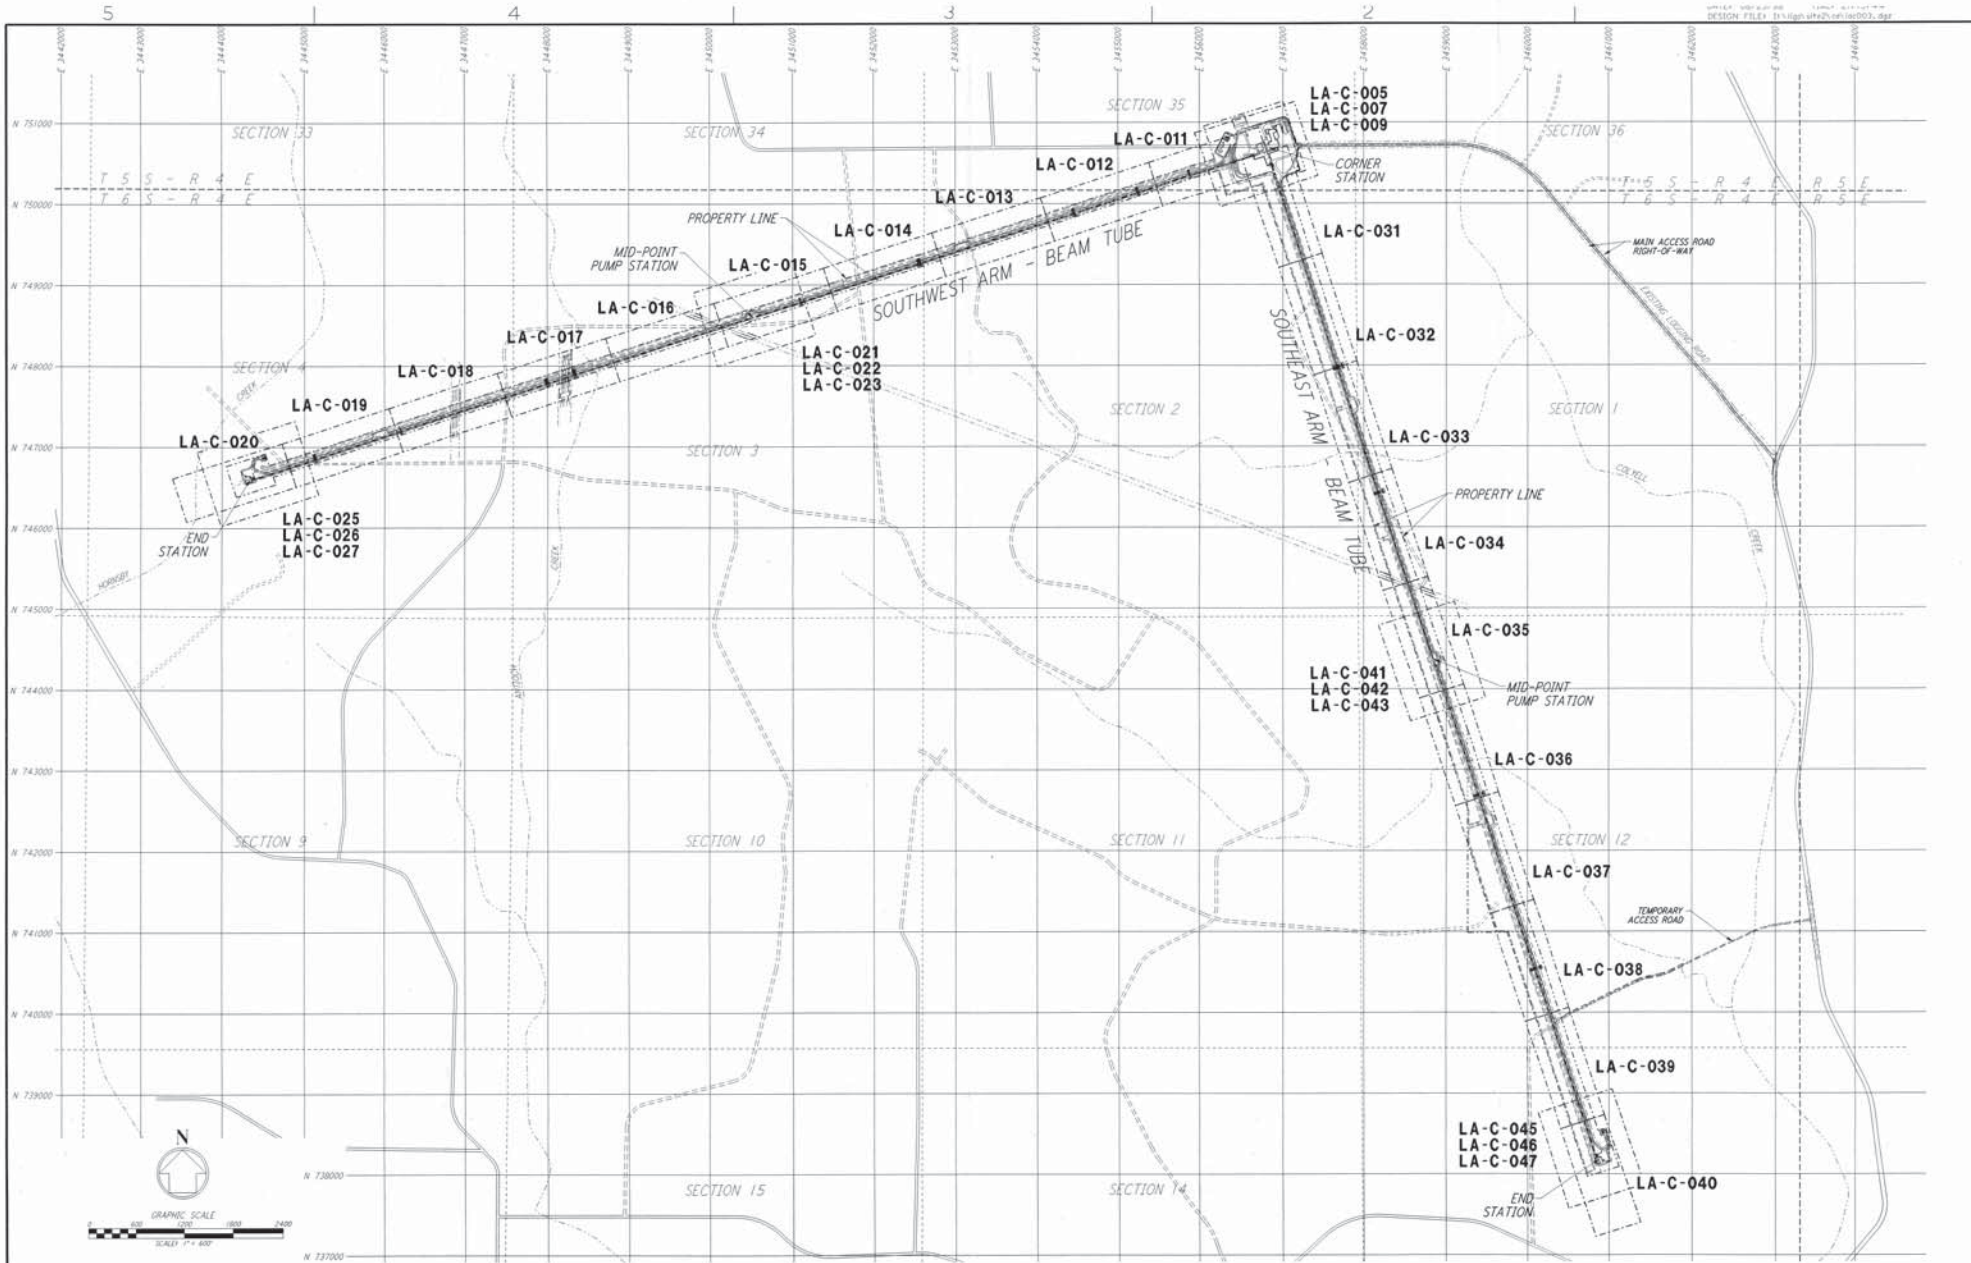

NO.	ISSUED FOR CONSTRUCTION
DRAWN	WRB 11-15-96
CHECKED	ME 11-15-96
ENGINEER	JB 11-15-96
PROJ.	TDW 11-15-96

NO.	DATE	BY	CHKD	ENGR	PROJ.	DESCRIPTION
1	08-07-99	WRB				ISSUED FOR AS-BUILT

AS-BUILT DRAWINGS

PARSONS
 100 WEST WALNUT STREET
 PASADENA, CALIFORNIA

LIGO
 CALIFORNIA INSTITUTE OF TECHNOLOGY
 MASSACHUSETTS INSTITUTE OF TECHNOLOGY

LIGO-D960821-01-0
 LASER INTERFEROMETER
 GRAVITATIONAL-WAVE OBSERVATORY
 SITE NO. 2 - LIVINGSTON, LOUISIANA

TITLE

CIVIL
 DRAWING MATRIX

* = 600' PPI 50969 8094

LA-C-003