

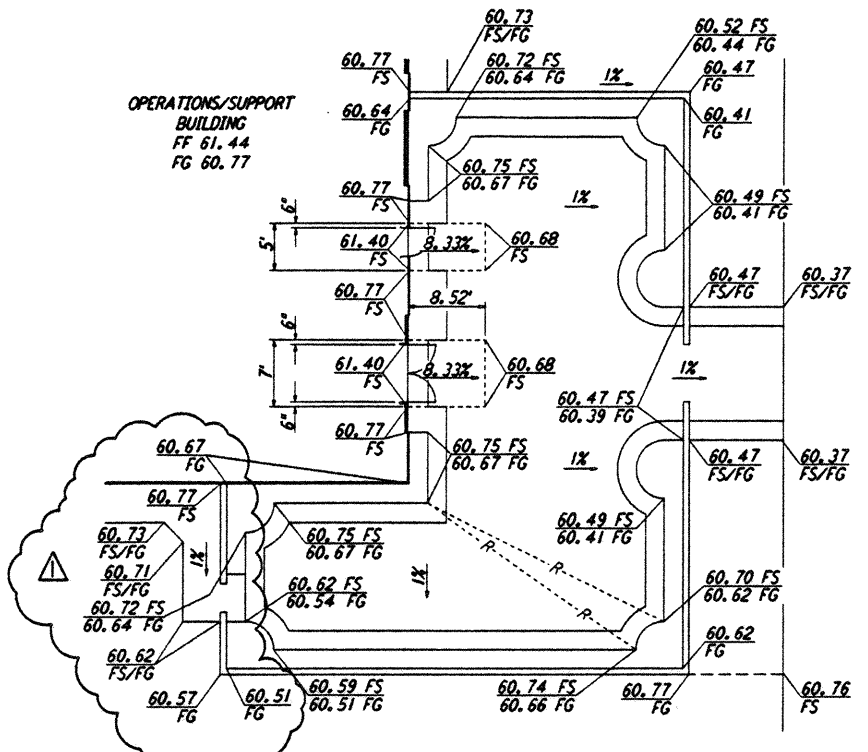



ENLARGED AREA - BUILDING ENTRANCE  
SCALE: 1" = 20'

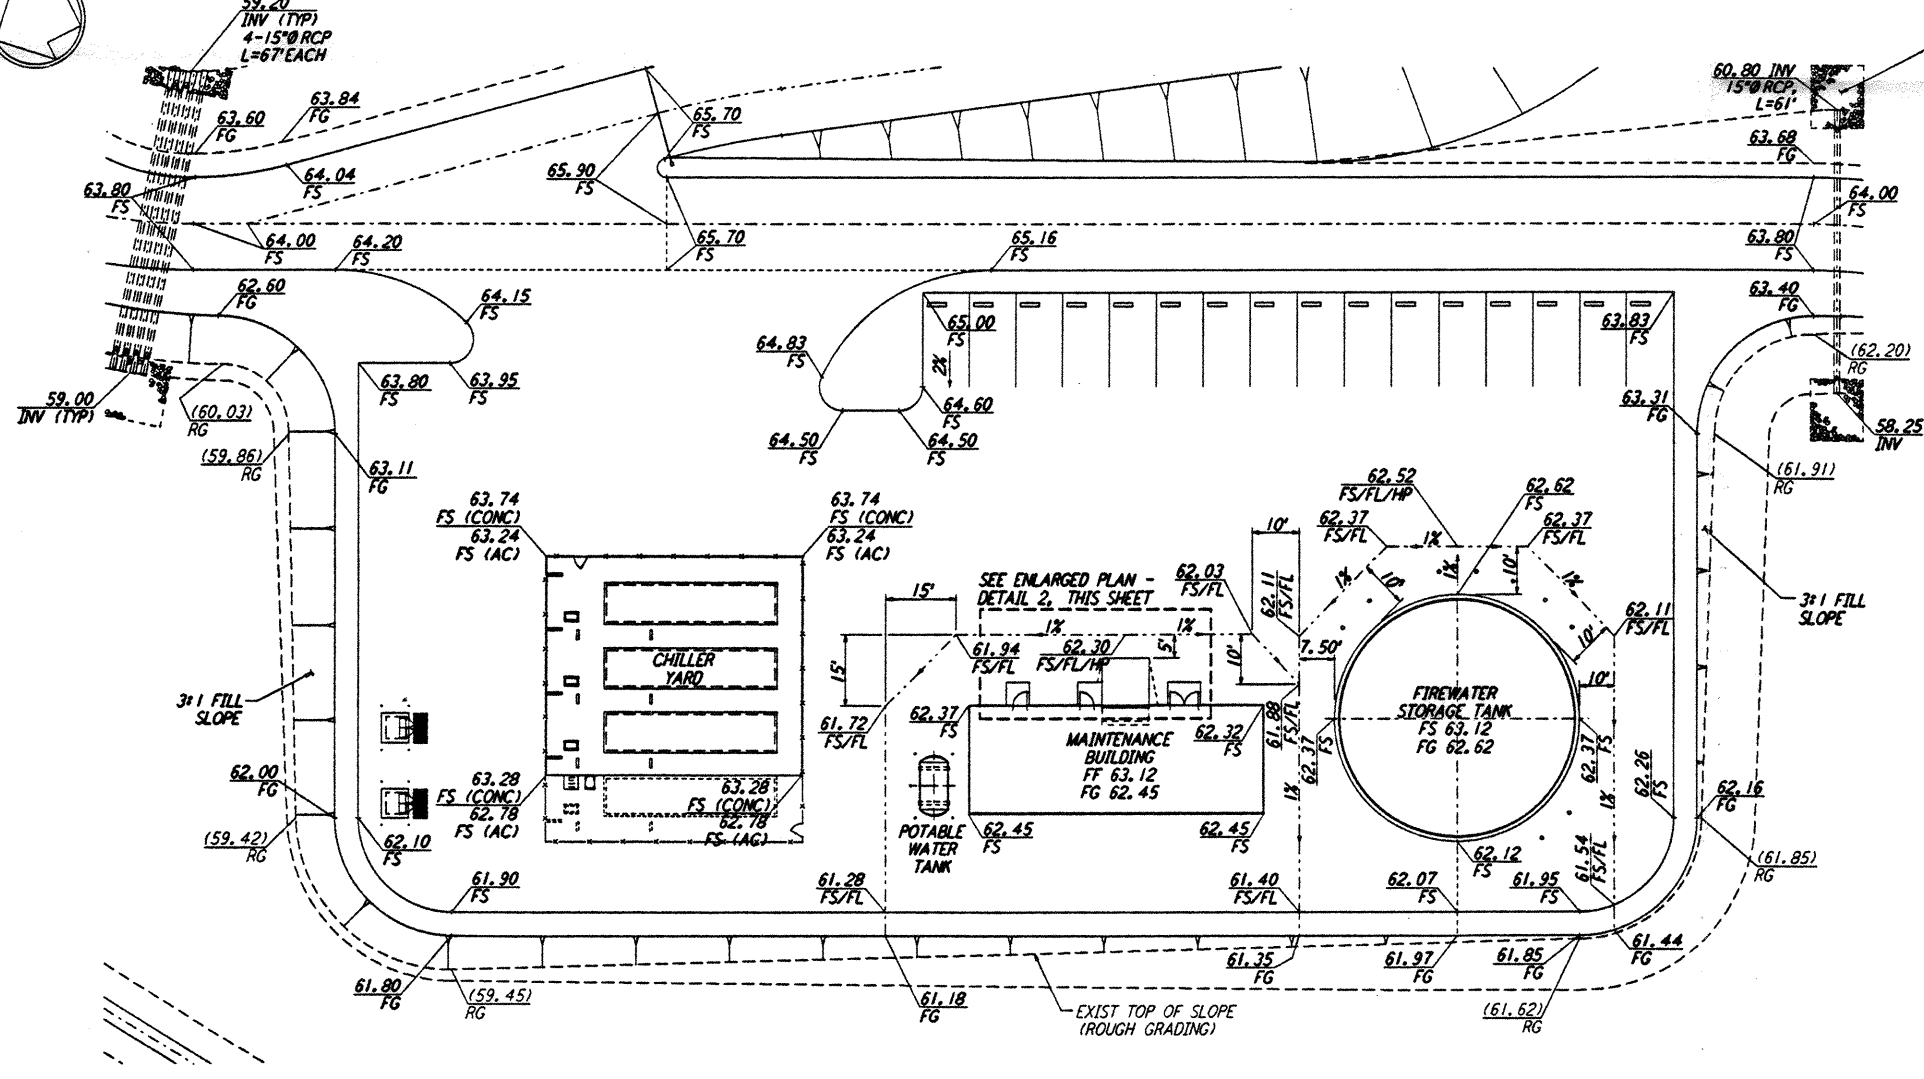


ENLARGED AREA - DETAIL 1  
SCALE: 1" = 10'

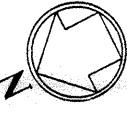

ENLARGED AREA - MAINTENANCE YARD  
SCALE: 1" = 20'

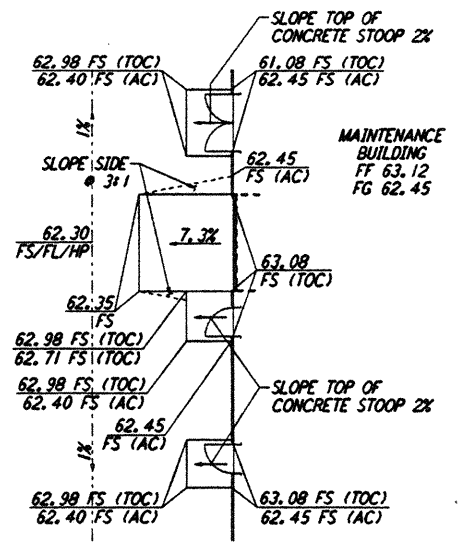

ENLARGED AREA - DETAIL 2  
SCALE: 1" = 10'

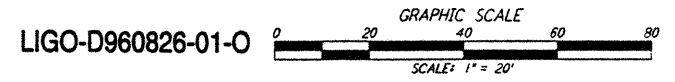

NOTES:  
1. SEE SHEET LA-C-002 FOR GENERAL NOTES, LEGEND AND ABBREVIATIONS.

not be reproduced, copied, loaned, exhibited, or used in any other way, except by written consent from PARSONS to the borrower.

This document and the design it covers are the property of PARSONS. They are loaned only with the borrower's expressed written agreement that they will

NO.	DATE	BY	CHKD	ENGR	PROJ	DESCRIPTION
1	2-28-97	WRB	CL			ADDED WALK/WALL OPENING, REVISED GRADING

ISSUED FOR CONSTRUCTION  
 DRAWN WRB 11-15-96  
 CHECKED ML 11-15-96  
 ENGINEER JB 11-15-96  
 PROJ TDM 11-15-96



**PARSONS**  
 100 WEST WALNUT STREET  
 PASADENA, CALIFORNIA

**LIGO**  
 CALIFORNIA INSTITUTE OF TECHNOLOGY  
 MASSACHUSETTS INSTITUTE OF TECHNOLOGY

LASER INTERFEROMETER GRAVITATIONAL-WAVE OBSERVATORY SITE NO. 2 - LIVINGSTON, LOUISIANA		
TITLE	SCALE	CONTRACT NUMBER
CIVIL CORNER STATION GRADING PLAN ENLARGED PLAN	AS NOTED	PP150969
SHEET NUMBER		PROJECT NUMBER
<b>LA-C-008</b>		8094