
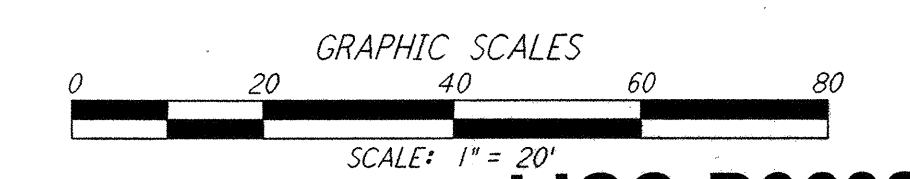
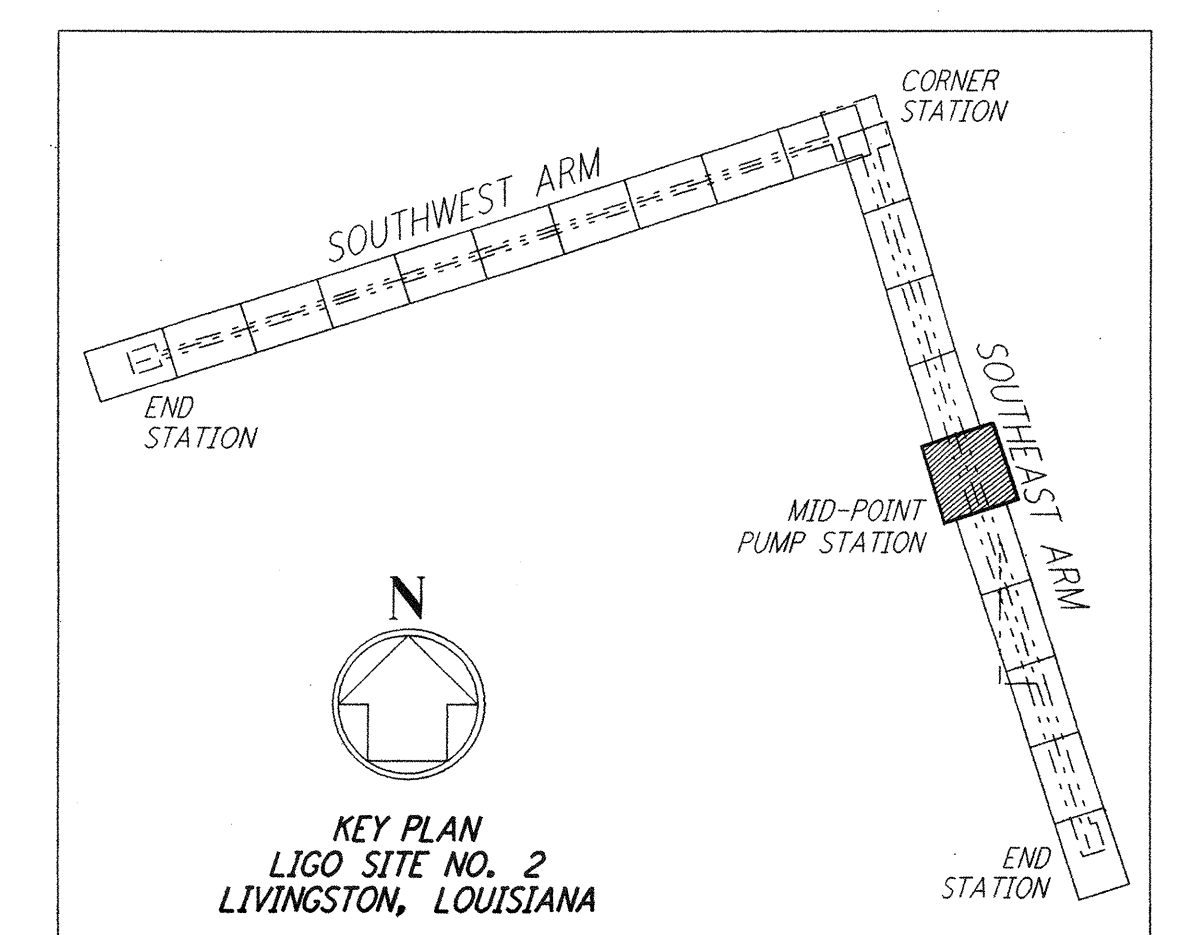


NOTES:
 1. SEE SHEET LA-C-002 FOR GENERAL NOTES, LEGEND AND ABBREVIATIONS.

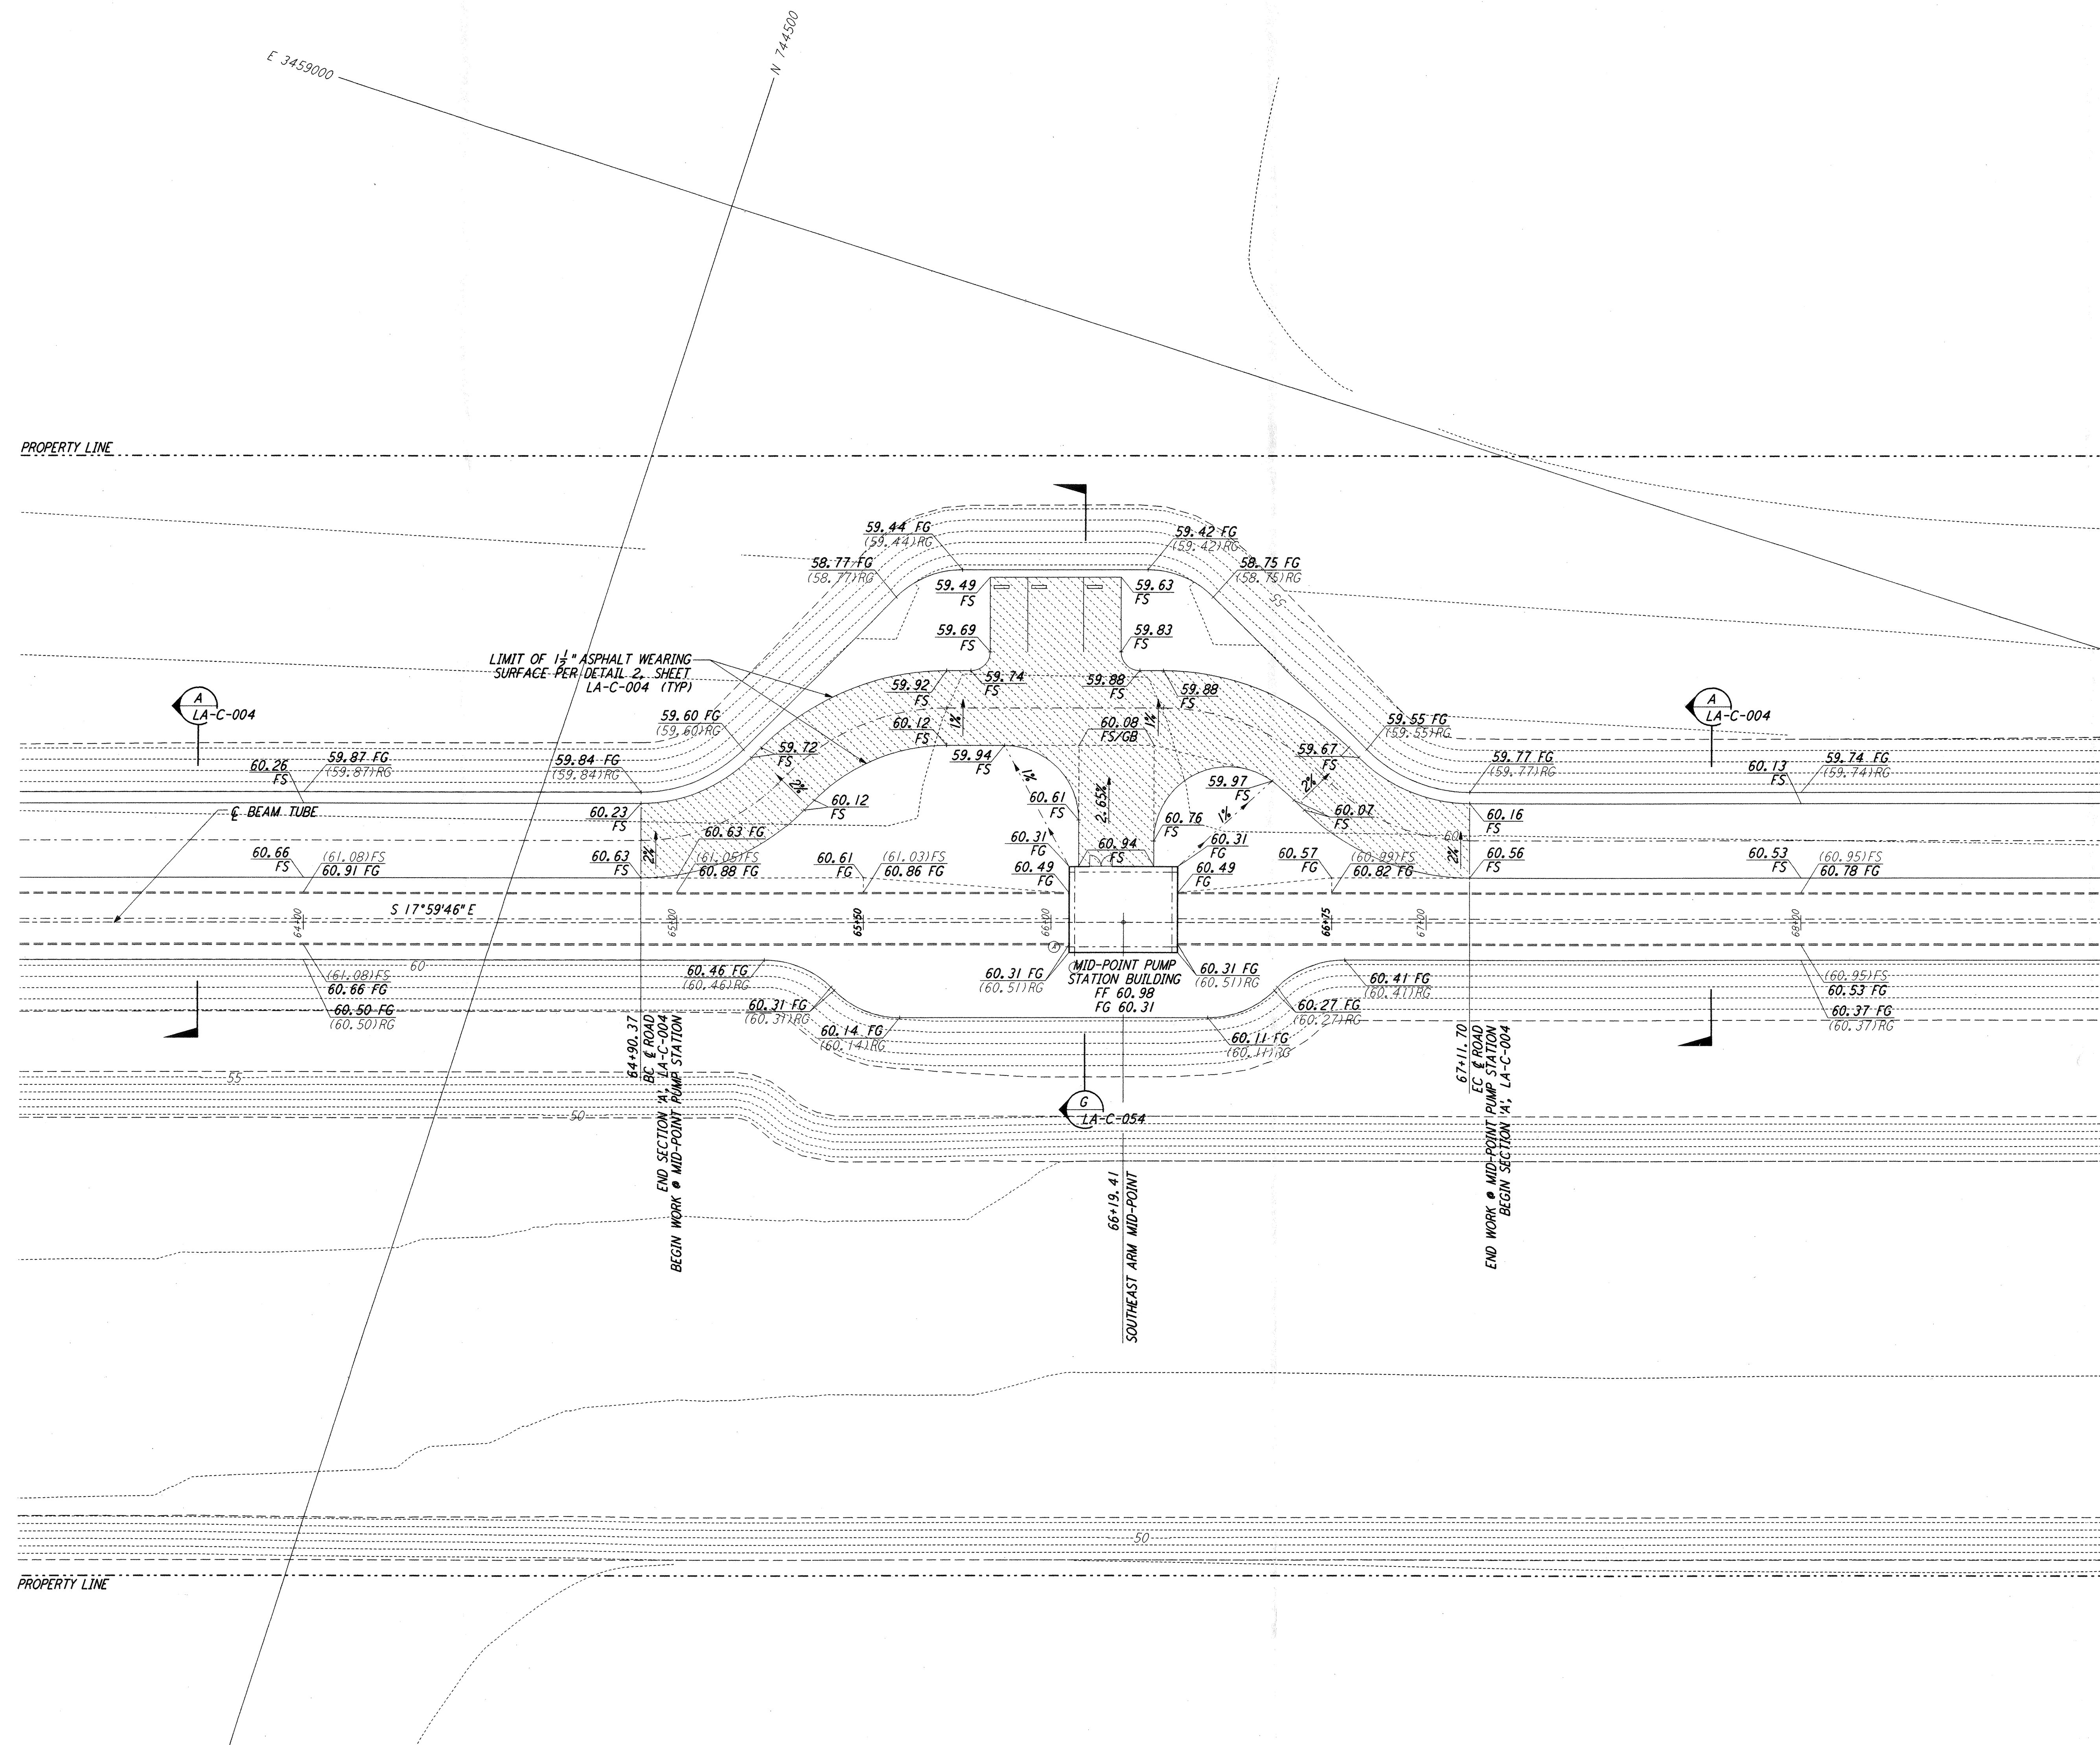

LIGO-D960856-02-0

LASER INTERFEROMETER
 GRAVITATIONAL-WAVE OBSERVATORY
 SITE NO. 2 - LIVINGSTON, LOUISIANA

TITLE	SCALE	CONTRACT NUMBER	PROJECT NUMBER
CIVIL SOUTHEAST ARM PUMP STATION GRADING PLAN	1" = 20'	PPI50969	8094
SHEET NUMBER		REVISIONS	
LA-C-042		2	

ISSUED FOR CONSTRUCTION	DRAWN	WRB	11-15-96
	CHECKED	ML	11-15-96
	ENGINEER	JB	11-15-96
	PROJ	TDM	11-15-96

**AS-BUILT
 DRAWINGS**

PARSONS
 100 WEST WALNUT STREET
 PASADENA, CALIFORNIA

LIGO
 CALIFORNIA INSTITUTE OF TECHNOLOGY
 MASSACHUSETTS INSTITUTE OF TECHNOLOGY

REFERENCES	NO.	DATE	BY	CHKD	ENGR	PROJ	DESCRIPTION
	2	08-07-98	WRB	CB	WV		ISSUED FOR AS-BUILT
	1	2-3-97	WRB	ML	JB	TDM	REVISED MID STATION, FIN FLR ELEV, FIN GRADES

This document and the design it covers are the property of PARSONS. They are loaned only with the borrower's expressed written agreement that they will not be reproduced, copied, loaned, exhibited, or used in any other way, except by written consent from PARSONS to the borrower.