




WALL SECTION
 $\frac{1}{4}'' = 1'-0''$ REF: (G) LA-A-163 LA-A-153

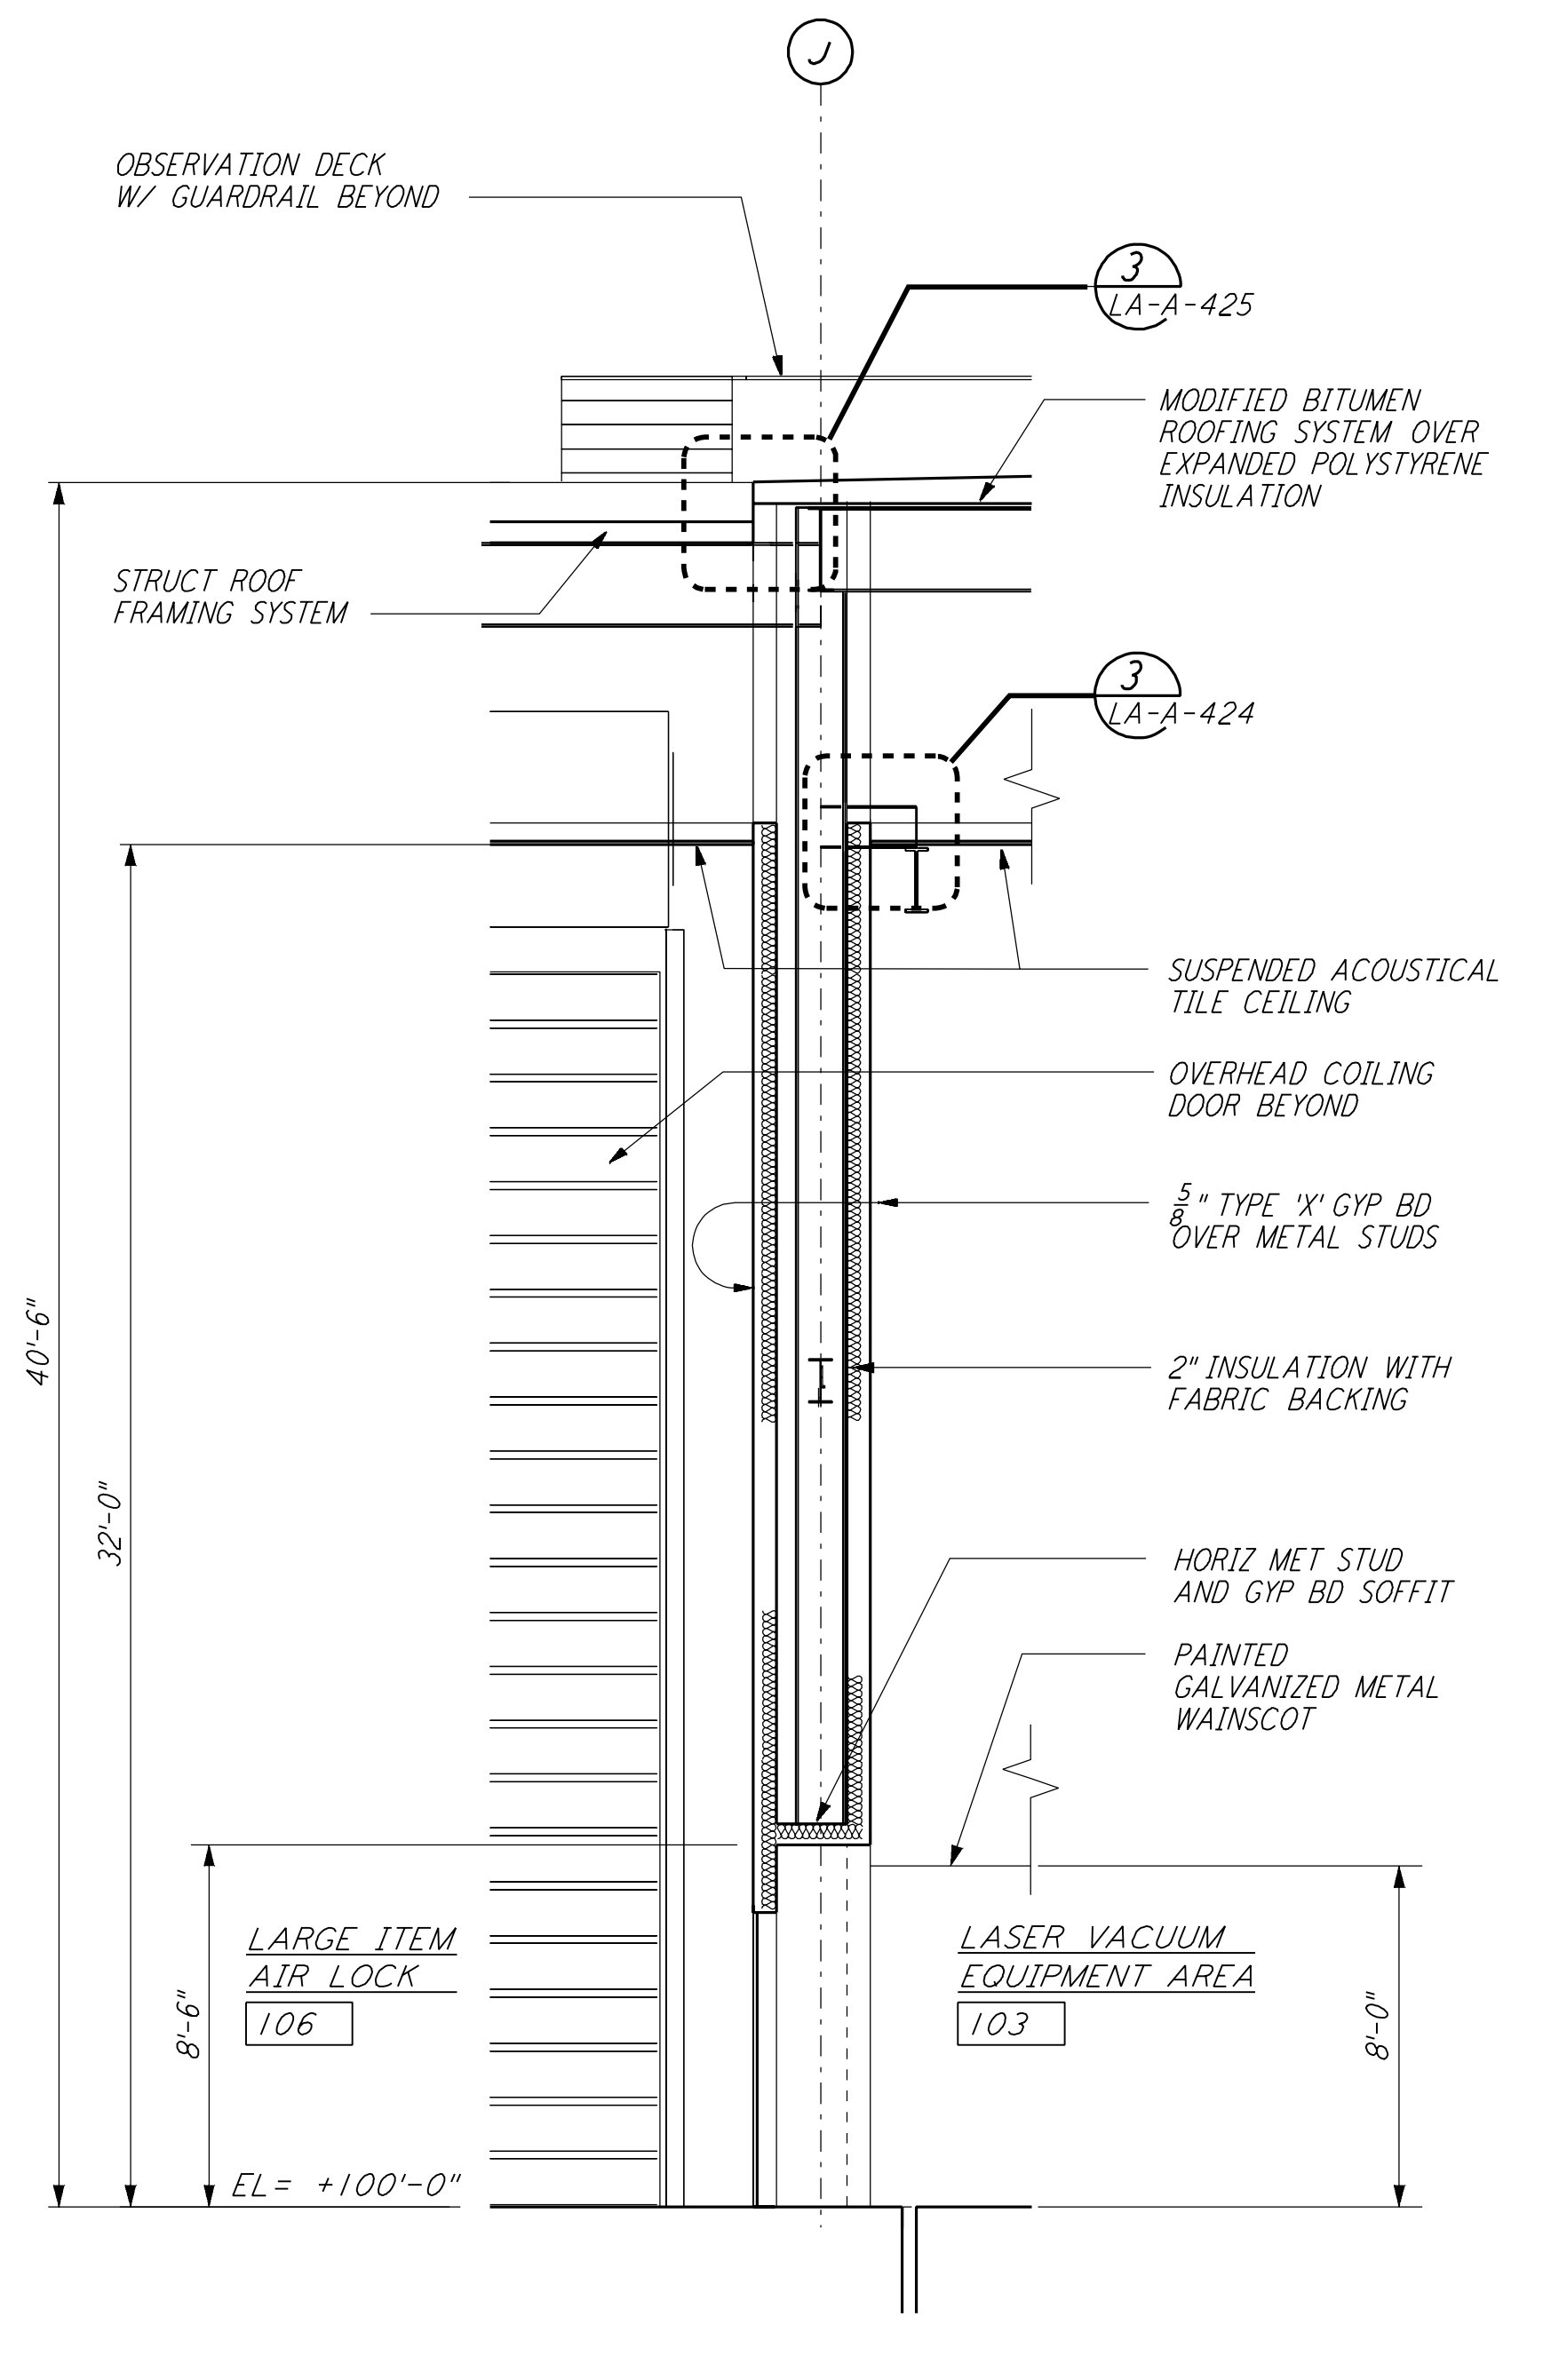


WALL SECTION
 $\frac{1}{4}'' = 1'-0''$ REF: (E) LA-A-163 LA-A-153

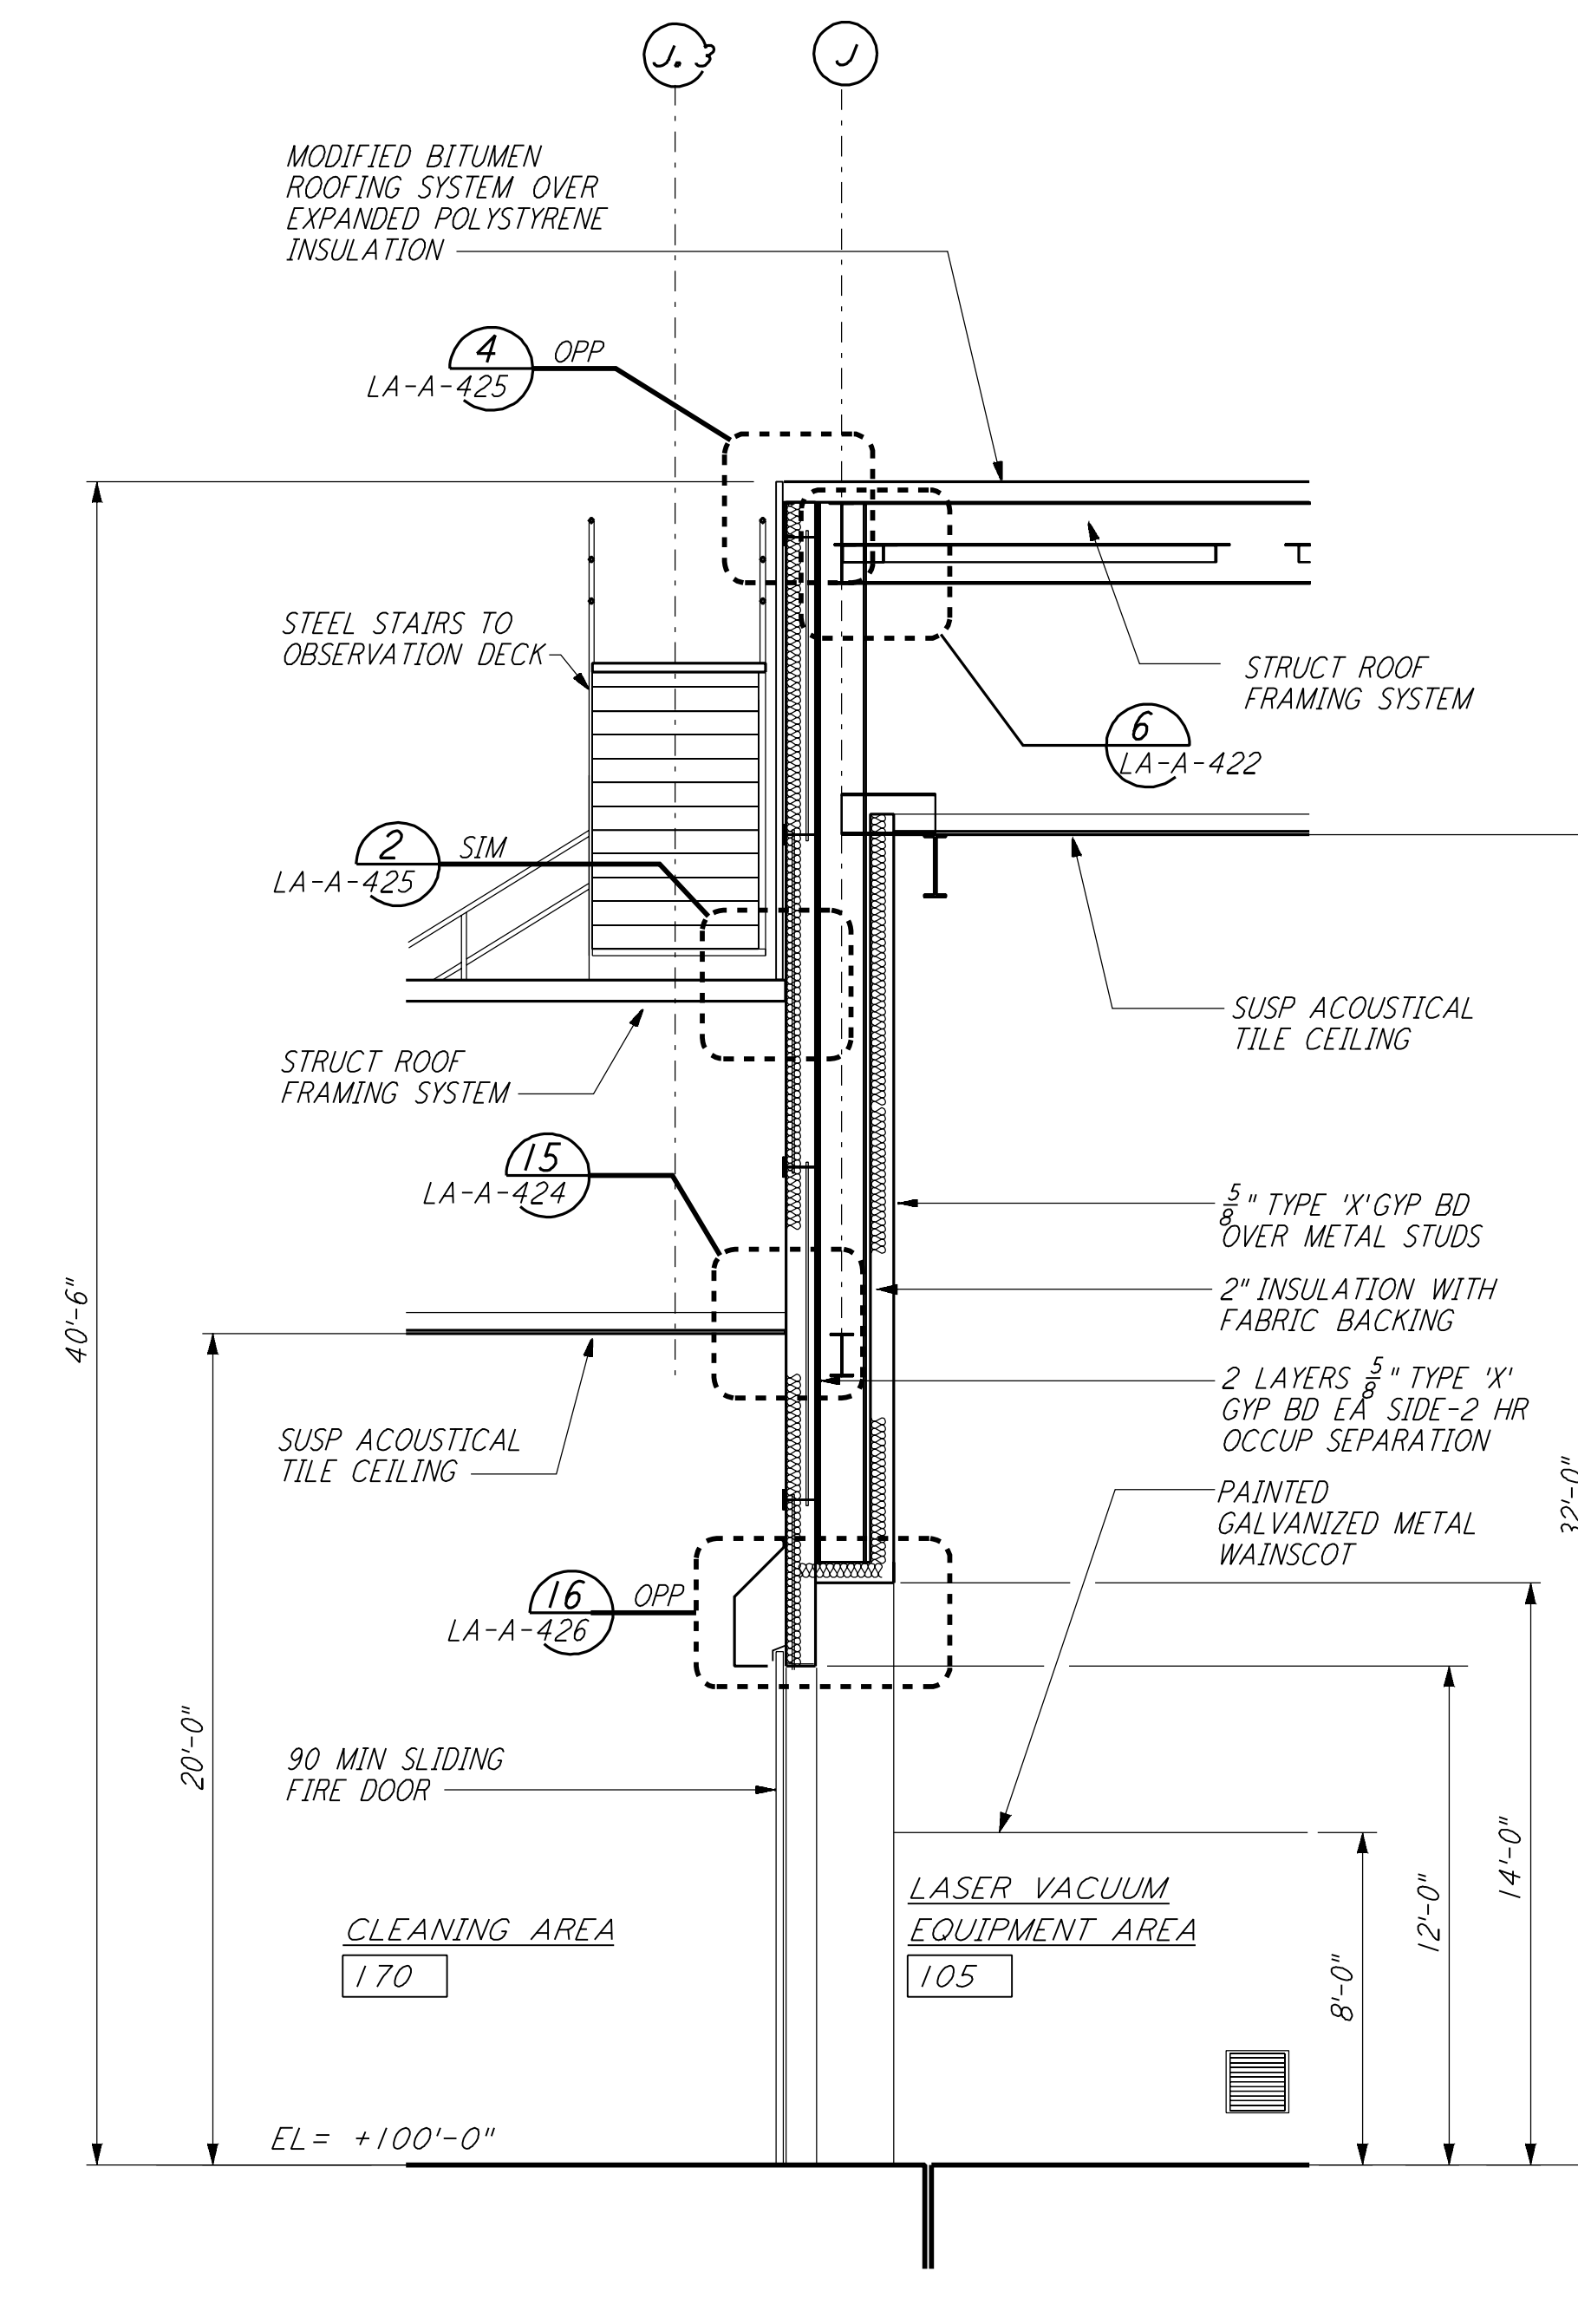


WALL SECTION
 $\frac{1}{4}'' = 1'-0''$ REF: (C) LA-A-163 LA-A-153

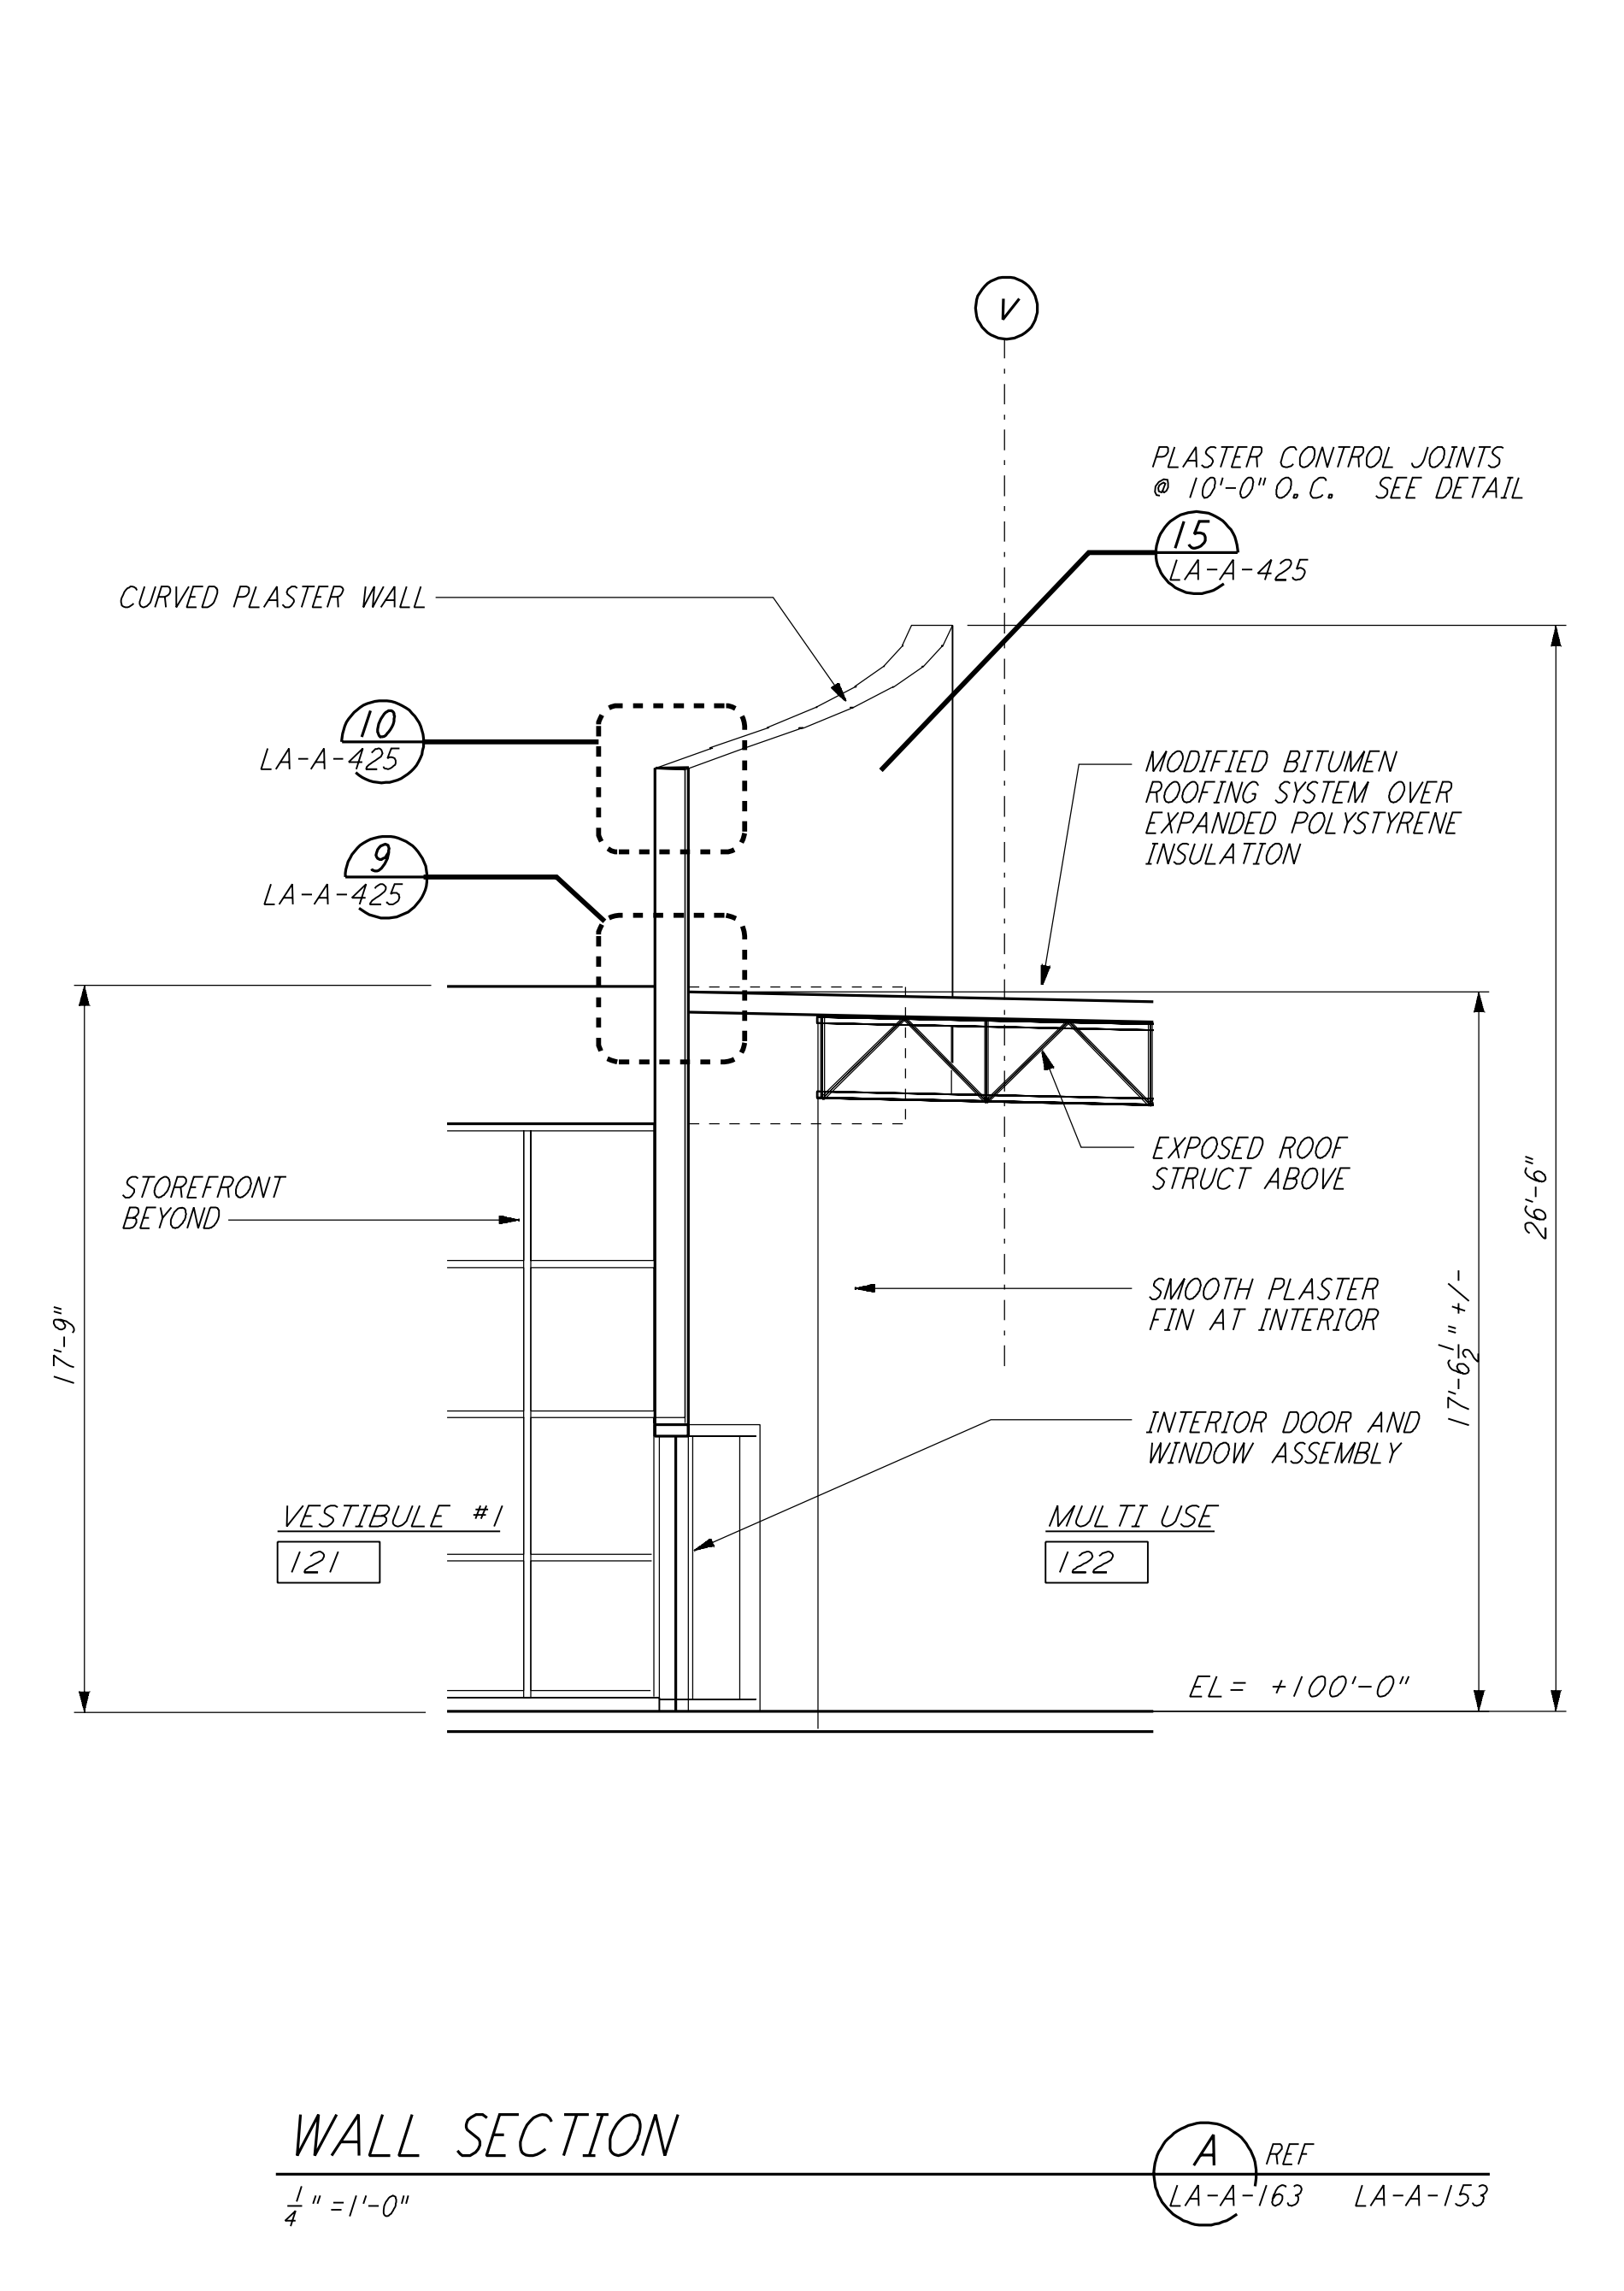


WALL SECTION
 $\frac{1}{4}'' = 1'-0''$ REF: (A) LA-A-163 LA-A-153

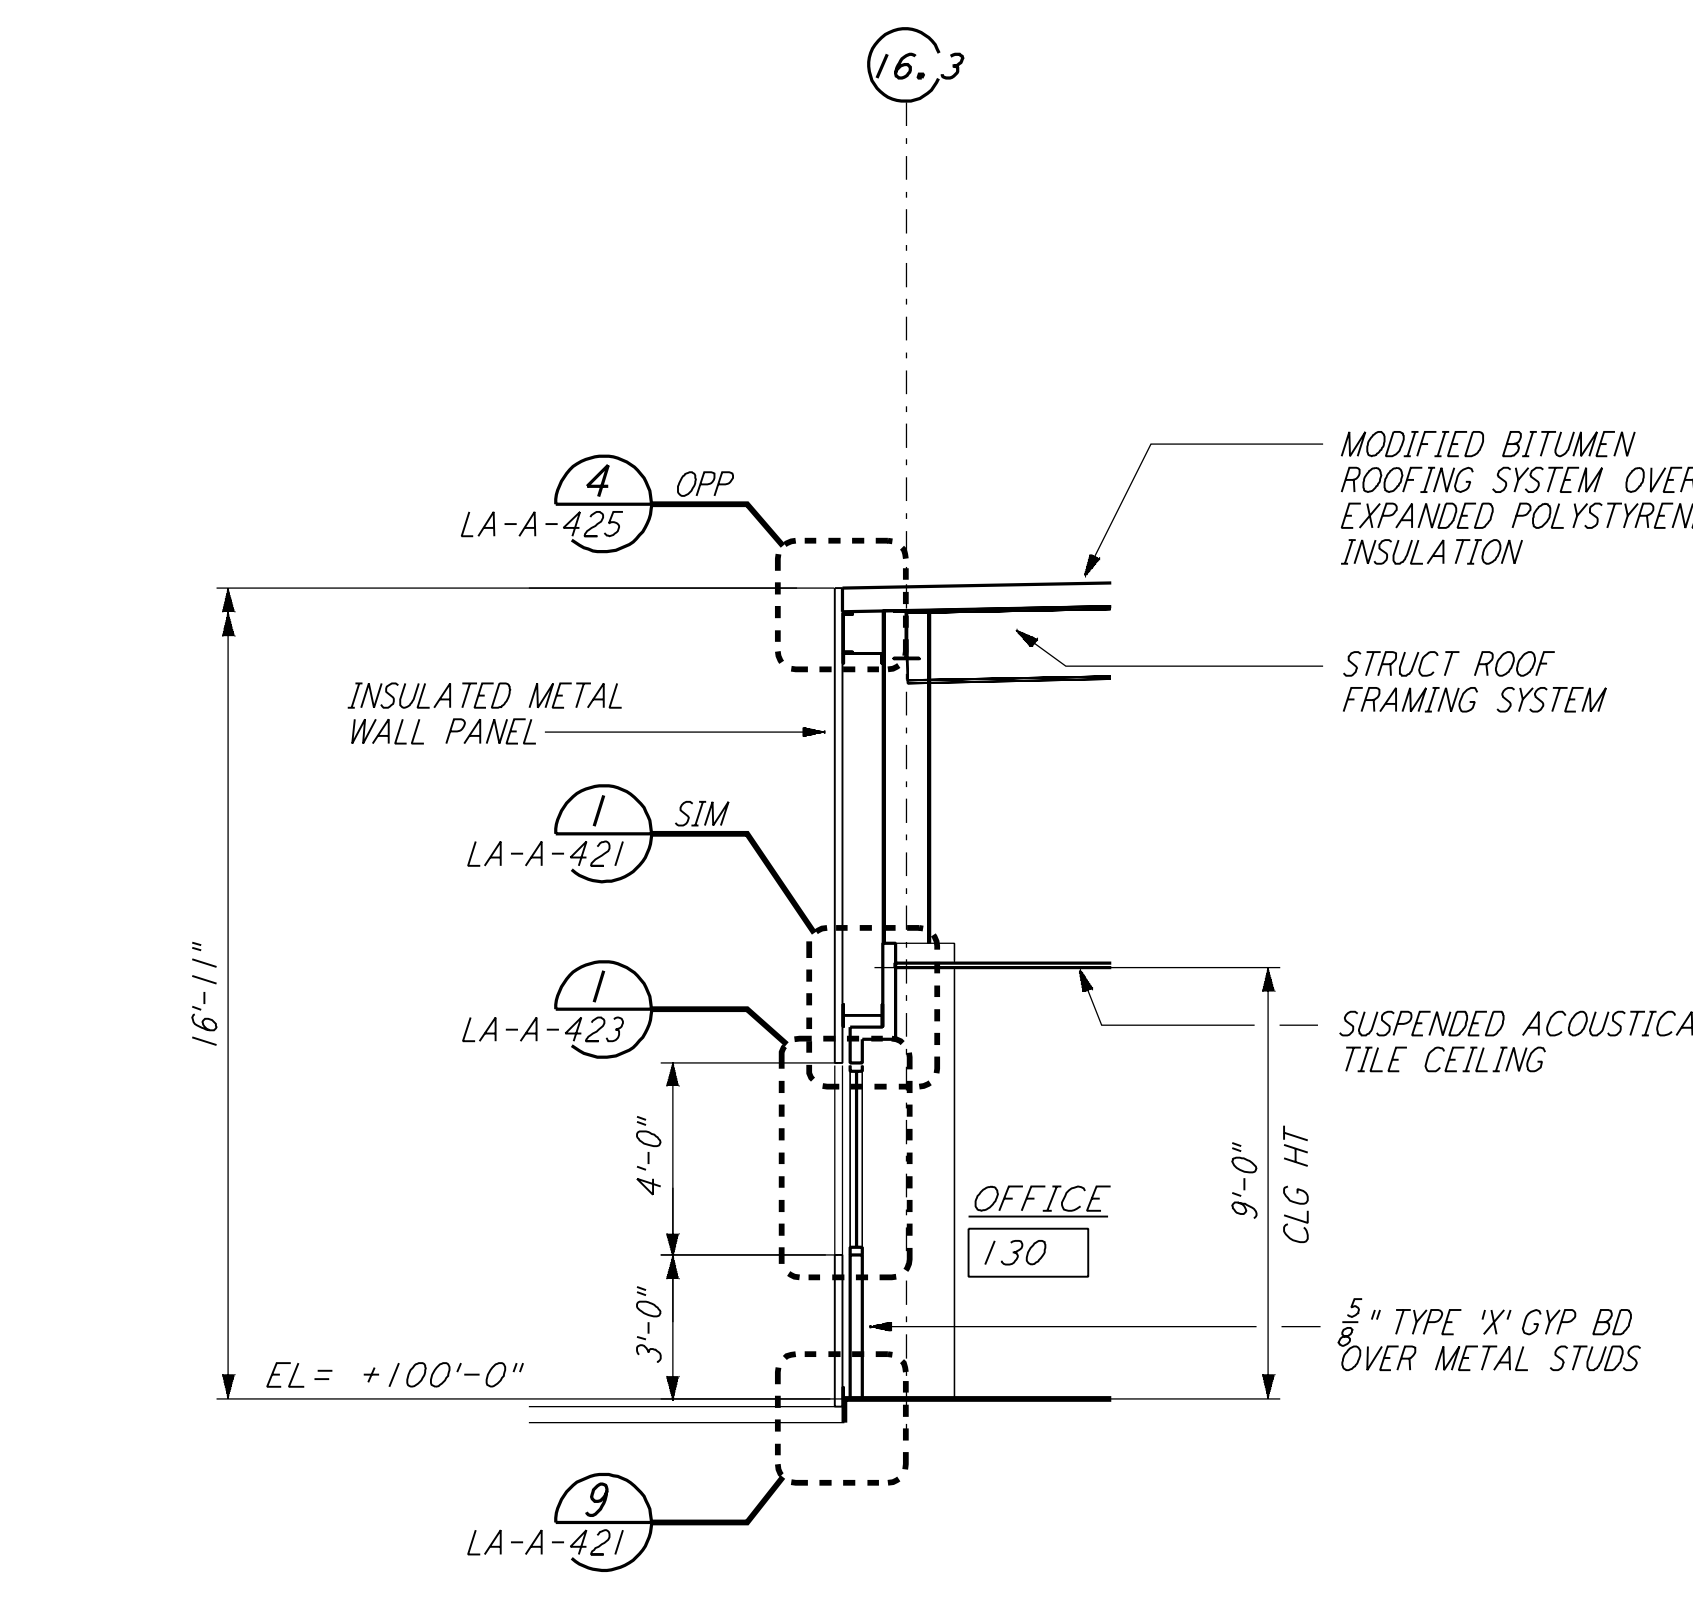


WALL SECTION
 $\frac{1}{4}'' = 1'-0''$ REF: (H) LA-A-163 LA-A-153

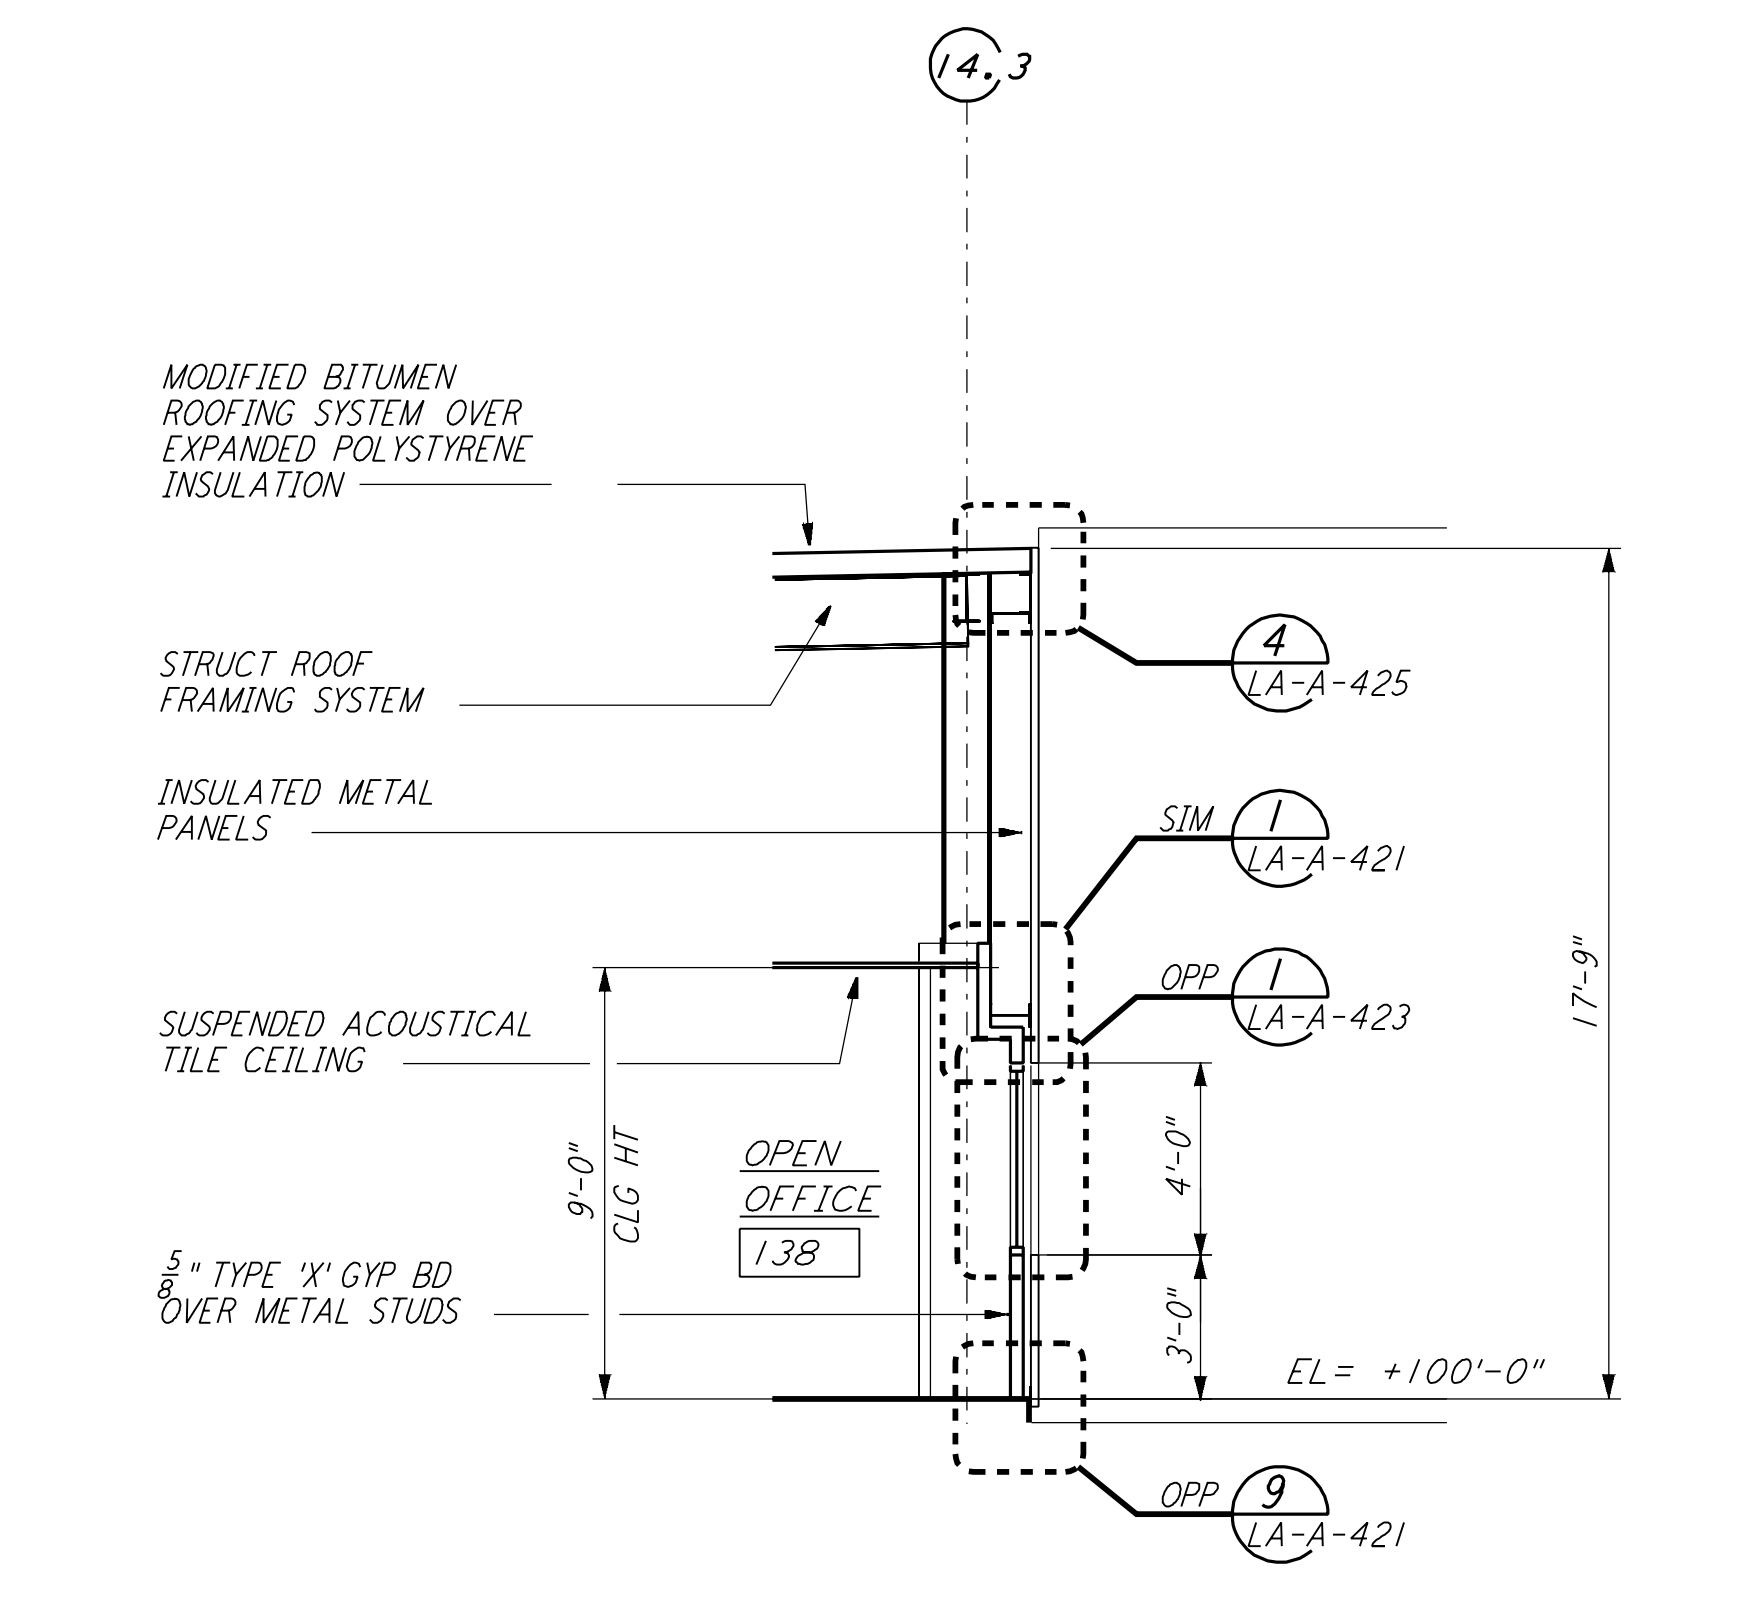


WALL SECTION
 $\frac{1}{4}'' = 1'-0''$ REF: (F) LA-A-163 LA-A-153

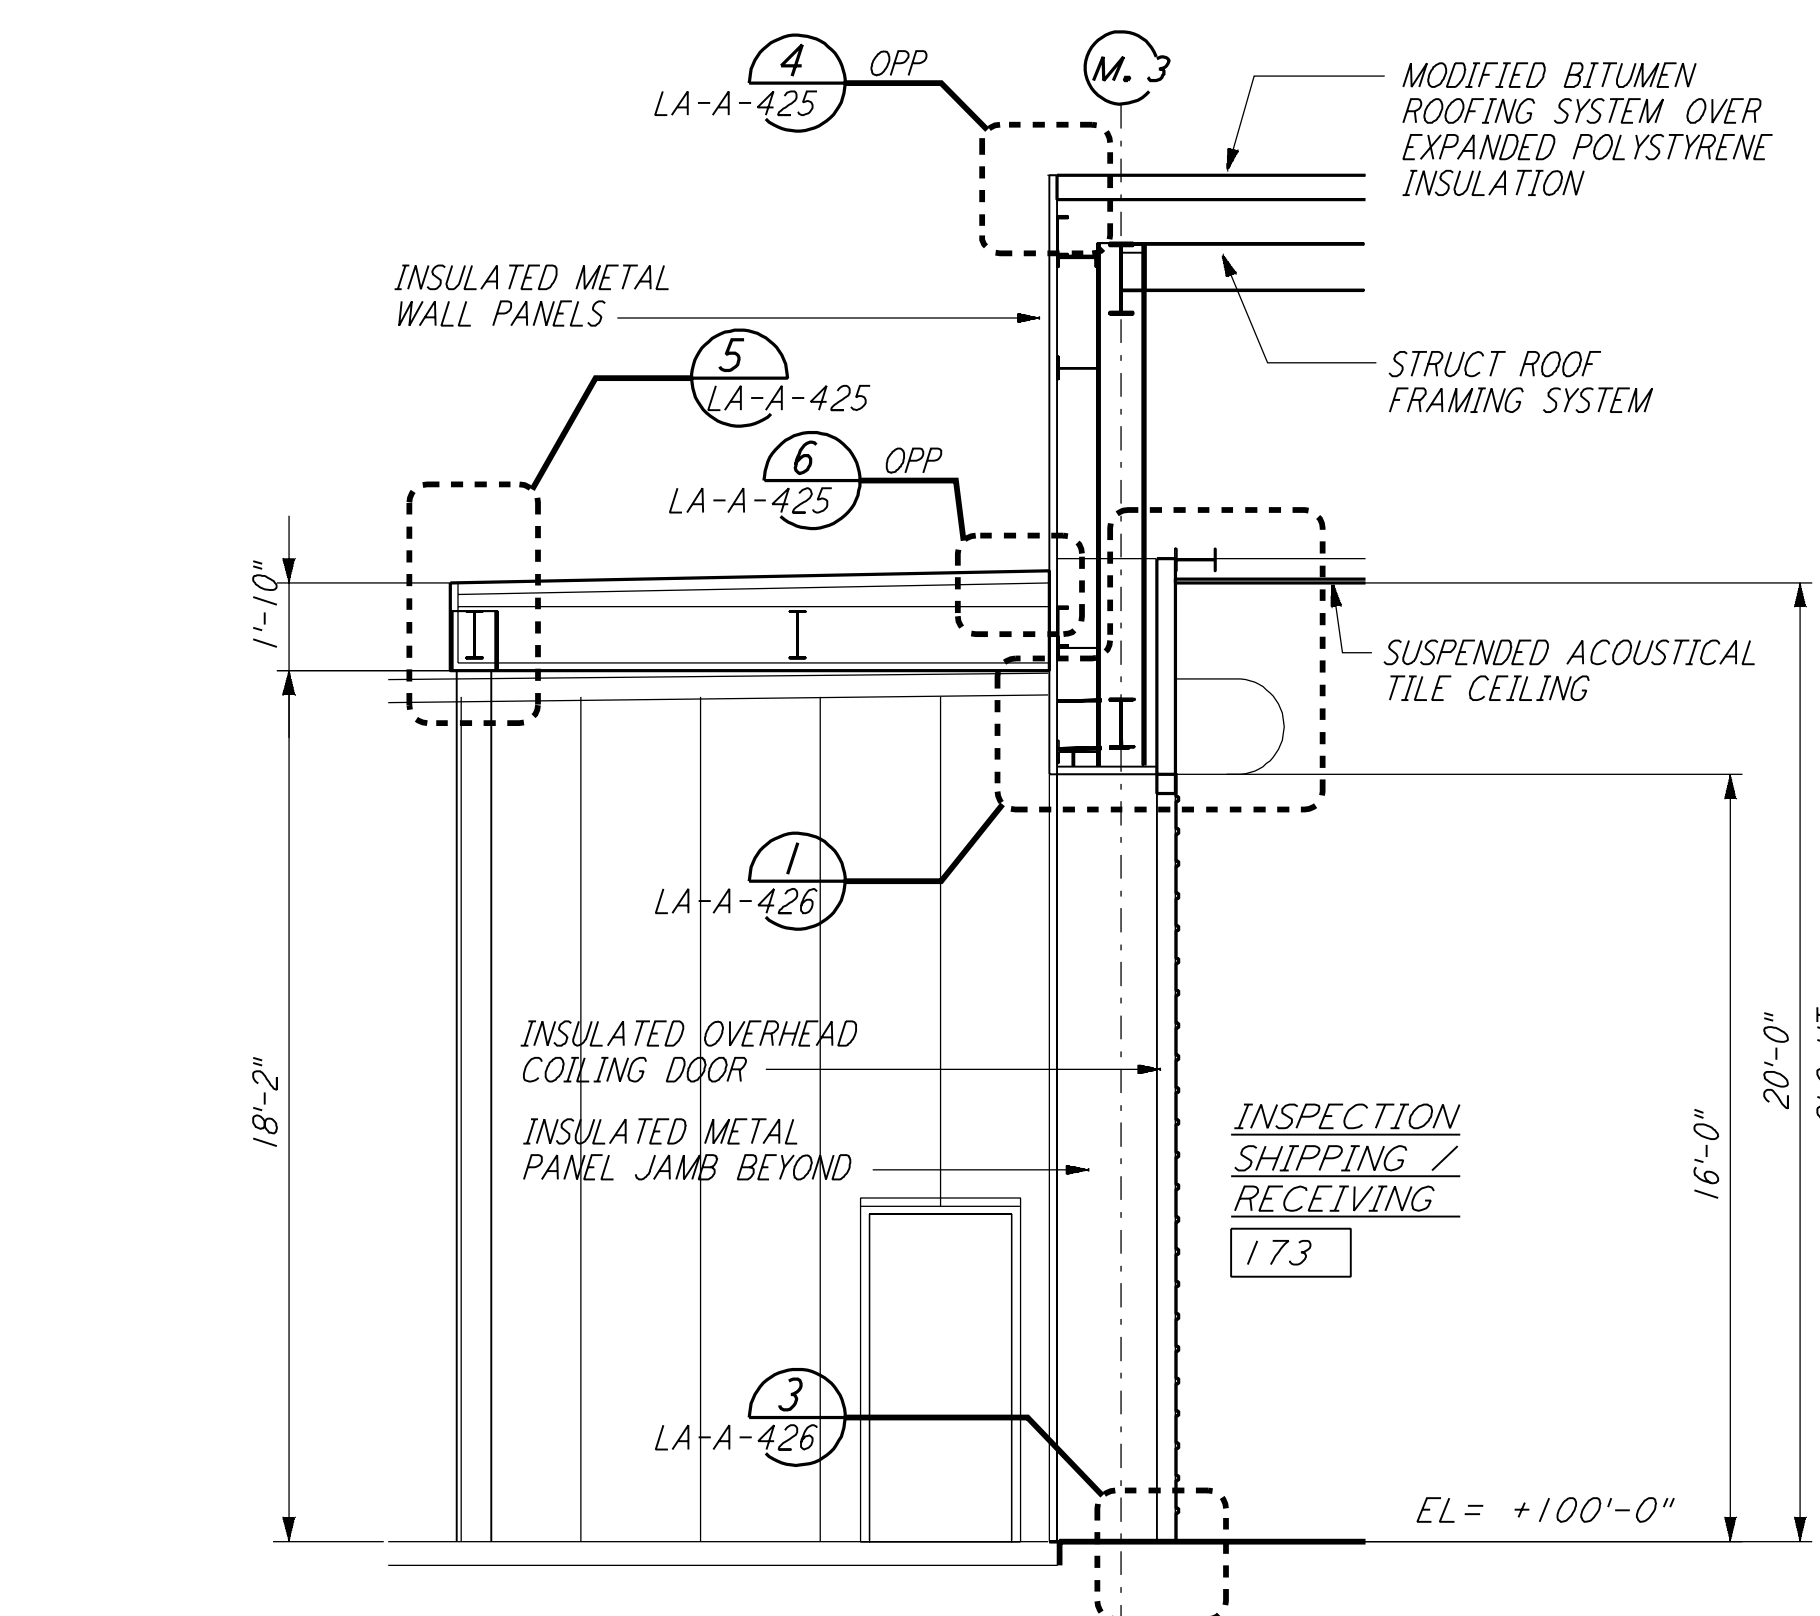

WALL SECTION
 $\frac{1}{4}'' = 1'-0''$ REF: (D) LA-A-163 LA-A-153

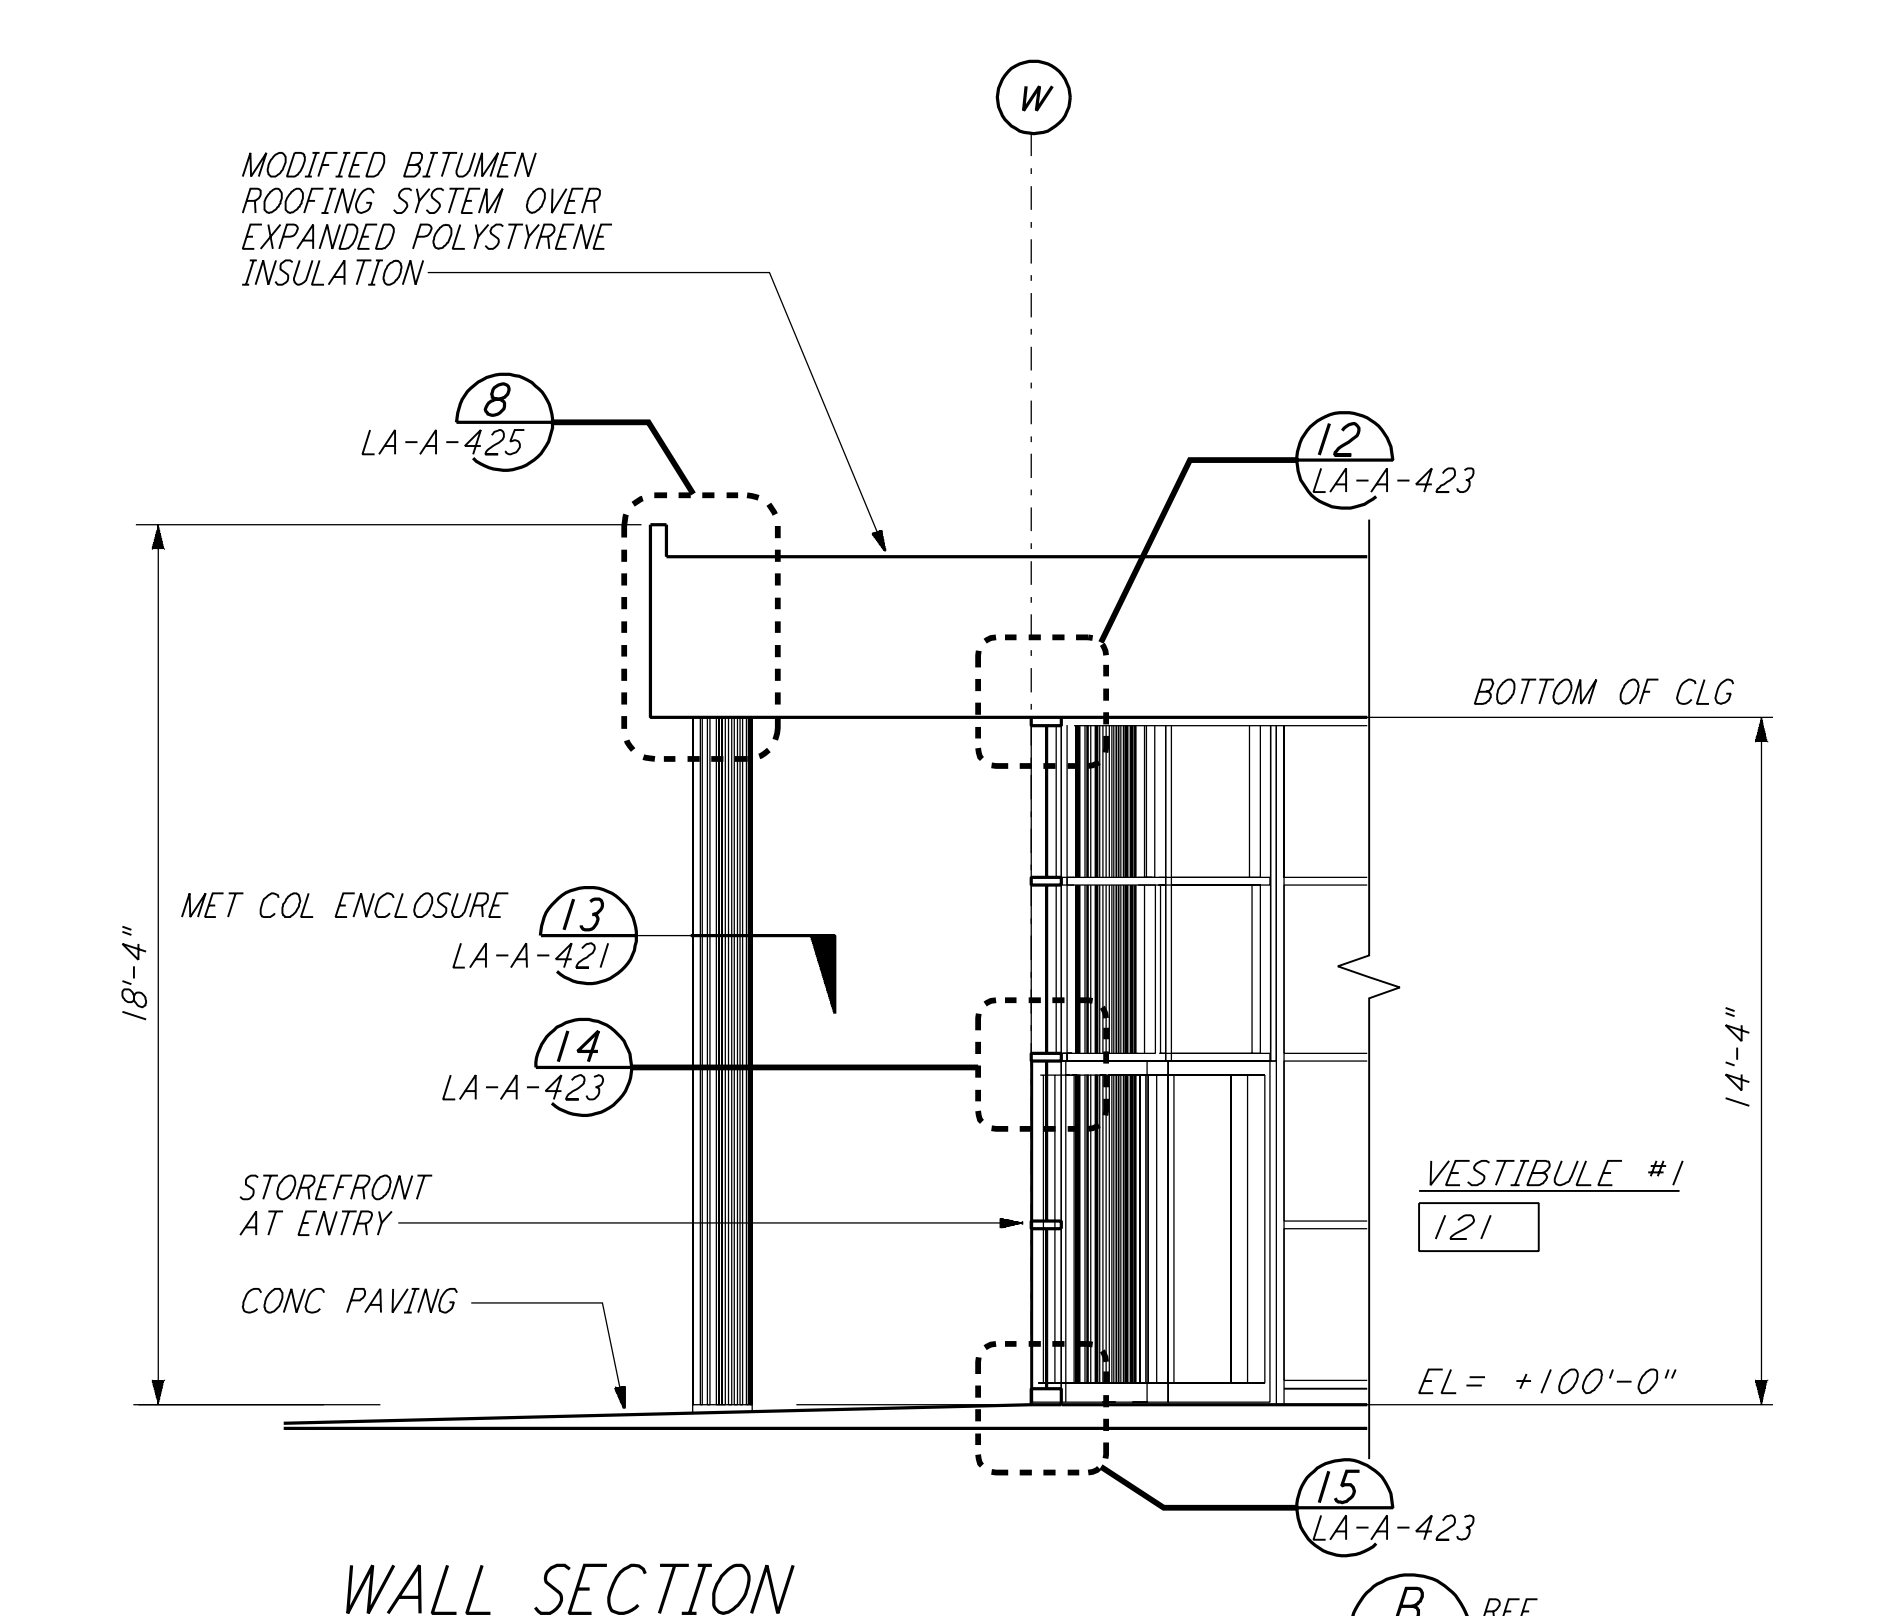

WALL SECTION
 $\frac{1}{4}'' = 1'-0''$ REF: (B) LA-A-163 LA-A-153

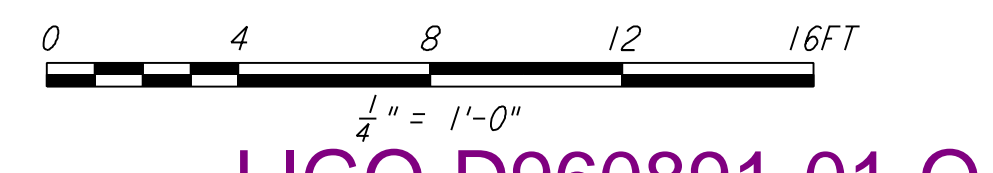

This document and the design it covers are the property of PARSONS. They are loaned only with the borrower's expressed written agreement that they will not be reproduced, copied, loaned, exhibited, or used in any other way, except by written consent from PARSONS to the borrower.

This document and the design it covers are the property of PARSONS. They are loaned only with the borrower's expressed written agreement that they will not be reproduced, copied, loaned, exhibited, or used in any other way, except by written consent from PARSONS to the borrower.

| NO. | DATE | BY | CHKD | ENGR | PROJ | DESCRIPTION |
|-----|----------|-----|------|------|------|---------------------|
| 1 | 08-07-98 | SJM | | | | ISSUED FOR AS-BUILT |

| ISSUED FOR CONSTRUCTION | DRAWN | CHECKED | ENGINEER | PROJ |
|-------------------------|-------|---------|----------|------|
| AS-BUILT DRAWINGS | CKT | TB | SF | TDM |

AS-BUILT DRAWINGS

ISSUED FOR CONSTRUCTION
 DRAWN: CKT 11-15-96
 CHECKED: TB 11-15-96
 ENGINEER: SF 11-15-96
 PROJ: TDM 11-15-96



LASER INTERFEROMETER GRAVITATIONAL-WAVE OBSERVATORY SITE NO. 2 - LIVINGSTON, LOUISIANA

ARCHITECTURAL CORNER STATION WALL SECTIONS SHEET 3

SCALE: PP150969 8094
 SHEET NUMBER: LA-A-163