



FOUNDATION PLAN
 $\frac{1}{8}'' = 1'-0''$


FOR FLOOR SLOPE AND FLOOR DRAIN
 SEE ARCHITECTURAL DRAWINGS
 DATUM POINT EL 100'-0" = EL 61.44'

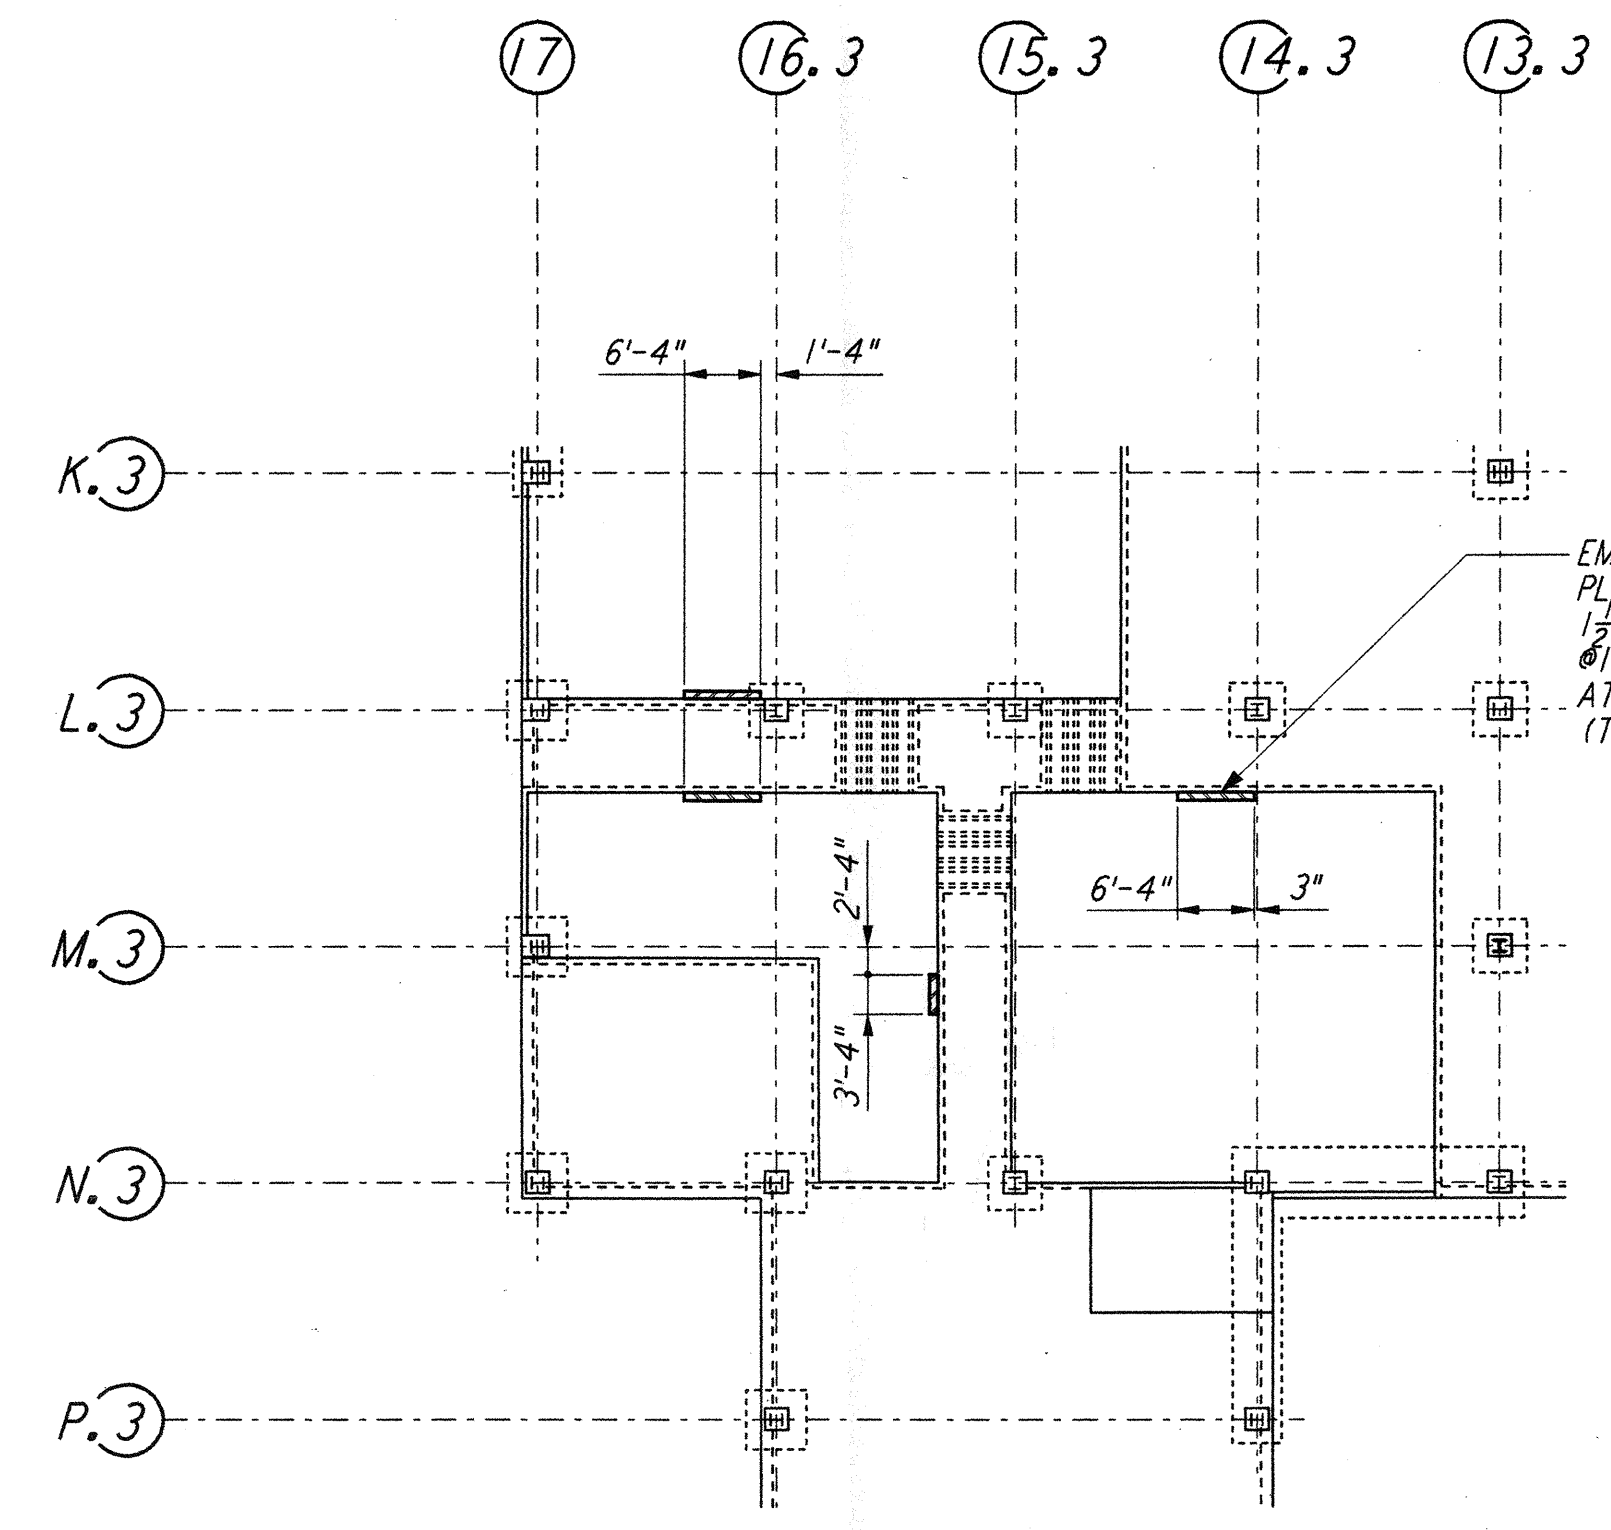

EMBED LOCATION LAYOUT
 $\frac{1}{8}'' = 1'-0''$

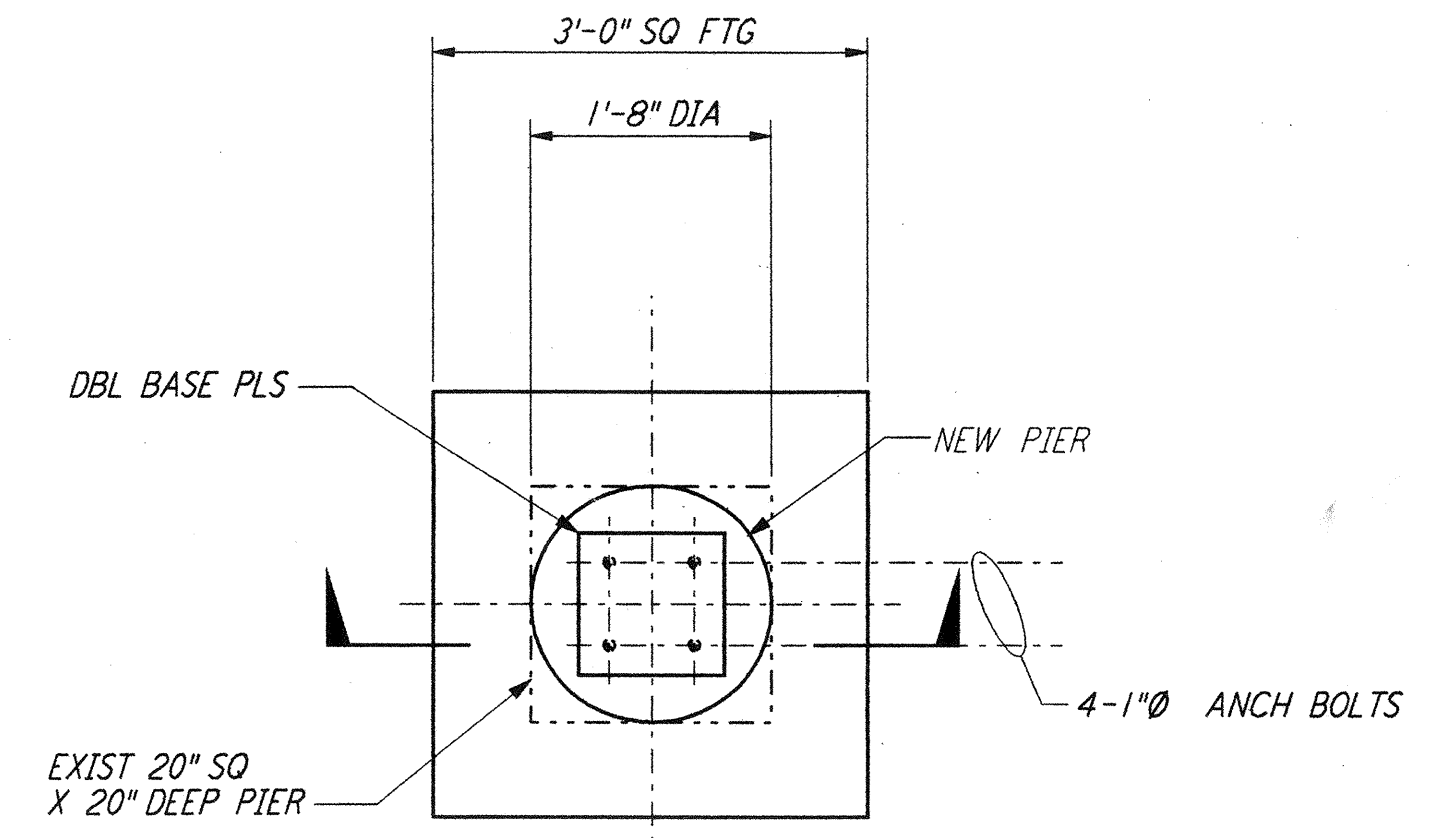

PLAN

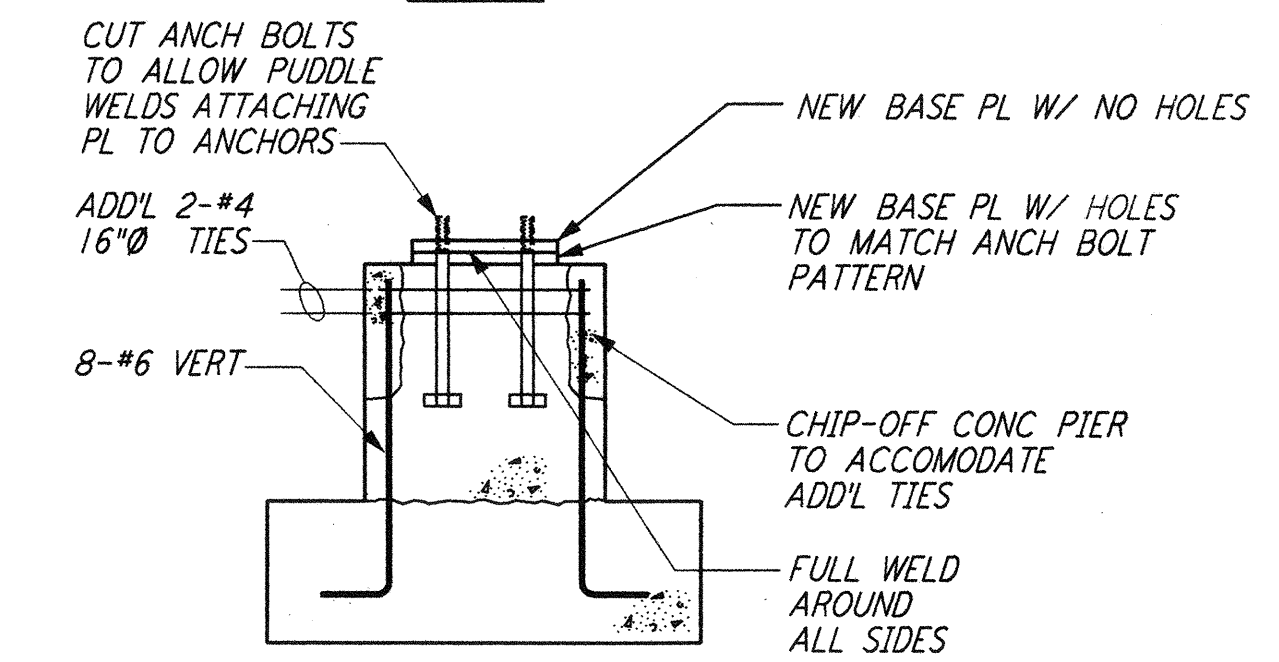


SECTION


**MODIFICATION OF FDN
 TO COLS W-18.4 & W.4-18**
 $\frac{3}{4}'' = 1'-0''$

NOTES:

1. FOR GENERAL NOTES, ABBREVIATIONS AND SYMBOLS, SEE DRAWING LA-S-001.
2. FOR SLAB ON GRADE DETAILS SEE DRAWING LA-S-002.
3. FOR BASE ANGLE AT EDGE OF SLAB OR TOP OF 6" CONCRETE WALL, SEE FRAMING ELEVATIONS AND SECTION LA-S-003.
4. FOR FOUNDATION SCHEDULE AND DETAILS SEE DRAWINGS LA-S-402 AND LA-S-403.
5. ALL VERTICAL SURFACES OF FOUNDATION SHALL BE FORMED.

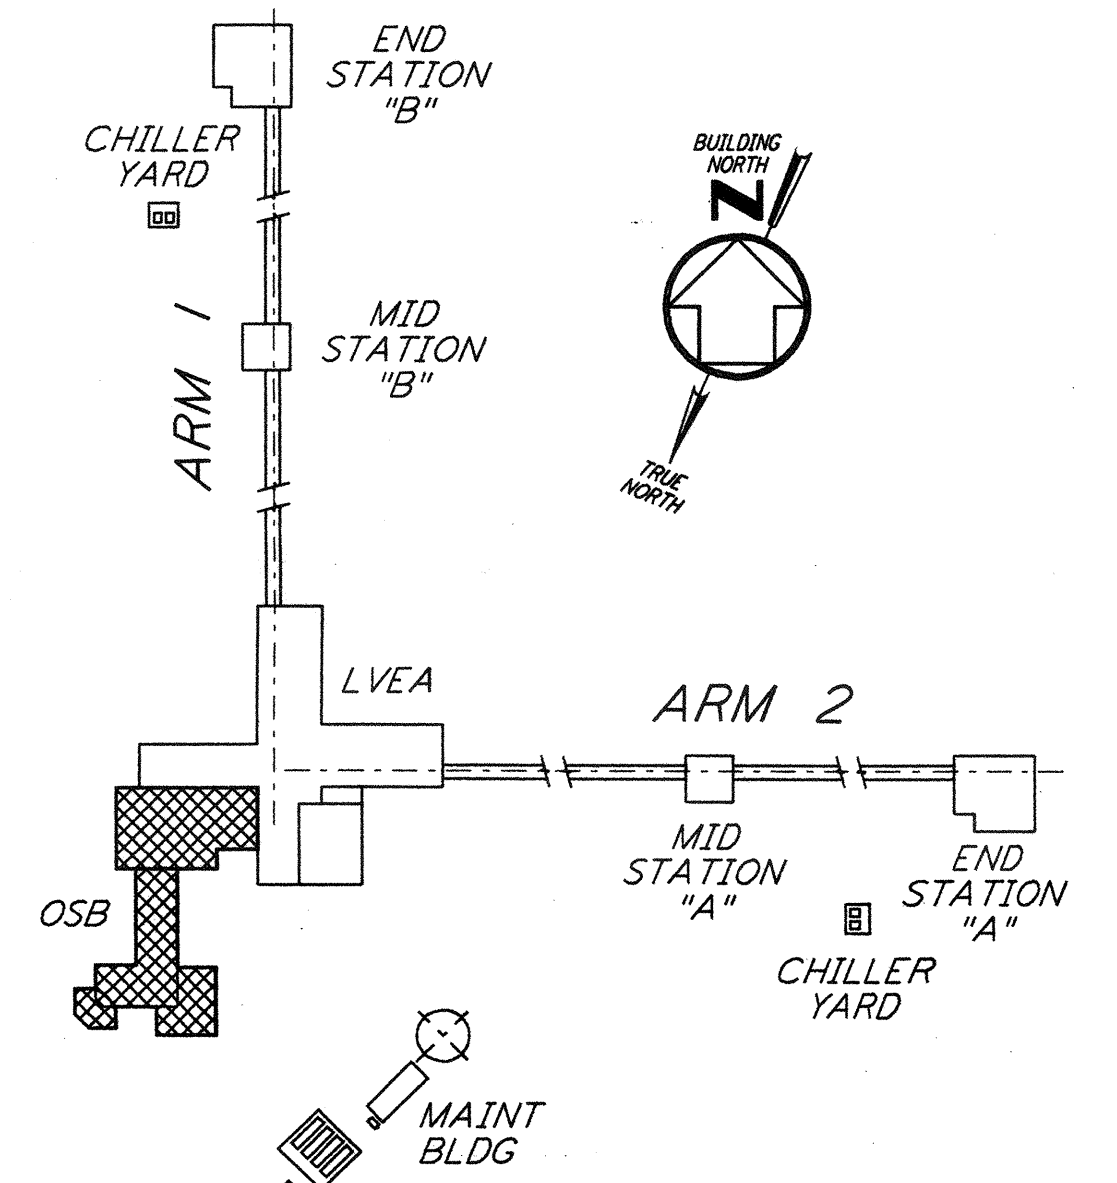

KEY PLAN

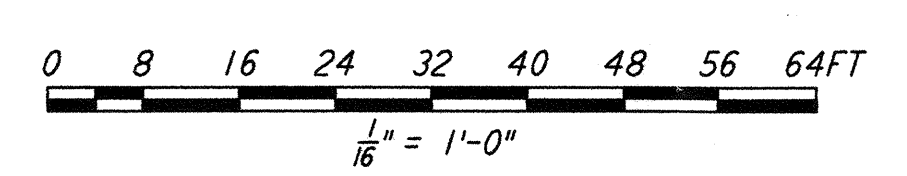

This document and the design it covers are the property of PARSONS. They are loaned only with the borrower's expressed written agreement that they will not be reproduced, copied, loaned, exhibited, or used in any other way, except by written consent from PARSONS to the borrower.

NO.	DATE	BY	CHKD	ENGR	PROJ	DESCRIPTION
1	08-07-98	WA	AM	GM	VVV	ISSUED FOR AS-BUILT

ISSUED FOR CONSTRUCTION	MCS	11-15-96
DRAWN	DDM	11-15-96
CHECKED	BP	11-15-96
ENGINEER	TDM	11-15-96
PROJ		

**AS-BUILT
 DRAWINGS**



100 WEST WALNUT STREET
 PASADENA, CALIFORNIA



CALIFORNIA INSTITUTE OF TECHNOLOGY
 MASSACHUSETTS INSTITUTE OF TECHNOLOGY

LIGO-D960918-01-O
 LASER INTERFEROMETER
 GRAVITATIONAL-WAVE OBSERVATORY
 SITE NO. 2 - LIVINGSTON, LOUISIANA

TITLE	SCALE	CONTRACT NUMBER	PROJECT NUMBER
STRUCTURAL CORNER STATION OSB FOUNDATION PLAN	AS NOTED	PPI 50969	8094
SHEET NUMBER	REVISIONS		
LA-S-102			