



FOUNDATION PLAN
 $\frac{1}{8}'' = 1'-0''$


FOR FLOOR SLOPE AND FLOOR DRAIN
 SEE ARCHITECTURAL DRAWINGS
 DATUM POINT EL 100'-0" = EL 61.44'

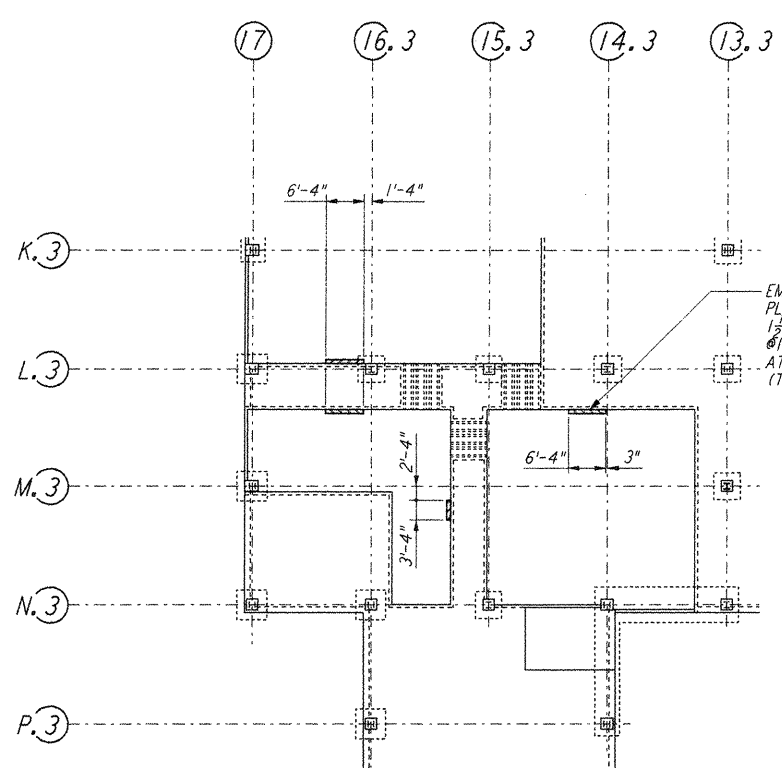

EMBED LOCATION LAYOUT
 $\frac{1}{8}'' = 1'-0''$

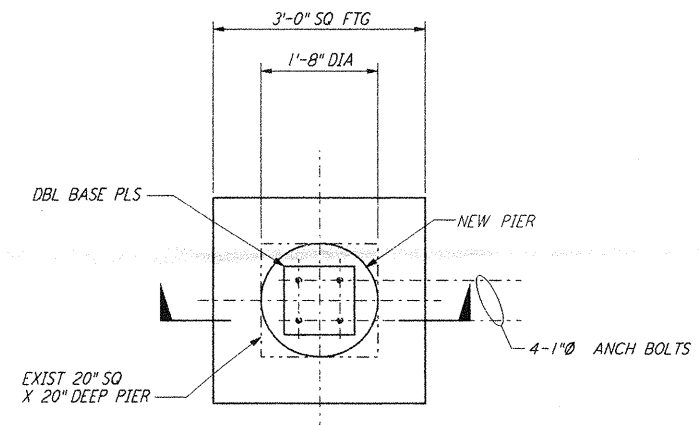


PLAN

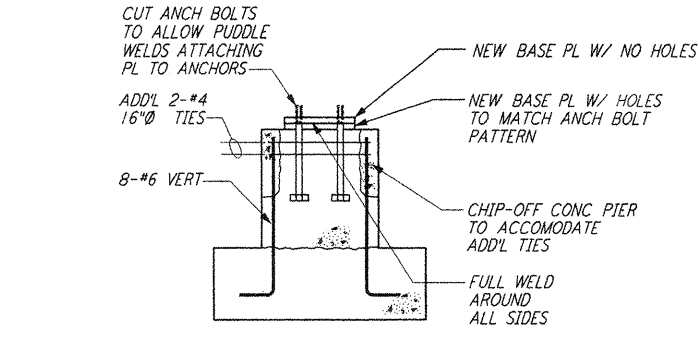


SECTION

MODIFICATION OF FDN TO COLS W-18.4 & W.4-18
 $\frac{3}{8}'' = 1'-0''$

- NOTES:**
1. FOR GENERAL NOTES, ABBREVIATIONS AND SYMBOLS, SEE DRAWING LA-S-001.
 2. FOR SLAB ON GRADE DETAILS SEE DRAWING LA-S-002.
 3. FOR BASE ANGLE AT EDGE OF SLAB OR TOP OF 6\"/>

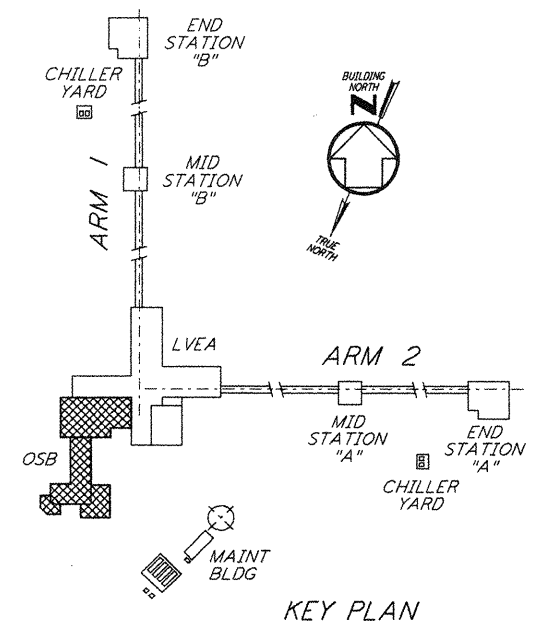

KEY PLAN

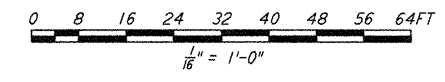

This document and the design it covers are the property of PARSONS. They are loaned only with the borrower's expressed written agreement that they will not be reproduced, copied, loaned, exhibited, or used in any other way, except by written consent from PARSONS to the borrower.

NO.	DATE	BY	CHKD	ENGR	PROJ	DESCRIPTION
1	08-07-98	WA	BBM	BBM	1111	ISSUED FOR AS-BUILT

ISSUED FOR CONSTRUCTION		
DRAWN	MCS	11-15-96
CHECKED	DDM	11-15-96
ENGINEER	BP	11-15-96
PROJ	TDM	11-15-96

AS-BUILT DRAWINGS

PARSONS
 100 WEST WALNUT STREET
 PASADENA, CALIFORNIA

LIGO
 CALIFORNIA INSTITUTE OF TECHNOLOGY
 MASSACHUSETTS INSTITUTE OF TECHNOLOGY

LIGO-D960918-01-0
 LASER INTERFEROMETER
 GRAVITATIONAL-WAVE OBSERVATORY
 SITE NO. 2 - LIVINGSTON, LOUISIANA

TITLE	SCALE	CENTRIFUGAL NUMBER	PROJECT NUMBER
STRUCTURAL CORNER STATION OSB FOUNDATION PLAN	AS NOTED	PP150969	8094
SHEET NUMBER		REVISIONS	
LA-S-102			