



**FOUNDATION PLAN**  
 $\frac{1}{16}'' = 1'-0''$


FOR FLOOR SLOPE AND FLOOR DRAIN  
 SEE ARCHITECTURAL DRAWINGS  
 DATUM POINT EL 100'-0" = EL 61.44'

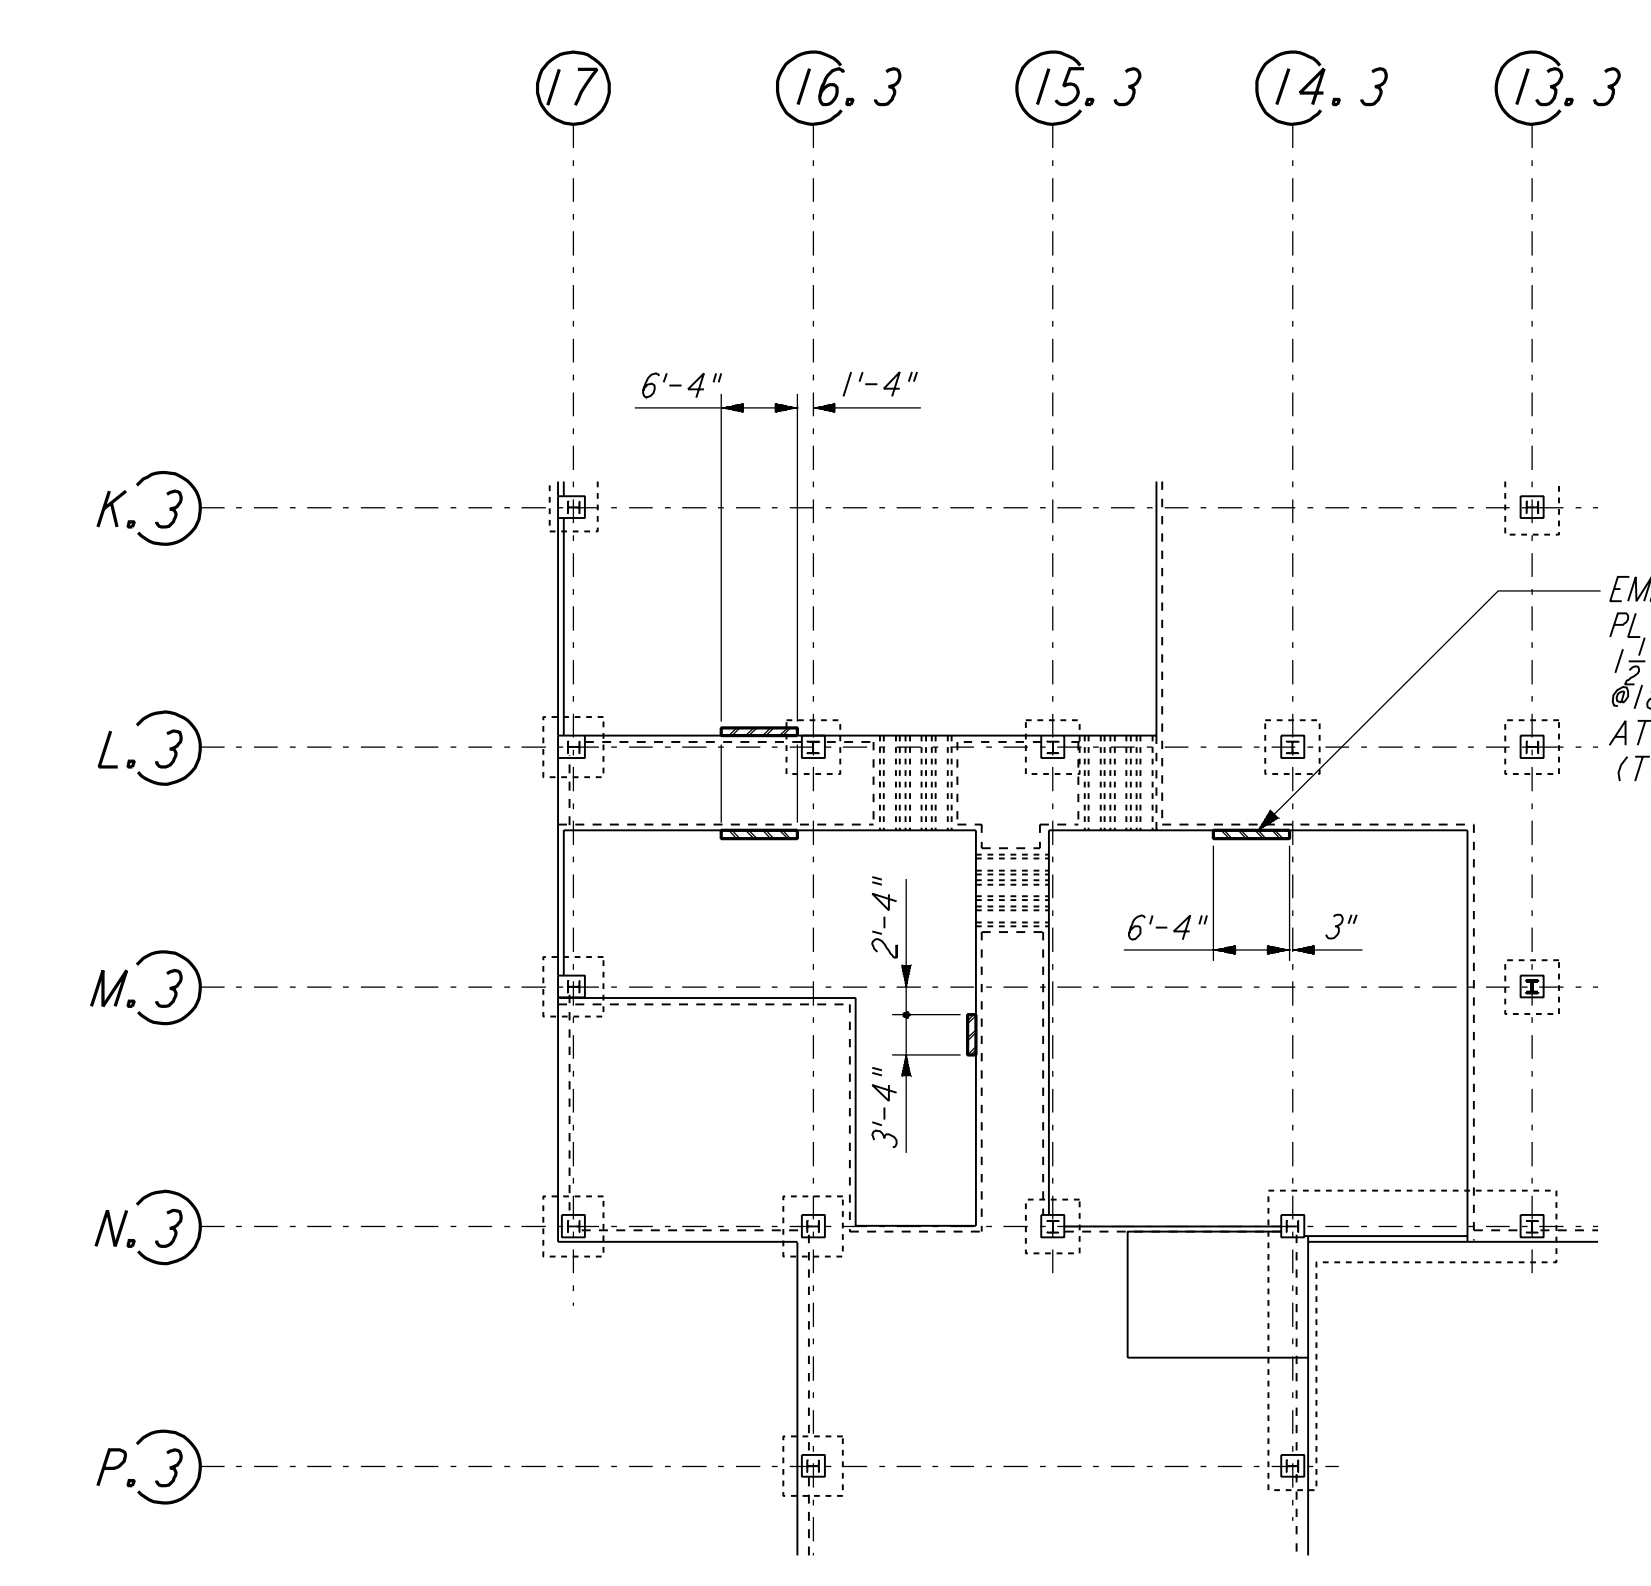

**EMBED LOCATION LAYOUT**  
 $\frac{1}{16}'' = 1'-0''$

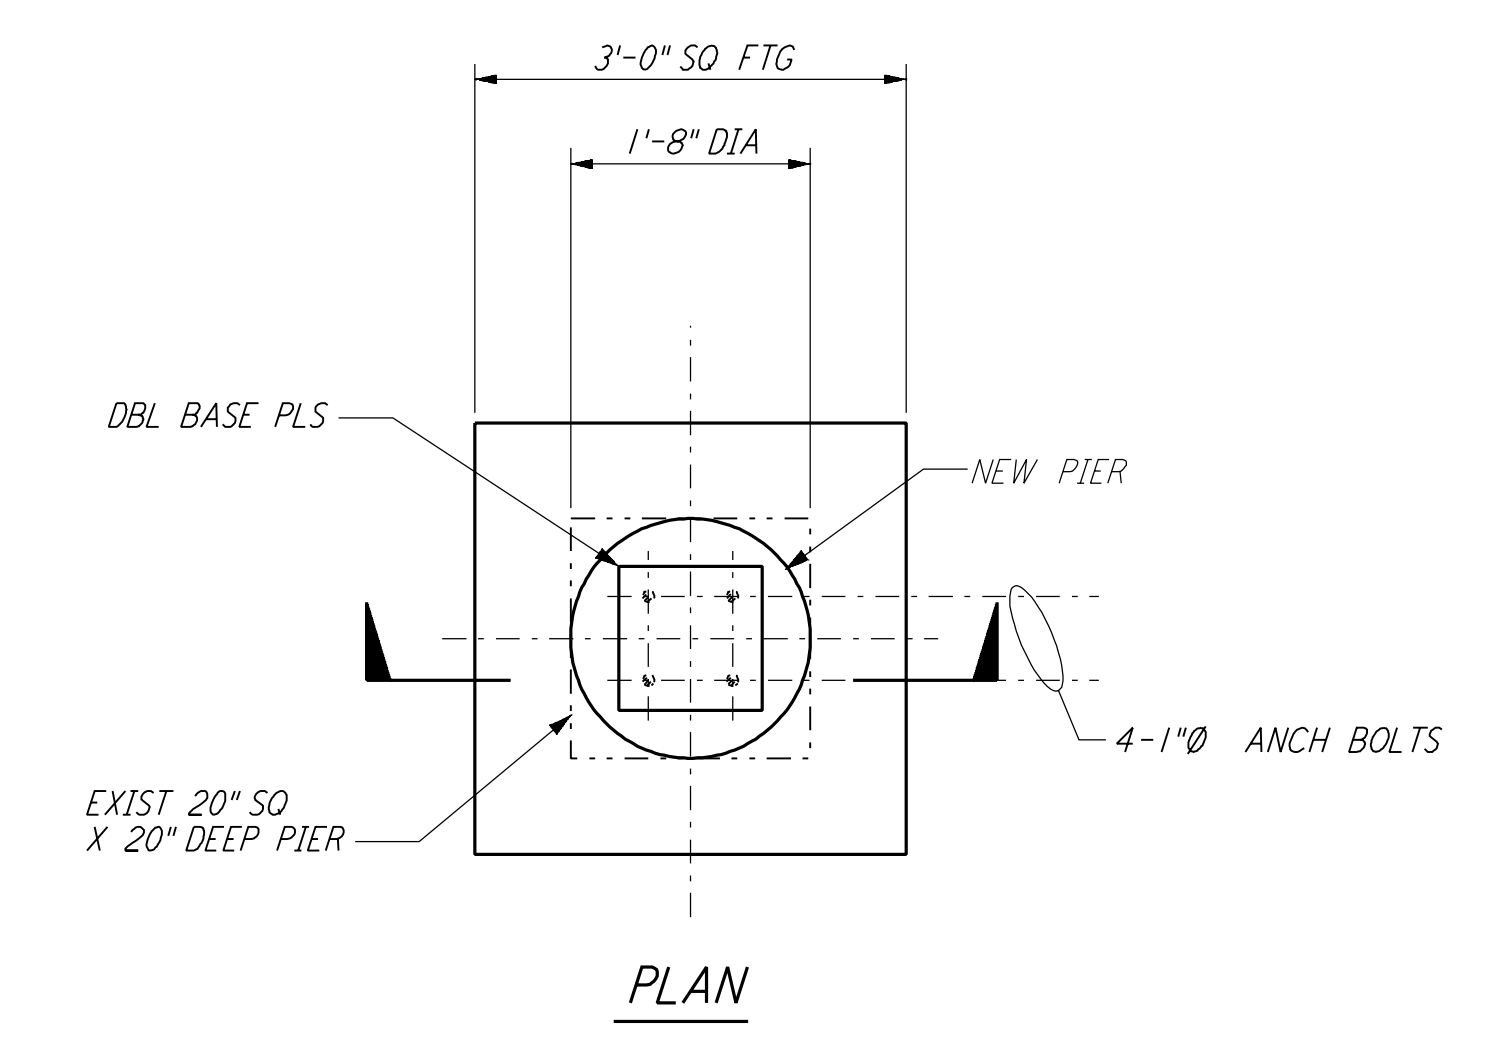


**PLAN**

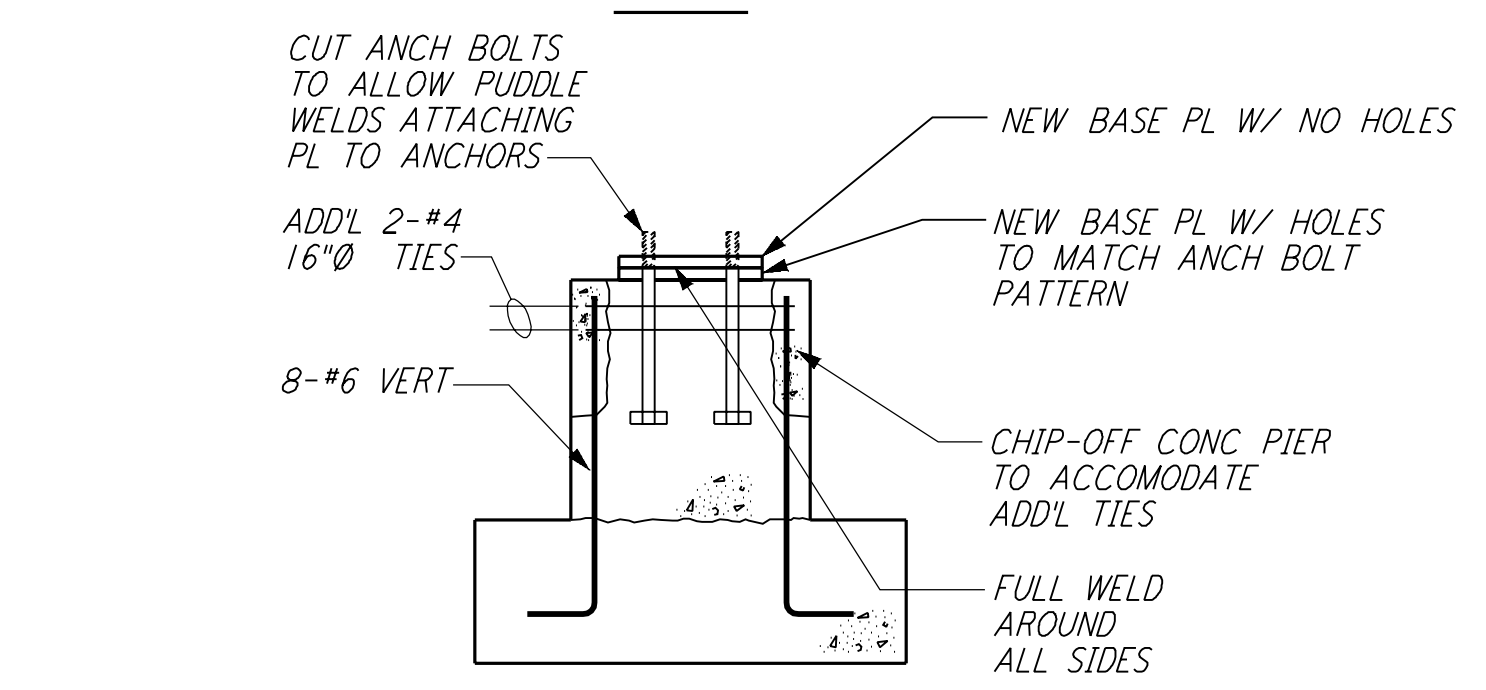


**SECTION**

**MODIFICATION OF FDN TO COLS W-18.4 & W.4-18**  
 $\frac{3}{8}'' = 1'-0''$

- NOTES:**
1. FOR GENERAL NOTES, ABBREVIATIONS AND SYMBOLS, SEE DRAWING LA-S-001.
  2. FOR SLAB ON GRADE DETAILS SEE DRAWING LA-S-002.
  3. FOR BASE ANGLE AT EDGE OF SLAB OR TOP OF 6" CONCRETE WALL, SEE FRAMING ELEVATIONS AND SECTION LA-S-003.
  4. FOR FOUNDATION SCHEDULE AND DETAILS SEE DRAWINGS LA-S-402 AND LA-S-403.
  5. ALL VERTICAL SURFACES OF FOUNDATION SHALL BE FORMED.

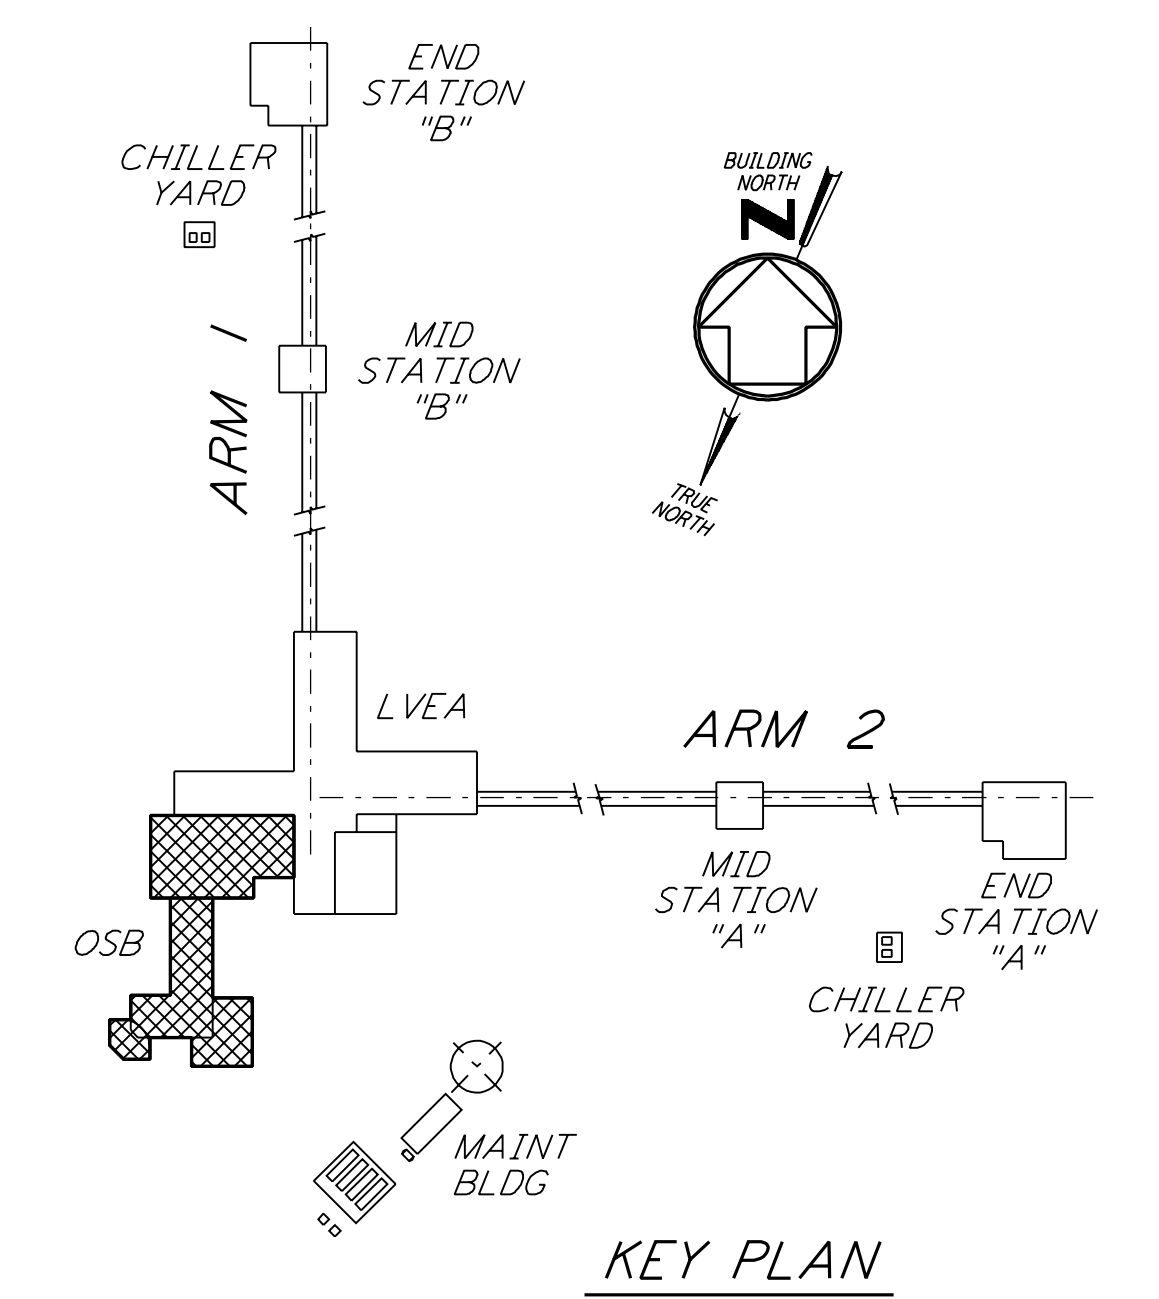

**KEY PLAN**

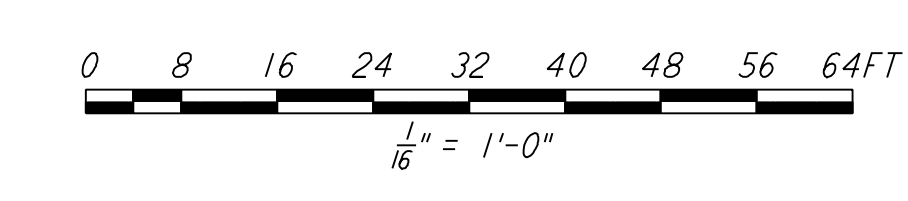

This document and the design it covers are the property of PARSONS. They are loaned only with the borrower's expressed written agreement that they will not be reproduced, copied, loaned, exhibited, or used in any other way, except by written consent from PARSONS to the borrower.

NO.	DATE	BY	CHKD	ENGR	PROJ	DESCRIPTION
1	08-07-98	WA				ISSUED FOR AS-BUILT

ISSUED FOR CONSTRUCTION			
DRAWN	MCS	11-15-96	
CHECKED	DDM	11-15-96	
ENGINEER	BP	11-15-96	
PROJ	TDM	11-15-96	

**AS-BUILT DRAWINGS**

100 WEST WALNUT STREET  
 PASADENA, CALIFORNIA

CALIFORNIA INSTITUTE OF TECHNOLOGY  
 MASSACHUSETTS INSTITUTE OF TECHNOLOGY

**LIGO-D960918-01-O**

LASER INTERFEROMETER  
 GRAVITATIONAL-WAVE OBSERVATORY  
 SITE NO. 2 - LIVINGSTON, LOUISIANA

TITLE	SCALE	CONTRACT NUMBER	PROJECT NUMBER
STRUCTURAL CORNER STATION OSB FOUNDATION PLAN	AS NOTED	PP150969	8094
SHEET NUMBER	REVISIONS		
<b>LA-S-102</b>			